

submitted in lieu of Form 3160-5

UNITED STATES
DEPARTMENT OF THE INTERIOR
BUREAU OF LAND MANAGEMENT

Sundry Notices and Reports on Wells

1. Type of Well
GAS

2. Name of Operator

**BURLINGTON
RESOURCES**

OIL & GAS COMPANY

3. Address & Phone No. of Operator

PO Box 4289, Farmington, NM 87499 (505) 326-9700

4. Location of Well, Footage, Sec., T, R, M

660' FNL, 1345' FEL, Sec. 31, T-32-N, R-10-W, NMPM

5. Lease Number
SF-078604

6. If Indian, All. or
Tribe Name

7. Unit Agreement Name

8. Well Name & Number
Scott 2C

9. API Well No.
30-045-32889

10. Field and Pool
Blanco Mesaverde

11. County and State
San Juan, NM

12. CHECK APPROPRIATE BOX TO INDICATE NATURE OF NOTICE, REPORT, OTHER DATA

Type of Submission

☒ Notice of Intent

☐ Subsequent Report

☐ Final Abandonment

Type of Action

☐ Abandonment

☐ Recompletion

☐ Plugging Back

☐ Casing Repair

☐ Altering Casing

☒ Other Name & formation Change

☐ Change of Plans

☐ New Construction

☐ Non-Routine Fracturing

☐ Water Shut off

☐ Conversion to Injection

13. Describe Proposed or Completed Operations

It is intended to Change the name on the subject well from the Scott C1 to The Scott 2C. This well was originally to be drilled as a Basin Dakota and during the drilling Phase was changed to a Blanco Mesaverde stand alone.



ACCEPTED FOR RECORD

FEB 16 2006

FARMINGTON DISTRICT OFFICE
BY ll

2006 FEB 7 PM 4 16
RECEIVED
070 FARMINGTON NM

14. I hereby certify that the foregoing is true and correct.

Signed Frances Bond Title Regulatory Specialist Date 12/21/05
fsb

(This space for Federal or State Office use)

APPROVED BY _____ Title _____ Date _____

CONDITION OF APPROVAL, if any:

Title 18 U.S.C. Section 1001, makes it a crime for any person knowingly and willfully to make to any department or agency of the United States any false, fictitious or fraudulent statements or representations as to any matter within its jurisdiction.

NNOCDD

District I

1625 N. French Dr., Hobbs, NM 88240
Phone:(505) 393-6161 Fax:(505) 393-0720

District II

1301 W. Grand Ave., Artesia, NM 88210
Phone:(505) 748-1283 Fax:(505) 748-9720

District III

1000 Rio Brazos Rd., Aztec, NM 87410
Phone:(505) 334-6178 Fax:(505) 334-6170

District IV

1220 S. St Francis Dr., Santa Fe, NM 87505
Phone:(505) 476-3470 Fax:(505) 476-3462

State of New Mexico
Energy, Minerals and Natural Resources

Oil Conservation Division

1220 S. St Francis Dr.
Santa Fe, NM 87505

Form C-102
Permit 20451

2006 FEB 7 PM 4 16
RECEIVED
070 FARMINGTON NM

WELL LOCATION AND ACREAGE DEDICATION PLAT

1. API Number 30-045-32889	2. Pool Code 72319	3. Pool Name BLANCO-MESAVERDE (PRORATED GAS)
4. Property Code 7493	5. Property Name SCOTT	6. Well No. 002C
7. OGRID No. 14538	8. Operator Name BURLINGTON RESOURCES OIL & GAS COMPANY LP	9. Elevation


10. Surface Location

UL - Lot B	Section 31	Township 32N	Range 10W	Lot Idn	Feet From 660	N/S Line N	Feet From 1345	E/W Line E	County SAN JUAN
----------------------	----------------------	------------------------	---------------------	---------	-------------------------	----------------------	--------------------------	----------------------	---------------------------

11. Bottom Hole Location If Different From Surface

UL - Lot	Section	Township	Range	Lot Idn	Feet From	N/S Line	Feet From	E/W Line	County
12. Dedicated Acres 318.46	13. Joint or Infill	14. Consolidation Code	15. Order No.						

NO ALLOWABLE WILL BE ASSIGNED TO THIS COMPLETION UNTIL ALL INTERESTS HAVE BEEN CONSOLIDATED OR A NON-STANDARD UNIT HAS BEEN APPROVED BY THE DIVISION

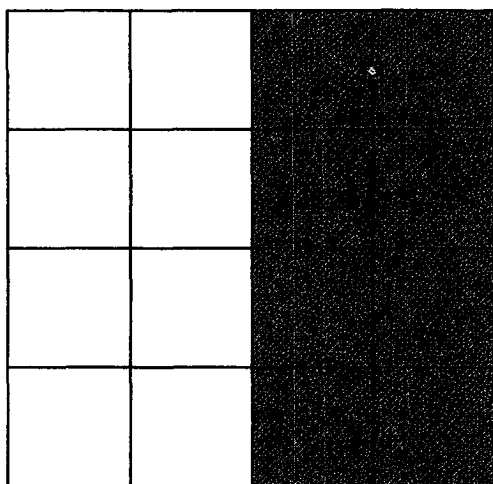**OPERATOR CERTIFICATION**

I hereby certify that the information contained herein is true and complete to the best of my knowledge and belief, and that this organization either owns a working interest or unleased mineral interest in the land including the proposed bottom hole location(s) or has a right to drill this well at this location pursuant to a contract with an owner of such a mineral or working interest, or to a voluntary pooling agreement or a compulsory pooling order heretofore entered by the division.

Signed By: *Frances Band*
Title: *Regulatory Specialist*
Date: *12-22-05*

SURVEYOR CERTIFICATION

I hereby certify that the well location shown on this plat was plotted from field notes of actual surveys made by me or under my supervision, and that the same is true and correct to the best of my belief.

Surveyed By: **John A Vukonich**
Date of Survey: **10/3/2004**
Certificate Number: **14831**



ENTERPRISE
FIELD
SERVICES LLC

BLANCO GATHERING SYSTEM

DWG. NO. BTH-173-01

WO NO. P11131

RW NO. 0470517

DATE 12/01/04

SCALE 1" = 1000'

SURVEYED 11/15/04

RANGE 10-W, N.M.P.M.

LINE BURLINGTON RESOURCES OIL & GAS CO.- SCOTT 2C

FROM 0+00 = 0+98.34 ON BURLINGTON RESOURCES OIL & GAS CO.- SCOTT NO. 16

(BTH-73-1, R/W NO. 7670319)(MC NO. 89591)

COUNTY SAN JUAN


STATE NEW MEXICO

SECTION 31

TOWNSHIP 32-N

RANGE 10-W, N.M.P.M.

AS-BUILT

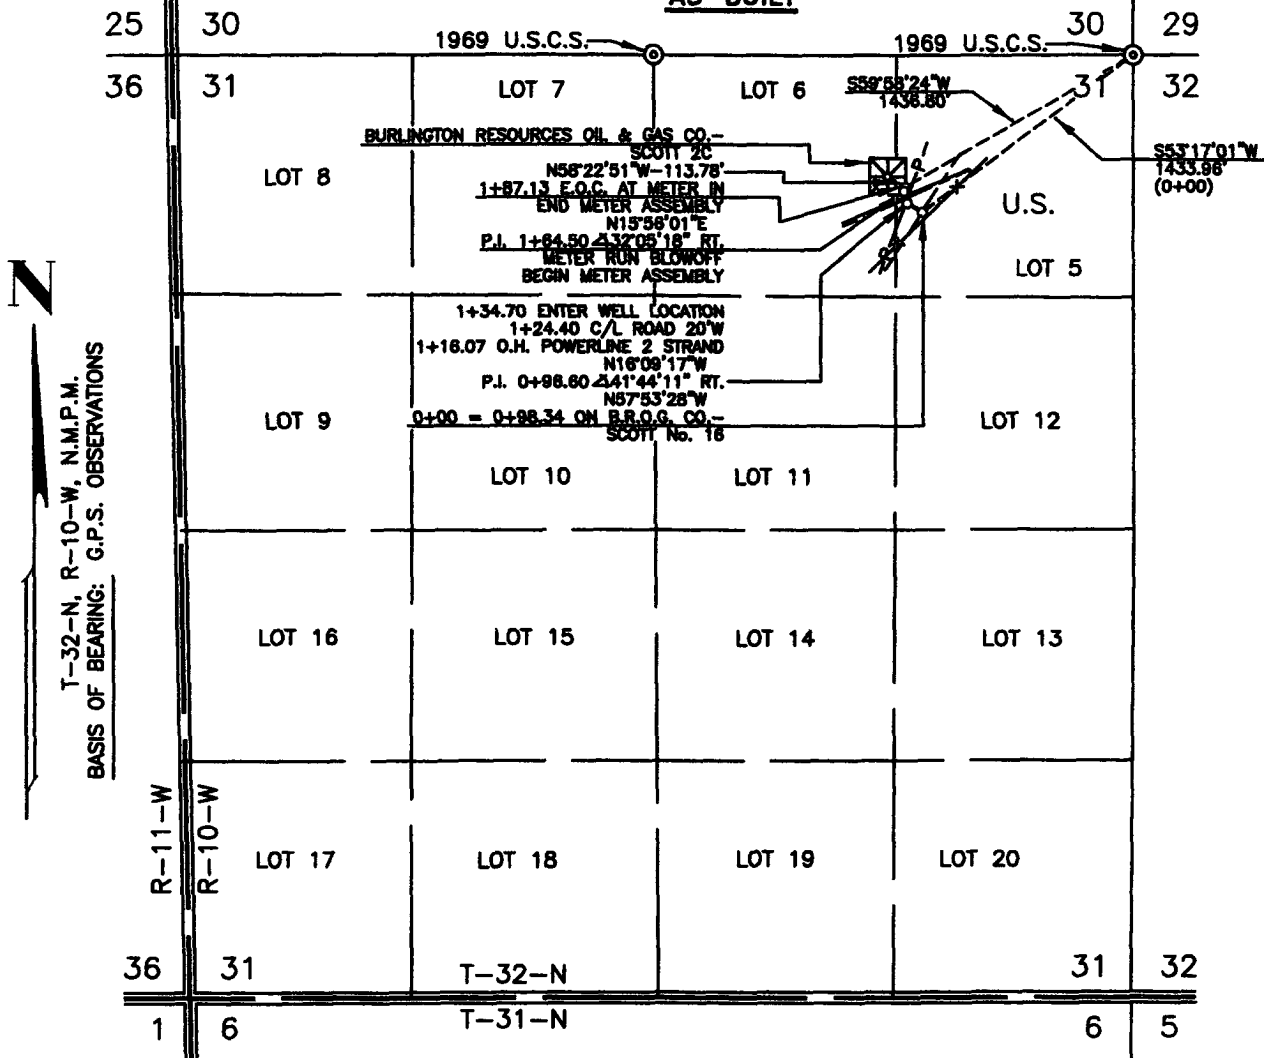

DWN. BY IC CONSTR. COMMENCED 10/12/05 APPL. DWG. SLACK CHAIN 10/21/05

CKD. BY MD CONSTR. COMPLETED 10/12/05 DATE PIPE SIZE 4.50" O.D.

PRINT RECORD

PIPE DATA

METER STA. NO. 86210 DK

NOTE: WELL FLAG

Ⓟ

SUBDIVISION	OWNER	LESSEE	METER(S)	RODS	ACRE(S)
ALL SEC. 31	UNITED STATES	AUSTIN D. DECKER ESTATE		11.341	0.172

1- REVISED DRAWING PER ASBUILT NOTES DATED 10/21/05 (11/04/05/DB)

2- NAME CHANGED FROM SCOTT C No. 1 PER MEMO DATED 12/05/05/KB (12/07/05/DB)