


30-039-82326

RESOURCE DEVELOPMENT TECH NCRA STATE #4

LOCATED IN THE W/2 OF THE SE/4 OF SECTION 16, T24N, R6W, N.M.P.M.,
RIO ARriba COUNTY, NEW MEXICO

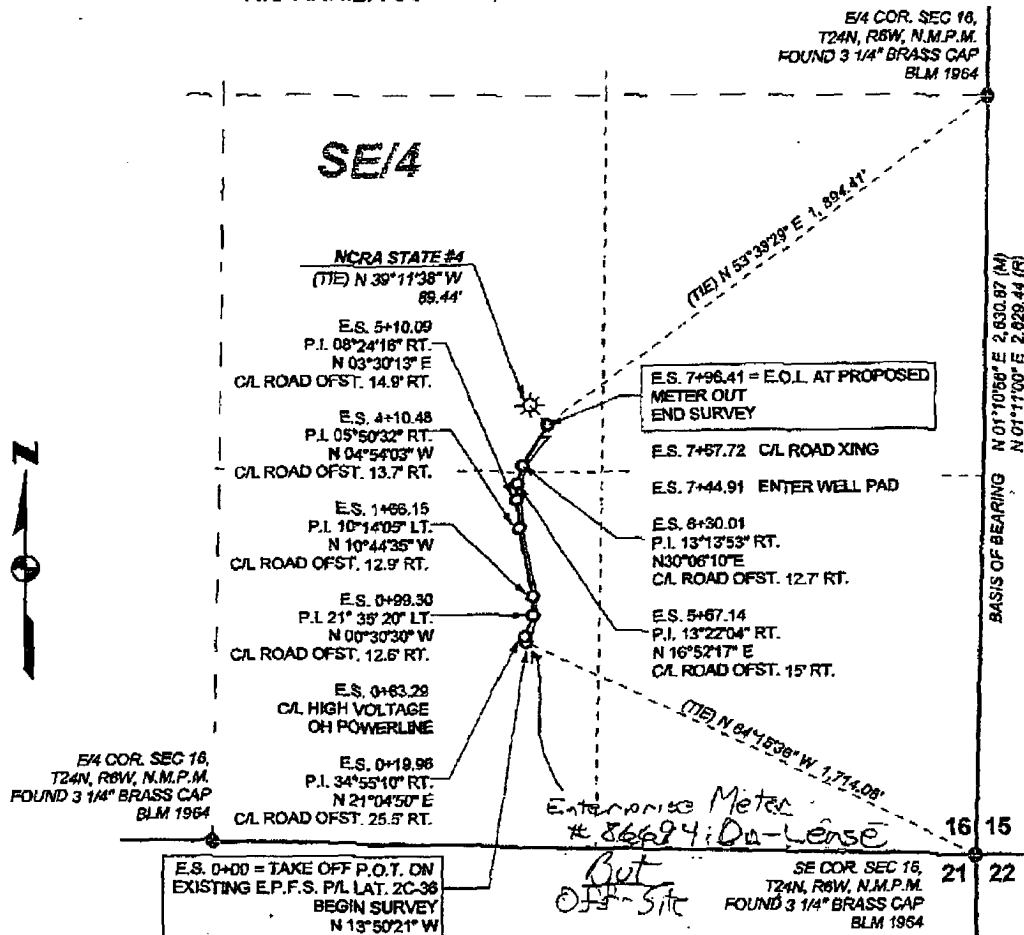

0 255 510 1,020 Feet

OWNERSHIP	LOCATION	ENGINEERING STATION	OWNER	BOOK / PAGE	FEET / RODS
	W/2 SE/4	0+00.00 - 7+96.41	STATE OF NEW MEXICO	N/A	796.41 / 48.27

NOTES	BASIS OF BEARING	PLAT INFO.
LOCATION OF UNDERGROUND UTILITIES DEPICTED ARE APPROXIMATE. PRIOR TO EXCAVATION UNDERGROUND UTILITIES SHOULD BE FIELD VERIFIED. ALL CONSTRUCTION ACTIVITIES SHOULD BE FIELD VERIFIED WITH NEW MEXICO ONE-CALL AUTHORITIES AT LEAST 48 HRS. PRIOR TO CONSTRUCTION.	A LINE BETWEEN FOUND MONUMENTS AT THE SOUTHEAST CORNER AND THE EAST QUARTER CORNER OF SECTION 16, T24N, R6W, N.M.P.M. BEARS: N 01°10'56" E 2,630.87'	☒ PRELIMINARY ☐ LINE CHANGE ☐ RE-TIE ☐ AS-BUILT

THIS IS TO CERTIFY THAT THE ABOVE PLAT WAS PREPARED FROM FIELD NOTES OF A CADASTRAL SURVEY MADE BY ME OR UNDER MY DIRECT SUPERVISION AND THE SAME ARE TRUE AND CORRECT TO THE BEST OF MY KNOWLEDGE AND BELIEF.	SVYD DATE:	NO.	DATE	BY	DESCRIPTION
6/1/05 R. HOWARD DARGatz, L.S. NO. 49679 DATE	05/20/05				
	OWN. BY:				
	CHK. BY:				
	JOB #:				
	W.O. #:				

FILE PATH
RD0001P01

1908 E. 20th STREET, #7 FARMINGTON, NM, 87401

Geographic Solutions

PHONE: (505) 325-6941 FAX: (505) 325-6842