
201 = 30039-20774 56 = 30039-06678 55 = 30-039-06741

DATA SHEET FOR DEEP GROUND BED CATHODIC PROTECTION WELLS NORTHWESTERN NEW MEXICO (Submit 3 copies to OCD Aztec Office)

Operator Union Oil Company of California Location: Unit Sec. 2 Twp26N Rng7W
Name of Well/Wells or Pipeline Serviced Rincon 201 PC Rincon #56 PC
Rincon #55 PC
Elevation 6661 Completion Date 11-13-89 Total Depth 300 Land Type* S
Casing, Sizes, Types & Depths None
If Casing is cemented, show amounts a types used None OIL CON. DIV.
If Cement or Bentonite Plugs have been placed, show depths.& amounts used
Depths & thickness of water zones with description of water when possible:
Fresh, Clear, Salty, Sulphur, Etc. Fresh water 120' Deep 30' Thick
SEE ATTACHED SHEET
Depths gas encountered: NA
Type & amount of coke breeze used: Carbo 60 plus mettalurgical 2500 lbs
Depths anodes placed: 155' to 190'
Depths vent pipes placed: 300'
Vent pipe perforations: 125' to 300'
Remarks: Unocal was the operator at the time this ground bed was installed.
First ground bed installed on this location.
If any of the above data is unavailable, please indicate so. Copies of all logs, including Drillers Log, Water Analyses & Well Bore Schematics should be submitted when available. Unplugged abandoned wells are to be included.
*Land Type may be shown: F-Federal; I-Indian; S-State; P-Fee. If Federal or Indian, add Lease Number.

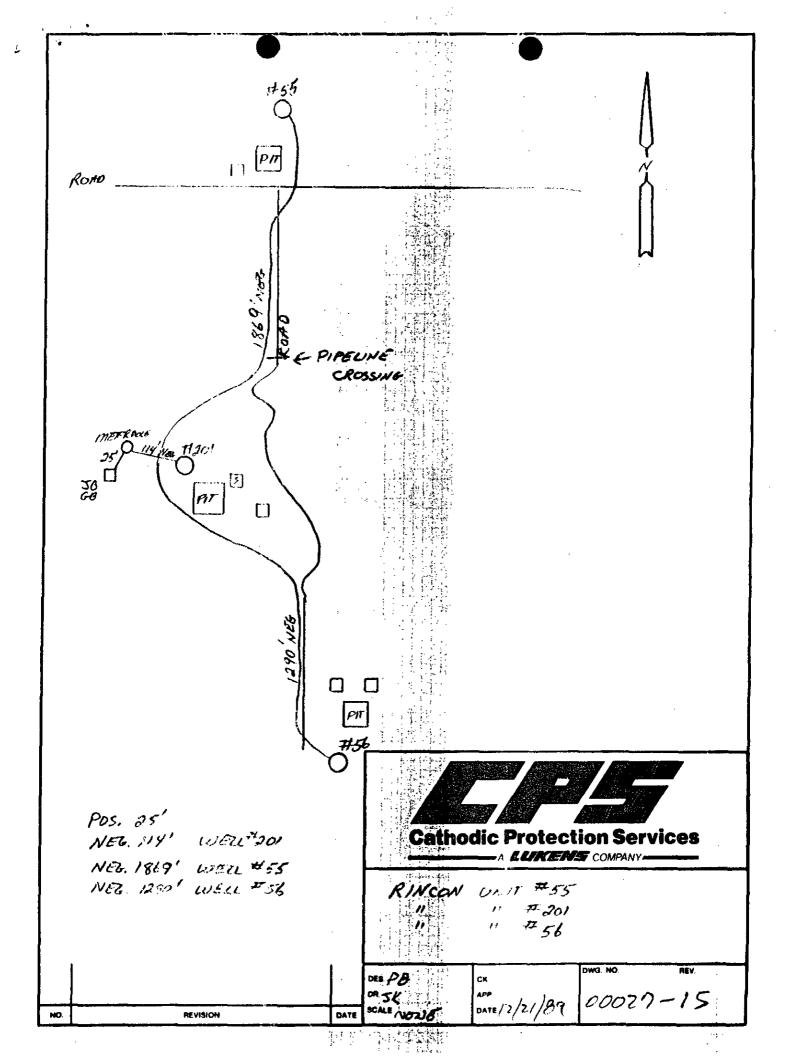

. . 55

DATA SHEET NO. _/Of/

CATION	: SEC. 2 TWP. 26 RGE. 7	_ co. 🚅	Sto K	RRI	34 STAT	e	! 177e	<u> </u>
	FT: ROTARY 300 FT: (• 1 .						
	ED: DEPTH 300 PT. DIA. 12 N.							
. 1			EXPLORING ANODE		NO			DEPTH,
7. T.	DRILLER'S LOG			1	COKE		№.	ANODE:
 ¦	RIRST WATER 120	<u> </u>	<u> </u>		I	1	<u> </u>	
	0- 130 SANCE		 		 	i	<u> </u>	
30		1	14.0	ı	1			
<u>.s- </u>	· · · · · · · · · · · · · · · · · · ·	1	14.6		Ī	<u> </u>	i I	
40		Ī	1 4.5		i	İ	i	
٦			1 4.7		i		ī	
50			1 4.2		İ	i	Ī	j
5	TOP OF LION AWYORS	i i	5.4		15.4	12.2	Ī	15
601		1	1 4.43				ı	
حی		1	1 52	1 - 1		<u> </u>	1	
201			1 4.8		L LIL	DA37	RING	
حی		1	1 4.5		1	!	0	
80		<u> </u>	1 5.7		1		1	1
5-			3.2			<u> </u>	!	
90			3, 9		<u> </u>	<u> </u>	1.	190
5			1 2.7	'	<u> </u>	<u>!</u>		<u> </u>
200			1 2.8	'		!	<u> </u>	<u> </u>
سی			126	<u>.l</u>	<u> </u>	<u> </u>	<u> </u>	<u> </u>
/0		<u> </u>	1 . 2.7	1	<u> </u>	<u> </u>	!	1
_5			1.7			<u> </u>	1	
20		<u> </u>	1 2.0	1	.1	<u> </u>	<u> </u>	
<u>5</u>			1.1.1	<u>- </u>		<u> </u>		<u> </u>
_رمح		_	1 1 6	<u>- </u>	<u> </u>	<u> </u>	<u> </u>	<u> </u>
5		<u> </u>	1.4		-\			
40		_!	1.8			 	_	\
-5-	Z :		1.9		- 	 		
.50			1.8		_	- 	 	1
5		_	1.0		-:	 	-	
60	•		1.3		- 	'		
5 70 5	× 1			/ 		+		1
-/2		- 	' '; 		- .,	- 	- i	1
801		- 	1.6	Z	- 	i - -	-i	
<u> </u>		- 		71	- 	- 		1
90		-i	2.0		1	-i	1	1
5-1		_	1 2	71	- 	-1	7	1
300	7.0. 300	1		Ĭ	<u> </u>	1	7	7,
		1		1	1			yen.
					200 60			COS
					THURG		. 7	113-1 E40


GROUNDSED RESIEVANCE: (1) VOLTE 12.40 - AMPS 12.2 - 1.02 OHME

(2) VEROGROUND ____ CHM

GENERAL CATHODIC PROTECTION SERVICES CO.

© Cathobic Protection Services Company
P. O. Box 388
Farmington, New Mexico 87499
1608 Schofield Lane
Farmington, New Mexico 87401
(505) 325-1946

February 2, 1990

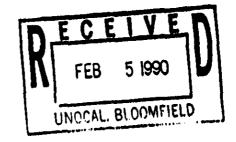

Unocal Corporation 3300 N. Butler, Suite 201 Farmington, NM 87401

Attention: Mr. Steve Gregory

Subject: Major Water Zones in Cathodic Protection Deep-Well Groundbeds

Dear Mr. Gregory:

Per your recent request for information concerning the cathodic protection deep-well groundbeds for your well casings in the San Juan Basin area, we are pleased to submit the following information.

Township & Range	Depths Ranging From Shallowest to Deepest	Average Depth	Average Thickness of Water Zone		
T-25N - R-10W	110' - 140'	122.5'	201		
T-25N - R-11W	60' - 140'	93.31	45'		
T-26N - R-7W	80' - 150'	112.5'	30'		
T-27N + R-7W	80' - 200'	123.3'	22.5'		
T-27N - R-6W	80' - 200'	131.1'	30 ·		

This data reflects information supplied by the drilling logs acquired at the time the wells were drilled. The depths shown are based on the type of sand which was being extruded from the drilled hole and the dampness of the sand.

The thickness of the water zones are determined by the change in the strata which was being drilled.

It has been a pleasure providing this information to your company. If you have any further questions or desire additional information, please do not hesitate to contact us.

Sincretaly,

Cathodic Protection Services Company

John Kerr, Corrosion Technician

cc: Mike Tabet

