

107-30-039-60093

174-30-039-06952

DATA SHEET FOR DEEP GROUND BED CATHODIC PROTECTION WELLS
NORTHWESTERN NEW MEXICO
(Submit 3 copies to OCD Aztec Office)

Operator Union Oil Company of California Location: Unit Sec. 19 Twp 27N Rng 6WName of Well/Wells or Pipeline Serviced Rincon Unit #107 MV, Rincon Unit #174 DKElevation 6592' Completion Date 7/9/1970 Total Depth 610' Land Type* FCasing, Sizes, Types & Depths NoneIf Casing is cemented, show amounts & types used None


If Cement or Bentonite Plugs have been placed, show depths & amounts used
None

Depths & thickness of water zones with description of water when possible:
Fresh, Clear, Salty, Sulphur, Etc. 340' deep Thickness ?

Depths gas encountered: NAType & amount of coke breeze used: 8100 lbs Kind knownDepths anodes placed: 410' - 575'Depths vent pipes placed: ?Vent pipe perforations: 400'Remarks: El Paso Natural Gas was operator when this ground bed was installed.Second ground bed installed at this location.

If any of the above data is unavailable, please indicate so. Copies of all logs, including Drillers Log, Water Analyses & Well Bore Schematics should be submitted when available. Unplugged abandoned wells are to be included.

*Land Type may be shown: F-Federal; I-Indian; S-State; P-Fee.
If Federal or Indian, add Lease Number.

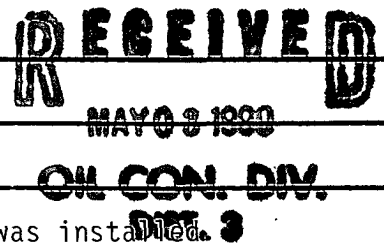

WELL CASING
CATHODIC PROTECTION CONSTRUCTION REPORT
DAILY LOG

Drilling Log (Attach Hereto). ☐

#2 GND BED
Contractor CPS.

Completion Date 7-9-70


Well Name Rincon #174		Location SW 19-27-6		CPS No. 689W	
Type & Size Bit Used 6 3/4		Work Order No. 184-33447-50-20			
Anode Hole Depth 610	Total Drilling Rig Time	Total Lbs. Coke Used	Lost Circulation Mat'l Used	No. Sacks Mud Used	
Anode Depth					
#1 575	#2 525	#3 515	#4 490	#5 480	#6 470
#7 460	#8 450	#9 440	#10 430		
Anode Output (Amps)					
#1 1.38	#2 3.7	#3 3.7	#4 1.32	#5 4.0	#6 4.0
#7 2.5	#8 2.5	#9 3.7	#10 3.7		
Anode Depth					
#11 420	#12 410	#13	#14	#15	#16
#17	#18	#19	#20		
Anode Output (Amps)					
#11 3.8	#12 3.8	#13	#14	#15	#16
#17	#18	#19	#20		
Total Circuit Resistance	No. 8 C.P. Cable Used		No. 2 C.P. Cable Used		
Volts 12.5	Amps 10.8	Ohms 1.15			

Remarks: Wet at 340 Drill with air to 360
Pump 55 Bags Coke Slurry 26 Bags 81 Total
1" Hose perforated approx 400' to No 1 Anode
Anodes 1 & 4 are Single - others Dual

All Construction Completed

Farrils
(Signature)

GROUND BED LAYOUT SKETCH

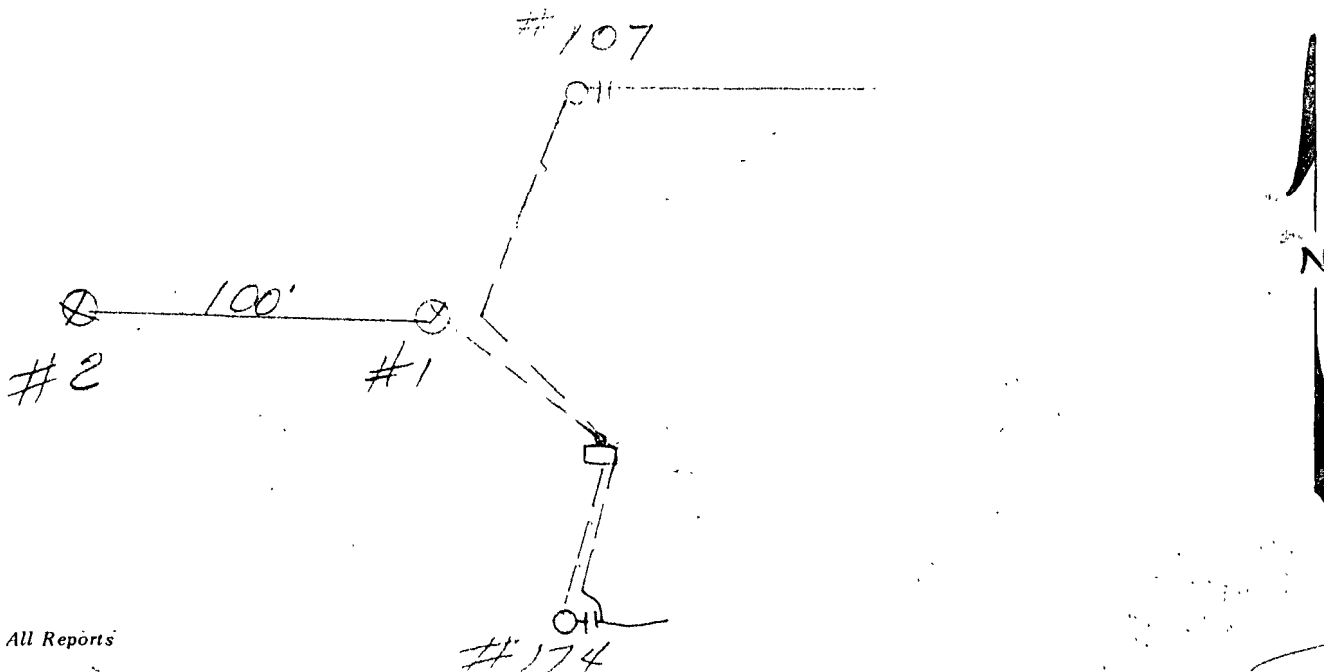

689W Drill To 610

Drill 360 with air used at 340

Pump
55 Bags

12.5 V

10.8 A

MW	gas/mol
16	6.4
20	8.0
44	10.4
58	12.8
72	15.2
6778	1164.8

WELL TYPE GROUNDBED DATA

DATA SHEET NO. 1

COMPANY EL PASO NATL GAS Co. JOB NO. 5664 DATE: 7-9-70
 WELL: RINCON # 107 & 174 PIPELINE: CPS # 689-W
 LOCATION: SEC. 19 TWP. 27 RGE. 6 CO. RIO ARRIAR STATE NEW MEXICO
 ELEV. 6526 FT. ROTARY 610 FT. CABLE TOOL ✓ FT. CASING ✓ FT.
 GROUNDBED: DEPTH 610 FT. DIA. 6 3/4 IN. GAB 8500 LBS. ANODES 12-CDD-051

DEPTH, FT.	DRILLER'S LOG	DRILL PIPE TO STRUCTURE			EXPLORING ANODE TO STRUCTURE			DEPTH, TOP OF ANODES
		E	I	R	E	I	R	
5	SURFACE SOIL (0'-5')							
10	SANDSTONE (5'-32')							
20								
30								
40	SANDSTONE (32'-71')							
50								
60								
70								
80	SANDSTONE (71'-108')							
90								
100								
110	SHALE (108'-132')							
120								
130								
140	SANDSTONE (132'-165')							
150								
160								
170	SANDY SHALE (165'-172')							
180	SANDSTONE & SHALE							
190	STRINGERS (172'-394')							
200								
210								
GROUNDBED RESISTANCE: (1) VOLTS _____ - AMPS _____ = _____ OHMS

(2) VIBROGROUND _____ OHMS



cathodic protection service

WELL TYPE GROUNDBED DATA

DATA SHEET NO. _____

COMPANY _____ JOB No. _____ DATE: _____

WELL: _____ PIPELINE: _____

LOCATION: SEC. _____ TWP. _____ RGE. _____ CO _____ STATE _____

ELEV. _____ FT: ROTARY _____ FT: CABLE TOOL _____ FT: CASING _____ FT.

GROUNDBED: DEPTH _____ FT. DIA. _____ IN. GAB _____ LBS. ANODES _____

DEPTH, FT.	DRILLER'S LOG	DRILL PIPE TO STRUCTURE			EXPLORING ANODE TO STRUCTURE			DEPTH, TOP OF ANODES
		E	I	R	E	I	R	
20								
30								
40								
50								
60								
70								
80								
90								
300						.65		
10						.67		
20						.67		
30						.38		
40						.36		
50						.60		
60						.52		
70						.68		
80						.88		
90						.66		
30						.64		
40	(Light wire R.)					.66		
50						.26		
60						.68		
70						.69		
80						.23		
90						.23		
30						.71		
40						.72		
50						.82		
400	SHALE & SILTY SAND (394-612)					1.13		
10						1.02		
20						1.55 ✓		410 12
30						1.65		
40						1.23 ✓		420 11
50						1.64		
60						2.00 ✓		430 10

GROUNDBED RESISTANCE: (1) VOLTS _____ AMPS _____ = _____ OHMS

(2) VIBROGROUND _____ OHMS



cathodic protection service

DATA SHEET NO. _____

GROUND BED: DEPTH _____ FT. DIA. _____ IN. GAB _____ LBS. ANODES _____

