

97-30-039-60094

157-30-039-07026

DATA SHEET FOR DEEP GROUND BED CATHODIC PROTECTION WELLS
NORTHWESTERN NEW MEXICO
(Submit 3 copies to OCD Aztec Office)

Operator Union Oil Company of California Location: Unit Sec. 18 Twp 27N Rng 6W

Name of Well/Wells or Pipeline Serviced Rincon Unit 97 MV & Rincon Unit 157 DK

Rincon Unit 239 FC

Elevation 6662' Completion Date 12/11/89 Total Depth 425' Land Type* F

Casing, Sizes, Types & Depths None

If Casing is cemented, show amounts & types used None

If Cement or Bentonite Plugs have been placed, show depths & amounts used

None

Depths & thickness of water zones with description of water when possible:

Fresh, Clear, Salty, Sulphur, Etc. 120' deep ? thick

Depths gas encountered: NA

Type & amount of coke breeze used: Carbo 50 2500 lbs

Depths anodes placed: 240

Depths vent pipes placed: 240'

Vent pipe perforations: 150'

Remarks: Unocal operator of well when this ground bed was installed. Second

ground bed installed at this location.

If any of the above data is unavailable, please indicate so. Copies of all logs, including Drillers Log, Water Analyses & Well Bore Schematics should be submitted when available. Unplugged abandoned wells are to be included.

*Land Type may be shown: F-Federal; I-Indian; S-State; P-Fee.
If Federal or Indian, add Lease Number.

RECEIVED

MAY 03 1990

OIL CON. DIV.

DIST. 2

JOB No. 50027 DATE: 11-2-89

PIPELINE: Dr. Smith

~~SECRET~~ STATE

ABLE TOOL

QASB	QAS	ANCODES
<u>3000</u>	LOS.	

EXPLORING ANODE	NO


DEPTH, FT.	DRILLER'S LOG	EXPLORING ANODE TO STRUCTURE		NO COKE	WITH COKE	ANODE NO.	DEPTH, TOP OF ANODES
		E	I				
	First 10 water #120						
	0-200 sand						
200			3.2				
5	Top of KIDA Anodes		3.4		3.7		205
10			3.6		5.8		
5			3.6				
20			3.5				
5			3.2				
30			3.9				
5			3.0				
40			3.2				240
5			2.9				
50			2.7				
5			1.9				
60			1.0				
5			0.9				
70			0.9				
5			1.0				
80			1.3				
5			1.6				
90			1.4				
5			1.0				
340	T.D. 300						

GROUNDING RESISTANCE: (1) VOLTS 11.4 - AMPS 5.8 - 1926 OHMS

(b) VERBODEN TOEGANG CHM 13

GENERAL CATHODIC PROTECTION SERVICES CO.

KEYWORDS:

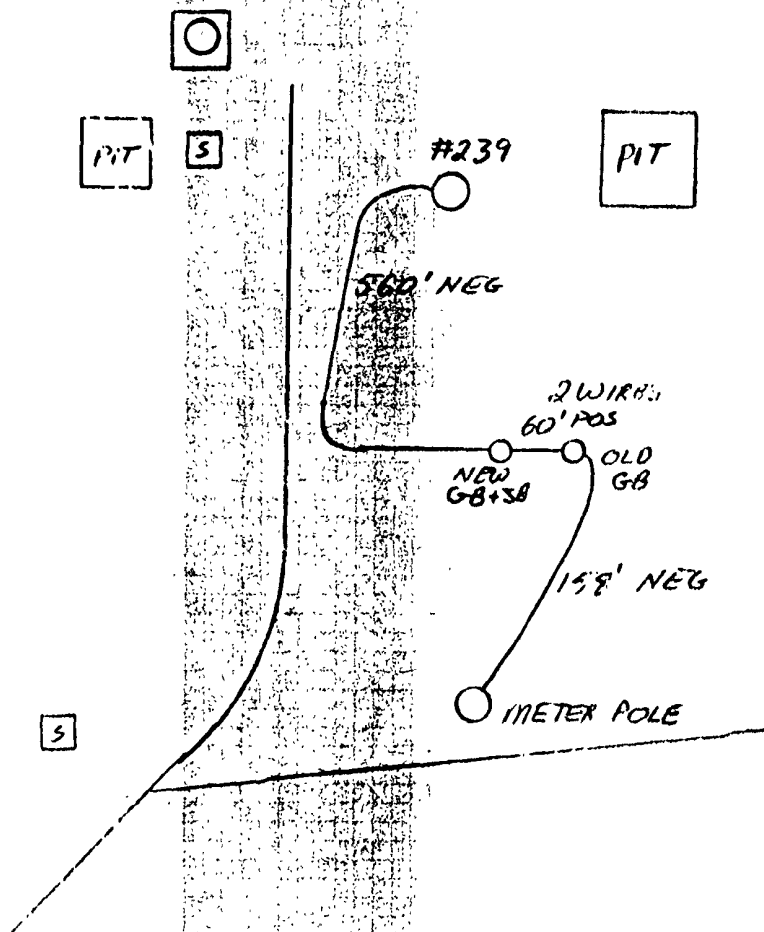

CPS 684

Cathodic Protection Services

A LUKENS COMPANY

RINCON UNIT #239
" " #97

DES CF
DR JK
SCALE NONE

CK
APP
DATE 12-11-89

DWG NO
REV.
00027 - 17

NO

REV'S ON

DATE