

**NEW MEXICO OIL, GAS AND MINERAL COMMISSION  
WELL LOCATION AND ACREAGE DEDICATION PLAT**

Form No. 1  
Supersedes Form  
Effective 1-1-87

All distances must be from the outer boundaries of the Section.

Operator <b>Robert L. Bayless</b>			Lease <b>JICARILLA CONTRACT 491</b>		Well No. <b>1</b>
Unit Letter <b>J</b>	Section <b>32</b>	Township <b>28N</b>	Range <b>2W</b>	County <b>Rio Arriba</b>	
Actual Footage Location of Well: <b>1585</b> feet from the <b>South</b> line and <b>1505</b> feet from the <b>East</b> line					
Ground Level Elev. <b>7115</b>	Producing Formation <b>Gallup</b>		Pool <b>Undesignated Gallup</b>		Dedicated Acreage: <b>160</b> Acres

1. Outline the acreage dedicated to the subject well by colored pencil or hatchure marks on the plat below.
2. If more than one lease is dedicated to the well, outline each and identify the ownership thereof (both as to working interest and royalty).
3. If more than one lease of different ownership is dedicated to the well, have the interests of all owners been consolidated by communitization, unitization, force-pooling, etc?

☐ Yes ☐ No If answer is "yes," type of consolidation \_\_\_\_\_


If answer is "no," list the owners and tract descriptions which have actually been consolidated. (Use reverse side of this form if necessary.) \_\_\_\_\_

No allowable will be assigned to the well until all interests have been consolidated (by communitization, unitization, forced-pooling, or otherwise) or until a non-standard unit, eliminating such interests, has been approved by the Commission.

**RECEIVED**

**DEC 29 1987**

**OIL CON. DIV  
DIST. 3**

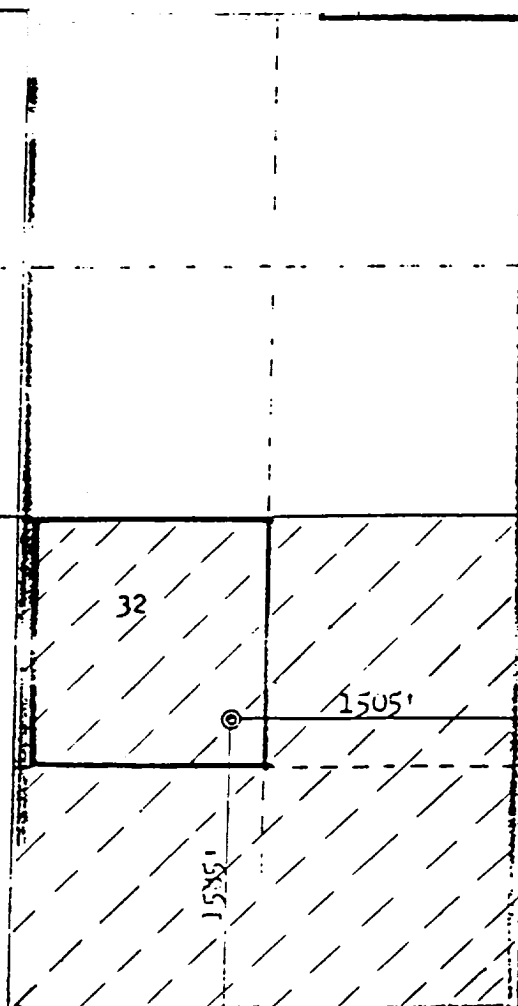

**CERTIFICATION**

I hereby certify that the information contained herein is true and complete to the best of my knowledge and belief.

Position *Robert L. Bayless*  
Operator

Company  
**Robert L. Bayless**

Date  
**9/24/87**

I hereby certify that the well location shown on this plat was plotted from field notes of actual surveys made by me or under my supervision, and that the same is true and correct to the best of my knowledge and belief.

Date Surveyed  
**May 20, 1985**  
Registered Professional Engineer  
*Frederick B. Smith*  
**FREDERICK B. SMITH**

Scale: 1"=100'