

UNITED STATES
DEPARTMENT OF THE INTERIOR
BUREAU OF LAND MANAGEMENT

Sundry Notices and Reports on Wells

1. Type of Well GAS	5. Lease Number SF-078771
2. Name of Operator Meridian Oil Inc. New	6. If Indian, All.or Tribe Name
3. Address & Phone No. of Operator Box 4289, Farmington, NM 87499 (505) 326-9700	7. Unit Agreement Name Rosa Unit
4. Location of Well, Footage, Sec, T, R, M. 1585'N, 1070'E Sec.14, T-31-N, R-6-W, NMPM	8. Well Name & Number Rosa Unit #212
	9. API Well No.
	10. Field and Pool Basin Fruitland Coal
	11. County and State Rio Arriba County, NM
12. CHECK APPROPRIATE BOX TO INDICATE NATURE OF NOTICE, REPORT, OTHER DATA	
Type of Submission	Type of Action
☐ Notice of Intent	☐ Abandonment
☐ Subsequent Report	☐ Recompletion
☐ Final Abandonment	☐ Plugging Back
	☐ Casing Repair
	☐ Altering Casing
	☐ Other
	☐ Change of Plans
	☐ New Construction
	☐ Non-Routine Fracturing
	☐ Water Shut Off
	☐ Conversion to Injection

13. Describe Proposed or Completed Operations

Attached is a copy of the C-102, cut and fill diagram, and well laydown showing the revised location of this well.

RECEIVED

JUL 25 1990

OIL CON. DIV.
DIST. 3

14. I hereby certify that the foregoing is true and correct
Signed [Signature] Title Regulatory Affairs Date 5-15-90

(This space for Federal or State office use)

APPROVED BY _____ TITLE _____
CONDITION OF APPROVAL, IF ANY:

APPROVED
AS AMENDED
JUL 25 1990
[Signature] Ron Fellows
AREA MANAGER

Submit to Appropriate
District Office
State Lease - 4 copies
Fee Lease - 3 copies

State of New Mexico
Energy, Minerals and Natural Resources Department

Form C-102
Revised 1-1-89

OIL CONSERVATION DIVISION

P.O. Box 2088
Santa Fe, New Mexico 87504-2088

DISTRICT I
P.O. Box 1980, Hobbs, NM 88240

DISTRICT II
P.O. Drawer DD, Artesia, NM 88210

DISTRICT III
1000 Rio Brazos Rd., Aztec, NM 87410

WELL LOCATION AND ACREAGE DEDICATION PLAT

All Distances must be from the outer boundaries of the section

Operator Meridian Oil Inc.			Lease Rosa Unit (SF-078771)		Well No. 212
Unit Letter H	Section 14	Township 31 North	Range 6 West	County Rio Arriba	
Actual Footage Location of Well: 1585 feet from the North line and 1070 feet from the East line					
Ground level Elev. 6342'	Producing Formation Fruitland Coal		Pool Basin	Dedicated Acreage: 320 Acres	

1. Outline the acreage dedicated to the subject well by colored pencil or hatchure marks on the plat below.
2. If more than one lease is dedicated to the well, outline each and identify the ownership thereof (both as to working interest and royalty).
3. If more than one lease of different ownership is dedicated to the well, have the interest of all owners been consolidated by communitization, unitization, force-pooling, etc.?
☒ Yes ☐ No If answer is "yes" type of consolidation unitization
If answer is "no" list the owners and tract descriptions which have actually been consolidated. (Use reverse side of this form if necessary).
No allowable will be assigned to the well until all interests have been consolidated (by communitization, unitization, force-pooling, or otherwise) or until a non-standard unit, eliminating such interest, has been approved by the Division.

OPERATOR CERTIFICATION

I hereby certify that the information contained herein is true and complete to the best of my knowledge and belief.

Signature Peggy Bradfield

Printed Name Peggy Bradfield

Position Regulatory Affairs

Company Meridian Oil Inc.

Date 5-15-90

SURVEYOR CERTIFICATION

I hereby certify that the well location shown on this plat was plotted from field notes or actual surveys made by me or under my supervision, and that the same is true and correct to the best of my knowledge and belief.


Date Surveyed 4-17-90

Signature Neale C. Edwards
Professional Surveyor



Certificate No. 6857

Neale C. Edwards

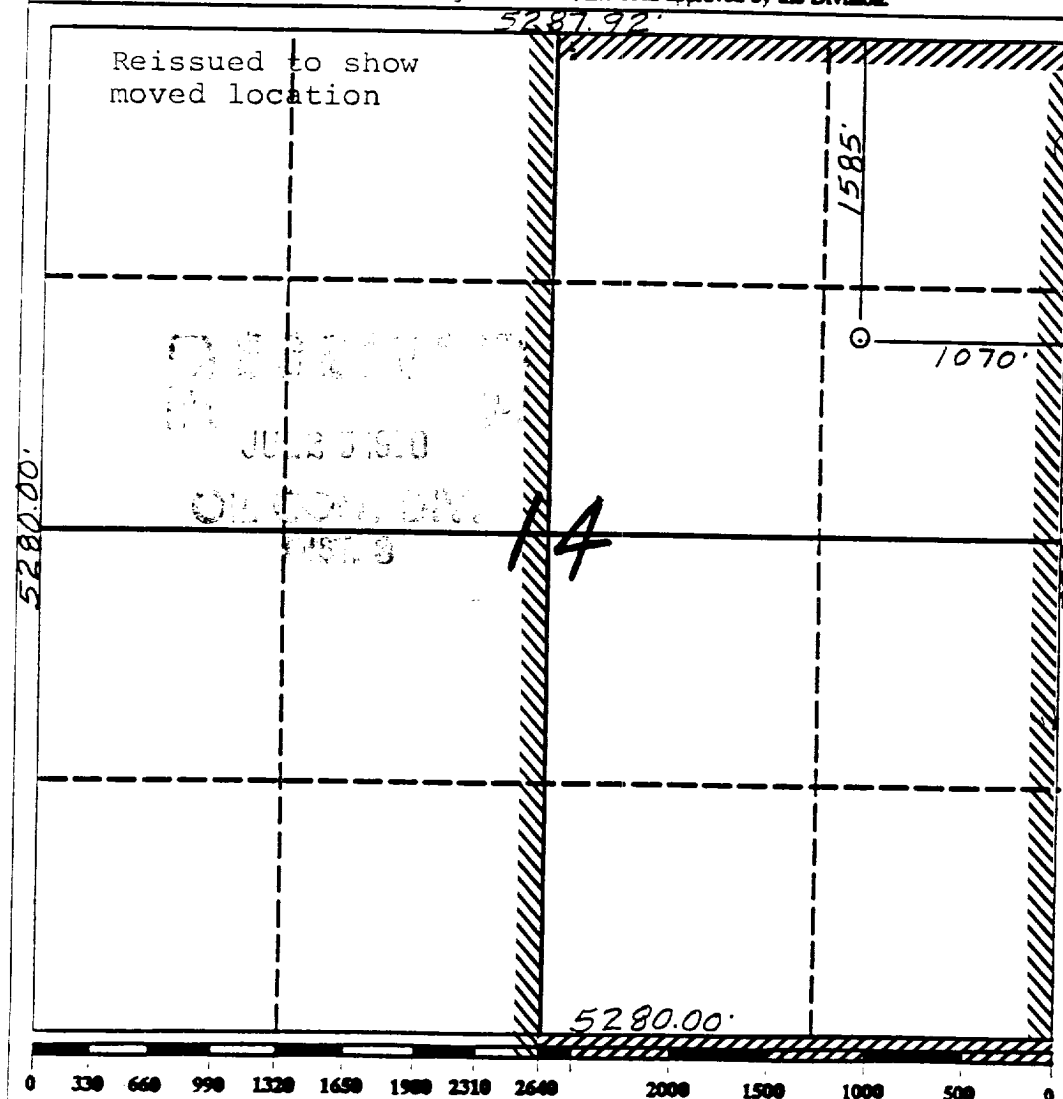


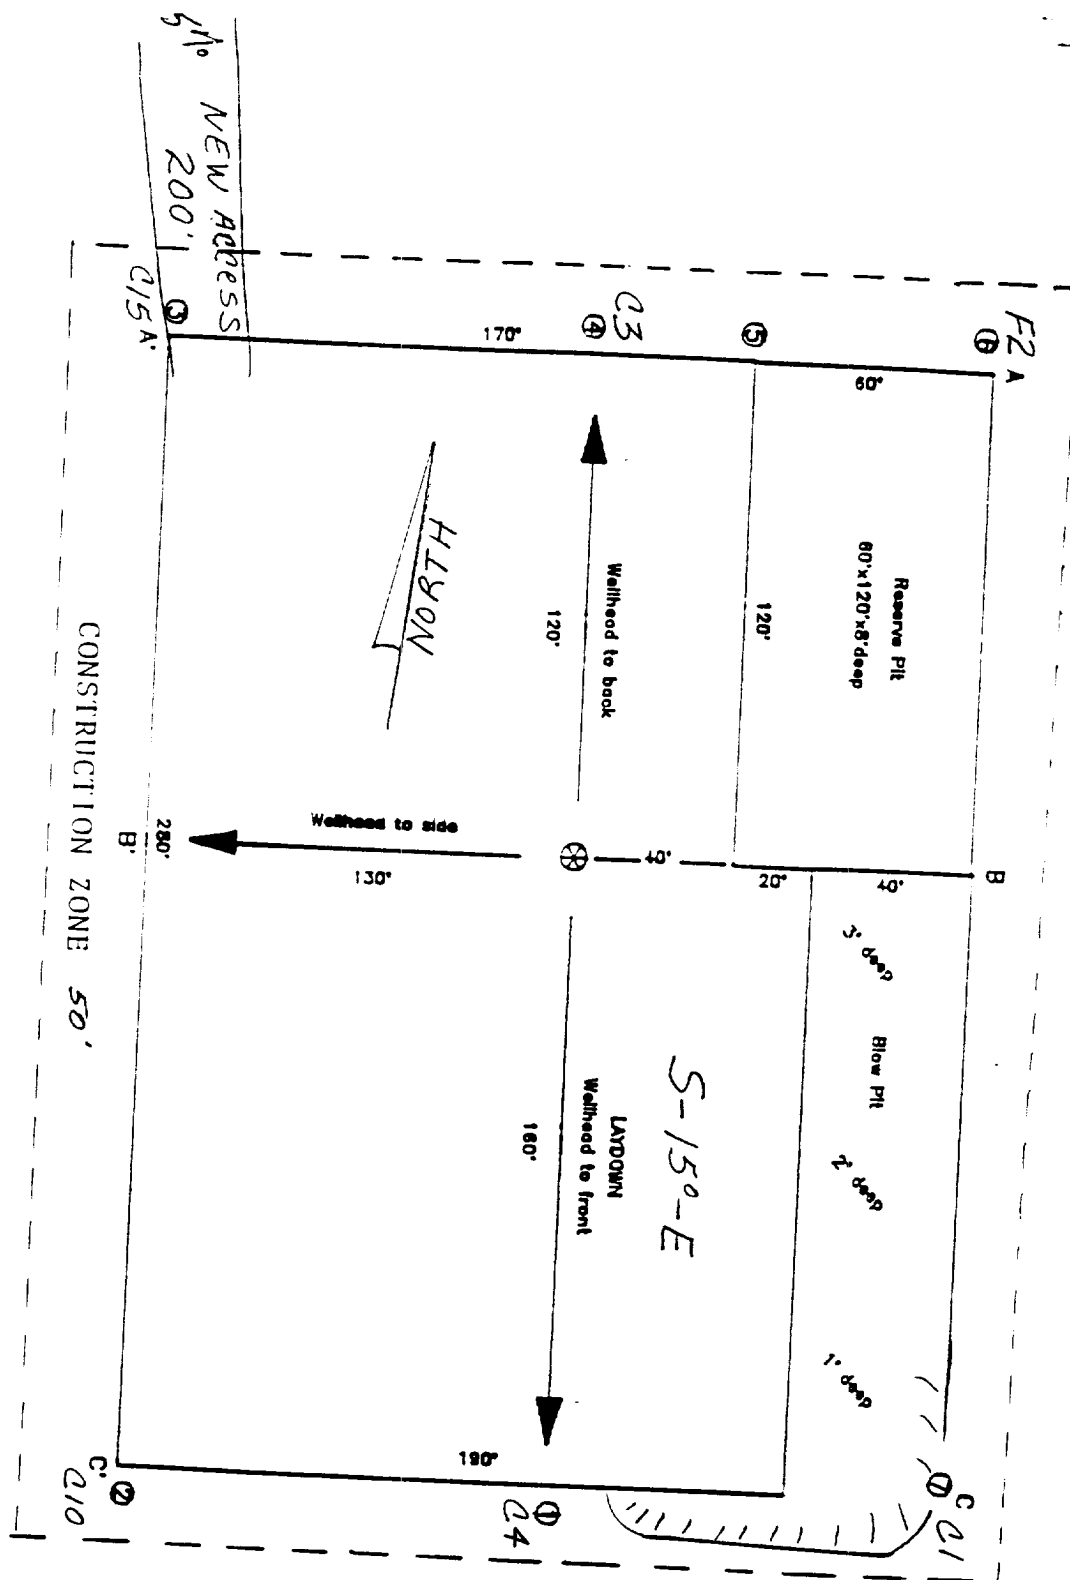


EXHIBIT:	
Name:	MOI ROSA UNIT #212
Footage:	1585 FNL 1070 FEL
Sec:	14 T-31-N, R-6-W NMPM
Co:	RIO ARRIBA St. N.M.
Elevation:	6342' Date: 4-17-90


A - A' Vert.: 1" = 20' Horiz.: 1" = 50'

C/L

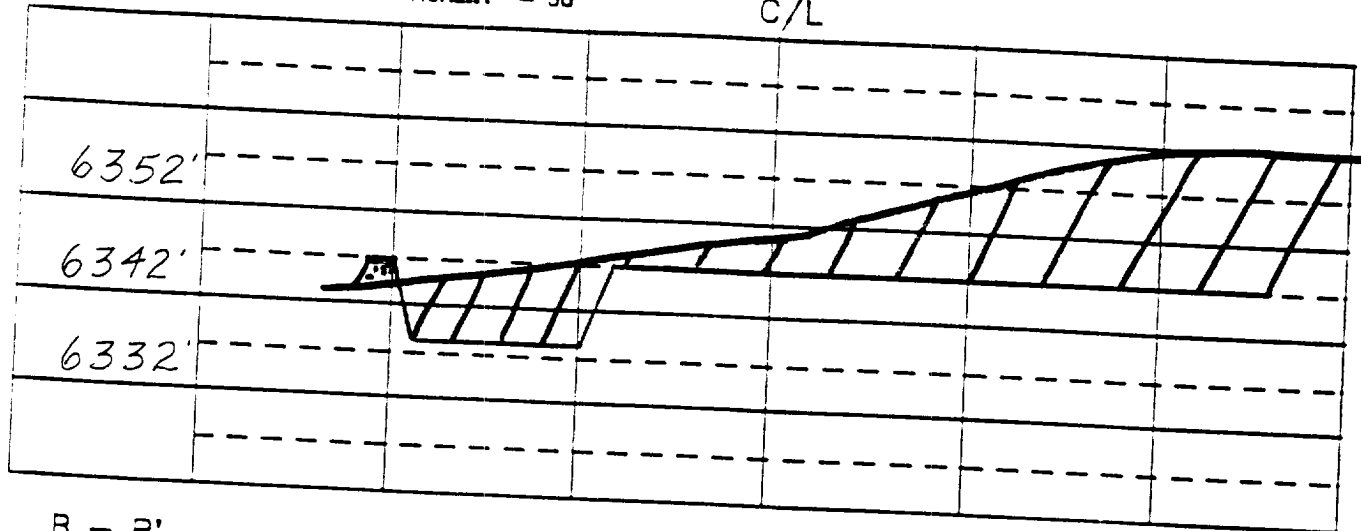

B - B'

C/L

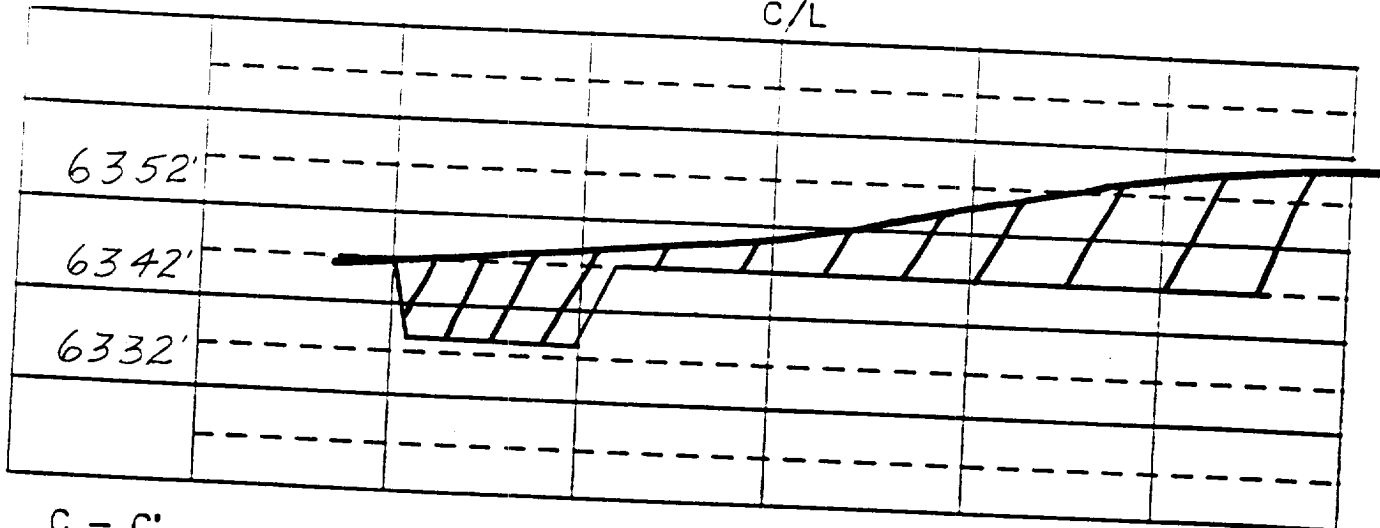

C - C'

C/L

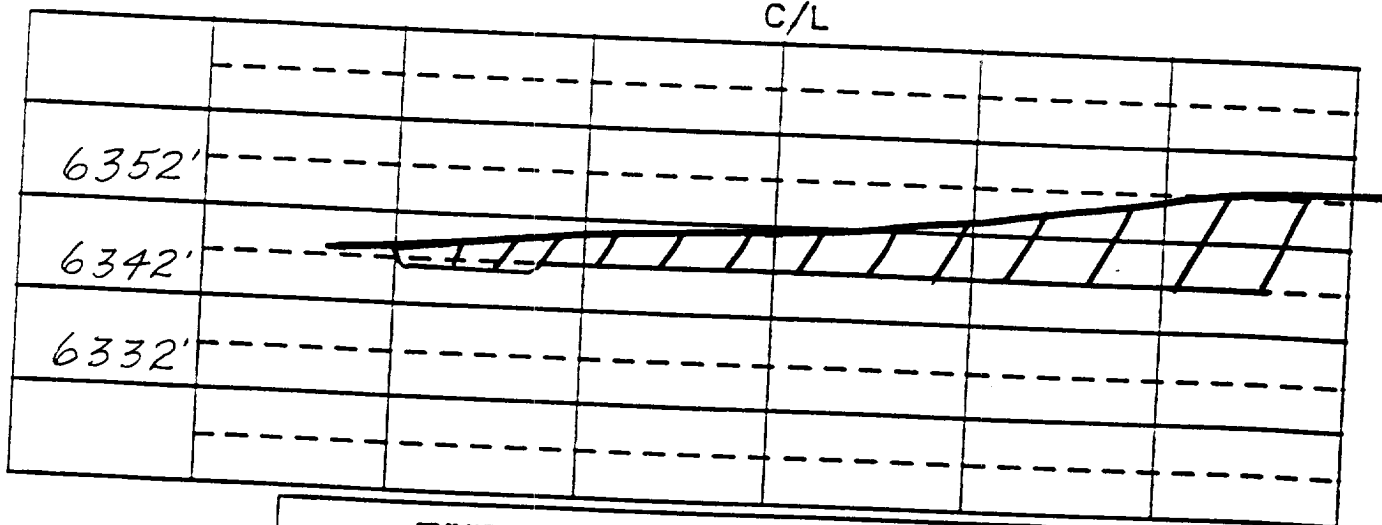


EXHIBIT:

Name: MOI ROSA UNIT #212
 Footage: 1585 FNL 1070 FEL
 Sec 14 T- 31 -N,R- 6 -W NMPM
 Co. RIO ARRIBA St. N.M.
 Elevation: 6342' Date: 4-17-90

Plot XC
2/4/90