Rec'd 9/24/2020 - NMOCD State of New Mexico DISTRICT I Energy, Minerals & Natural Resources Department 1625 N. FRENCH DR., HOBBS, NM 88240 Phone: (575) 393-6161 Fax: (575) 393-0720 DISTRICT II 811 S. FIRST ST., ARTESIA, NM 88210 Phone: (575) 748-1283 Fax: (575) 748-9720 CONSERVATION DIVISION Revised August 1, 2011 Submit one copy to appropriate 1220 SOUTH ST. FRANCIS DR. District Office DISTRICT III 1000 RIO BRAZOS RD., AZTEC, NM 87410 Phone: (505) 334-6178 Fax: (505) 334-6170 Santa Fe, New Mexico 87505 DISTRICT IV 1220 S. ST. FRANCIS DR., SANTA FE, NM 87505 Phone: (505) 476-3460 Fax: (505) 476-3462 X AMENDED REPORT As Drilled WELL LOCATION AND ACREAGE DEDICATION PLAT API Number Pool Code Pool Name 98098 WC-025 G-09 S243532M; WOLFBONE 30-025-46556 Property Code Property Name Well Number STOVE PIPE FEDERAL COM 601H 315644 OGRID No. Operator Name Elevation COG OPERATING, LLC 229137 3321.7 Surface Location UL or lot No. Section Township Range Lot Idn Feet from the North/South line Feet from the East/West line Ν 31 24 - S35 - E270 SOUTH 2160 WEST Bottom Hole Location If Different From Surface UL or lot No. Section Township Range Lot Idn Feet from the North/South line Feet from the East/West line Ν 25 - S35 - F53 SOUTH 1835 WEST Dedicated Acres Joint or Infill Consolidation Code Order No. 639.08 NO ALLOWABLE WILL BE ASSIGNED TO THIS COMPLETION UNTIL ALL INTERESTS HAVE BEEN CONSOLIDATED OR A NON-STANDARD UNIT HAS BEEN APPROVED BY THE DIVISION SEE PAGE 2

County

LEA

County


LEA

PAGE 1 OF

DRAWN BY: WN

W.O. #20-1249

Property Code	ode Property Name							
315644	STOVE PIPE FEDERAL COM	601H						
OGRID No.	Operator Name	Elevation						
229137	COG OPERATING, LLC	3321.7'						

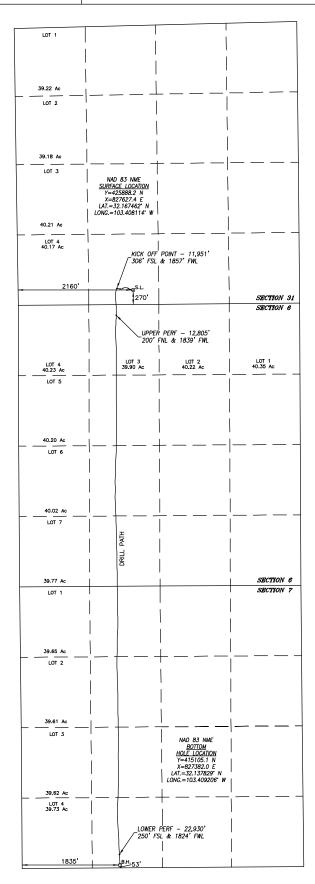

SURFACE INFO AND BOREPATH SHOWN HEREON SOLACE IN ANY BORDARY SURVEY REPORT PROVIDED BY COG OPERATING, LLC FOR THE STOVE PIPE FEBERAL COM #601H SUPPLIED TO HARCROW SURVEYING, LLC ON SEPTEMBER 18,

1800 0 1800 SCALE: 1"=1800

OPERATOR CERTIFICATION

I hereby certify that the information herein is true and complete to the best of my knowledge and belief, and that this organization either owns a working interest or unleased mineral interest in the land including the proposed bottom hole location or has a right to drill this well at this location pursuant to a contract with an owner of such mineral or working interest, or to a voluntary pooling agreement or a compulsory pooling order heretofore entered by the division.

Amanda Avery 9/22/20 Signature Date

Amanda Avery

Printed Name

aavery@concho.com


E-mail Address

SURVEYOR CERTIFICATION

I hereby certify that the well location shown on this plat was plotted from field notes of actual surveys made by me or under my supervision, and that the same is true and correct to the best of my belief.

OCT. 24, 2019/FEB. 10, 2020

Date of Survey/Date of Geographic Survey

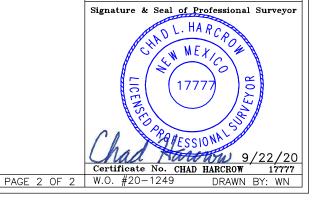

Intent As Drilled X API #							Rec'd 9/24/2020 - NMOCD							
30-025-46556 Operator Name: COG OPERATING, LLC						Property Name: STOVE PIPE FEDERAL COM							Well Number 601H	
Kick C	Kick Off Point (KOP)													
UL N	Section 31	Township 24S	Range 35E	Lot	Feet 306		From N		Feet 1857		n E/W	County LEA		
Latitu	Latitude Longi										<u> </u>	NAD 83		
First Take Point (FTP)														
UL 3	Section 6	Township 25S	Range 35E	Lot	Feet 200		From N		Feet 1839	From	n E/W ST	County		
Latitude Lon						ıde .409	NAD 83							
Last T	Last Take Point (LTP)													
UL N	Section 7	Township 25S	Range 35E	Lot	Feet 250		m N/S UTH	Feet From F		m E/W				
Latitude					Longitu	Longitude NAD 83								
Is this well the defining well for the Horizontal Spacing Unit? No														
Is this well an infill well? Yes														
If infill is yes please provide API if available, Operator Name and well number for Defining well for Horizontal Spacing Unit.														
API #	025-4650	00												
Operator Name:						Property Name:							Well Number	
COG Operating LLC						Stove Pipe Federal Com						603H		