

MEXICO OIL CONSERVATION COMMISSION  
WELL LOCATION AND ACREAGE DEDICATION

RECORD COPY  
ODESSA CENTRAL FILES

All distances must be from the outer boundaries of the Section

Phillips Petroleum Company			
Section	Section	Range	Merchandise
D	22	17 South	35 East
660		North	660
Initial Elevation 3949.8'		Vacuum Grayburg San South Shoe Bar Atoka Andes	
Atoka San Andres		460 40	

State 22


Lea

- Outline the acreage dedicated to the subject well by colored pencil or hachure marks on the plat below.
- If more than one lease is dedicated to the well, outline each and identify the ownership thereof (both as to working interest and royalty).
- If more than one lease of different ownership is dedicated to the well, have the interests of all owners been consolidated by communitization, unitization, forced-pooling etc?

Yes  No      If answer is "yes" type of consolidation \_\_\_\_\_

If answer is "no" list the owners and tract descriptions which have actually been consolidated. (See reverse side of this form if necessary.)

No allowable will be assigned to the well until all interests have been consolidated (by communitization, unitization, forced-pooling, or otherwise) or until a non-standard unit, eliminating such interests, has been approved by the Commission.

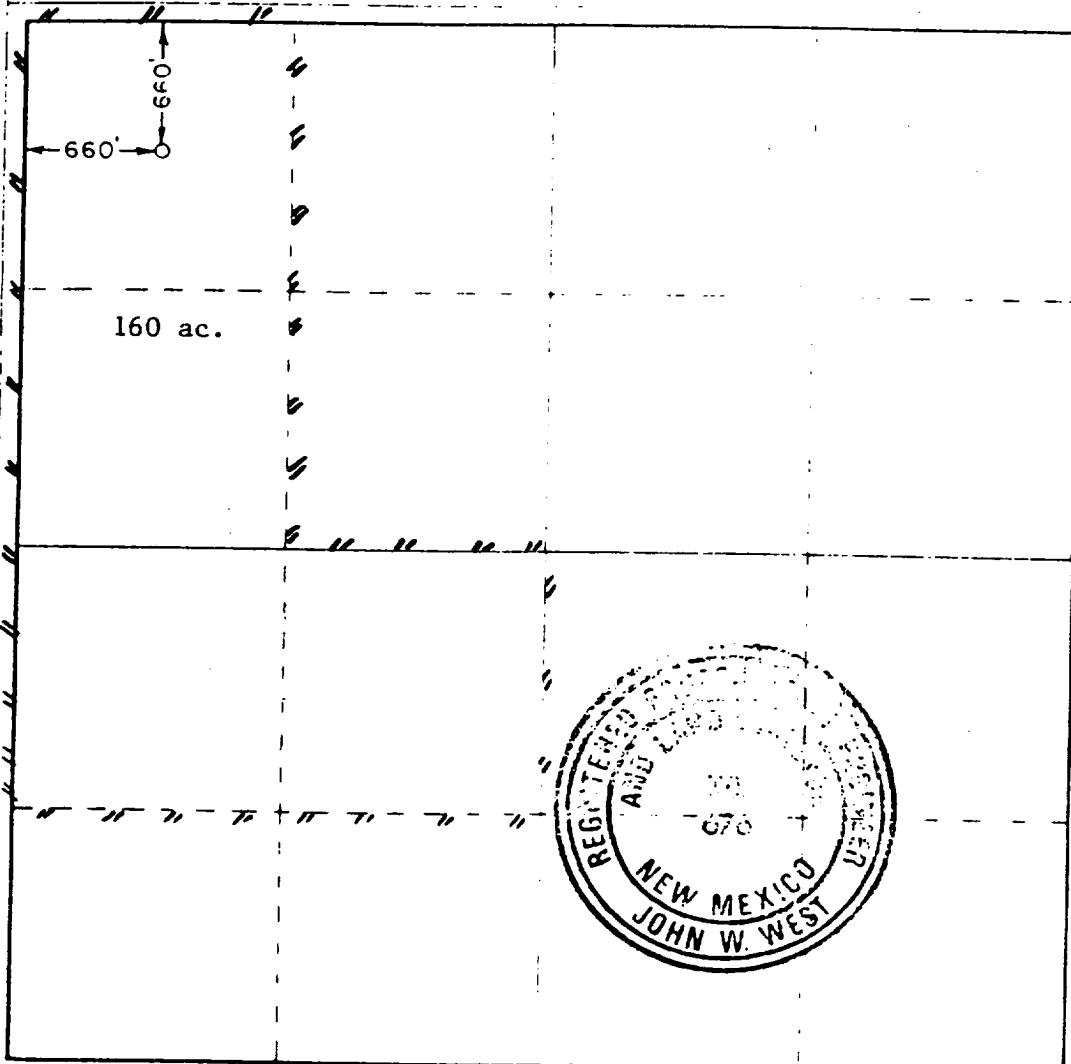

CERTIFICATION

I hereby certify that the information contained herein is true and complete to the best of my knowledge and belief.

Larry M. Sanders

Supervisor, Regulation & Protection  
Phillips Petroleum Co.

2/14/89

I hereby certify that the well location shown on this plat was plotted from field notes of actual surveys made by me or under my supervision and that the same is true and correct to the best of my knowledge and belief.

Certificate No. JOHN W. WEST  
RONALD J. SUDNICK, S.R.P.