elvel by OCD:4 #407W Submit 1	<b>8/1/7/2021 74.</b> Copy To Approprie	<b>40:34</b>			of Nev									ages1 o
District Office			Energ	gy, Mine	rals and	Natui	al Resour	ces	Timer	L API N		Revised	July 18,	2013
<u>District I</u> – (575) 3 1625 N. French Dr		40		CONTRE	on ar a or	**************************************	D II		WEI	LL API N	o. - <b>30-025</b> -	28612		
District II - (575)	748-1283						DIVISIO	)N	5. In	dicate Ty			·	•••••
811 S. First St., Ar <u>District III</u> – (505)	334-6178			1220 Sc						STATE		FEE		
1000 Rio Brazos R District IV - (505)	Rd., Aztec, NM 874	410		Santa	a Fe, N	M 87	505		6. S	tate Oil &	Gas Lea	se No.		
1220 S. St. Francis		1												
87505	CYDIDDY	NOTIC	TEG AND I	EDODE	2 031 117	TI I C	<del></del>		- x		** *.			
(DO NOT USE TH	SUNDRY I HIS FORM FOR P						IG BACK TO	) A	/. L	ease Nam	e or Unit State 26		nent Na	me
DIFFERENT RES	ERVOIR. USE "A	APPLIC.	ATION FOR	PERMIT" (	FORM C-	101) FO	R SUCH		8 V	/ell Numb		COM		
PROPOSALS.)  1. Type of We	ell: Oil Well	X (	Gas Well	Other					0. ,	CII I TUIII	7CI 175			
<ol><li>Name of Op</li></ol>	perator						·		9. C	GRID Nu	ımber			
CrownQuest (		<u>.C</u>							2131					
3. Address of <b>P.O. Box 5331</b>		W 707	10							Pool name	e or Wild	cat		
		A /9/	10				*		Tull	; Penn				
4. Well Locati			CCO 6.				,,	4000						
Section	Letter N 26	-		et from th			line and _	1900		eet from		w	line	
Section	011 20			nip 14S		ange	33E RKB, RT,		MPM		County	/ Lea		
			3117' GR		w whethe	er DK,	KKD, KI,	GK, etc.,	,					
of start propose 07/19/2 well he surface Perf'd 07/23/2	pe proposed or ing any proposed completion of MIRU Plug and, NU BOP.  E. Pressure tes  7050'. Press  1 RD tbg ton	ed wor or reco ging e POH ted cs; ssured gs, ND	rk). SEE R ompletion. equipment. w/ 155 star g, held 500 up on person BOP, ND	Began P ids of the PSI. Spo fs to 500 8 5/8" w	OH w/r g and an otted 25 PSI. Spe ell head	ods. 0 chor. ( sx class otted 3 , RU C	7/20/21 Fi 07/21/21 S ss H cmt @ 5 sx class Csg jacks.	nished I et 5 ½" @ 9625-9 C cmt @ Pulled s	mpletion POH v CIBP 9427'. @ 7100 tretch	ons: Attac v/ rods & @ 9625'. WOC. 07 0-6754'. V on csg, 5	pump. I Circ'd : //22/21 T VOC. Ta	ore diagrams Oug out 230 BB agged pl gged pl ree @ 4	cellar, LS ML blug @ lug @ 6	ND F to 9410'. 820'.
RD csg C cmt H20.Pi Tagged Moved	RIH w/ wireling tongs & tools tongs & tools @ 1850-1605' ressured up to d plug @ 120'. i in backhoe ange. Welded on	s. Spot . WOO 1000 . Perf nd wel	tted 65 sx c C. Tagged   PSI. Spotte d @ 100'. S lder, Cut o	class C cn plug @ 1 ed 130 sx Sqz'd 100 ff well he	nt @ 420 650'. Pe class C ) sx clase ad, Ker	06-396 rf'd @ emt @ s C en ry Foi	1'. WOC. 2 425'. ND 2 475' to s at @ 100' tner w/ N	07/27/2 BOP, Nurface. I & circul M OCD	I Tagg NU 8 5 Pushed lated to verifi	ged plug ( /8" well h d cmt dov o surface ed cmt @	@ 3937'. lead. Pur vn to 110 . Rigged ) surface	Spotte np'd 20 )'. WOO down & via pic	d 65 sx ) bbls B C. <mark>07/28</mark> & move ture tex	class rine 3/21 d off.
Spud Date:				T r	Rig Relea	ace De	ta:		· · · · · · · · · · · · · · · · · · ·					
					us Neice	we Da	ω.							
hereby certify	that the inform	ation a	above is tru	e and con	iplete to	the be	st of my ki	nowledg	e and l	pelief.	Miss	ing sign	ature/on	line filing
		_	<b>-</b> 1-		-		•	J						
GIGNATURE_	My	<del> </del>	toh		TITLE_	Regul	atory	······			_DATE_	10/12/2	021	
Type or print na  For State Use C		Ritchie		·	E-mail a	ddress	ann.wto	r@gmail	l.com		PHONE	: 432 6	84-6381	

1507

2548

3443

4073

6882

7610

8928 9537

9849

Formation Top

Änhy

Yates

Queen

Tubb

Penn Cisco


Abo

San Andres

Wolfcamp

CrownQue	est	PLUGGED	
Author:	Abby BCM		
Well Name	State 26 Com	Well No.	#5
Field/Pool	Tulk;Penn	API #:	30-025-28612
County	Lea	Location:	Sec 26, 14S,33E
State	New Mexico		660' FSL & 1900' FWL
Spud Date —	······································	— GL:	

Description	O.D.	Grade	Weight	Depth	Hole	Cmt Sx	TOC
Surface Csg	13 3/8	K55	68#	410	17 1/2	400	0
Inter Csg	8 5/8	\$80 &J55	24 &28#	4,100	11	1,600	0
Prod Csg	5 1/2	S95 &	17 & 20#	10,000	7 7/8	715	7,704

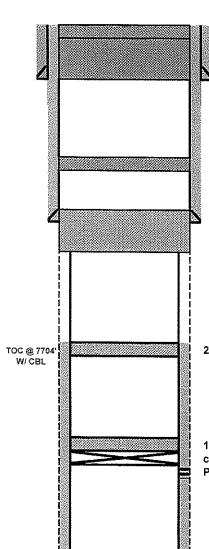

4. Sqz'd 100 sx class C cmt @ 100' & circulated to surface.

13 3/8 68# CSG @ 410

5. Perf'd @ 425'. ND BOP, NU 8 5/8" well head. Pressured up to 1000 PSI. Spotted 130 sx class C cmt @ 475' to surface. Pushed cmt down to 110'. WOC. Tagged plug @ 120'

4. Spotted 65 sx class C cmt @ 1850-1605'. WOC. Tagged plug @ 1650'.

8 5/8 24 &28# CSG @ 4,100


3. Cut 5 1/2" csg @ 4156'. POH a total of 93 jts of 5  $\frac{1}{2}$ " csg. Spotted 65 sx class C cmt @ 4206-3961'. WOC. Tagged plug @ 3937'.

2. Spotted 35 sx class C cmt @ 7100-6754'. WOC. Tagged plug @ 6820'.

1. Set 5 %" CIBP @ 9625'. Circ'd 230 BBLS MLF to surface. Pressure tested csg, held 500 PSI. Spotted 25 sx class H cmt @ 9625-9427'. WOC & Tagged @ 9410'. Perfs @ 9677-9881'

5 1/2 17 & 20# CSG @ 10,000

## Date Spudded: 3/16/84 KB: 4298' KB, 4283' GL

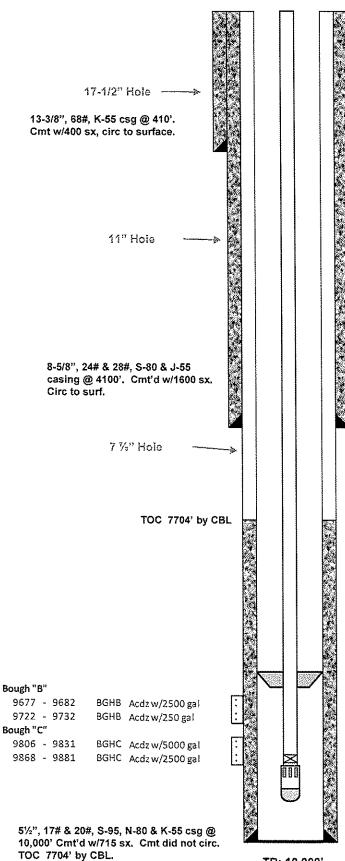

TD: 10,000' PBTD: 9942'

Drawn by: DLR, 4/11

Released to Imaging: 6/11/2021 10:24:14 AM

## CrownQuest Operating, LLC State 26 Com #5

Current Rod & Tbg Setup

660' FSL, 1900' FWL, Sec. 26, T-14-S, R-32-E, Lea County, NM, API #30-025-28612

Last Production Date: 2/22/2016				
Date	Type	Days		
10/5/2012	HIT			
4/1/2013	HIT	178		
7/1/2013	HIT	91		
1/10/2014	Pump	193		
6/24/2014	НІТ	165		
7/3/2014	Part	9		
10/1/2014	HIT	90		
6/1/2015	НІТ	243		
12/2/2015	HIT	184		
2/22/2016	НІТ	82		

Pumping Unit Setup (12-28-10)

Bethlehem C320-298-100	
Stroke Length:	100 in
SPM:	4.9
Approx. Pump Spacing:	in
Motor:	Ajax E-42

Rod Record (12-28-10)

1	Polish Rod	26.00	ft
2	1" Pony rods	6.00	ft
98	1" N97 rods	2,450.00	ft.
137	7/8" N97 rods	3,425.00	fŧ
141	3/4" N97 rods	3,525.00	ft
16	1" Dbar	400.00	ft
1	Stab Sub	4.00	ft
1	2.0" x 1.50" Pump	24.00	ft
	Total Length	9,860.00	ft

**Tubing Record (12-28-10)** 

1	KB Delta	10.00	ft
303	Jts 2-7/8" 6.5# N-80 Tbg (±)	9,623.28	ft
1	2-7/8" x 5-1/2" TAC	2.75	ft
7	Jts 2-7/8" 6.5# N-80 Tbg (±)	222.32	ft
1	2-3/8" CT SN	1.10	ft
1	Perf Sub	4.00	ft
1	Jts 2-7/8" 6.5# N-80 MH	31.00	ft
	Total Length	9,894.45	ft
	TAC Depth:	9,633.28	ft
	SN Depth:	9,858.35	ft

District I
1625 N. French Dr., Hobbs, NM 88240
Phone: (575) 393-6161 Fax: (575) 393-0720

District II 811 S. First St., Artesia, NM 88210 Phone:(575) 748-1283 Fax:(575) 748-9720

District III 1000 Rio Brazos Rd., Aztec, NM 87410 Phone:(505) 334-6178 Fax:(505) 334-6170

1220 S. St Francis Dr., Santa Fe, NM 87505 Phone:(505) 476-3470 Fax:(505) 476-3462

**State of New Mexico Energy, Minerals and Natural Resources Oil Conservation Division** 1220 S. St Francis Dr. **Santa Fe, NM 87505** 

CONDITIONS

Action 42546

## **CONDITIONS**

Operator:	OGRID:
CROWNQUEST OPERATING, LLC	213190
P.O. Box 53310	Action Number:
Midland, TX 79710	42546
	Action Type:
	[C-103] Sub. Plugging (C-103P)

## CONDITIONS

Created By	Condition	Condition Date
kfortner	None	10/13/2021