Office	State of New Mexico	Form C-103 <sup>1</sup> of		
<u>District I</u> – (575) 393-6161 Energy 1625 N. French Dr., Hobbs, NM 88240	, Minerals and Natural Resources	Revised July 18, 2013 WELL API NO. 30-025-50159		
<u>District II</u> – (575) 748-1283 811 S. First St., Artesia, NM 88210 OIL C				
<u>District III</u> – (505) 334-6178 1000 Rio Brazos Rd., Aztec, NM 87410	istrict III – (505) 334-6178 1220 South St. Francis Dr.			
District IV – (505) 476-3460	Santa Fe, NM 87505	STATE X FEE 6. State Oil & Gas Lease No.		
1220 S. St. Francis Dr., Santa Fe, NM 87505				
SUNDRY NOTICES AND RI	EPORTS ON WELLS	7. Lease Name or Unit Agreement Name		
(DO NOT USE THIS FORM FOR PROPOSALS TO DRILL DIFFERENT RESERVOIR. USE "APPLICATION FOR PI PROPOSALS.)	Eric Cartman 31 State Com			
1. Type of Well: Oil Well X Gas Well	8. Well Number 504H			
2. Name of Operator Permian Resource	9. OGRID Number 372165			
3. Address of Operator 300 N. Marienfeld	d St., Suite 1000	10. Pool name or Wildcat		
Midland, TX 797	01	Ojo Chiso; Bone Spring		
4. Well Location	o a Nighth as a	440		
	et from the North line and			
	ownship 21S Range 35E on (Show whether DR, RKB, RT, GR, etc.)	NMPM County Lea		
11. Elevano	3613			
12. Check Appropriate	Box to Indicate Nature of Notice	e, Report or Other Data		
NOTICE OF INTENTION	TO:   QII	BSEQUENT REPORT OF:		
	TO. SO ABANDON □ REMEDIAL WO			
TEMPORARILY ABANDON CHANGE F	_	RILLING OPNS. P AND A		
PULL OR ALTER CASING   MULTIPLE	<del></del>			
DOWNHOLE COMMINGLE	_	_		
CLOSED-LOOP SYSTEM	_	_		
OTHER:	OTHER:			
		and give pertinent dates, including estimated date Completions: Attach wellbore diagram of		
proposed completion or recompletion.	LE 19.13.7.14 NMAC. For Muniple C	completions. Attach wendore diagram of		
restant see-freeze				
Permian Resources respectfully re 160 acres.	equest to change our dedicate	ed acreage from 320 acres to		
Please see attached C-102.				
ricase see attached o roz.				
Spud Date:	Rig Release Date:			
I hereby certify that the information above is true	and complete to the best of my knowled	dge and belief.		
V ·	5 1. 0			
SIGNATURE 8	TITLE Regulatory Specia	DATE_4/30/24		
Type or print name Kanicia Schlichting	E-mail address: kanicia.schlichting	g@permianres.com PHONE: 432-400-0185		
For State Use Only	2 11111 4441 2551			
<del></del>		D. 1777		
	TITLE	DATE		
Conditions of Approval (if any):				

Township 21S

<u>District I</u> 1625 N. French Dr., Hobbs, NM 88240 Phone: (575) 393-6161 Fax: (575) 393-0720

District II Bit 1 S. First St., Artesia, NM 88210 Phone: (575) 748-1283 Fax: (575) 748-9720 District III 1000 Rio Brazos Road, Aztec, NM 87410 Phone: (505) 334-6178 Fax: (505) 334-6170

District IV 1220 S. St. Francis Dr., Santa Fe, NM 87505 Phone: (505) 476-3460 Fax: (505) 476-3462

State of New Mexico Energy, Minerals & Natural Resources Department OIL CONSERVATION DIVISION 1220 South St. Francis Dr. Santa Fe, NM 87505

Form C-102 Revised August 1, 2011 Submit one copy to appropriate District Office

■ AMENDED REPORT

LEA

<sup>17</sup>OPERATOR CERTIFICATION

to a contract with an owner of such a mineral or working interest, or to a voluntary pooling agreement or a compulsory pooling order heretofore entered by the division.

## WELL LOCATION AND ACREAGE DEDICATION PLAT

1 API Number 30-025-50159		<sup>2</sup> Pool Code 96553	³ Pool Name Ojo Chiso; Bone S	Spring
<sup>4</sup> Property Code 332793		5 Pr	operty Name AAN 31 STATE COM	<sup>6</sup> Well Number 504H
<sup>7</sup> OGRID №. 372165		Permian Res	orator Name Sources Operating, LLC	<sup>9</sup> Elevation 3612.9'


# <sup>10</sup> Surface Location

orth/South li NORTH

448

**EAST** 

"Bottom Hole Location If Different From Surface										
	UL or lot no.	Section	Township	Range	Lot Idn	Feet from the	North/South line	Feet from the	East/West line	County
	О	31	21S	35E		82	SOUTH	2222	EAST	LEA
	12 Dodinated Age	ne 13 L	sint or Infill	14 Conce	didation Code	15 Order No				

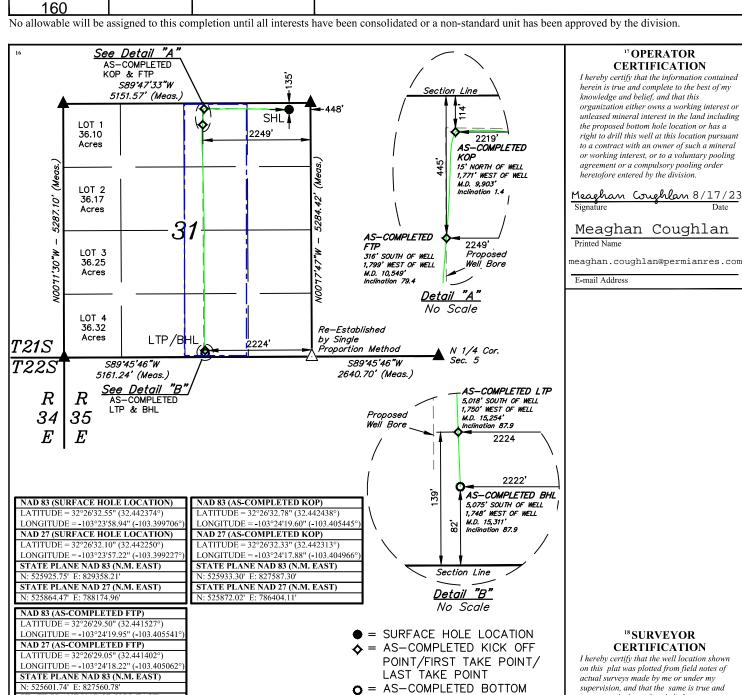


### 18 SURVEYOR CERTIFICATION

I hereby certify that the well location shown on this plat was plotted from field notes of actual surveys made by me or under my supervision, and that the same is true and correct to the best of my belief.

November 12, 2021

Date of Surve

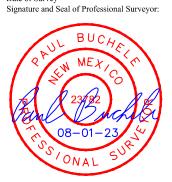

2000

POINT/FIRST TAKE POINT/ LAST TAKE POINT

AS-COMPLETED BOTTOM HOLE LOCATION

 $\triangle$  = SECTION CORNER LOCATED

 $\triangle$  = SECTION CORNER RE-ESTABLISHED.

(Not Set on Ground.) = AS-COMPLETED WELL BORE

- NOTE:

  Distances referenced on plat to section lines are perpendicular.

  Basis of Bearings is a Transverse Mercator Projection with a Central Meridian of W103°53'00' (NAD 83)

  As-Completed well head has not been field verified.

  Well Bore data provided by Centennial Resource Production, I

DRAWN BY: N.D.T. 08-01-23

SCALE

DISTANCE FROM FTP TO LTI

N: 520783.07' E: 786448.61 Rel<del>eased to Imaging: 5/1/2024 9:01:52 AM</del>

= -103°24'17.88" (-103.404966

STATE PLANE NAD 27 (N.M. EAST)

NAD 27 (AS-COMPLETED LTP)
LATITUDE = 32°25'42.53" (32.428481°)
LONGITUDE = -103°24'17.90" (-103.404
STATE PLANE NAD 83 (N.M. EAST)
N: 520901.11' E: 827629.48'

STATE PLANE NAD 27 (N.M. EAST)

NAD 27 (AS-COMPLETED BHL)

LATITUDE = 32°25'41.97" (32.428325°)

STATE PLANE NAD 83 (N.M. EAST)

STATE PLANE NAD 27 (N.M. EAST)

LONGITUDE

NAD 83 (AS-COMPLETED BHL)
LATITUDE = 32°25'42.42" (32.428449°)
LONGITUDE = -103°24'19.60" (-103.405444°

NAD 83 (AS-COMPLETED LTP)

District I
1625 N. French Dr., Hobbs, NM 88240
Phone: (575) 393-6161 Fax: (575) 393-0720 District II

811 S. First St., Artesia, NM 88210 Phone:(575) 748-1283 Fax:(575) 748-9720 District III

1000 Rio Brazos Rd., Aztec, NM 87410 Phone:(505) 334-6178 Fax:(505) 334-6170

1220 S. St Francis Dr., Santa Fe, NM 87505 Phone:(505) 476-3470 Fax:(505) 476-3462

**State of New Mexico Energy, Minerals and Natural Resources Oil Conservation Division** 1220 S. St Francis Dr. **Santa Fe, NM 87505** 

CONDITIONS

Action 339329

## **CONDITIONS**

Operator:	OGRID:
Permian Resources Operating, LLC	372165
300 N. Marienfeld St Ste 1000 Midland, TX 79701	Action Number: 339329
	Action Type: [C-103] NOI Change of Plans (C-103A)

### CONDITIONS

Created By	Condition	Condition Date
pkautz	None	5/1/2024