

OIL CONSERVATION DIVISION

P. O. BOX 2088
SANTA FE, NEW MEXICO 87501

Form C-103
Revised 10-1-78

NO. OF COPIES RECEIVED	
DISTRIBUTION	
SANTA FE	<input checked="" type="checkbox"/>
FILE	<input checked="" type="checkbox"/>
U.S.G.S.	
LAND OFFICE	
OPERATOR	<input checked="" type="checkbox"/>

5a. Indicate Type of Lease
State ☐ Fee ☒

5. State Oil & Gas Lease No.

SUNDRY NOTICES AND REPORTS ON WELLS
(DO NOT USE THIS FORM FOR PROPOSALS TO DRILL OR TO DEEPEN OR PLUG BACK TO A DIFFERENT RESERVOIR.
USE "APPLICATION FOR PERMIT -" (FORM C-101) FOR SUCH PROPOSALS.)

OIL ☐ GAS ☒ OTHER ☐

Name of Operator

YATES PETROLEUM CORPORATION

Address of Operator

207 South 4th Street, Artesia, New Mexico 88210

Location of Well

UNIT LETTER L 2265⁹ FEET FROM THE South LINE AND 756² FEET FROM

THE West LINE, SECTION 12 TOWNSHIP 10N RANGE 27E NMPM.

7. Unit Agreement Name

8. Farm or Lease Name

T-4 Filly's Tooth

9. Well No.

1

10. Field and Pool, or Wildcat

Undes. Penn

15. Elevation (Show whether DF, RT, GR, etc.)

4295⁷ GL

12. County

Quay

Check Appropriate Box To Indicate Nature of Notice, Report or Other Data

NOTICE OF INTENTION TO:

PERFORM REMEDIAL WORK ☐
TEMPORARILY ABANDON ☐
PULL OR ALTER CASING ☒

PLUG AND ABANDON ☐
CHANGE PLANS ☐

OTHER Resurvey, and correct name ☒

SUBSEQUENT REPORT OF:

REMEDIAL WORK ☐
COMMENCE DRILLING OPNS. ☐
CASING TEST AND CEMENT JOBS ☐

ALTERING CASING ☐
PLUG AND ABANDONMENT ☐

OTHER ☐

Describe Proposed or Completed Operations (Clearly state all pertinent details, and give pertinent dates, including estimated date of starting any proposed work) SEE RULE 1103.

Change name from T-4 Fillytooth #1 to T-4 Filly's Tooth #1.

Change surface casing setting depth from 350' to 450'.

Change location footage and elevation per resurveyed plat.

I hereby certify that the information above is true and complete to the best of my knowledge and belief.

SIGNED Pam Scott

TITLE Regulatory Secretary

DATE 12/6/84

APPROVED BY Roy Johnson

TITLE DISTRICT SUPERVISOR

DATE 12-18-84

CONDITIONS OF APPROVAL, IF ANY:

NEW MEXICO OIL CONSERVATION COMMISSION
WELL LOCATION AND ACREAGE DEDICATION PLAT

Form C-102
Supersedes C-128
Effective 1-1-65

All distances must be from the outer boundaries of the Section


Owner YATES PETROLEUM			Lease T-4 CATTLE CO. - Filly's Tooth		Well No. 1
Well Letter 1	Section 12	Township 10 N	Range 27 E	County QUAY	
Actual Footage Location of Well: 226.5 feet from the SOUTH line and 756 feet from the WEST line. Road Level Elev. 4295 Forming Formation _____ Pool _____ Dedicated Acreage 160 Acres					

- Outline the acreage dedicated to the subject well by colored pencil or hatchure marks on the plat below.
- If more than one lease is dedicated to the well, outline each and identify the ownership thereof (both as to working interest and royalty).
- If more than one lease of different ownership is dedicated to the well, have the interests of all owners been consolidated by communitization, unitization, force-pooling, etc?

☐ Yes ☐ No If answer is "yes," type of consolidation _____

If answer is "no," list the owners and tract descriptions which have actually been consolidated. (Use reverse side of this form if necessary.) _____

No allowable will be assigned to the well until all interests have been consolidated (by communitization, unitization, forced-pooling, or otherwise) or until a non-standard unit, eliminating such interests, has been approved by the Commission.

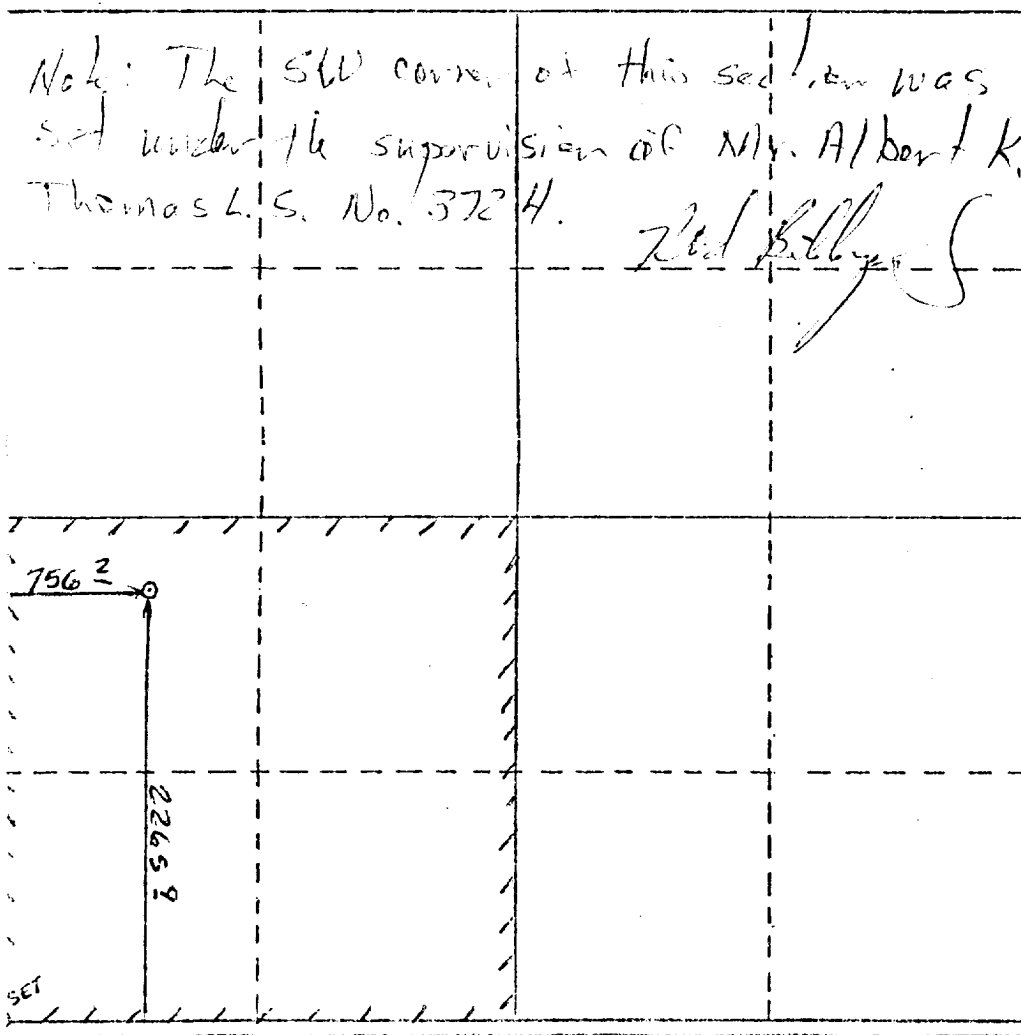

CERTIFICATION

I hereby certify that the information contained herein is true and complete to the best of my knowledge and belief.


[Signature]
Name _____

Position _____

Company _____

Date _____

I hereby certify that the well location shown on this plat was plotted from field notes of actual surveys made by me or under my supervision, and that the same is true and correct to the best of my knowledge and belief.

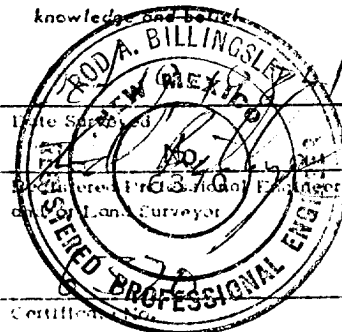

Certification _____

Scale: 1" = 40' 0' 10' 20' 30' 40' 50' 60' 70' 80' 90' 100'