



**NEW MEXICO OIL CONSERVATION COMMISSION  
WELL LOCATION AND ACREAGE DEDICATION PLAT**

Form C-102  
Supersedes C-128  
Effective 1-1-65

All distances must be from the outer boundaries of the Section.


|                                                                                                                                |                                    |                           |                                     |                          |                                        |
|--------------------------------------------------------------------------------------------------------------------------------|------------------------------------|---------------------------|-------------------------------------|--------------------------|----------------------------------------|
| Operator<br><b>AMOCO</b>                                                                                                       |                                    |                           | Lease<br><b>STATE OF NEW MEXICO</b> |                          | Well No.<br><b>KL 1</b>                |
| Unit Letter<br><b>G</b>                                                                                                        | Section<br><b>18</b>               | Township<br><b>T 20 N</b> | Range<br><b>R 33 E</b>              | County<br><b>HARDING</b> |                                        |
| Actual Footage Location of Well:<br><b>1980</b> feet from the <b>NORTH</b> line and <b>1980</b> feet from the <b>EAST</b> line |                                    |                           |                                     |                          |                                        |
| Ground Level Elev.<br><b>4995</b>                                                                                              | Producing Formation<br><b>Tubb</b> |                           | Pool<br><b>Und. Tubb</b>            |                          | Dedicated Acreage:<br><b>160</b> Acres |

1. Outline the acreage dedicated to the subject well by colored pencil or hatchure marks on the plat below.
2. If more than one lease is dedicated to the well, outline each and identify the ownership thereof (both as to working interest and royalty).
3. If more than one lease of different ownership is dedicated to the well, have the interests of all owners been consolidated by communitization, unitization, force-pooling, etc?

☐ Yes    ☐ No    If answer is "yes," type of consolidation \_\_\_\_\_

If answer is "no," list the owners and tract descriptions which have actually been consolidated. (Use reverse side of this form if necessary.) \_\_\_\_\_

No allowable will be assigned to the well until all interests have been consolidated (by communitization, unitization, forced-pooling, or otherwise) or until a non-standard unit, eliminating such interests, has been approved by the Commission.

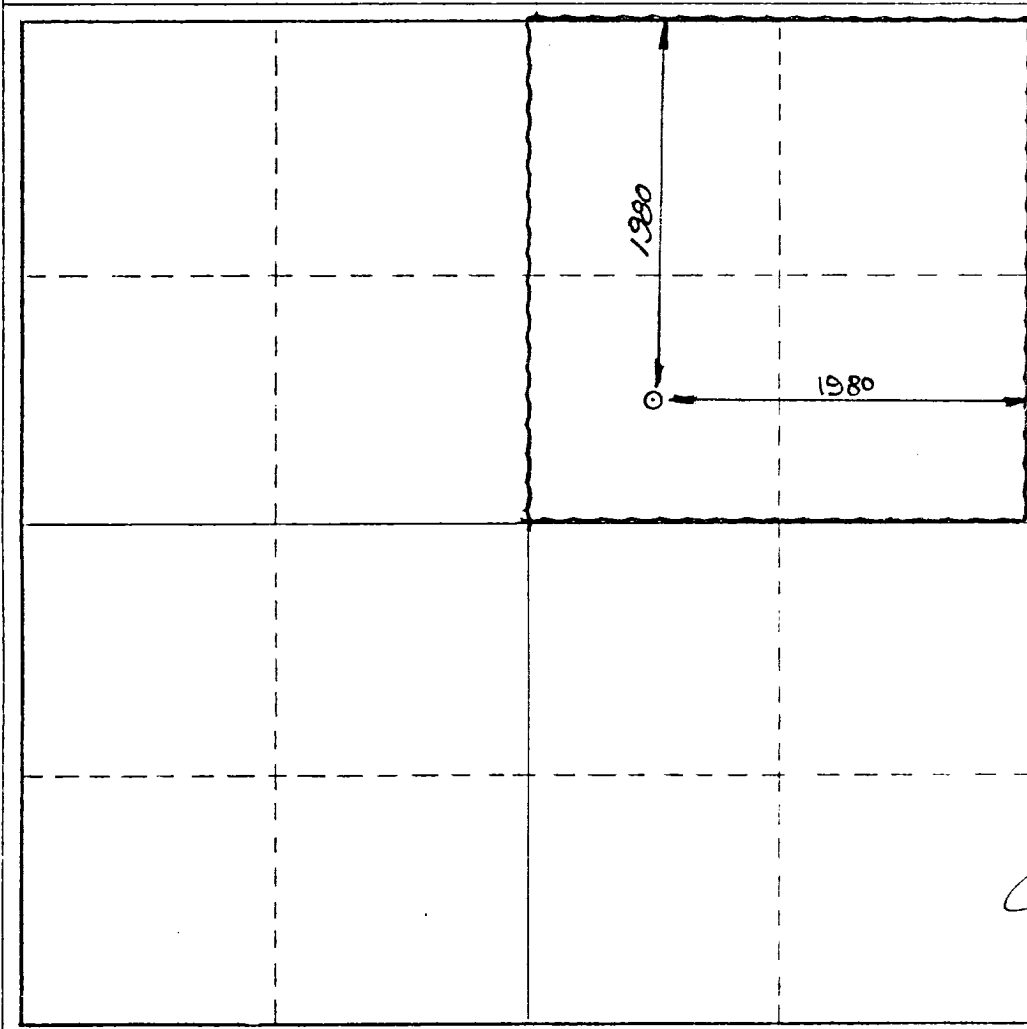

**CERTIFICATION**

*I hereby certify that the information contained herein is true and complete to the best of my knowledge and belief.*

Name  
**Bob Davis**

Position  
**Admin. Analyst**

Company  
**Amoco Production Company**

Date  
**12-9-80**

*I hereby certify that the well location shown on this plat was plotted from field notes of actual surveys made by me or under my supervision, and that the same is true and correct to the best of my knowledge and belief.*


NOV 21 1980

Date Surveyed  
**Nov 21 1980**

Registered Professional Engineer  
and/or Land Surveyor  
**James A. Miller**

N.M.L.S. NO. 5103


Plat No. \_\_\_\_\_

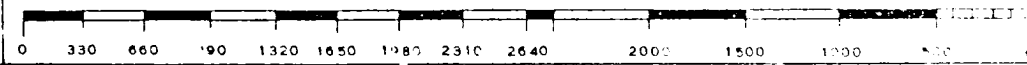

ATTACHMENT "B"  
NOTES

1. Blow-out preventers and master valve to be fluid operated and oil fittings must be in good condition, 3,000# W.P. (6,000 p.s.i. test), minimum.
2. Equipment through which bit must pass shall be as large as the inside diameter of the casing that is being drilled through.
3. Riddle above blow-out preventer shall be same size as casing being drilled through.
4. Kelly cock required, 3,000# W.P. (6,000 p.s.i. test) minimum.
5. OMSCO or comparable safety valve must be available on rig floor at all times with proper connection or sub, 3,000# W.P. (6,000 p.s.i. test), minimum.
6. Blow-out preventers and master valve while drilling intermediate hole to 6000' may be 2,000# W.P. (4,000 p.s.i. test), minimum.
7. Choke assembly, beyond second valve from cross, may be positioned (Optional) outside of derrick foundation.
8. Spool or cross may be eliminated if connections are available in the lower part of the blow-out preventer body.
9. Plug valves - gate valves are optional. Valves shown as 2" are minimum size.
10. Casing head and casing head spool, including attached valves, to be furnished by Amoco.
11. Rams in preventers will be installed as follows:  

|                                               |                                               |
|-----------------------------------------------|-----------------------------------------------|
| When drilling, use:                           | When running casing, use:                     |
| Top Preventer - Drill pipe rams               | Top Preventer - Casing rams                   |
| Bottom Preventer - Blind rams or master valve | Bottom Preventer - Blind rams or master valve |

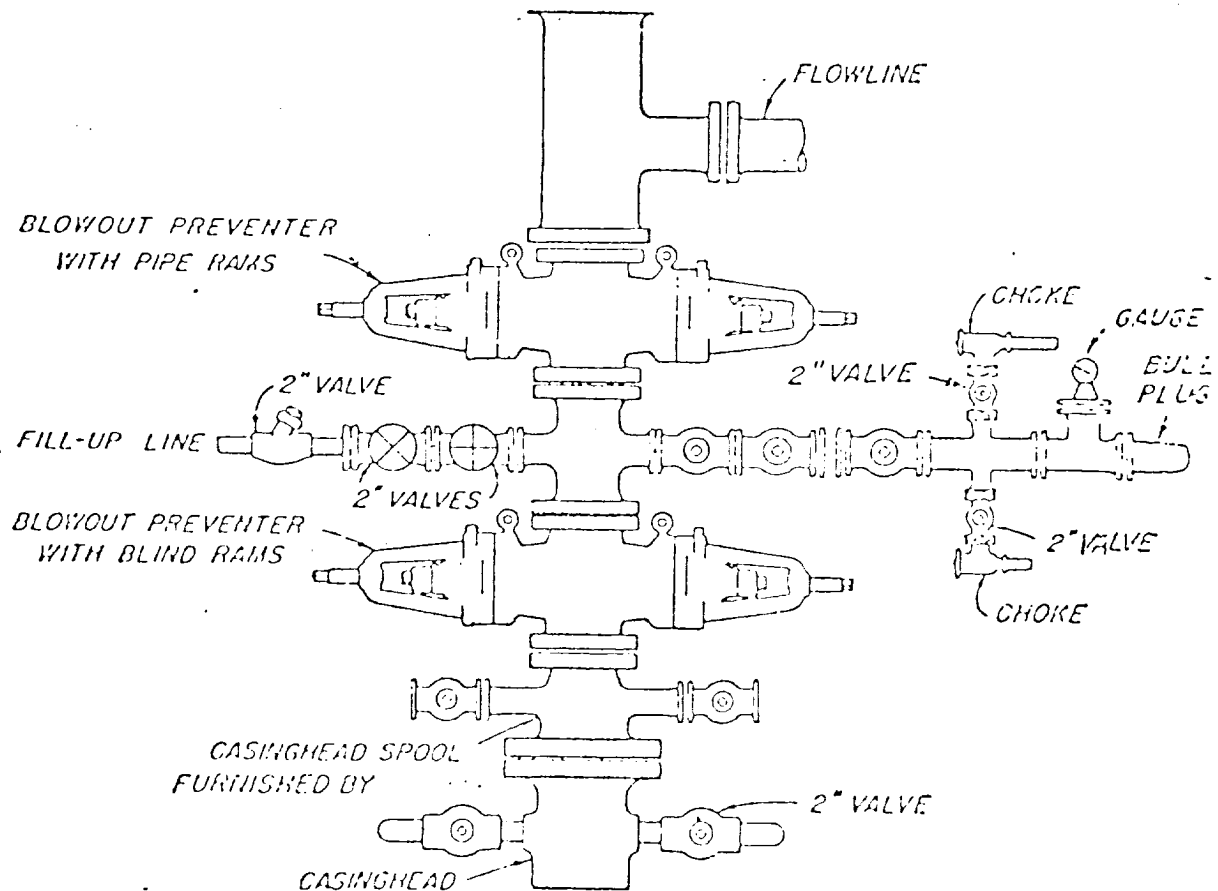

BLOWOUT PREVENTER HOOK-UP

AMOCO PRODUCTION COMPANY

EXHIBIT D-1 MODIFIED

JUNE 1, 1962