Submit 3 Copies To Appropriate District Office	State o	f New Me	xico		Form C-103				
District 1 *	Energy, Mineral	s and Natu	ral Resources	WELL ADINO	May 27, 2004				
1625 N. French Dr , Hobbs, NM 88240 District II				WELL API NO.	015-39094				
1301 W Grand Ave., Artesia, NM 88210	OIL CONSER			5. Indicate Type of					
District III 1000 Rio Brazos Rd., Aztec, NM 87410		th St. Fran		STATE  FEE					
<u>District IV</u> 1220 S St Francis Dr , Santa Fe, NM	Santa	Fe, NM 87	305	6. State Oil & Ga	s Lease No.				
87505									
SUNDRY NOT (DO NOT USE THIS FORM FOR PROPO	ICES AND REPORTS (			7. Lease Name or	Unit Agreement Name				
DIFFERENT RESERVOIR. USE "APPLI				Conti	nental State				
PROPOSALS.)  1. Type of Well: Oil Well	Gas Well  Other			8. Well Number	Tiontal State				
	Gas Well				2				
2. Name of Operator	OG Operating LLC			9. OGRID Numb	er <b>229137</b>				
3. Address of Operator	OG Operating LLC	<del> </del>		10. Pool name or					
550 W. Texas Ave., Su	ite 100	Midland, 1	X 79701	•	son; SR-Q-G-SA				
4. Well Location		· · · · · · · · · · · · · · · · · · ·		_L					
Unit Letter <u>D</u> :	450' feet from the	North	line and <b>990'</b>	feet from the	West line				
Section 15	Township		Range 29E	NMPM	County EDDY				
	11. Elevation (Show)			)					
Pit or Below-grade Tank Application .	or Closure	3567'	GR						
Pit type Depth to Groundwater 1		est fresh water	r well 1000' Distan	ce from nearest surface	water 1000'				
	Below-Grade Tank: Volume		bbls; Construction						
	Appropriate Box to 1	ndicate N	ature of Notice	Report or Other	Data				
	••	indicate iv	ature of rvotice,	report of Other	Data				
<del>-</del>	NTENTION TO:	–		SEQUENT RE					
PERFORM REMEDIAL WORK  TEMPORARILY ABANDON	PLUG AND ABANDO CHANGE PLANS	N L	REMEDIAL WOR	RK ∐ IILLING OPNS.□	ALTERING CASING  P AND A				
PULL OR ALTER CASING	MULTIPLE COMPL		CASING/CEMEN		PANDA				
		_							
OTHER:	1-4-1(C1	1 4 4 11		rect location					
13. Describe proposed or comp					am of proposed completion				
or recompletion.	om). SEE NOEE 1103.	Tor Manapa	e completions.	tuon wonoore ulugit	am or proposed completion				
	r								
	Due to This well was	permitted	at the following	location:					
	450' FNL & 990'				AISƏTAA OOONN				
	The location was s	staked and	l drillad at this k	acation:	LIOZ <b>6 %</b> VON				
	420' FNL & 990'				1100 0 6 MOIN				
					RECEIVED				
	A correct C-10	2 is attach	ned for your revi	ew.					
I hereby certify that the information	above is true and compl	ete to the be	st of my knowledg	e and belief. I furthe	r certify that any pit or below-				
grade tank has been/will be gonstructed or									
SIGNATURE SIGNATURE	- dan	TITLE	Regulatory An	alyst DA	TE <b>11/28/11</b>				
Type or print name: Robyn M.	Odom E-mail addre	ss: <u>rodom(</u>	@concho.com	Telephone No. 43	<u>32-685-4385</u>				
For State Use Only	Messel		6/102/	1	NOV 29 2011				
APPROVED BY:	IMINIU	_TITLE	0804051	51	DATE				
Conditions of Approval (if any):	· ,								

dm

DISTRICT I
1625 N. FRENCH DR., HOBBS, NM 88240
DISTRICT II
1301 W. GRAND AVENUE, ARTESIA, NM 88210
DISTRICT III
1000 RIO BRAZOS RD., AZTEC, NM 87410
DISTRICT IV

11885 S. ST. FRANCIS DR., SANTA FE, NM 87505

# State of New Mexico Energy, Minerals & Natural Resources Department OIL CONSERVATION DIVISION

CONSERVATION DIVISI 1220 South St. Francis Dr. Santa Fe, New Mexico 87505 Form C-102 Revised July 16, 2010 Submit to Appropriate District Office

□ AMENDED REPORT

### WELL LOCATION AND ACREAGE DEDICATION PLAT

Pool Code	Pool Code Pool Name					
28509	28509 Graybug Jackson; SR					
Prop	Well Number					
CONTINE	2					
Ope	Elevation					
COG OPE	3567'					
	Prop CONTINE Ope	1901.1				


#### Surface Location

UL or lot	No. Section	Township	Range	Lot Idn	Feet from the	North/South line	Feet from the	East/West line	County
D	15	17-S	29-E		420	NORTH	990	WEST	EDDY

#### Bottom Hole Location If Different From Surface

UL or lot No.	Section	Township	Range	Lot Idn	Feet from the	North/South line	Feet from the	East/West line	County
Dedicated Acres	Joint or	Infili C	onsolidation C	Code Ord	ler No.				

#### NO ALLOWABLE WILL BE ASSIGNED TO THIS COMPLETION UNTIL ALL INTERESTS HAVE BEEN CONSOLIDATED OR A NON-STANDARD UNIT HAS BEEN APPROVED BY THE DIVISION

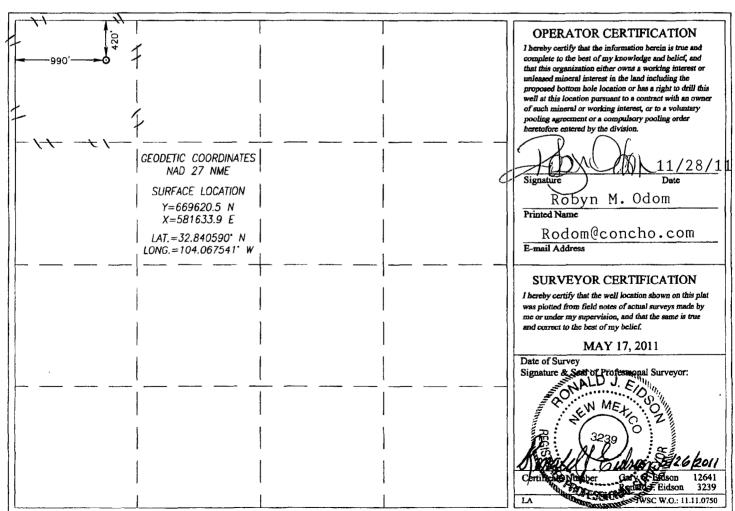

Amended

## SECTION 15. TOWNSHIP 17 SOUTH, RANGE 29 EAST, N.M.P.M. EDDY COUNTY NEW MEXICO 600' COG WATER BPL HOLLY BPL NORTHWEST I NORTHEAST CORNER SUN OIL CO. Ø CORNER 3567.5 P & A 3567 6' 170' **CONTINENTAL ST. #2 ELEV. 3567.4'** 130' LAT.=32.840590° N LONG.=104.067541° W 111' OF PROPOSED ROAD SOUTHEAST SOUTHWEST CORNER CORNER 3563.5 3565.6 **DURANGO** ST. COM #1 600'

#### DIRECTIONS TO LOCATION

FROM THE INTERSECTION OF U.S HWY #82 AND CO. RD. #214 (BARNAVAL DRAW), GO NORTHWEST ON CO. RD #214 APPROX. 1 4 MILES TO THE DURANGO STATE COM #1 WELL THE LOCATION STAKE IS APPROX. 412 FEET NORTHEAST OF EXISTING WELL HEAD.



PROVIDING SURVEYING SERVICES SINCE 1946

IOHN WEST SURVEYING COMPANY 412 N DAL PASO HOBBS, N.M 88240 (575) 393-3117

100	0	100	200 Feet		
	Scale: 1	"= 100'			

#### OPERATING. COGLLC

CONTINENTAL STATE #2 WELL LOCATED 420 FEET FROM THE NORTH LINE AND 990 FEET FROM THE WEST LINE OF SECTION 15, TOWNSHIP 17 SOUTH, RANGE 29 EAST, N.M.P.M., EDDY COUNTY, NEW MEXICO

	Survey Date:	5/	/17/11			Sheet		1	of	i	1	Sheets	
	W.O. Number:	11.	11.0750		Dr	By: LA			R	ev.	1: N	I/A	
j	Date: 5/25/11		Rel. W.	2. · .			ĵ	11110	750	Sc	cale:	1"=100'	