(August 2007)	, DI	UNITED STATES EPARTMENT OF THE IN	NTERIOR	M OIL CON	SERVATION	FORM OMB N Expires:	APPROVED O. 1004-0135 July 31, 2010	
DEPARTMENT OF THE INTERIOR BUREAU OF LAND MANAGEMENT SUNDRY NOTICES AND REPORTS ON WELLS Do not use this form for proposals to drill or to re-enter and 18 2015 abandoned well. Use form 3160-3 (APD) for such proposals.						Lease Serial No. NMLC029426B If Indian, Allottee or Tribe Name		
SUBMIT IN TRIPLICATE - Other instructions on reverse sideRECEIVED						7. If Unit or CA/Agreement, Name and/or No. NMNM134086		
1. Type of Well ☑ Oil Well ☐ Gas Well ☐ Other						8. Well Name and No. CROW FEDERAL 20H		
2. Name of Operator Contact: JENNIFER E VA. APACHE CORPORATION E-Mail: Jennifer.vancuren@arcadis.cc						9. API Well No. 30-015-41910-00-S1		
3a. Address 303 VETERA MIDLAND, T	7-5400 Ext: 117 -5401		10. Field and Pool, or FREN UNKNOWN	UNKNOWN				
4. Location of Well (Footage, Sec., T., R., M., or Survey Description)						11. County or Parish, and State .		
Sec 10 T17S 32,848107 N			EDDY COUNTY	/, NM				
12. CHECK APPROPRIATE BOX(ES) TO INDICATE NATURE OF NOTICE, REPORT, OR OTHER DATA								
TYPE OF SU	SUBMISSION TYPE OF ACTION							
Notice of Ir	ntent	☐ Acidize	☐ Deep	pen	☐ Product	tion (Start/Resume)	☐ Water Shut-Off	
_		☐ Alter Casing	_	ture Treat	🛚 Reclam		■ Well Integrity	
☐ Subsequent Report		Casing Repair	_	Construction Recomplete		<u>-</u>	☐ Other	
☐ Final Aband	donment Notice	☐ Change Plans				rarily Abandon		
		☐ Convert to Injection	☐ Plug		☐ Water I			
If the proposal is Attach the Bond following comp testing has been	s to deepen directions I under which the wo letion of the involved	eration (clearly state all pertiner ally or recomplete horizontally, rk will be performed or provide a operations. If the operation re- pandonment Notices shall be fil- final inspection.)	give subsurface the Bond No. or sults in a multipl	locations and measu i file with BLM/BIA e completion or reco	ired and true von. A. Required sumpletion in a	ertical depths of all pertir bsequent reports shall be new interval, a Form 316	ent markers and zones. filed within 30 days 0-4 shall be filed once	
APACHE REQUESTS TO MODIFY / CHANGE THE ORIGINAL PLANS FOR THE INTERIM RECLAMATION (IR) FOR THE FOLLOWING WELLS.								
CROW FEDERAL 19H, I-10-17S-31E, 2280' FSL & 370' FEL, 30015- CROW FEDERAL 20H, I-10-17S-31E, 2310' FSL & 370' FEL, 30015- CROW FEDERAL 21H, I-10-17S-31E, 2340' FSL & 370' FEL, 30015-				1910 ACCAPTACI RATISCOID 1911 NWOCD				
ORIGINAL PLANS DID NOT ACCOUNT FOR THE SATELLITE FACILITY LOCATED ON THE WEST JUST NORTH OF THE ACCESS ROAD. PLEASE SEE TABLE BELOW FOR ORIGINALLY PLANNED AND REVISED IR.								
TYPE PAD AS BUILT ACREAGE WELL PAD REMAINING ACREAGE ORIGINAL 310 x 350 FEET 2.49 190 X 260 FEET 1.35								
14. I hereby certify	that the foregoing is	Electronic Submission #	E CORPORAT	ON, sent to the	Carisbad	•		
Name(Printed/Typed) JENNIFER E VAN CUREN				Title AUTHORIZED REPRESENTATIVE				
Signature (Electronic Submission) Date					015			
THIS SPACE FOR FEDERAL OR STATE OFFICE USE								
_Approved By	Janes	C. Bris -		Title S	PET	+	/2-/2-/5 Date	
Conditions of approve certify that the application which would entitle t	Office A	CO						
THE LOTING C. A.	1001 and Title 42	II C C Cartian 1313 miles in a	anima for an incident				C-1 11 1- 1	

Additional data for EC transaction #323615 that would not fit on the form

32. Additional remarks, continued

REVISED 310 x 350 FEET 2.49 SEE PLAT 1.42

APACHE PLANS TO MAKE UP THE 0.07 ACRE DIFFERENCE WITHIN THE SAME DEVELOPMENT AREA AND WILL BE TRACKED BY ARCADIS. IF PROPOSED PRAIRIE CHICKEN SUBURBS 3H IS NOT DRILLED PRIOR TO EXPIRATION OF PERMIT, THE 0.07+ ACRES WILL BE RECLAIMED ON THE SOUTH SIDE OF CROW FEDERAL 19H ? 21H WELL PAD.

IR WORK TO BE COMPLETED? REMOVE CABLE, ANY FRAC SAND, AND UNUSED GRAVEL. PROPANE TANKS, IF STILL PRESENT, WILL BE REALIGNED TO MAXIMIZE THE IR ON THE EAST SIDE. CALICHE FREE OF ANY CONTAMINATION WILL BE REMOVED AND STOCKPILED FOR USE ON ROADS OR CONSTRUCTION OF WELL PADS. AREAS TO BE RECLAIMED WILL BE RECONTOURED TO MATCH SURROUNDING AREAS, THE TOPSOIL WILL BE DISTRIBUTED ACROSS ALL RECLAIMED AREAS, RIPPED ACROSS ANY SLOPED AREAS (NONE ANTICIPATED), AND SEEDED WITH BLM LPC SEED MIXTURE. WELL PAD WILL BE BERMED TO PREVENT CONTAMINANTS FROM LEAVING LOCATION IF AN UNDESIREABLE EVENT WAS TO OCCUR.

ALL LPC GUIDELINES WILL BE FOLLOWED IF IR STARTS AFTER MARCH 1 OR BEFORE JUNE 15.

APACHE PLANS TO RECLAIM AFTER LAST WELL (21H) IS DRILLED AND COMPLETED.

PLEASE SEE ATTACHED DIAGRAM OF REVISED PLAN.




ARCADIS U.S., Inc.

BY (AU) DATE 10/4/15 SHEET NO 2 OF May

CHKO. BY DATE 10/4/15 JOB NO MT COULT. 1002

SUBJECT (ROW FERENCE 1911 2111

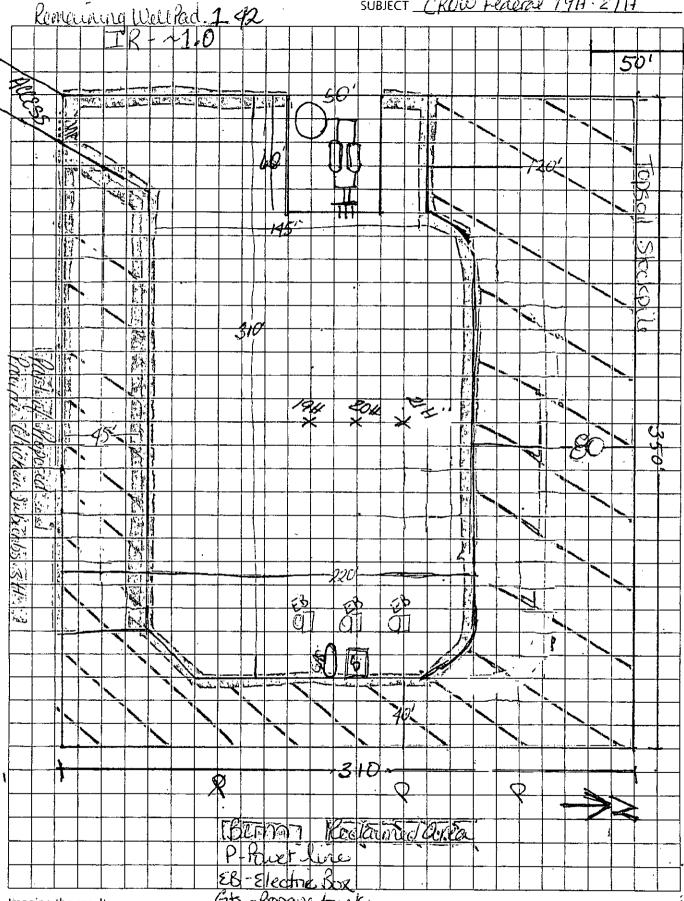

Imagine the result

Gts-Proporetork

B-Power Erruler