

UNITED STATES  
DEPARTMENT OF THE INTERIOR  
BUREAU OF LAND MANAGEMENT

OCD Artesia

FORM APPROVED  
OMB NO. 1004-0135  
Expires: July 31, 2010

**SUNDRY NOTICES AND REPORTS ON WELLS**  
*Do not use this form for proposals to drill or to re-enter an abandoned well. Use form 3160-3 (APD) for such proposals.*

**SUBMIT IN TRIPLICATE - Other instructions on reverse side.**

1. Type of Well <input checked="" type="checkbox"/> Oil Well <input type="checkbox"/> Gas Well <input type="checkbox"/> Other		5. Lease Serial No. NMNM86905
2. Name of Operator RKI EXP & PROD, LLC		6. If Indian, Allottee or Tribe Name
Contact: JESSICA M DEMARCE E-Mail: jessica.demarce@wpenergy.com		7. If Unit or CA/Agreement, Name and/or No.
3a. Address 3500 ONE WILLIAMS CENTER MD35 TULSA, OK 74172	3b. Phone No. (include area code) Ph: 539-573-3521	8. Well Name and No. MALAGA "7" FEDERAL 31
4. Location of Well (Footage, Sec., T., R., M., or Survey Description) Sec 7 T24S R29E 660FNL 1650FEL		9. API Well No. 30-015-29229
		10. Field and Pool, or Exploratory MALAGA DELAWARE
		11. County or Parish, and State EDDY COUNTY, NM

**12. CHECK APPROPRIATE BOX(ES) TO INDICATE NATURE OF NOTICE, REPORT, OR OTHER DATA**

TYPE OF SUBMISSION	TYPE OF ACTION			
<input type="checkbox"/> Notice of Intent	<input type="checkbox"/> Acidize	<input type="checkbox"/> Deepen	<input type="checkbox"/> Production (Start/Resume)	<input type="checkbox"/> Water Shut-Off
<input checked="" type="checkbox"/> Subsequent Report	<input type="checkbox"/> Alter Casing	<input type="checkbox"/> Fracture Treat	<input type="checkbox"/> Reclamation	<input type="checkbox"/> Well Integrity
<input type="checkbox"/> Final Abandonment Notice	<input type="checkbox"/> Casing Repair	<input type="checkbox"/> New Construction	<input type="checkbox"/> Recomplete	<input checked="" type="checkbox"/> Other Site Facility Diagram/Security Plan
	<input type="checkbox"/> Change Plans	<input type="checkbox"/> Plug and Abandon	<input type="checkbox"/> Temporarily Abandon	
	<input type="checkbox"/> Convert to Injection	<input type="checkbox"/> Plug Back	<input type="checkbox"/> Water Disposal	

13. Describe Proposed or Completed Operation (clearly state all pertinent details, including estimated starting date of any proposed work and approximate duration thereof. If the proposal is to deepen directionally or recomplete horizontally, give subsurface locations and measured and true vertical depths of all pertinent markers and zones. Attach the Bond under which the work will be performed or provide the Bond No. on file with BLM/BIA. Required subsequent reports shall be filed within 30 days following completion of the involved operations. If the operation results in a multiple completion or recompletion in a new interval, a Form 3160-4 shall be filed once testing has been completed. Final Abandonment Notices shall be filed only after all requirements, including reclamation, have been completed, and the operator has determined that the site is ready for final inspection.)

SFD DATED 7/6/2016 & ABSM DATED 7/6/2016 ATTACHED

**NM OIL CONSERVATION**  
ARTESIA DISTRICT

NOV 14 2016

RECEIVED

Accepted for Record Purposes.  
Approval Subject to Onsite Inspection.  
Date: 09.28.16


14. I hereby certify that the foregoing is true and correct. Electronic Submission #348296 verified by the BLM Well Information System For RKI EXP & PROD, LLC, sent to the Carlsbad Committed to AFMSS for processing by DEBORAH MCKINNEY on 08/24/2016 ()	
Name (Printed/Typed) JESSICA M DEMARCE	Title REGULATORY TECH
Signature (Electronic Submission)	Date 08/18/2016

**THIS SPACE FOR FEDERAL OR STATE OFFICE USE**

Approved By _____	Title _____	Date _____
Conditions of approval, if any, are attached. Approval of this notice does not warrant or certify that the applicant holds legal or equitable title to those rights in the subject lease which would entitle the applicant to conduct operations thereon.		Office _____

Title 18 U.S.C. Section 1001 and Title 43 U.S.C. Section 1212, make it a crime for any person knowingly and willfully to make to any department or agency of the United States any false, fictitious or fraudulent statements or representations as to any matter within its jurisdiction.

**\*\* OPERATOR-SUBMITTED \*\* OPERATOR-SUBMITTED \*\* OPERATOR-SUBMITTED \*\***

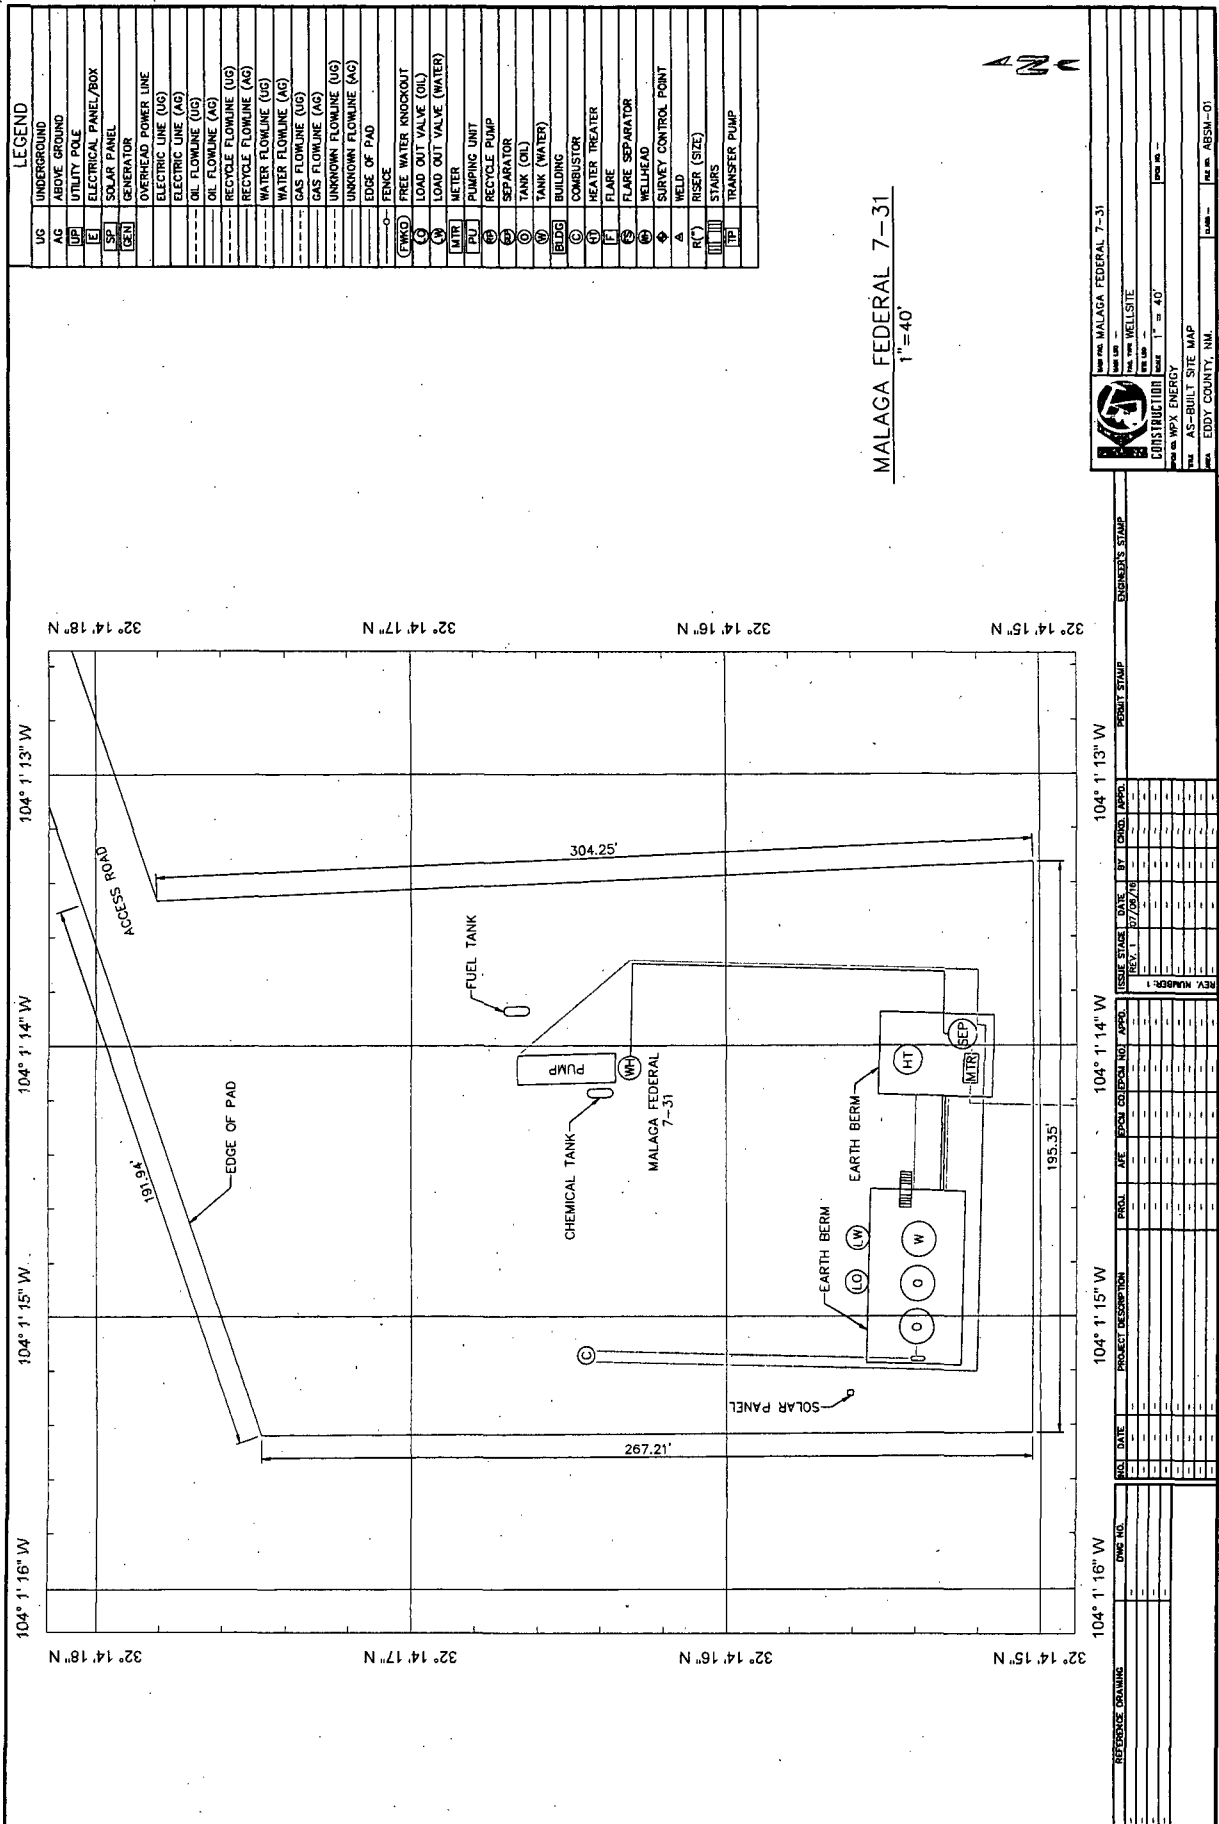

Accepted for Record Purposes.  
Approval Subject to Onsite Inspection.  
Date: 09.28.16

		WFX ENERGY CONSTRUCTION	
PROJECT: MALAGA FEDERAL 7-31		DATE: 09/28/16	
DRAWN BY: [Name]		CHECKED BY: [Name]	
SCALE: 1" = 40'		SHEET NO.: 1 OF 1	
PROJECT LOCATION: AS-BUILT SITE MAP		COUNTY: EDDY COUNTY, NM	
PROJECT NO.: AEDM-01		DRAWING NO.: [Blank]	

WPK ENERGY  
MALAGA FEDERAL 7-31  
660' FHL & 1650' FEL  
SEC. 7-1245-R28E  
APN 30-015-29229  
LOS ANGELES COUNTY  
EDDY COUNTY, NEW MEXICO


ACCESS ROAD

General setting of valves, sales by tank gauge.  
Production Phase: Sales valves S1 and S2 sealed closed. Fill valve to tank that is in production will be open. Equalizer valve to tank that is in production will be open. Circulating valves will be opened as necessary, then released.  
Sales Phase: The tank from which sales are being made will be isolated by sealing closed the fill valve, circulating valve and the equalizer valve during sales and opening the sales valve. Upon completion of the sale the sales valve will be released. Sales by truck will be by tank gauge.

Valve	Production Phase	Sales Phase	Circulating
S1	Closed	Open	Closed
S2	Closed	Open	Closed
C1	Closed or Open	Closed	Closed
C2	Closed or Open	Closed	Closed
F1	Open or Closed	Closed	Closed or Open
E1	Open or Closed	Closed	Closed
	Open	Open	Open

The Site Security Plan is kept at WPK's office located at:  
5315 Buena Vista Dr. Caribod, NM.

MALAGA FEDERAL 7-31  
N.T.S.

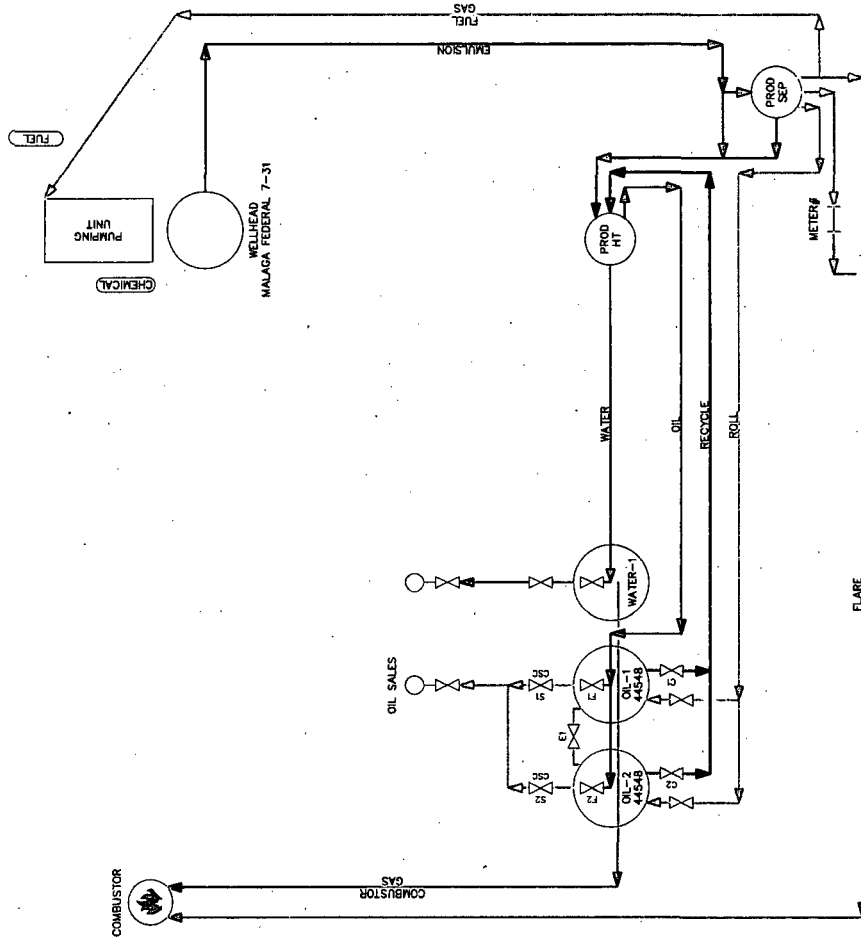

WPK ENERGY		MALAGA FEDERAL 7-31	
CONSTRUCTION		N.T.S.	
SHEET NO. 1		SHEET NO. 1	
DATE		DATE	
DRAWN BY		CHECKED BY	
APPROVED BY		APPROVED BY	
PROJECT NO.		PROJECT NO.	
SHEET NO.		SHEET NO.	
DATE		DATE	
DRAWN BY		CHECKED BY	
APPROVED BY		APPROVED BY	
PROJECT NO.		PROJECT NO.	
SHEET NO.		SHEET NO.	
DATE		DATE	
DRAWN BY		CHECKED BY	
APPROVED BY		APPROVED BY	
PROJECT NO.		PROJECT NO.	
S			