

UNITED STATES
DEPARTMENT OF THE INTERIOR
BUREAU OF LAND MANAGEMENTNMOCD
ArtesiaFORM APPROVED
OMB NO. 1004-0137
Expires: January 31, 2018**SUNDRY NOTICES AND REPORTS ON WELLS**
*Do not use this form for proposals to drill or to re-enter an abandoned well. Use form 3160-3 (APD) for such proposals.*5. Lease Serial No.
NMNM120357

6. If Indian, Allottee or Tribe Name

7. If Unit or CA/Agreement, Name and/or No.

8. Well Name and No.
NEREID 1 FEDERAL 1H9. API Well No.
30-005-29145-00-S110. Field and Pool or Exploratory Area
UNDESIGNATED-ABO-WOLFCAMP11. County or Parish, State
CHAVES COUNTY, NM**SUBMIT IN TRIPLICATE - Other instructions on page 2**

1. Type of Well

☒ Oil Well ☐ Gas Well ☐ Other2. Name of Operator
CHEVRON USA INC.Contact: CINDY H MURILLO
E-Mail: CERRERAMURILLO@CHEVRON.COM3a. Address
6301 DEAUVILLE BLVD
MIDLAND, TX 797063b. Phone No. (include area code)
Ph: 575-263-0431
Ex: 575-263-0445

4. Location of Well (Footage, Sec., T., R., M., or Survey Description)

Sec-1 T15S R31E SESE 660FSL 100FEL

12. CHECK THE APPROPRIATE BOX(ES) TO INDICATE NATURE OF NOTICE, REPORT, OR OTHER DATA

TYPE OF SUBMISSION	TYPE OF ACTION			
☐ Notice of Intent	☐ Acidize	☐ Deepen	☐ Production (Start/Resume)	☐ Water Shut-Off
☒ Subsequent Report	☐ Alter Casing	☐ Hydraulic Fracturing	☐ Reclamation	☐ Well Integrity
☐ Final Abandonment Notice	☐ Casing Repair	☐ New Construction	☐ Recomplete	☒ Other
	☐ Change Plans	☐ Plug and Abandon	☐ Temporarily Abandon	Site Facility Diagram/Security Plan
	☐ Convert to Injection	☐ Plug Back	☐ Water Disposal	

13. Describe Proposed or Completed Operation: Clearly state all pertinent details, including estimated starting date of any proposed work and approximate duration thereof. If the proposal is to deepen directionally or recompleat horizontally, give subsurface locations and measured and true vertical depths of all pertinent markers and zones. Attach the Bond under which the work will be performed or provide the Bond No. on file with BLM/BIA. Required subsequent reports must be filed within 30 days following completion of the involved operations. If the operation results in a multiple completion or recompleat in a new interval, a Form 3160-4 must be filed once testing has been completed. Final Abandonment Notices must be filed only after all requirements, including reclamation, have been completed and the operator has determined that the site is ready for final inspection.

CHEVRON USA INC IS SUBMITTING THE CURRENT SITE SECURITY DIAGRAM FOR THE NEREID 1 FEDERAL #1

pending PET inspection

RECEIVED

PLEASE FIND ATTACHED SITE SECURITY DIAGRAM.

DEC 11 2019

DISTRICT 7 - ARTESIA O.C.D.

14. I hereby certify that the foregoing is true and correct.	
Electronic Submission #495016 verified by the BLM Well Information System For CHEVRON USA INC., sent to the Roswell Committed to AFMSS for processing by JENNIFER SANCHEZ on 12/09/2019 (20JS0041SE)	
Name (Printed/Typed) CINDY H MURILLO	Title PERMITTING SPECIALIST
Signature (Electronic Submission)	Date 12/09/2019
THIS SPACE FOR FEDERAL OR STATE OFFICE USE	
Approved By	Title
Conditions of approval, if any, are attached. Approval of this notice does not warrant or certify that the applicant holds legal or equitable title to these rights in the subject lease which would entitle the applicant to conduct operations thereon.	Date
BUREAU OF LAND MANAGEMENT ROSWELL FIELD OFFICE	
Title 18 U.S.C. Section 1001 and Title 43 U.S.C. Section 1212, make it a crime for any person knowingly and willfully to make to any department or agency of the United States any false, fictitious or fraudulent statements or representations as to any matter within its jurisdiction.	

(Instructions on page 2)

** BLM REVISED ** BLM REVISED ** BLM REVISED ** BLM REVISED ** BLM REVISED **

Accepted 1/27/20 KS

Revisions to Operator-Submitted EC Data for Sundry Notice #495016

Operator Submitted

Sundry Type: SITE
SR

Lease: NMNM120357

Agreement:

Operator: CHEVRON USA INC
6301 DEAUVILLE BLVD
MIDLAND, TX 79706
Ph: 575-263-0431

Admin Contact: CINDY H MURILLO
PERMITTING SPECIALIST
E-Mail: CHERRERAMURILLO@CHEVRON.COM
Ph: 575-263-0431
Fx: 575-263-0445

Tech Contact: CINDY H MURILLO
PERMITTING SPECIALIST
E-Mail: CHERRERAMURILLO@CHEVRON.COM
Ph: 575-263-0431
Fx: 575-263-0445

Location:
State: NM
County: CHAVES

Field/Pool: ABO-WOLFCAMP

Well/Facility: NEREID 1 FEDERAL 1H
Sec 1 T17S R31E SESE 660FSL 100FEL

BLM Revised (AFMSS)

SITE
SR

NMNM120357

CHEVRON USA INC
6301 DEAUVILLE BLVD
MIDLAND, TX 79706
Ph: 432-687-7100


CINDY H MURILLO
PERMITTING SPECIALIST
E-Mail: CHERRERAMURILLO@CHEVRON.COM
Ph: 575-263-0431
Fx: 575-263-0445

CINDY H MURILLO
PERMITTING SPECIALIST
E-Mail: CHERRERAMURILLO@CHEVRON.COM
Ph: 575-263-0431
Fx: 575-263-0445

NM
CHAVES

UNDESIGNATED-ABO-WOLFCAMP

NEREID 1 FEDERAL 1H
Sec 1 T15S R31E SESE 660FSL 100FEL

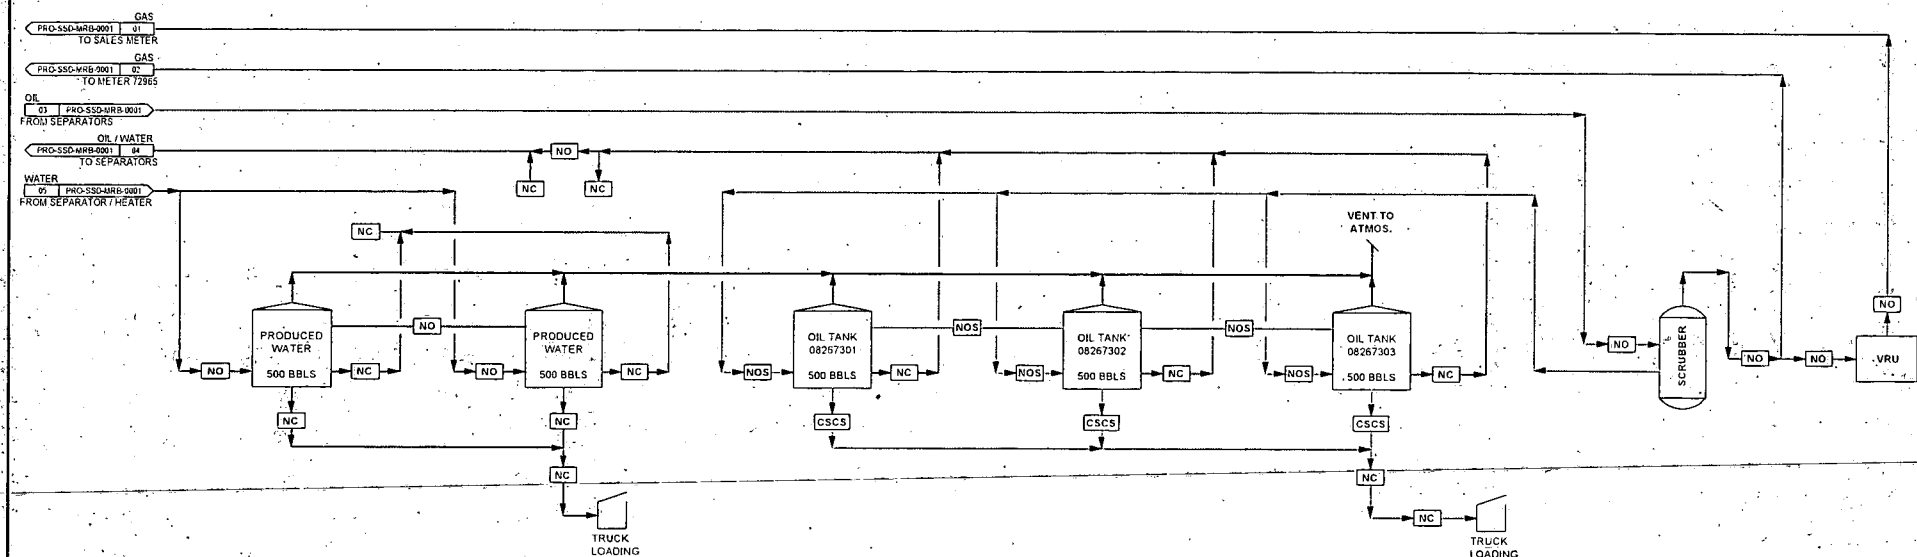

VALVE KEY:
 CSO: CAR SEALED OPEN
 CSC: CAR SEALED CLOSED
 NO: NORMALLY OPEN
 NC: NORMALLY CLOSED
 NOS: (EXCEPT DURING SALES)
 CSCS: (EXCEPT DURING SALES)

COMPOSITION KEY:
 — OIL/WATER/GAS
 — OIL/WATER
 — OIL
 — WATER
 — GAS

DIAGRAM STORED AT:
 CHEVRON MIDCONTINENT HEADQUARTERS
 6301 DEAUVILLE BLVD
 MIDLAND, TEXAS 79706

ISSUED AS-BUILT	BASIN DESIGN, DRP #19244	MMW 11/21/19	1/1	1/1

REVISIONS

AS-BUILT

Chevron U.S.A. Inc.


HOBBS FOT - DELAWARE BASIN
 NERIED CTB - CHAVEZ COUNTY, NM

DR. JCM
 ENG. TZDZ

NEREID 1 FEDERAL 1H - SITE SECURITY DIAGRAM
 NERD-N1F1HPAD-PRO-SSD-MCB-0002

ALTERNATE DWG NUMBER API NUMBER LEASE NUMBER PLOT DATE: 11/21/2019, FILE NAME: NERD-N1F1HPAD-PRO-SSD-MCB-0002

NEREID 1 FEDERAL #001H
 660' FSL & 100' FEL
 SECTION: P-01-158-31E
 API NO. 30-005-29145
 CHAVEZ COUNTY, NM
 WELLHEAD (OFFSITE) FEDERAL

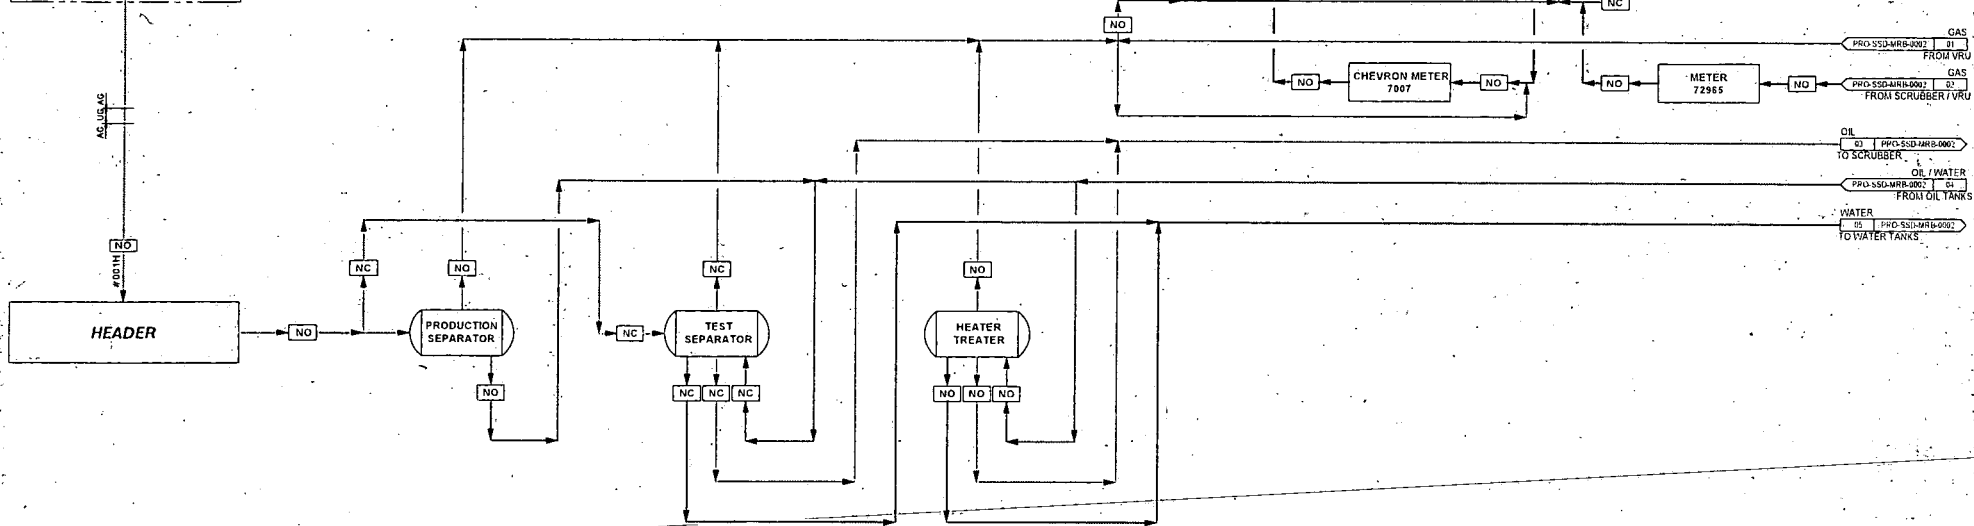

**HEATER TREATER
 FUEL GAS USED:**
 6 MCF/D
 OBTAINED FROM ENERGY
 COMPONENTS (EC SYSTEM)

COMPOSITION KEY:
 — OIL/WATER/GAS
 — OIL/WATER
 — OIL
 — WATER
 — GAS

VALVE KEY:
 CSO: CAR SEALED OPEN
 CSC: CAR SEALED CLOSED
 NO: NORMALLY OPEN
 NC: NORMALLY CLOSED
 NOS: (EXCEPT DURING SALES)
 CSCS: (EXCEPT DURING SALES)

DIAGRAM STORED AT:
 CHEVRON MIDCONTINENT HEADQUARTERS
 6301 DEAUVILLE BLVD
 MIDLAND, TEXAS 79706

REVISIONS				
0	ISSUED AS-BUILT			
1	BASIN DESIGN, DRP #19244	MWH	11/21/19	
2				
3				

AS-BUILT

HOBBS FOT - DELAWARE BASIN
NEREID CTB - CHAVEZ COUNTY, NM

NEREID 1 FEDERAL 1H - SITE SECURITY DIAGRAM

NERD-N1F1HPAD-PRO-SSD-MCB-0001

DR. JCM
 ENG. TZDZ

FILE NAME: NERD-N1F1HPAD-PRO-SSD-MCB-0001
 PLOT DATE: 11/21/2019
 LEASE NUMBER
 ALTERNATE DWG NUMBER API NUMBER