

Submit 3 Copies To Appropriate District Office  
District I  
1625 N French Dr, Hobbs, NM 88240  
District II  
1301 W Grand Ave, Artesia, NM 88210  
District III  
1000 Rio Brazos Rd, Aztec, NM 87410  
District IV  
1220 S St Francis Dr., Santa Fe, NM 87505

State of New Mexico  
Energy, Minerals and Natural Resources

Form C-103  
May 27, 2004

OIL CONSERVATION DIVISION  
1220 South St. Francis Dr.  
Santa Fe, NM 87505

S

WELL API NO. 30-015-30276
5. Indicate Type of Lease STATE <input checked="" type="checkbox"/> FEE <input type="checkbox"/>
6. State Oil & Gas Lease No.
7. Lease Name or Unit Agreement Name Washington "33" State
8. Well Number 003
9. OGRID Number 00778
10. Pool name or Wildcat Artesia, Queen-Grayburg-San Andres

11. Elevation (Show whether DR, RKB, RT, GR, etc.) GR 3677'
--

Pit or Below-grade Tank Application <input type="checkbox"/> or Closure <input type="checkbox"/>
Pit type _____ Depth to Groundwater _____ Distance from nearest fresh water well _____ Distance from nearest surface water _____
Pit Liner Thickness: _____ mil Below-Grade Tank: Volume _____ bbls; Construction Material _____

**SUNDRY NOTICES AND REPORTS ON WELLS**  
(DO NOT USE THIS FORM FOR PROPOSALS TO DRILL OR TO DEEPEN OR PLUG BACK TO A DIFFERENT RESERVOIR USE "APPLICATION FOR PERMIT" (FORM C-101) FOR SUCH PROPOSALS)

1. Type of Well: Oil Well ☒ Gas Well ☐ Other ☐

2. Name of Operator  
BP America Production Company

3. Address of Operator  
P. O. Box 1610 Midland, TX 79701

4. Well Location  
Unit Letter B : 260 feet from the North line and 1550 feet from the East line  
Section 33 Township 17S Range 28E NMPM County Eddy

11. Elevation (Show whether DR, RKB, RT, GR, etc.)  
GR 3677'

12. Check Appropriate Box to Indicate Nature of Notice, Report or Other Data

NOTICE OF INTENTION TO:

PERFORM REMEDIAL WORK ☐ PLUG AND ABANDON ☐  
TEMPORARILY ABANDON ☐ CHANGE PLANS ☐  
PULL OR ALTER CASING ☐ MULTIPLE COMPL ☐

OTHER: Pull liner from lateral and clean out wellbore ☐

SUBSEQUENT REPORT OF:

REMEDIAL WORK ☐ ALTERING CASING ☐  
COMMENCE DRILLING OPNS. ☐ P AND A ☐  
CASING/CEMENT JOB ☐

OTHER: Pull liner from lateral and clean out wellbore ☐

13. Describe proposed or completed operations. (Clearly state all pertinent details, and give pertinent dates, including estimated date of starting any proposed work). SEE RULE 1103. For Multiple Completions: Attach wellbore diagram of proposed completion or recompletion.

Start date 11/21/2007, completion date 12/14/2007. See attached wellbore schematic.

11/21/2007 MIRU PU. Pulled rods (backed off at pump).  
11/26-30/2007 Perf tbg @ 2165'. ND tbg hd flange. NU BOP. POH with tbg.  
12/3-4/2007 TIH with milling shoe. Milled over packer at 2230'. POH. TIH w/ overshot. Caught packer and pulled 3 1/2" liner from lateral. Left 11 perforated joints and one piece of 3 1/2" liner in lateral.  
12/5/2007 TIH with retrieving hook. Caught whipstock and POH. TIH with bit. Drill out CIBP at 2270'.  
12/6-7/2007 Pushed CIBP to 2849'. Clean out fill to 2910'.  
12/10/2007 TIH with RBP and packer.  
12/11/2007 Treated perfs 2286-2808' w/ 1500 gallons 15% NEFE HCL and 25 bbl xylene. Treated perfs 1422-2068' with 1500 gallons 15% NEFE HCL and 25 bbl xylene.  
12/12/2007 POH w/ RBP and packer. Made wiper run w/ bit. POH. Ran production tbg. ND BOP. NU tbg hd flange. Swabbed 80 bbl water.  
12/14/2007 Ran pump and rods. RDPU.

I hereby certify that the information above is true and complete to the best of my knowledge and belief. I further certify that any pit or below-grade tank has been/will be constructed or closed according to NMOCD guidelines ☐, a general permit ☐ or an (attached) alternative OCD-approved plan ☐.

SIGNATURE W. C. Heard TITLE agent for BP America Production company DATE 12/18/2007

Type or print name W. C. Heard E-mail address: bill.heard@bp.com Telephone No. 432-688-5257

**For State Use Only**

**FOR RECORDS ONLY**

APPROVED BY: \_\_\_\_\_ TITLE \_\_\_\_\_ DATE DEC 27 2007

Conditions of Approval (if any):

S


Washington 33 State #3  
Artesia Field

API No. 30-015-30276

260' FNL & 1550' FEL  
Sec 33 - T17S - R28E  
Eddy County, New Mexico

DEC 26 2007  
OCD-ARTESIA

As Installed

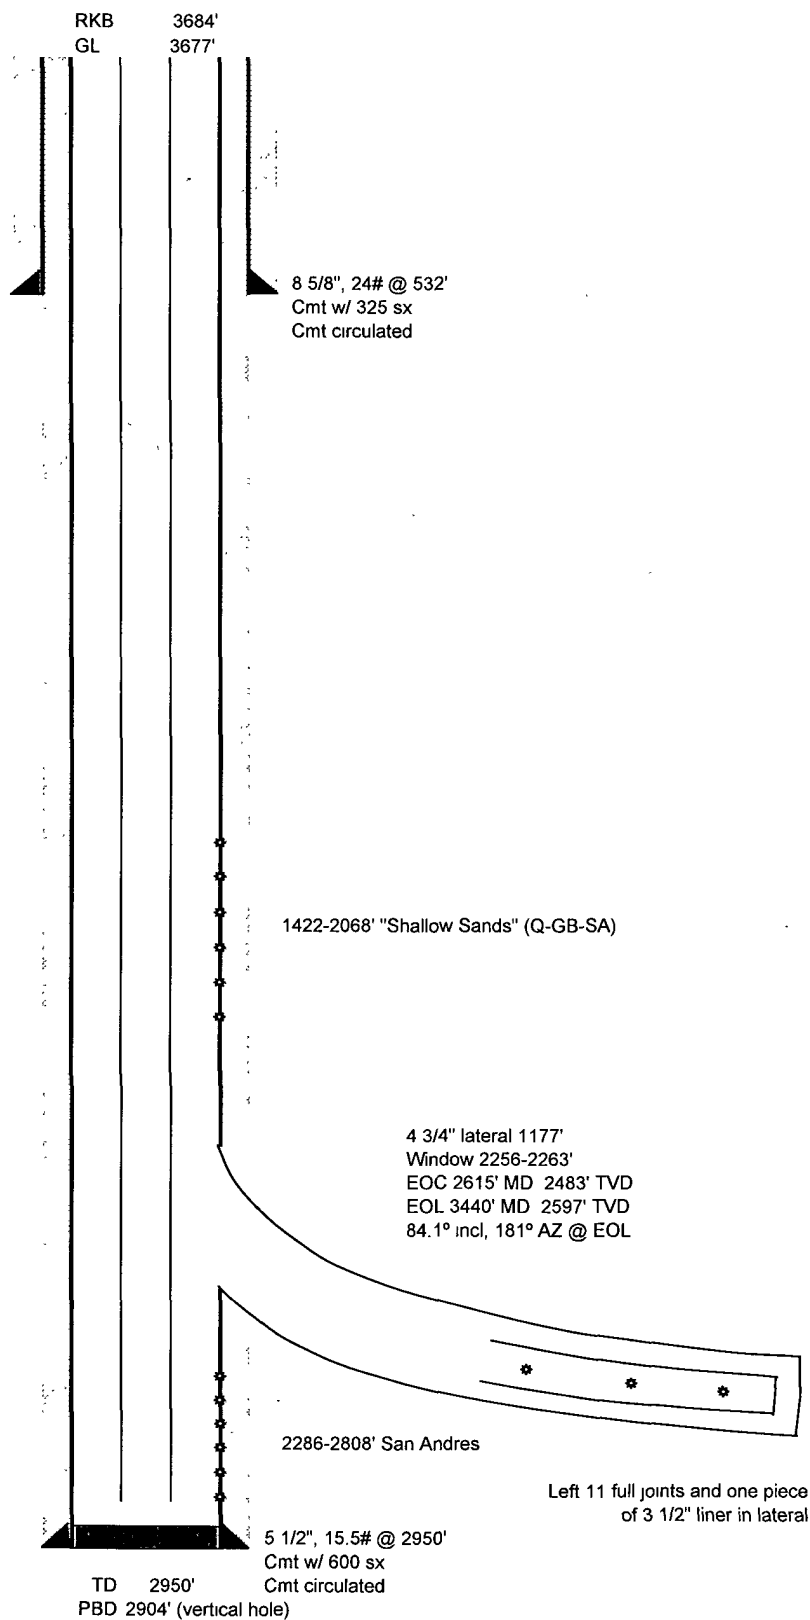

WCH 12/18/2007