Form 3160-5 (August 2007)


## **UNITED STATES** DEPARTMENT OF THE INTERIOR


FORM APPROVED OMB No. 1004-0137 Expires: July 31, 2010

 
BUR	EAU OF LAND MANAGEMENT	5. Lease Serial-No. NMNM107373	5. Lease Serial-No. NMNM107373 NM 29953				
Do not use this f	NOTICES AND REPORTS ON N Form for proposals to drill or t Use Form 3160-3 (APD) for su	6. If Indian, Allottee o					
	T IN TRIPLICATE - Other instructions of	7. If Unit of CA/Agre	7. If Unit of CA/Agreement, Name and/or No.				
1. Type of Well  ✓ Oil Well  ✓ Gas W	Vell Other		8. Well Name and No. Mongo 25 Fed Com #2H				
2. Name of Operator OGX Resources LLC			9. API Well No. 30-015-37164				
3a. Address P. O. Box 2064 Midland, Texas 79702	3b. Phone No 432-685-128	o. (include area code) 37	l l	D. Field and Pool or Exploratory Area cock Spur; Delaware/Bone Spring			
4. Location of Well (Footage, Sec., T., 1980' FNL & 374' FEL, Sec 25, T24S, R28E	R.,M., or Survey Description)		11. Country or Parish, Eddy Co., New Mex				
12. CHEC	CK THE APPROPRIATE BOX(ES) TO INI	DICATE NATURE OF NO	OTICE, REPORT OR OTH	ER DATA			
TYPE OF SUBMISSION		ACTION					
✓ Notice of Intent  ☐ Subsequent Report		cture Treat	Production (Start/Resume) Reclamation Recomplete	Water Shut-Off  Well Integrity  ✓ Other Install gas compr,			
Final Abandonment Notice			emporarily Abandon  Nater Disposal	etc.			
OGX Resources LLC requests perm (1) one inch fuel line to scrubber, (e	nission to install (a) Three-Stage 700 HF ) one (1) one inch flowline to steel tank requests permission to install one (1) 3 said Section 25 Removed	<sup>o</sup> Gas Compressor, (b) C from scrubber, on the ex <del>inch buried steel flowline</del>	One (1) 100 bbl steel tank isting well pad of the Most from well pad going ear of 3 - 22 - 1	k, (c) one (1) gas scrubber, (d) one ingo 25 Fed Com #2H Well. <del>In-</del>			
Shelley Bush	and and correct. Islante (17 maca 19 pea)	Title Regulatory Anal	ry Analyst				
Signature Alllen	Bush						
	THIS SPACE FOR FEDE	ERAL OR STATE C	FFICE USE				
that the applicant holds legal or equitable to entitle the applicant to conduct operations.  Title 18 U.S.C. Section 1001 and Title 43 fictitious or fraudulent statements or repre	1. Approval of this notice does not warrant or itle to those rights in the subject lease which withereon.  U.S.C. Section 1212, make it a crime for any posentations as to any matter within its jurisdiction.	oerson knowingly and willful	)	Date 3-27-/			
(Instructions on page 2)				alle !			

## **LOCATION MAP**

dirkhich i Dirkhich i	44s, 70f 060	8	State of New Mexico						Evrient Culmber 12, 2005			
DISTRICT II	Adrilla AR	2213	Energy, Etherels and Rebural Recourson Department						Submit to appropriate District Ciffics			
DISTRICT III		OIL CONSERVATION DIVISION										
DESTRICT IV	. Prote Re. 1	Oct #25000		morre	en roj	740H W	21000					
WELL LOCATION AND ACREAGE DEDICATION PLAT									HEFUKT			
ASPE S	in par		Port Cods Peet Reme									
Vermoster C	Froperty Ceda Property Reno Well Simpler									mbur		
}		]	MONGO "25" FEDERAL COM 2H									
OCETO R			Operator Namo Staventing									
CGX RESOURCES, L.L.C. 2912' Surface Location												
The part Ha.	Seption	Township	Dango	Lot Ma	Voet Co		Morth/Bouth Der	I A	et trom the	Part/Test Pine	County	
н	25	24 S	28 E		19	80	NORTH	Ĭ	374	EAST	EDDY	
Bottom Hole Location If Different From Surface												
UL or Jos Do.	Section	Township	Renge	Lot Min	Fort fr	na the	North/South line			Rest/Test Elae	County	
E	25	24 \$	28 E	<u> </u>	, ,,	80	NORTH		350	WEST	EDDY	
Bodicated Annu		-	manitication	·	rder Ma,							
L RO ATTE	THE ATTEMATIC THIS BE ACCUMING TO THE CONTROL OF TH											
WA 6000	NO ALLOVABLE VILL BE ASSIGNED TO THE COMPLETION UNTIL ALL INTERESTS HAVE BEEN CONSOLIDATED OR A NON-STANDARD UNIT HAS BEEN APPROVED BY THE DIVISION											
								$\neg$	OPERATO	R CERTIFICAT	MOE	
11	·					i		-   }	Abouty as	city that the defend in the free and emile learnings and being a cliffer being a trail and mobered citizen the property better of the embrack soft wife to embrack soft the develope when hay agreement or a long arms harpitytes		
	1		•	Į.		ļ	j	1	the test of ear this organisation	According and bells a color out a con-	क्षा क्षा क्षा	
9				1			096	-	land transiting	के इस्ट्राब्वर रेस्स्या व १७ क क्यांट्राब्द क्यांट्र		
)) Ť				i		i	I	H	emingrah ber	pot many productions great disconnections on a many disconnection of a potential and a many disconnection of a many disconnect	enthreef by	
				+		·-÷·		_~1		·		
	!			1		- 1	2908.2'	22				
350'			4552.F	1		l l	33	74	Algorithms		Dete	
				1		<del>-  </del>		7	Petritud Stars			
]]						j	2909.9	궯	Princes, page			
1						_ !		<u>ā</u>	BUBARYO	R CERTIFICAS	TON	
		i				i			I haraby early)	one that the sent took	ton elecen	
BOTTOM HOLE	LOCATION	!					SURFACE LOCATION		estud currept	n pistini from fisi meta ta ma er	<b>w</b> êr (27	
TOKO - AT 25.	72 KK 74°	t I				30	r - 41: 221126,16	F		d that the acts to a test of way take		
25.0-FT 62834						25	C.N.: 433103.075 E: 634175.318		FERR	UARNESS. 2	മവം	
	7	]				į	(NAD-53)		Dato Survey			
lr				†·		-+-		-	Eignature Protestic			
		i				-	•			(m)		
						j			J 1			
						- !			Ø.W		4	
	i	; 				 			Cartificate #	- Cary L Jense	7977	
IL				1		- 1		П	190	LOTH RETURNS R		

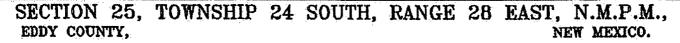

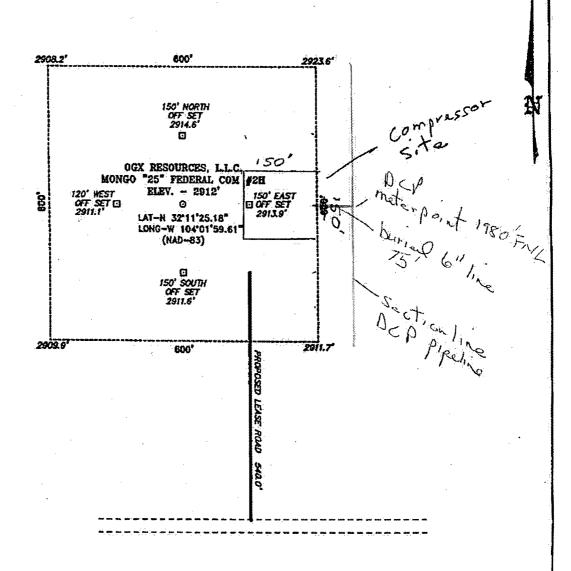



FROM THE JUNCTION OF HWY 285 AND CO. RD. 721; CO EAST ON PULLY FOR 1.2 MILES TO LEASE ROAD, ON LEASE ROAD GO SOUTHERLY 0.5 MILES TURNING EAST FOR 0.5 MILES TO PROPOSED LEASE ROAD.

BASIN SURVEYS P.O. BOX 1786-HOBBS, NEW MEXICO

W.O. Number: 21104 Drawn By; J. M. SMALL
Date: 02-19-2009 Disk: JMS 21104

200 0 200 400 FEET

SCALE: 1" = 200'

## OGX RESOURCES, L.L.C.

REF: MONGO "25" FEDERAL COM #2H / Well Pad Topo
THE MONGO "25" FEDERAL COM #2H LOCATED 1980' FROM

THE NORTH LINE AND 374' FROM THE EAST LINE OF SECTION 25, TOWNSHIP 24 SOUTH, RANGE 28 EAST,

N.M.P.M., EDDY COUNTY, NEW MEXICO.

Survey Date: 02-18-2009 Sheet 1 of 1 Sheets