

STATE OF NEW MEXICO
ENERGY AND MINERALS DEPARTMENT

OIL CONSERVATION DIVISION
P. O. BOX 2088 **RECEIVED**
SANTA FE, NEW MEXICO 87501

30-005-60684

Form C-101
Revised 10-1-78

NO. OF COPIES RECEIVED	5
DISTRIBUTION	
SANTA FE	1
FILE	1
U.S.G.S.	2
LAND OFFICE	
OPERATOR	1

MAR 19 1980

O. C. D.

APPLICATION FOR PERMIT TO DRILL, DEEPEN, OR PLUG BACK

5A. Indicate Type of Lease
STATE ☐ FEE ☒

6. State Oil & Gas Lease No.

7. Unit Agreement Name

8. Farm or Lease Name
Miller & Olsen

9. Well No.
2

10. Field and Pool, or Wildcat
Unders. Railroad Mountain-SA

17. County
Chaves

1a. Type of Work
DRILL ☒ DEEPEN ☐ PLUG BACK ☐

b. Type of Well
OIL WELL ☒ GAS WELL ☐ OTHER ☐
SINGLE ZONE ☒ MULTIPLE ZONE ☐

2. Name of Operator
Phoenix Resources Company

3. Address of Operator
c/o Oil Reports & Gas Services, Inc., Box 763, Hobbs, NM 88240

4. Location of Well
UNIT LETTER H LOCATED 1980 FEET FROM THE North LINE
AND 660 FEET FROM THE East LINE OF SEC. 3 TWP. 8S RGE. 28E NADPM

19. Proposed Depth 3200	19A. Formation San Andres	20. Rotary or C.T. Rotary
21. Elevations (Show whether D.R., K.T., etc.) 3983.3 GR	21A. Kind & Status Plug. Bond Blanket	21B. Drilling Contractor Baber Well Service
		22. Approx. Date Work will start 4/7/80

PROPOSED CASING AND CEMENT PROGRAM

SIZE OF HOLE	SIZE OF CASING	WEIGHT PER FOOT	SETTING DEPTH	SACKS OF CEMENT	EST. TOP
11	8 5/8	24#	250	150	Circ
6 3/4	4 1/2	10.5#	3200	250	1400

Completion to be conventional perforation & treatment

Blowout preventor: 10" series 900 Shafer double ram

APPROVED AND
FOR SECRETARY OF
DRILLING DIVISION, N.M.
EXPIRES 6-21-80

4. ABOVE SPACE DESCRIBE PROPOSED PROGRAM: IF PROPOSAL IS TO DEEPEN OR PLUG BACK, GIVE DATA ON PRESENT PRODUCTIVE ZONE AND PROPOSED NEW PRODUCTIVE ZONE. GIVE BLOWOUT PREVENTER PROGRAM, IF ANY.

I hereby certify that the information above is true and complete to the best of my knowledge and belief.

Signed W. A. Gussitt Title Agent Date 3/18/80

(This space for State Use)

APPROVED BY W. A. Gussitt TITLE SUPERVISOR, DISTRICT II DATE MAR 21 1980

CONDITIONS OF APPROVAL, IF ANY:

WELL LOCATION AND ACREAGE DEDICATION PLAT

Form C-102
Supersedes C-128
Effective 1-1-65

All distances must be from the outer boundaries of the Section.


Operator Phoenix Resources Co.		Lease Miller and Olsen		Area #2
Unit Letter H	Section 3	Township 8 South	Range 28 East	Chaves
Actual Footage Location of Well: 1980 feet from the North line and 660 feet from the East				
Ground Level Elev. 3983.3	Producing Formation San Andres	Pool Undes. Railroad Mountain		40

1. Outline the acreage dedicated to the subject well by colored pencil or hatchure marks on the plat below.
2. If more than one lease is dedicated to the well, outline each and identify the ownership thereof (both as to working interest and royalty).
3. If more than one lease of different ownership is dedicated to the well, have the interests of all owners been consolidated by communitization, unitization, force-pooling, etc?

☐ Yes ☐ No If answer is "yes," type of consolidation _____

If answer is "no," list the owners and tract descriptions which have actually been consolidated (Use reverse side of this form if necessary.) _____

No allowable will be assigned to the well until all interests have been consolidated (by communitization, unitization, forced-pooling, or otherwise) or until a non-standard unit, eliminating such interests, has been approved by the Commission.

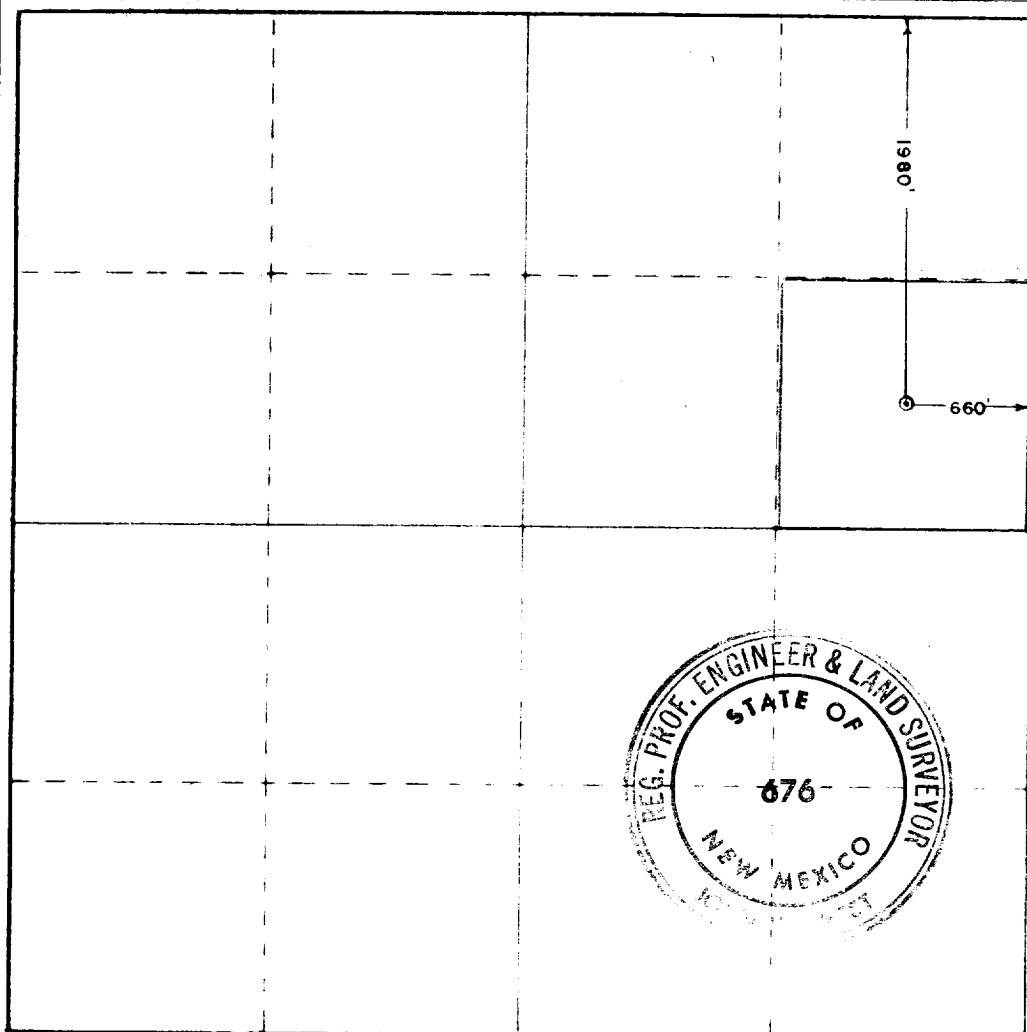

CERTIFICATION

I hereby certify that the information contained herein is true and complete to the best of my knowledge and belief.

Marina Hollos
Agent

Phoenix Resources Company

3/18/80

I hereby certify that the well location shown on this plat was plotted from field notes of actual surveys made by me or under my supervision, and that the same is true and correct to the best of my knowledge and belief.

March 17, 1980

John W. West
Certificate No. **JOHN W. WEST 676**
PATRICK A. ROMERO 6665
Ronald J. Eidson 3239

0 330 660 990 1320 1650 1980 2310 2640 2970 3300 3630 3960 4290 4620 4950 5280 5610 5940 6270 6600