

MEXICO OIL CONSERVATION COMMISSION  
WELL LOCATION AND ACREAGE DEDICATION PLAT

Form C-102  
Supersedes C-128  
Effective 11-65

All distances must be from the outer boundaries of the Section.


Operator <b>CORINNE GRACE</b>				STATE		Well No. <b>2</b>
Unit Letter <b>B</b>	Section <b>1</b>	Township <b>15 SOUTH</b>	Range <b>29 EAST</b>	County <b>CHAVES</b>		
Actual Footage Location of Well: <b>660</b> feet from the <b>NORTH</b> line and <b>1650</b> feet from the <b>EAST</b> line						
Ground Level Elev. <b>3860.3</b>	Producing Formation <i>Green</i>		Pool <i>And. Permian G. Green</i>		Dedicated Acreage: <i>461</i> Acres	

1. Outline the acreage dedicated to the subject well by colored pencil or hatchure marks on the plat below.
2. If more than one lease is dedicated to the well, outline each and identify the ownership thereof (both as to working interest and royalty).
3. If more than one lease of different ownership is dedicated to the well, have the interests of all owners been consolidated by communitization, unitization, force-pooling, etc?

☐ Yes ☐ No If answer is "yes," type of consolidation \_\_\_\_\_

If answer is "no," list the owners and tract descriptions which have actually been consolidated. (Use reverse side of this form if necessary.) \_\_\_\_\_

No allowable will be assigned to the well until all interests have been consolidated (by communitization, unitization, forced-pooling, or otherwise) or until a non-standard unit, eliminating such interests, has been approved by the Commission.

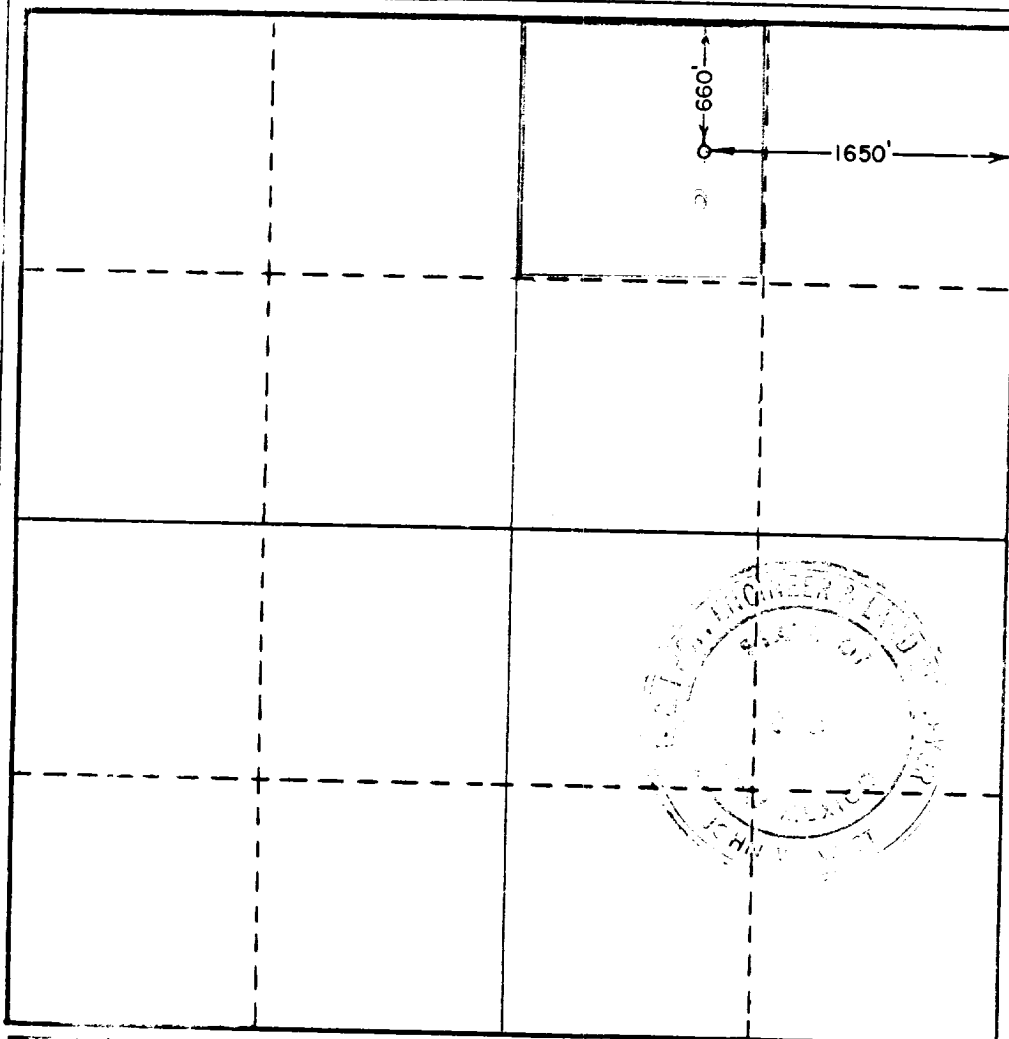

CERTIFICATION

I hereby certify that the information contained herein is true and complete to the best of my knowledge and belief.

Name  
*Wanda Keller*

Position

**Agent**

Company

**Corinne Grace**

Date

**December 7, 1970**

I hereby certify that the well location shown on this plat was plotted from field notes of actual surveys made by me or under my supervision, and that the same is true and correct to the best of my knowledge and belief.


Date Surveyed

**DECEMBER 3, 1970**

Registered Professional Engineer and/or Land Surveyor

*John W. West*  
Certificate No.

**676**

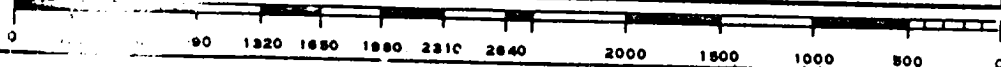

NO. OF COPIES RECEIVED	
DISTRIBUTION	
SANTA FE	
FILE	
U.S.G.S.	
LAND OFFICE	
OPERATOR	

NEW MEXICO OIL CONSERVATION COMMISSION

DEC 7 1970

O. C. C.  
ARTESIA, OFFICE

30-005-60156  
Form C-101  
Revised 1-1-65

5A. Indicate Type of Lease	STATE <input checked="" type="checkbox"/> FEE <input type="checkbox"/>
5. State Oil & Gas Lease No.	<b>K-4321</b>

APPLICATION FOR PERMIT TO DRILL, DEEPEN, OR PLUG BACK

1a. Type of Work		7. Unit Agreement Name	
b. Type of Well OIL WELL <input checked="" type="checkbox"/> GAS WELL <input type="checkbox"/> OTHER <input type="checkbox"/> DRILL <input checked="" type="checkbox"/> DEEPEN <input type="checkbox"/> PLUG BACK <input type="checkbox"/> SINGLE ZONE <input checked="" type="checkbox"/> MULTIPLE ZONE <input type="checkbox"/>		8. Farm or Lease Name	
2. Name of Operator <b>Corinne Grace</b>		9. Well No. <b>2</b>	
3. Address of Operator <b>c/o Oil Reports &amp; Gas Services, Inc., Box 763, Hobbs, N. M. 88240</b>		10. Field and Pool, or Wildcat <b>Double I. Queen</b>	
4. Location of Well UNIT LETTER <b>B</b> LOCATED <b>660</b> FEET FROM THE <b>North</b> LINE AND <b>1650</b> FEET FROM THE <b>East</b> LINE OF SEC. <b>1</b> TWP. <b>15S</b> RGE. <b>29E</b> NMPM		12. County <b>Chaves</b>	
21. Elevations (Show whether DF, RT, etc.) <b>3860.3</b>		19. Proposed Depth <b>2050</b>	
21A. Kind & Status Plug. Bond <b>Blanket</b>		19A. Formation <b>Queen</b>	
21B. Drilling Contractor <b>Jack Burrows</b>		20. Rotary or C.T. <b>Cable Tool</b>	
22. Approx. Date work will start <b>Upon approval</b>			

PROPOSED CASING AND CEMENT PROGRAM

SIZE OF HOLE	SIZE OF CASING	WEIGHT PER FOOT	SETTING DEPTH	SACKS OF CEMENT	EST. TOP
12 1/4	8 5/8	24#	300	250	circ.
7 7/8	5 1/2	14#	2050	250	610

APPROVAL VALID  
FOR 90 DAYS UNLESS  
DRILLING COMMENCED,

EXPIRES **3-7-71**

IN ABOVE SPACE DESCRIBE PROPOSED PROGRAM: IF PROPOSAL IS TO DEEPEN OR PLUG BACK, GIVE DATA ON PRESENT PRODUCTIVE ZONE AND PROPOSED NEW PRODUCTIVE ZONE. GIVE BLOWOUT PREVENTER PROGRAM, IF ANY.

I hereby certify that the information above is true and complete to the best of my knowledge and belief.

Signed *Norman Hollos* Title Agent Date 12/7/70

(This space for State Use)

APPROVED BY *W. A. Gressett* TITLE OIL AND GAS INSPECTOR DATE DEC 7 1970

CONDITIONS OF APPROVAL, IF ANY:

Cement must be circulated to