
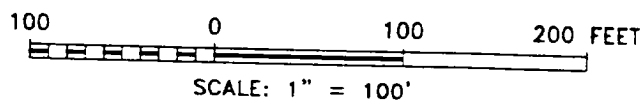


SECTION 7, TOWNSHIP 17 SOUTH, RANGE 28 EAST, N.M.P.M.,
EDDY COUNTY, NEW MEXICO.

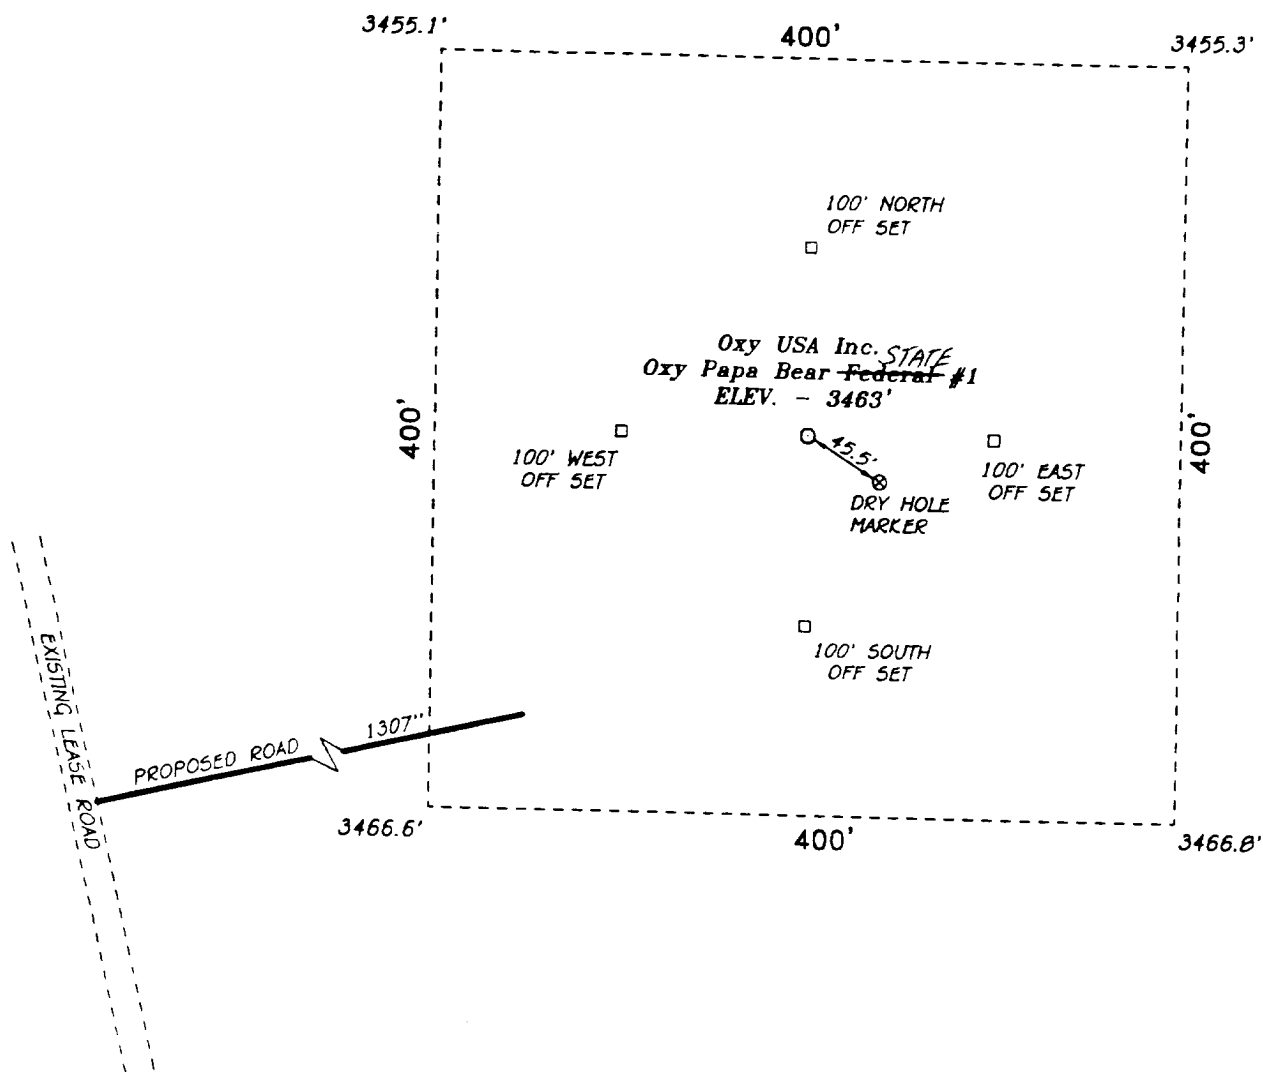

Oxy USA Inc.

REF: Oxy Papa Bear ~~Fed.~~ No. 1/ Well Pad Topo

THE OXY PAPA BEAR ~~FED.~~ ^{STATE} No. 1 LOCATED 1980' FROM THE
SOUTH LINE AND 1980' FROM THE WEST LINE OF
SECTION 7, TOWNSHIP 17 SOUTH, RANGE 28 EAST,
N.M.P.M., EDDY COUNTY, NEW MEXICO.

BASIN SURVEYS P.O. BOX 1786-HOBBS, NEW MEXICO

W.O. Number: 8509

Drawn By: K. GOAD

Date: 11-25-98

Disk: KJG #119 - 8509A.DWG

Survey Date: 11-24-98