






OPERATOR RICHARDSON & BASS  
LEASE FEDERAL-VAN S WELCH,  
TRUSTEE, ET AL

DATE 5-22-54  
SCALE " = 1000'

LOCATION NO 1  
COUNTY EDDY STATE NEW MEXICO

SEC. 20, T20S, R31E

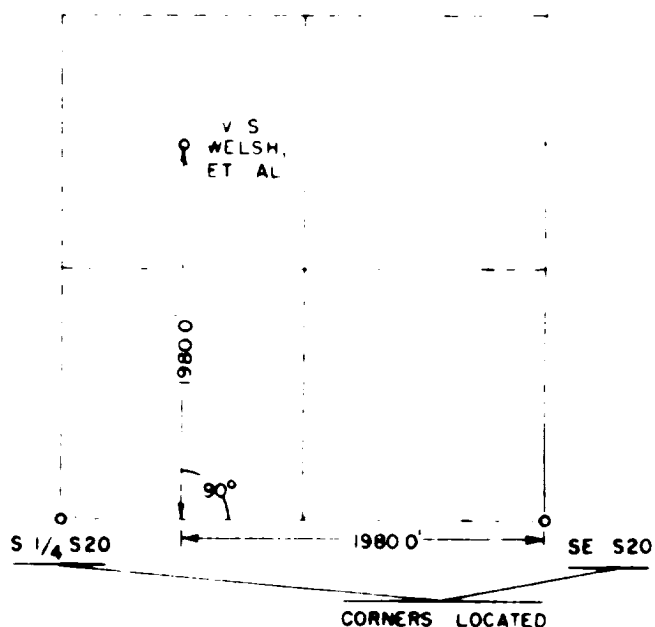

I CERTIFY THAT THE ABOVE PLAT WAS CONSTRUCTED  
FROM NOTES TAKEN BY ME IN THE FIELD AND IS  
TRUE AND CORRECT TO THE BEST OF MY KNOWLEDGE  
AND BELIEF.

*Ben T Phillips, Jr.*

BEN T PHILLIPS, JR., R.L.S.

