

UNITED STATES  
DEPARTMENT OF THE INTERIOR  
GEOLOGICAL SURVEY

## APPLICATION FOR PERMIT TO DRILL, DEEPEN, OR PLUG BACK

## 1a. TYPE OF WORK

DRILL ☒DEEPEN ☐PLUG BACK ☐

## b. TYPE OF WELL

OIL  
WELL ☐GAS  
WELL ☒OTHER ☐

## 2. NAME OF OPERATOR

DAVID FASKEN

## 3. ADDRESS OF OPERATOR

608 First National Bank Building, Midland, TX 79701

## 4. LOCATION OF WELL (Report location clearly and in accordance with any State requirements.)\*

At surface  
1980' FSL & 1650' FWL, Section 35  
At proposed prod. zone

## 14. DISTANCE IN MILES AND DIRECTION FROM NEAREST TOWN OR POST OFFICE\*

6 miles North of Carlsbad

## 15. DISTANCE FROM PROPOSED\*

LOCATION TO NEAREST  
PROPERTY OR LEASE LINE, FT.  
(Also to nearest drlg. unit line, if any)

1650'

## 16. NO. OF ACRES IN LEASE

640

## 17. NO. OF ACRES ASSIGNED

320

18. DISTANCE FROM PROPOSED LOCATION\*  
TO NEAREST WELL, DRILLING, COMPLETED,  
OR APPLIED FOR, ON THIS LEASE, FT.

1650'

## 19. PROPOSED DEPTH

11400'

## 20. ROTARY OR CABLE TOOLS

Rotary

## 21. ELEVATIONS (Show whether DF, RT, GR, etc.)

3234.1' GR

## 23.

## PROPOSED CASING AND CEMENTING PROGRAM

SIZE OF HOLE	SIZE OF CASING	WEIGHT PER FOOT	SETTING DEPTH	QUANTITY OF CEMENT
17-1/2"	13-3/8"	54.50	400'	350 Lite 100" C" CIRCULATE
12-1/4"	8-5/8"	24 & 32	3000'	900 Lite 1200" C" CIRCULATE
7-7/8"	4-1/2"	11.60 & 13.50	11400'	1st Stage 1000" H" 2nd Stage 1400" C" 50-50 Pozmix out DV tool 7000'

Please refer to the attached:

1. Drilling & Completion Procedure
2. B.O.P. Specifications
3. Archaeologist's Report

Estimated Tops: 3rd Bone Springs 7820', Penn Lime 9200', Strawn 9700', Atoka 10000',  
Morrow 10600'.

No abnormal pressure zones anticipated.

Drilling duration estimated @ 45 days.

Gas is dedicated to El Paso Natural Gas Company.

IN ABOVE SPACE DESCRIBE PROPOSED PROGRAM: If proposal is to deepen or plug back, give data on present productive zone and proposed new productive zone. If proposal is to drill or deepen directionally, give pertinent data on subsurface locations and measured and true vertical depths. Give blowout preventer program, if any.

## 24.

SIGNED

*Robert H. Angevine*

TITLE Robert H. Angevine, Agent

DATE 4-1-81

(This space for Permittee's use)

APPROVED

PERMIT NO.

APPROVAL DATE

APPROVED BY: APR 9 1981

TITLE

CONDITIONS OF APPROVAL, IF ANY:

(SIGNED) GEORGE H. STEVAKI

JAMES A. GILLHAM  
DISTRICT SUPERVISOR

\*See Instructions On Reverse Side

**NEW MEXICO OIL CONSERVATION COMMISSION  
WELL LOCATION AND ACREAGE DEDICATION PLAT**

Form C-101  
Supersedes C-126  
Effective 1-1-65

All distances must be from the outer boundaries of the Section.

Owner <b>David Fasken</b>		Lease <b>Maralo Fed.</b>		Well No. <b>2</b>
Section <b>K</b>	Section <b>35</b>	Township <b>20 South</b>	Range <b>27 East</b>	County <b>Eddy</b>

Actual Well Location of Well:


<b>1980</b>	feet from the <b>South</b>	line and	<b>1650</b>	feet from the <b>West</b>	line
Ground Level Elev. <b>3234.1</b>	Producing Formation <b>Morrow</b>	Pool <b>Burton Flat</b> <b>Avalon Morrow</b>	Dedicated Acreage: <b>320</b>		

- Outline the acreage dedicated to the subject well by colored pencil or hatchure marks on the plat below.
- If more than one lease is dedicated to the well, outline each and identify the ownership thereof (both as to working interest and royalty).
- If more than one lease of different ownership is dedicated to the well, have the interests of all owners been consolidated by communitization, unitization, force-pooling, etc? Working interest unit w/David Fasken as operator.

☒ Yes    ☐ No    If answer is "yes," type of consolidation All Federal Acreage & Lease

If answer is "no," list the owners and tract descriptions which have actually been consolidated. (Use reverse side of this form if necessary.)

No allowable will be assigned to the well until all interests have been consolidated (by communitization, unitization, forced-pooling, or otherwise) or until a non-standard unit, eliminating such interests, has been approved by the Commission.

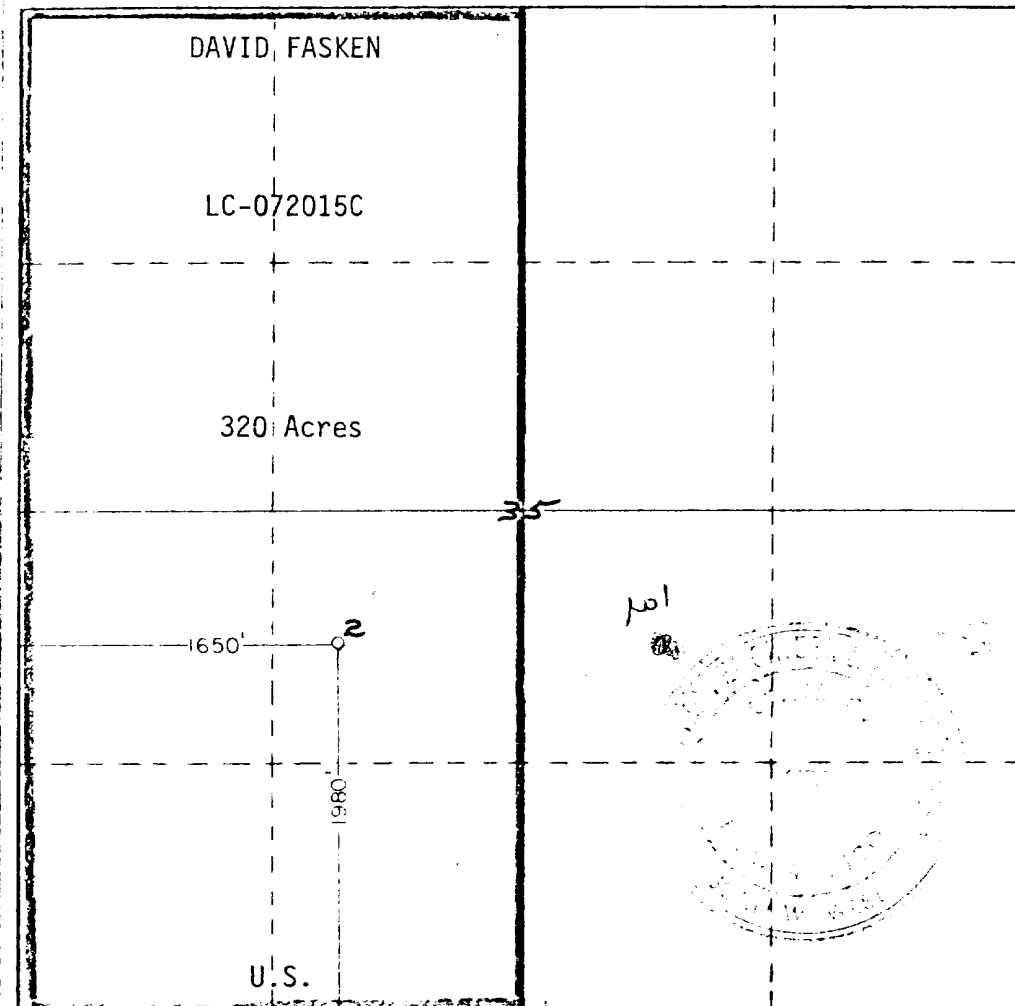

**CERTIFICATION**

I hereby certify that the information contained herein is true and complete to the best of my knowledge and belief.

*Robert H. Angevine*  
Signature  
**Robert H. Angevine**

Position  
**Agent**

Company  
**DAVID FASKEN**

Date  
**4-1-81**

I hereby certify that the well location shown on this plat was plotted from field notes of actual surveys made by me or under my supervision, and that the same is true and correct to the best of my knowledge and belief.

Date Surveyed  
**2-9-81**


Registered Professional Engineer  
and/or Land Surveyor

*John W. West*  
Signature  
Certificate No. **JOHN W. WEST 878**  
**PATRICK A. ROMERO 6663**  
**Ronald J. Eidson 3239**

0 330 660 990 1320 1650 1980 2310 2640 2000 1500 1000 500

# B.O.P. ARRANGEMENT—RIG NO. 7

12" GK HYDRIL 3000 WP  
 160 GALLON—7 STATION KOOMEY ACCUMULATOR WITH REMOTE CONTROL  
 3000 LB. WP CHOKE MANIFOLD  
 13 5/8" TYPE "U" CAMERON 5000 WP, DOUBLE B.O.P.

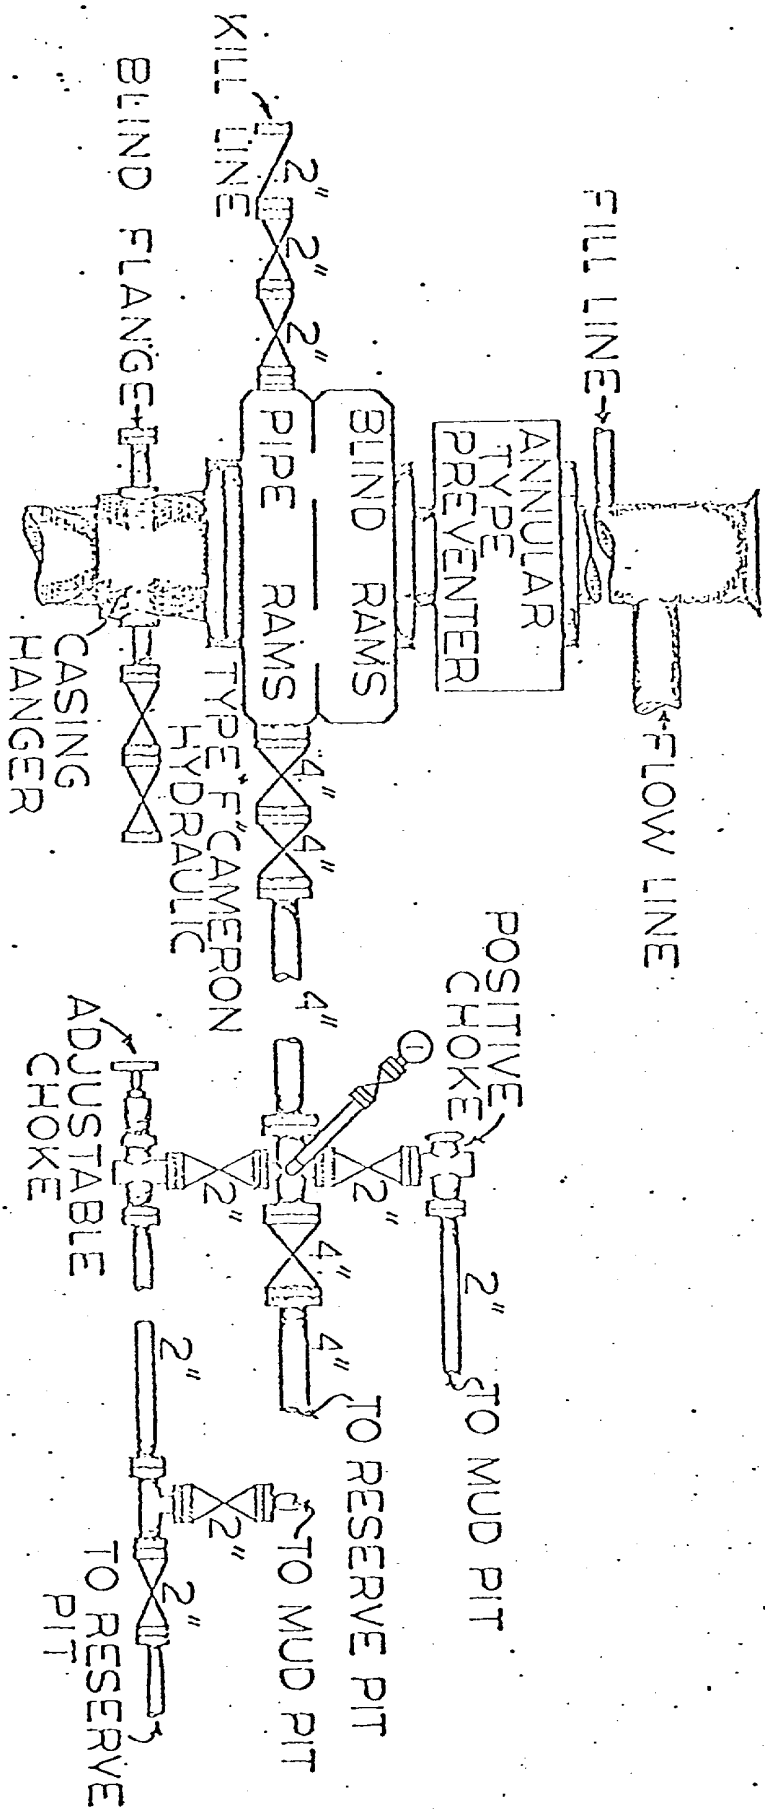

HENRY ENGINEERING  
*Petroleum Engineers*  
807 FIRST NATIONAL BANK BUILDING  
MIDLAND, TEXAS 79701

April 1, 1981

RECEIVED

APR 15 1981

O. C. D.

ARTESIA, OFFICE

RECEIVED  
APR - 3 1981

U. S. G. S.  
P. O. Drawer 1857  
Roswell, New Mexico 88201

Attention: George Stewart

Re: David Fasken  
Maralo Federal No. 2  
1980' FSL & 1650' FWL  
Sec. 35, T-20-S, R-27-E  
Eddy County, New Mexico


Gentlemen:

On behalf of our client, David Faslen, we are submitting an application to drill the subject well. A list of enclosed exhibits is attached to this letter.

If you require any additional exhibits or data to expedite approval of this drill site, please call me at 1-915-683-1893.


Yours truly,

HENRY ENGINEERING

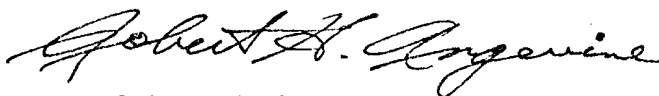

Robert H. Angevine


RHA:jcs  
Enclosures

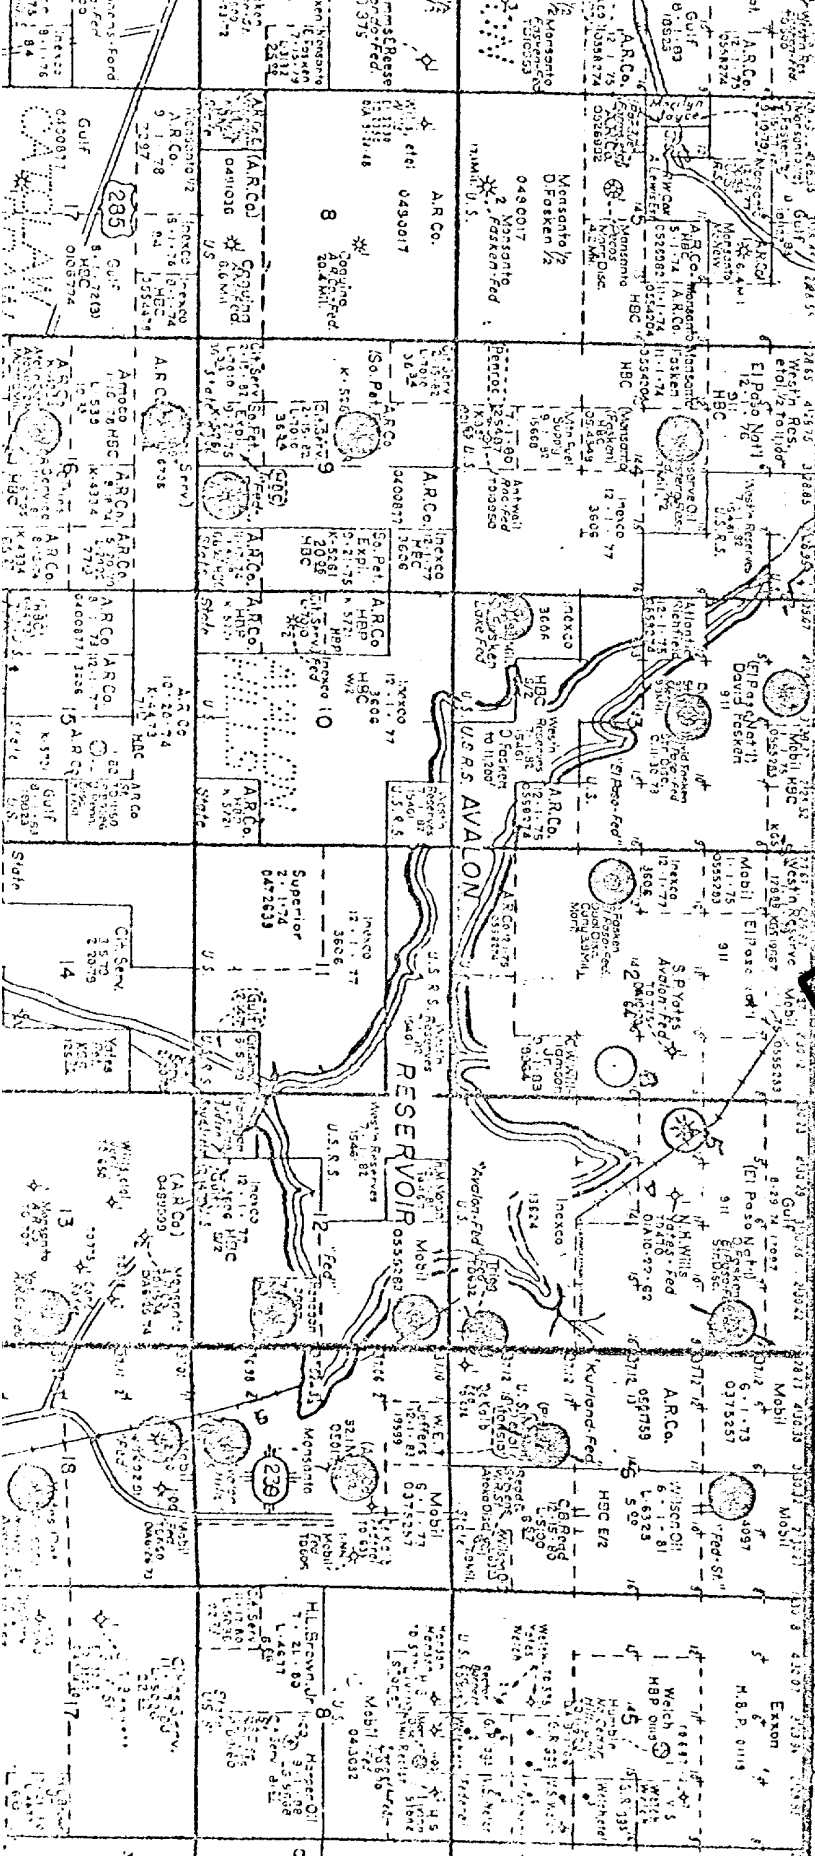

MULTIPOINT SURFACE USE AND OPERATIONS PLAN

for

DAVID FASKEN

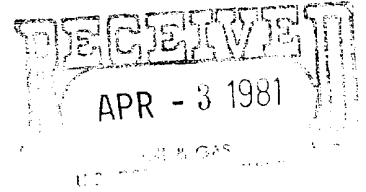

Maralo Federal No. 2

1980' FSL & 1650' FWL, Sec. 35, T-20-S, R-27-E

Eddy County, New Mexico

1. Existing Roads. The attached plat of a portion of the Lake McMillan, South, New Mexico, quadrangle shows existing roads in the Lake Avalon area and in the vicinity of the proposed wells. Existing Eddy County maintained roads will be utilized.
2. Planned Access Road. The attached plat referred to in 1. above shows the planned new access road as a single dashed line high-lighted in red. The new road bed will be 12' wide by 30' long with no major cuts or fills to be encountered. Due to the short length, no turnouts will be required. No fences will be cut and no cattleguards will be required.
3. Location of Existing Wells. Existing wells are shown on a portion of E. Eddy County map.
4. Location of Tank Batteries, Production Facilities, etc. All condensate tanks, separators, dehydrators and/or gas meters will be located at the well site.
5. Location and Type of Water Supply. A water supply well is shown on the Lake McMillan, South, New Mexico, quadrangle located 2900' FEL & 2800' FNL, Section 3, T-21-S, R-26-E, NMPM, Eddy County, New Mexico. This well was drilled by David Fasken and has supplied drilling water for seven gas wells.
6. Methods for Handling Waste Disposal. Cuttings from the well bore will be contained in conventional earth reserve pits. The top soil will be used in the pit walls and used to cover the pits after they have been dried and leveled.

Garbage will be burned in a burner pit dug in the reserve pit excavation in an area cleared of all flammable vegetation and materials.

The only salts and chemicals anticipated to be used will be in the drilling mud and will be buried after the mud in the reserve pit with the cuttings has dried.

Sewage will be disposed of into a temporary septic tank dug at the rig trailer house. This will be filled with dirt, covered with top soil and leveled at the completion of the well.

Drilling fluids will be allowed to dry in the reserve pits and will be buried with the cuttings and backfilled with top soil.

Produced oil and water will be contained in test tanks and the oil trucked to the nearest pipeline and the water hauled by transport truck to the nearest commercial disposal well and injected therein.

7. Ancillary Facilities. None are planned.
8. Well Site Layout. See attached plat.

9. Restoration of the Surface. The location will be reshaped to the original contour of the surface except for the area needed to service the well. Unnecessary pad and roadway will be "ripped" to help with recovery of natural plants.

START: 60 Days after completion of well.

END: 120 Days after completion of well.

10. Other Information. All lands are Federal ownership. The surface is utilized for cattle grazing and administered by the Bureau of Land Management.

11. Operator's Representative.

James B. Henry, Agent for David Fasken  
Henry Engineering  
807 First National Bank Building  
Midland, Texas 79701


Business Phone: 1-915-683-1893

Home Phone: 1-915-694-0137

12. Certification.


I hereby certify that I, or persons under my direct supervision, have inspected the proposed drillsite and access route; that I am familiar with the conditions which presently exist; that the statements made in this plan are, to the best of my knowledge, true and correct; and, that the work associated with the operations proposed herein will be performed by David Fasken and his contractors and sub-contractors in conformity with this plan and the terms and conditions under which it is approved.

April 1, 1981

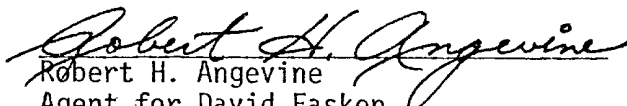  
Robert H. Angevine  
Agent for David Fasken

RHA:jcs



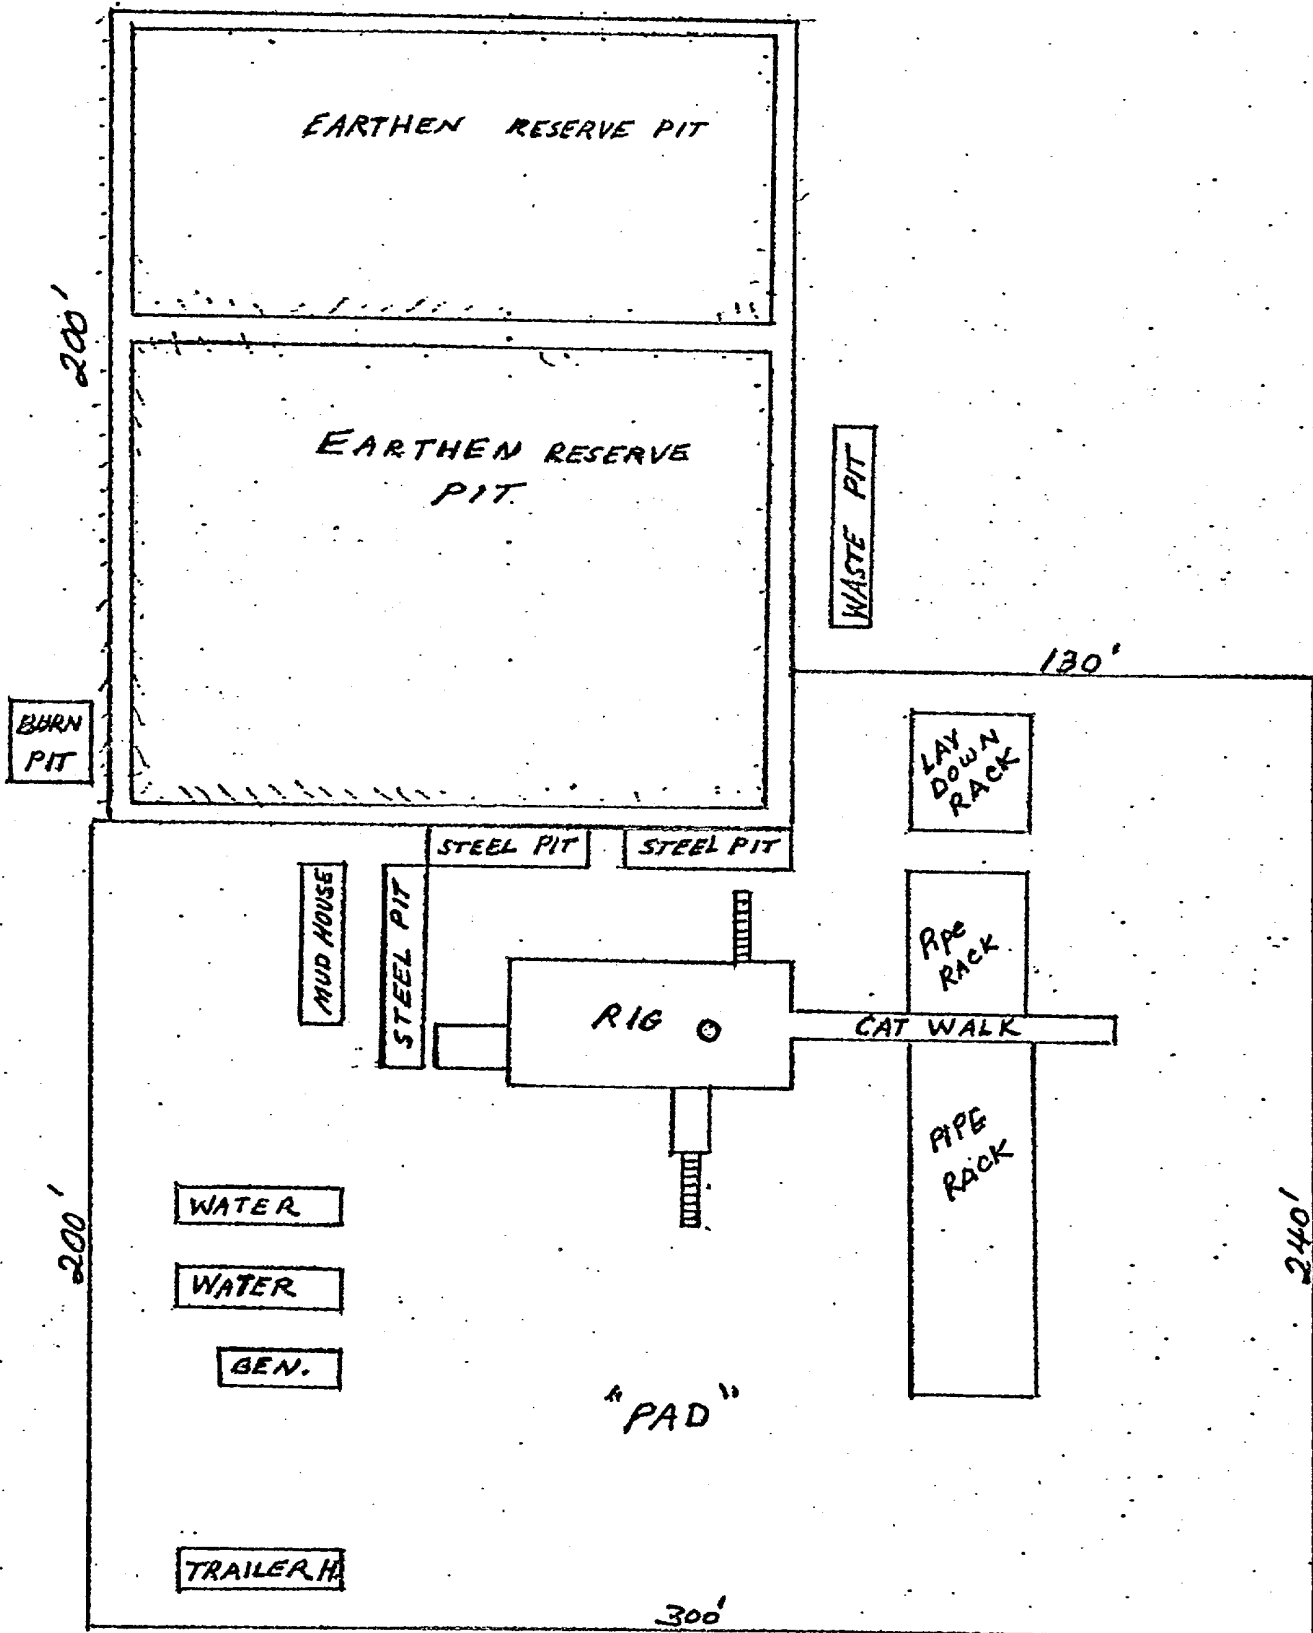

HENRY ENGINEERING  
MIDLAND, TEXAS

RIG & WELL SITE PLAT

RECOMMENDED DRILLING & COMPLETION PROCEDURE

A.F.E. NO. 463

David Fasken ----- MARALO FEDERAL NO. 2 ----- Avalon (Morrow) Field  
Eddy County, New Mexico

1. Drill 17-1/2" hole to 400' with spud mud.
2. Set 13-3/8" casing at 400', cement to surface and install 12" x 3000 psi W.P. casinghead and B.O.P. stack. (Estimate 350 sxs Halliburton Lite w/1/2# Flocele per sack and 2% CaCl, slurry weight 12.7 ppg, yield 1.85 cf/sx, plus 100 sxs Class "C" with 2% CaCl.)
3. Drill 12-1/4" hole to 3000' with fresh water, control seepage with paper. Dry drill if complete loss of returns is encountered.
4. Set and cement 8-5/8" casing at 3000' with sufficient cement to circulate (Estimate 900 sxs Halliburton Lite with 1/2# Flocele per sack plus 2% CaCl, slurry weight 12.7 ppg, yield 1.85 cf/sx, plus 200 sxs Class "C" with 2% CaCl, slurry weight 14.8 ppg.) W.O.C. 18 hours. If cement does not circulate, run temperature survey and stage cement outside pumped through 1" tubing using Class "C" with 4% CaCl and/or fill up with ready mix concrete - 6 sxs mix with pea gravel aggregate. Install 12" - 3000# W.P. x 10" - 5000# W.P. spool with secondary seal, bit guide, B.O.P.'s, Hydril and choke manifold.
5. On or before 8000' test 8-5/8" casing to 2200 psig and test B.O.P.'s, choke manifold and all wellhead valves to 3000 psig and Hydril to 1500 psig.
6. Install PVT, flow line sensor, and rotating head at 8000'.
7. Drill 7-7/8" hole to estimated T.D. of 11,400' with fresh water. Control seepage with paper and  $P_h$  at 11.0 with lime.
8. At 8000' add potash to 4% KCl concentration, increase viscosity with salt water gel as required to maintain good hole conditions. Decrease water loss as necessary with salt water C.M.C. and starch. At top of Morrow reduce water loss to 10 cc and maintain to T.D.
9. Drill stem test all shows (test each Morrow Sand separately).
10. Run logs (combination CNL-FDC w/Gamma Ray, DLL and Dip Meter).
11. Set and cement 4-1/2" production casing (resin coated and centralized through pay zones) in two stages with D.V. tool at 7000'.  
  
First Stage: 500 sxs Class "H" cement with 3.0# KCl per sx, 1/4# Flocele and 0.8% Halad-22 plus 0.4% CFR-2, slurry weight 15.6 ppg, yield 1.19 cf/sx, plus 500 sxs Class "H" with 3.0# KCl plus 0.8% Halad-22 plus 0.4% CFR-2, slurry weight 15.6 ppg, yield 1.18 cf/sx. Open D.V. tool and circulate 6 hours.  
  
Second Stage: 1400 sxs Class "C" - 50-50 Pozmix with 2% Gel, slurry weight 13.7 ppg, yield 1.36 cf/sx.
12. Install 10" - 5000 psi W.P. x 6" - 5000 psi W.P. tubinghead and Christmas Tree.
13. Run temperature survey to locate cement top.
14. Rig down and move out rotary tools.

Recommended Drilling & Completion Procedure  
A.F.E. No. 463  
David Fasken - Maralo Federal No. 2  
Avalon (Morrow) Field  
Eddy County, New Mexico


15. Set mast anchors and move in pulling unit.
16. Pressure test casing and Christmas Tree to 4500 psig.
17. Run 2-3/8" tubing N-80, EUE 8RD c/w AB modified couplings, and packer.
18. Displace fluid in well with 3% KCl water containing oxygen scavenger and corrosion inhibitor.
19. Set packer and install Christmas Tree.
20. Swab fluid level to 9000' in tubing.
21. Run Gamma Ray correlation log and perforate Morrow for production.
22. Test well.
23. Stimulate as needed - acid and/or frac.
24. Clean up "load fluid" and test.
25. Run C.A.O.F.P. and pressure build up.
26. Install surface equipment.

RECOMMENDED CASING PROGRAM

A.F.E. NO. 463

David Fasken ----- MARALO FEDERAL NO. 2 ----- Avalon (Morrow) Field  
Eddy County, New Mexico

	<u>Footage</u>	<u>Size</u>	<u>Weight</u>	<u>Grade</u>	<u>Thread</u>
Surface Casing	400'	13-3/8"	54.50#/ft.	J-55	ST&C
Intermediate Casing	2,500'	8-5/8"	24#/ft.	J-55	ST&C
	500'	8-5/8"	32#/ft.	J-55	ST&C
	<u>3,000'</u>				
Oil String Casing	2,000'	4-1/2"	11.60#/ft.	N-80	Buttress
	8,300'	4-1/2"	11.60#/ft.	N-80	LT&C
	1,100'	4-1/2"	13.50#/ft.	N-80	LT&C
	<u>11,400'</u>				
Tubing	11,400'	2-3/8"	4.70#/ft.	N-80	EUE8RD AB Modified

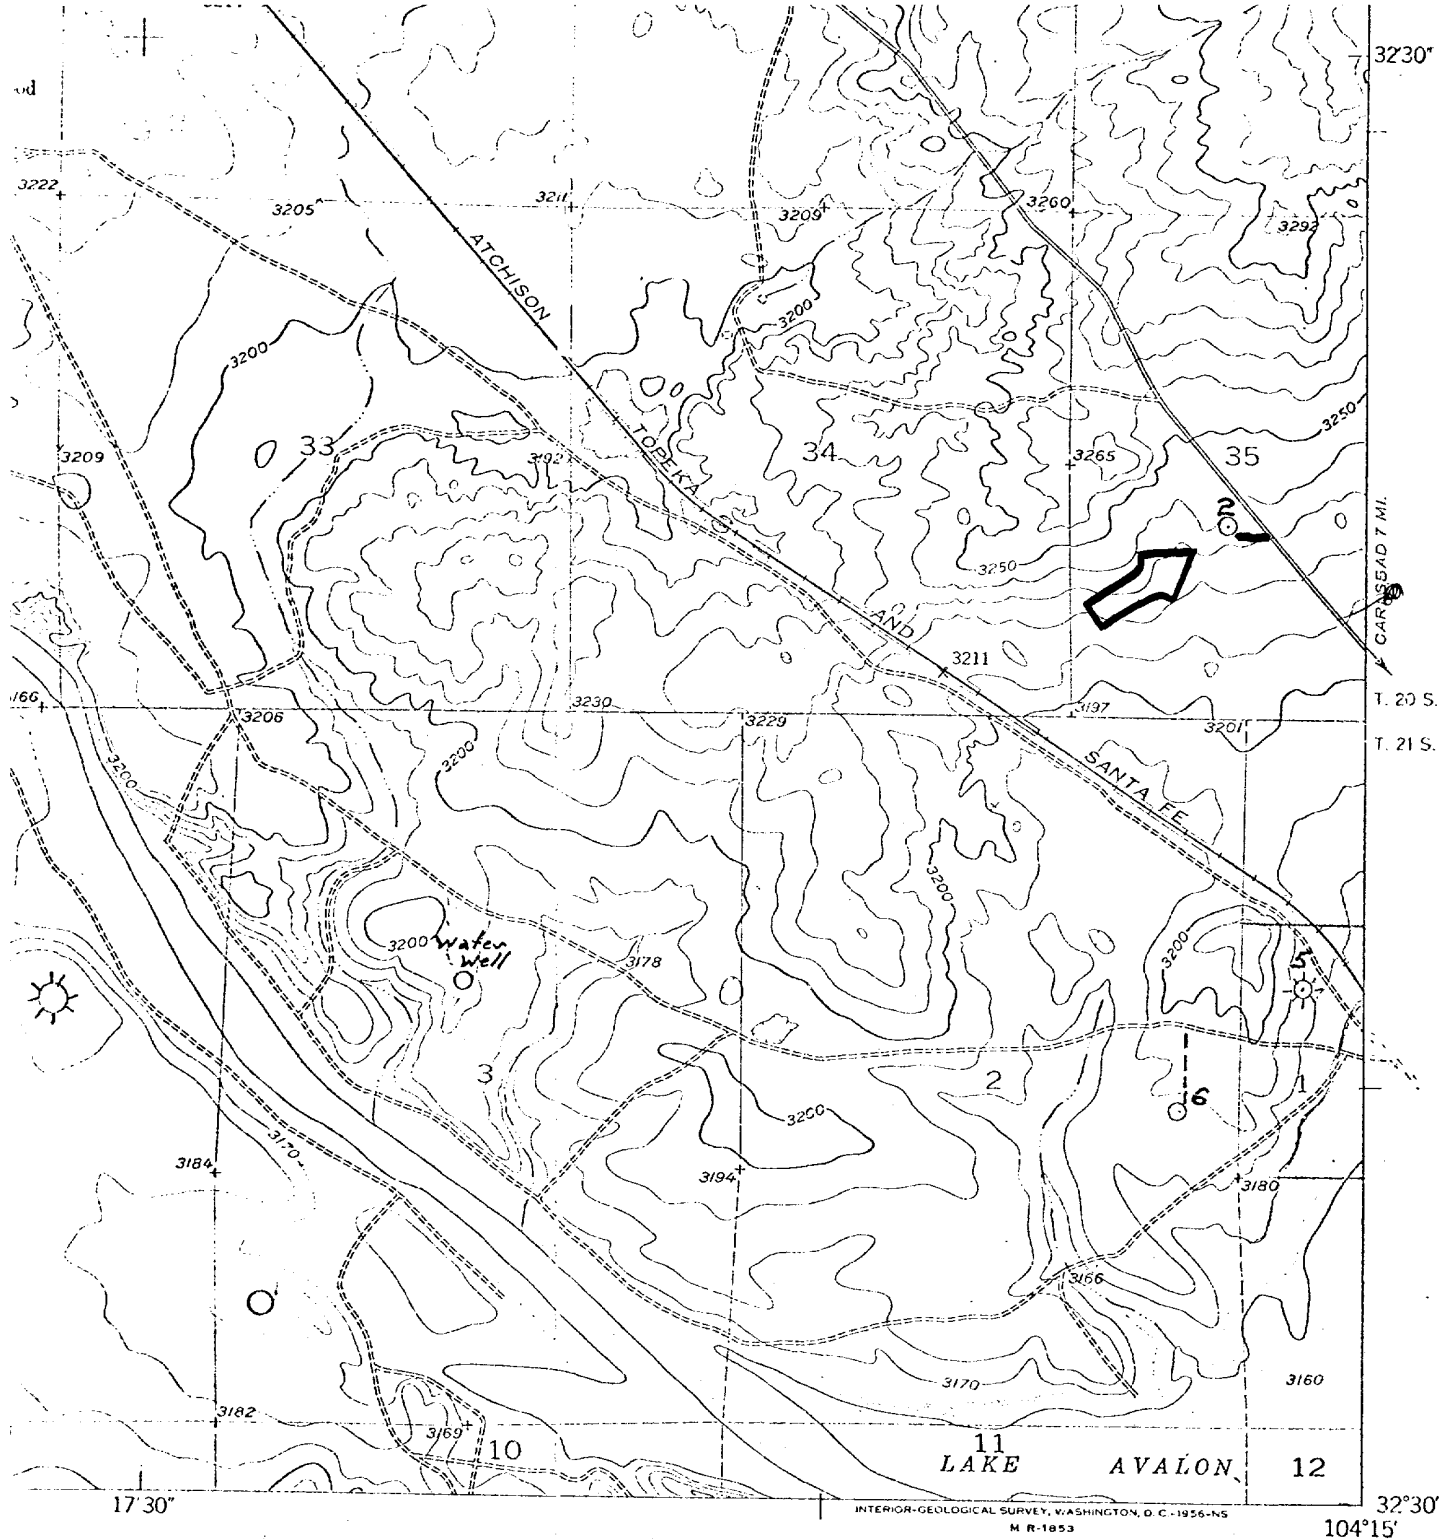

### ROAD CLASSIFICATION

- Heavy-duty Light-duty
- Medium-duty Unimproved dirt
- U. S. Route
- State Route



LAKE MC MILLAN SOUTH, N. MEX.  
N3230-W10415/7.5

1955

25, D.C.

(CARLSBAD)  
1:62,500