

Copy 635

NEW MEXICO OIL CONSERVATION COMMISSION
WELL LOCATION AND ACREAGE DEDICATION PLAT

Form C-102
Supersedes C-128
Effective 1-1-65

All distances must be from the outer boundaries of the Section.

Operator <i>Agent for Perry R. Lane Trust Co.</i> Belco Petroleum Corporation			Lease James Ranch Unit		Well No. 3
Unit Letter J	Section 1	Township 23-S	Range 30-E	County Eddy	
Actual Well Location of Well:					
1980 feet from the South line of		1657.7 feet from the East line of			
Ground Level Elev. 3288'	Producing Formation Morrow	Well Wildcat		Dedicated Acreage: 320 Acres	

1. Outline the acreage dedicated to the subject well by colored pencil or hatchure marks on the plat below.

RECEIVED

2. If more than one lease is dedicated to the well, outline each and identify the ownership thereof (both as to working interest and royalty).

MAY 23 1973


3. If more than one lease of different ownership is dedicated to the well, have the interests of all owners been consolidated by communitization, unitization, forced-pooling, etc?

ARTESIA, OFFICE

☐ Yes ☐ No If answer is "yes," type of consolidation _____

If answer is "no," list the owners and tract descriptions which have actually been consolidated. (Use reverse side of this form if necessary.) _____

No allowable will be assigned to the well until all interests have been consolidated (by communitization, unitization, forced-pooling, or otherwise) or until a non-standard unit, eliminating such interests, has been approved by the Commission.

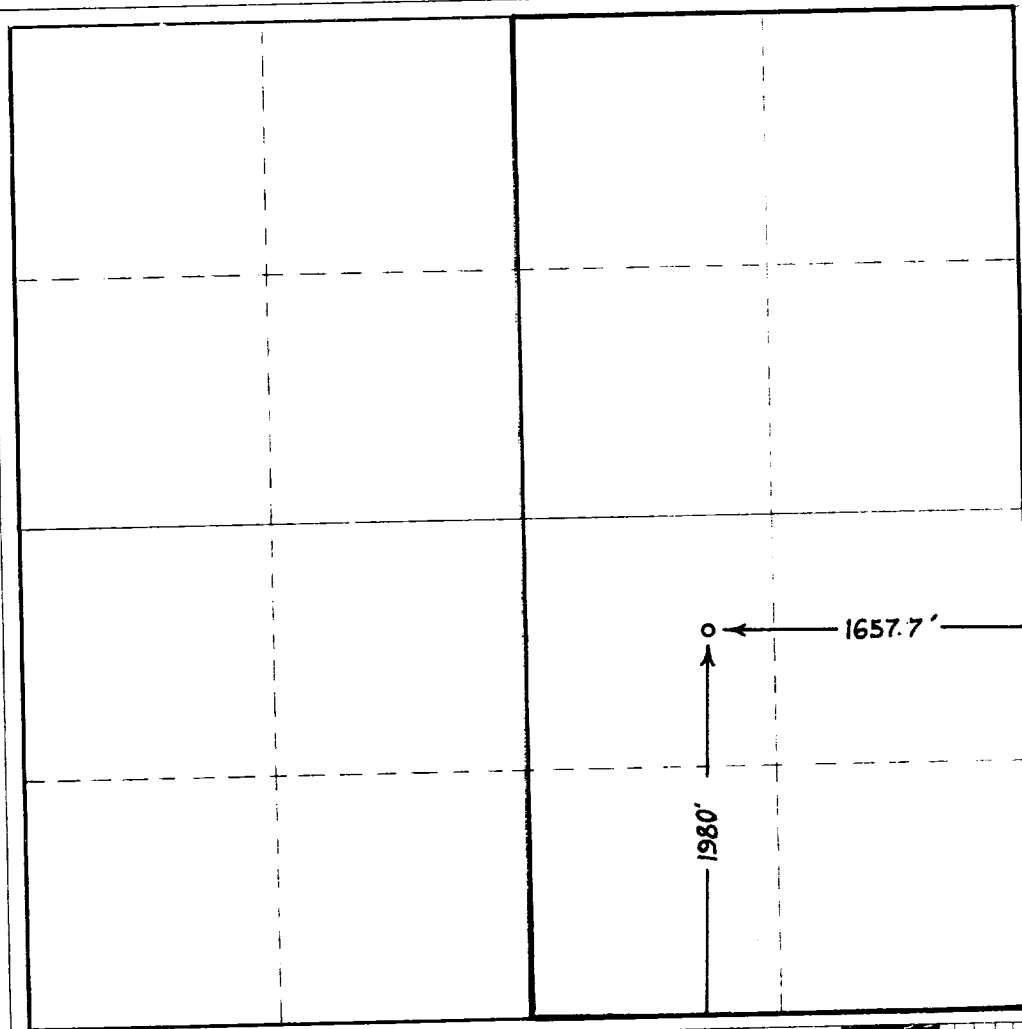

CERTIFICATION

I hereby certify that the information contained herein is true and complete to the best of my knowledge and belief.

Glenn Cope

Glenn Cope
District Engineer

Position

BELCO PETROLEUM CORPORATION

Company

March 21, 1972

Date

I hereby certify that the well location shown on this plat was plotted from field notes of actual surveys made by me or under my supervision, and that the same is true and correct to the best of my knowledge and belief.

Drawn by

Registered Professional Engineer
and/or Licensed Surveyor

Certificate No.

0 330 660 990 1320 1650 1980 2310 2640 2970 3300 3630 3960 4290 4620 4950 5280 5610 5940 6270 6600