

NEW MEXICO OIL CONSERVATION COMMISSION
WELL LOCATION AND ACREAGE DEDICATION PLAT

Form O-102
Supersedes O-128
Effective 1-1-65

All distances must be from the outer boundaries of the Section


| | | | | |
|---|--------------------------------------|---------------------------------------|----------------------------------|-----------------------|
| Operator Amoco Production Company | | Lease Pardue Farms Gas Com. | | Well No. 1 |
| Section G | Section 26 | Township 23 South | Range 28 East | County Eddy |
| Actual Well Location of Well: | | | | |
| 1980 feet from the | North line and | 1980 feet from the | East line | |
| Ground level 3012.4 | Producing Formation Morrow | Pool Und. Morrow | Dedicated Acreage: 320 | Acres |

1. Outline the acreage dedicated to the subject well by colored pencil or hatchure marks on the plat below.
2. If more than one lease is dedicated to the well, outline each and identify the ownership thereof (both as to working interest and royalty).
3. If more than one lease of different ownership is dedicated to the well, have the interests of all owners been consolidated by communitization, unitization, force-pooling, etc?

☐ Yes ☐ No If answer is "yes," type of consolidation _____

If answer is "no," list the owners and tract descriptions which have actually been consolidated. (Use reverse side of this form if necessary.) _____

No allowable will be assigned to the well until all interests have been consolidated (by communitization, unitization, forced-pooling, or otherwise) or until a non-standard unit, eliminating such interests, has been approved by the Commission.

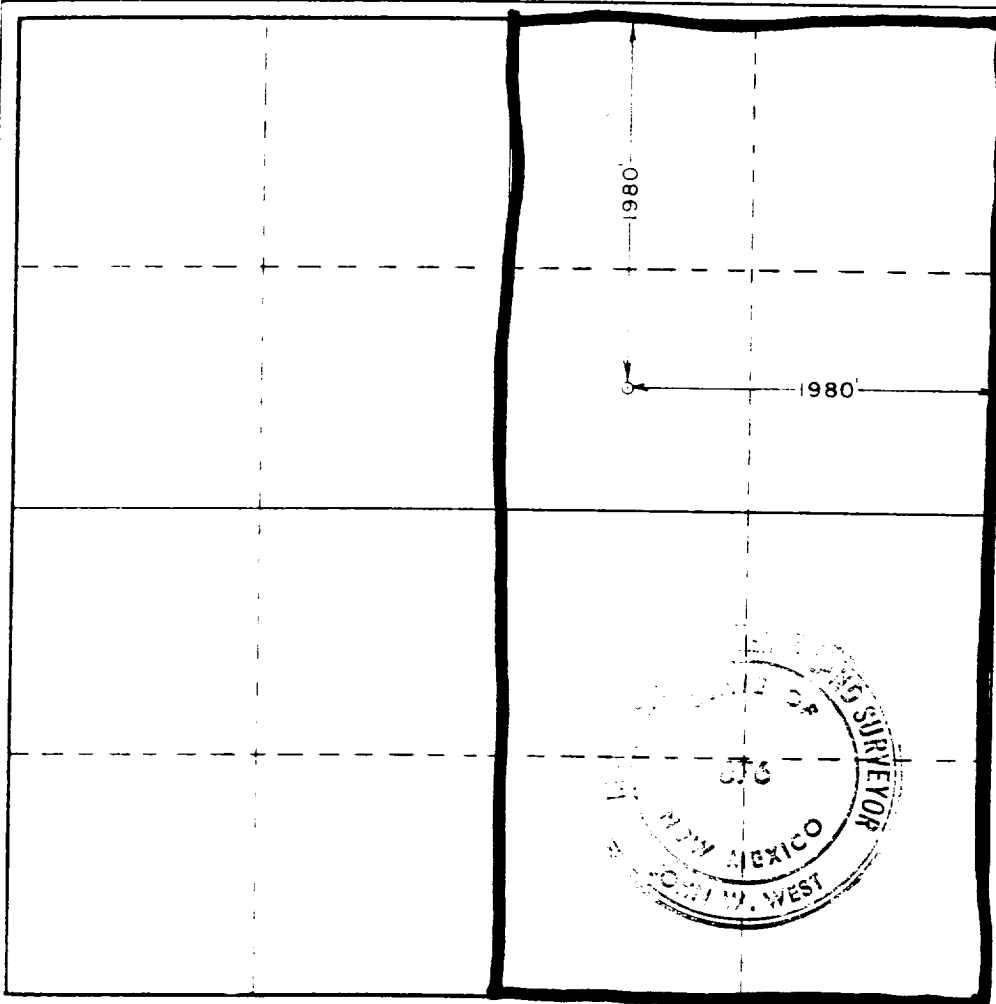

CERTIFICATION

I hereby certify that the information contained herein is true and complete to the best of my knowledge and belief.

Name H. J. Beale
Position Staff Business Analyst
Company Amoco Production
Date 2-3-93

I hereby certify that the well location shown on this plat was plotted from field notes of actual surveys made by me or under my supervision, and that the same is true and correct to the best of my knowledge and belief.

Date Surveyed
Feb. 22, 1978

Registered Professional Engineer
and/or Land Surveyor

John W. West

Certificate No. John W. West **676**
Ronald J. Eidson **3239**

Scale: 1" = 400' 0" 800' 1200' 1600' 2000' 2400' 2800' 3200' 3600' 4000'