

STATE OF NEW MEXICO
ENERGY AND MINERALS DEPARTMENT

OIL CONSERVATION DIVISION
RECEIVED BOX 2088
SANTA FE, NEW MEXICO 87501

APR 4 1980

O. C. D.

30-015-23275
Form C-101
Revised 10-1-78

NO. OF COPIES RECEIVED	
DISTRIBUTION	
SANTA FE	1
FILE	1
U.S.G.S.	1
LAND OFFICE	1
OPERATOR	1

5A. Indicate Type of Lease STATE <input checked="" type="checkbox"/> FEE <input type="checkbox"/>
5. State Oil & Gas Lease No. L - 4381
7. Unit Agreement Name
8. Farm or Lease Name El Paso State
9. Well No. 1
10. Field and Pool or Wildcat Undes. Sulfate Draw-Del.
12. County Eddy

APPLICATION FOR PERMIT TO DRILL, DEEPEN, OR PLUG BACK

1a. Type of Work
DRILL ☒ DEEPEN ☐ PLUG BACK ☐

b. Type of Well
OIL WELL ☒ GAS WELL ☐ OTHER ☐

2. Name of Operator
Ford Chapman & Assoc.

3. Address of Operator
c/o Oil Reports & Gas Services, Inc., Box 763, Hobbs, NM 88240

4. Location of Well
UNIT LETTER A LOCATED 330 FEET FROM THE North LINE
AND 990 FEET FROM THE East LINE OF SEC. 32 TWP. 24S RGE. 27E NMPM

19. Proposed Depth
2400

19A. Formation
Delaware

20. Rotary or C.T.
Cable Tools

21. Elevations (Show whether DF, RT, etc.)
3351.4

21A. Kind & Status Plug. Bond
Blanket

21B. Drilling Contractor
Company Toos

22. Approx. Date Work will start
Upon Approval

23. PROPOSED CASING AND CEMENT PROGRAM

SIZE OF HOLE	SIZE OF CASING	WEIGHT PER FOOT	SETTING DEPTH	SACKS OF CEMENT	EST. TOP
12 1/2	10 3/4	40.5#	200	100	cive.
6 1/4	4 1/2	9.5#	2400	100	1500

Completion to be conventional perforation & treatment.

APPROVAL VALID
FOR 90 DAYS UNLESS
DRILLING COMMENCED,

EXPIRES 7-4-80

IN ABOVE SPACE DESCRIBE PROPOSED PROGRAM; IF PROPOSAL IS TO DEEPEN OR PLUG BACK, GIVE DATA ON PRESENT PRODUCTIVE ZONE AND PROPOSED NEW PRODUCTIVE ZONE. GIVE BLOWOUT PREVENTER PROGRAM, IF ANY.

I hereby certify that the information above is true and complete to the best of my knowledge and belief.

Signed W. A. Gressett Title Agent Date 4/3/80
(This space for State Use)

APPROVED BY W. A. Gressett TITLE SUPERVISOR, DISTRICT DATE APR 4 1980
CONDITIONS OF APPROVAL, IF ANY:

MEXICO OIL CONSERVATION COMMISSION
WELL LOCATION AND ACREAGE DEDICATION PLAT

Form C-102
 Supersedes C-128
 Effective 1-1-65

All distances must be from the outer boundaries of the Section

Operator Ford Chapman & Assoc's			Lease El Paso State "B" state		Well No. 1
Unit Letter A	Section 32	Township 24 South	Range 27 East	County Eddy	
Actual Footage Location of Well: 330 feet from the North line and 990 feet from the East line					
Ground Level Elev. 3351.4	Producing Formation Delaware	Pool Undes. Sulphate Draw		Dedicated Acreage: 40 Acres	

1. Outline the acreage dedicated to the subject well by colored pencil or hatchure marks on the plat below.
2. If more than one lease is dedicated to the well, outline each and identify the ownership thereof (both as to working interest and royalty).
3. If more than one lease of different ownership is dedicated to the well, have the interests of all owners been consolidated by communitization, unitization, force-pooling, etc?

RECEIVED


APR 4 1980

**O. C. D.
 ARTESIA, OFFICE**

☐ Yes ☐ No If answer is "yes," type of consolidation _____

If answer is "no," list the owners and tract descriptions which have actually been consolidated. (Use reverse side of this form if necessary.) _____

No allowable will be assigned to the well until all interests have been consolidated (by communitization, unitization, forced-pooling, or otherwise) or until a non-standard unit, eliminating such interests, has been approved by the Commission.

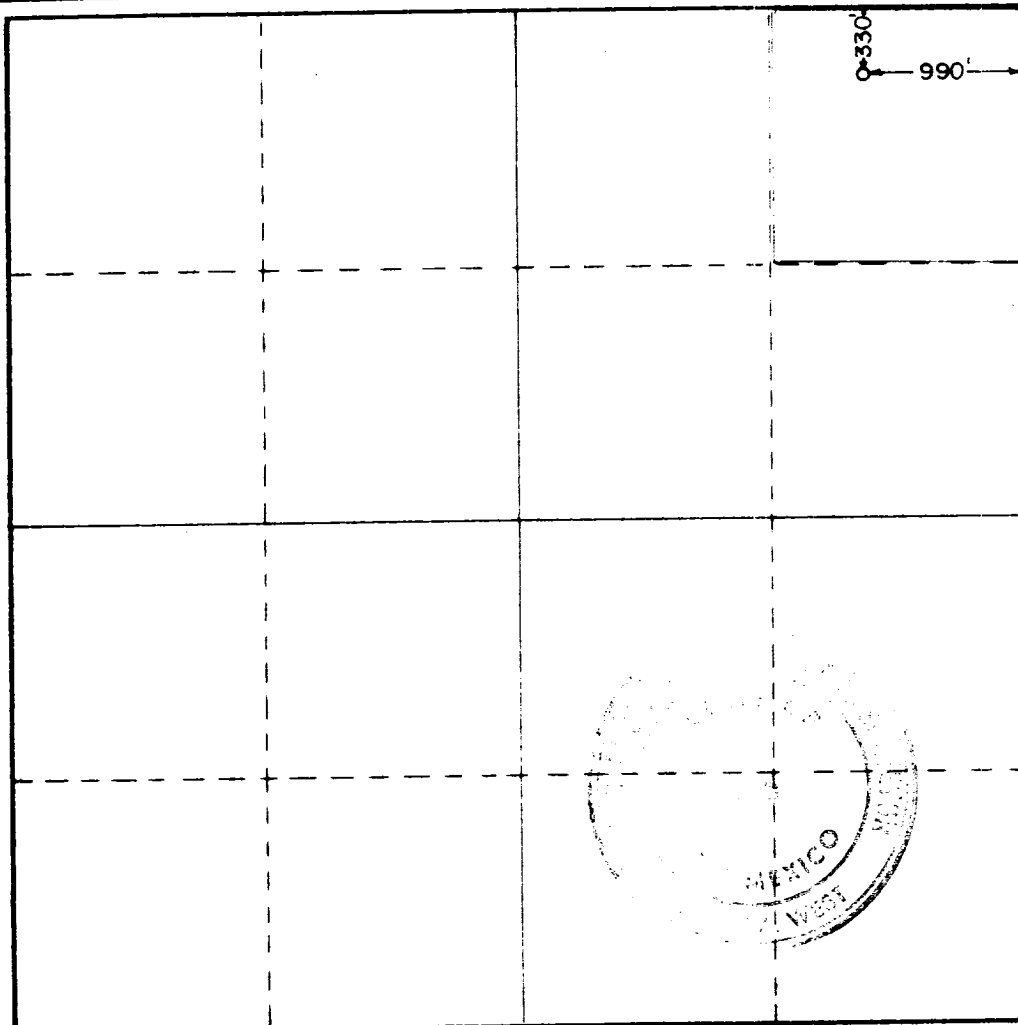

CERTIFICATION

I hereby certify that the information contained herein is true and complete to the best of my knowledge and belief.

Name _____
 Position **Agent**
 Company **Ford Chapman & Assoc.**
 Date **4/3/80**

I hereby certify that the well location shown on this plat was plotted from field notes of actual surveys made by me or under my supervision, and that the same is true and correct to the best of my knowledge and belief.

Date Surveyed **February 25, 1980**
 Registered Professional Engineer and/or Land Surveyor

 Certificate No. **JOHN W. WEST 676**
PATRICK A. ROMERO 6665
Ronald J. Eidson 3239

0 330 660 990 1320 1650 1980 2310 2640 2970 3300 3630 3960 4290 4620 4950 5280 5610 5940 6270 6600