

WELL LOCATION AND ACREAGE DEDICATION PLAT

Superseded by
Effective 1/1/84

All dimensions must be from the outer boundaries of the section.

Santa Fe Energy Company

Unit Letter Section Township

C 27 31

22 south

Weems

Range

27 East

W.M.

100

Actual Plotting Location of well:

990	feet from the	Second Level Elav.	Producing Formation	Depth	Well No.	Location
3108.1					Undesignated S. Carlsbad	320


1. Outline the acreage dedicated to the subject well by colored pencil or hatchure marks on the plat below.

2. If more than one lease is dedicated to the well, outline each and identify the ownership thereof (both as to working interest and royalty).
3. If more than one lease of different ownership is dedicated to the well, have the interests of all owners been consolidated by communitization, unitization, forced-pooling, etc?

Yes No If answer is "yes" type of consolidation Designation of Consolidated Gas Leasehold Estate

If answer is "no," list the owners and tract descriptions which have actually been consolidated. (Use reverse side of this form if necessary.)

No allowable will be assigned to the well until all interests have been consolidated (by communitization, unitization forced-pooling, or otherwise) or until a non-standard unit, eliminating such interests, has been approved by the Commission.

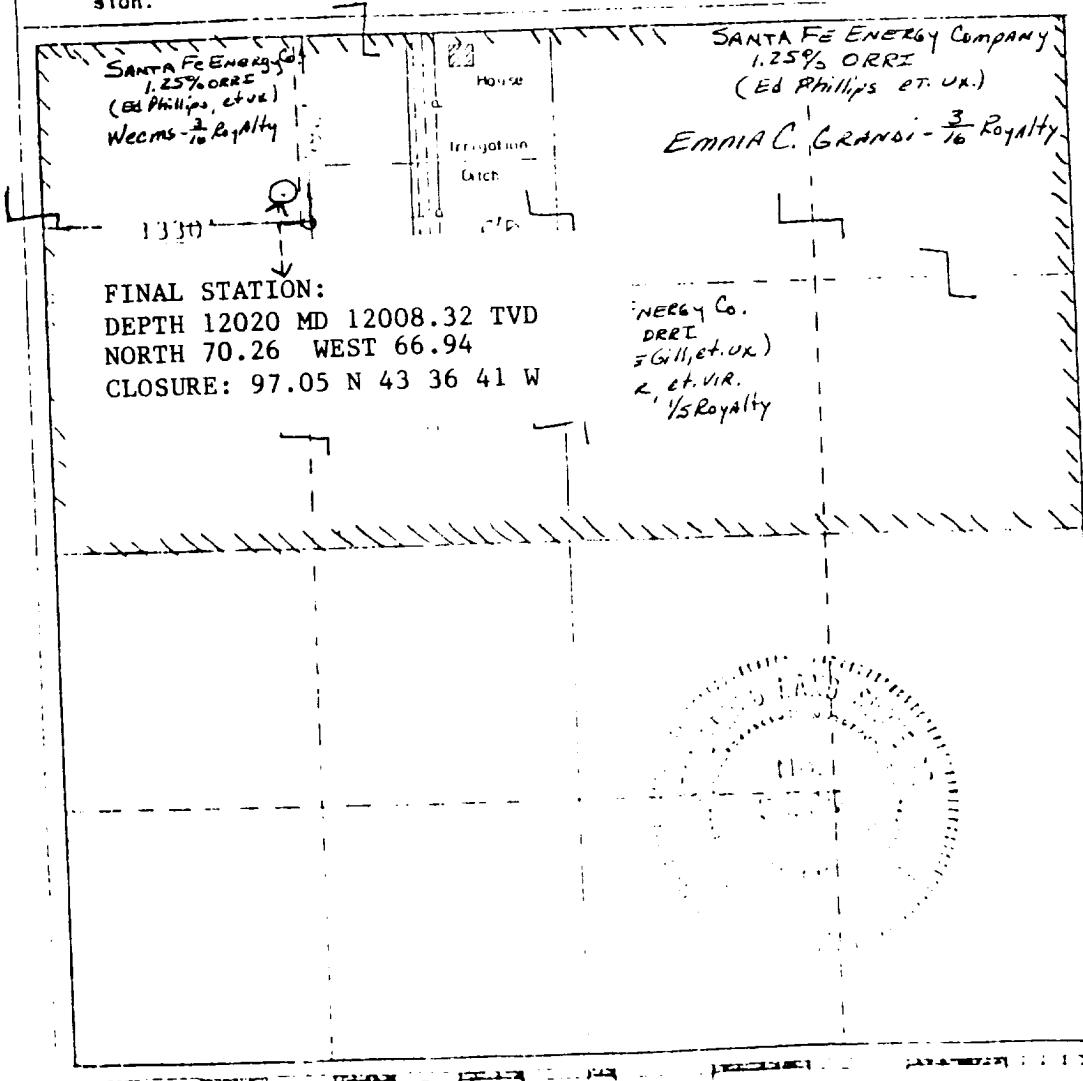

CERTIFICATION

I hereby certify that the information contained herein is true and complete to the best of my knowledge and belief.

Michael R. Ginter

Senior Drilling Engineer

Tested

Santa Fe Energy Company

Typed Name

February 23, 1984

Printed Name

I hereby certify that the well location shown on this plat was plotted from notes of annual surveys made by me under my supervision, and that the same is true and correct to the best of my knowledge and belief.

Tested

February 23, 1984

Plotted and Drawn by

John W. West

Handy's Drawing

Signature

Date