Form 3160-5 (August 1999)


DEPAR' LINT OF THE INTERIOR OCD-ARTES

APPROVED O. 1004-0135 ovember 30, 200

В	UREAU OF LAND MANAGEN	MENT	1				
SUNDRY NOTICES AND REPORTS ON WELLS			5. Lease Serial No. NMLC068545				
Do not use the abandoned we	6. If Indian, Allottee	or Tribe Name					
	PLICATE - Other instruction		If Unit or CA/Agra NMNM71016X	ement, Name and or No			
I. Type of Well — Cas Well — Orl	hor	7.2	E/VED 8. Well Name and No				
Oil Well Gas Well Otl 2. Name of Operator		MI WILBER OCD	ARIESI/ 9. API Well No.				
BASS ENTERPRISES PROD 3a. Address	UCTION CO / E-M	iaii. iiwiibei@bassper.com	30-013-31000-				
P O BOX 2760 MIDLAND, TX 79702		. Phone No. (include area code h: 915.683.2277 c: 915.687.0329	The state of the s	RIDGE			
4. Location of Well (Footage, Sec., 1			11. County or Parish				
Sec 6 T24S R30E SWSE-660	15 1900/E	ut. D	EDDY COUNT	Y, NM			
12. CHECK APPE	ROPRIATE BOX(ES) TO IN	DICATE NATURE OF N	NOTICE, REPORT, OR OTHE	R DATA			
TYPE OF SUBMISSION	TYPE OF ACTION						
Notice of Intent	☐ Acidize	Deepen	Production (Start/Resume)	Water Shut-Off			
	Alter Casing	Fracture Treat	Reclamation	☐ Well Integrity			
☐ Subsequent Report	Casing Repair	New Construction	Recomplete	Other			
☐ Final Abandonment Notice	Change Plans	☐ Plug and Abandon	Temporarily Abandon				
	Convert to Injection	□ Plug Back	☐ Water Disposal				
	bandonment Notices shall be filed of final inspection.) oved from 660' FSL & 1980' F n order to be 120' from Bluebi o' acheological survey. This I	only after all requirements, incluing the section 6, T24S-R30l and high pressure gas line line was installed after the	and stay within APD was				
	ommitted to AFMSS for proces	ES PROD₩CŤION CO, sent ssing by Џinda Askwig on (to the Carlsbad 09/26/2002 (02LA1212SE)				
Name (Printed/Typed) TAMI WIL	BER	Title AUTHO	RIZED REPRESENTATIVE				
Signature (Electronic S		Date 09/25/2					
	THIS SPACE FOR F	FEDERAL OR STATE	OFFICE USE				
	J. Rugwell		LD MANAGER	OQ7Daye			
Conditions of approval, if any, are attache certify that the applicant holds legal or eq which would entitle the applicant to cond-	uitable title to those rights in the sul	t warrant or bject lease Office CAF	RLSBAD FIELD OF	FICE			

Title 18 U.S.C. Section 1001 and Title 43 U.S.C. Section 1212, make it a crime for any person knowingly and willfully to make to any department or agency of the United States any false, fictitious or fraudulent statements or representations as to any matter within its jurisdiction.

2001 09/25/02 13:05 FAX 915 687 CTION 6, TOWNSH 24 SOUTH, RANGE CO LAST, N.M.P.M., NEW MEXICO. ADDY COUNTY,

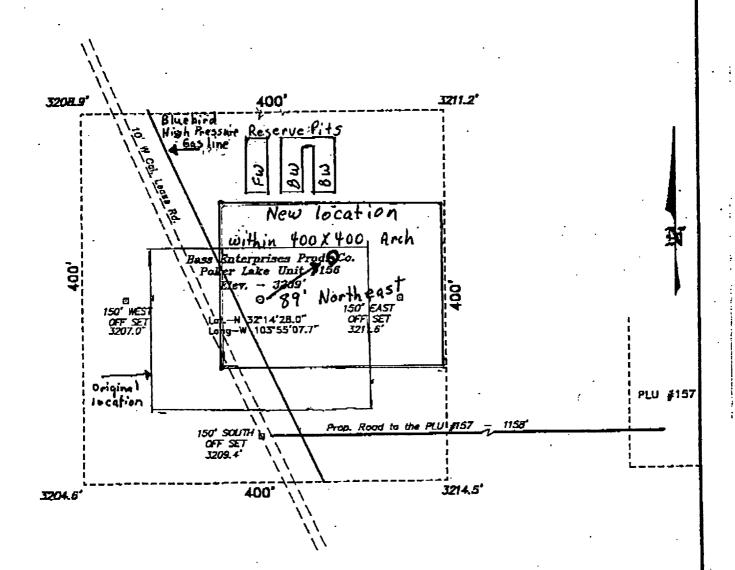

New Location will be: 1900' FEL & 700' FSL Sec 6, T245, R30E

> 200 FEET 100 SCALE: 1" = 100'.

DIRECTIONS TO LOCATIONS

FROM THE JUNCTION OF STATE HWY 128 & CO. RD. 793. GO SOUTH AND WEST ON CO. RD. 793 APPROX. 4.0 MRES TO A LEASE ROAD: THENCE SOUTH ON LEASE ROAD APPROX. 4 MILES TO A POINT ON THE PROPOSED WELL PAD.

PACEN STRYEYS P.O. BOX 1786-HOBBS, NEW MEXICO

The Contract of the Contract o					
W.O. Number: 0449		Drawn	By:	K. GOAD	1
Date: 08-17-2000	Disk: K	JG #122	_	0449A.DWG	Surve

BASS ENTERPRISES PRODUCTION CO.

REF: Poker Lake Unit No. 156 / Well Pad Topo THE POKER LAKE UNIT No. 158 LOCATED 660' FROM THE SOUTH LINE AND 1980' FROM THE EAST LINE OF SECTION 5, TOWNSHIP 24 SOUTH, RANGE 30 EAST, N.M.P.M., EDDY COUNTY, NEW MEXICO. Sheets Sheet αŧ

ey Date: 08-1<u>5-</u>2000