

STATE OF NEW MEXICO
ENERGY AND MINERALS DEPARTMENT

OIL CONSERVATION DIVISION
P. O. BOX 2088
SANTA FE, NEW MEXICO 87501

30-005-60683
Form C-101
Revised 10-1-78

NO. OF COPIES RECEIVED	5
DISTRIBUTION	
SANTA FE	1
FILE	1
U.S.G.S.	2
LAND OFFICE	
OPERATOR	1

RECEIVED
MAR 19 1980

APPLICATION FOR PERMIT TO DRILL, DEEPEN, OR PLUG BACK

a. Type of Work
DRILL ☒ DEEPEN ☐ PLUG BACK ☐

b. Type of Well
OIL WELL ☒ GAS WELL ☐ OTHER ☐
SINGLE ZONE ☒ MULTIPLE ZONE ☐

c. Name of Operator
Phoenix Resources Company

d. Address of Operator
c/o Oil Reports & Gas Services, Inc., Box 763, Hobbs, NM 88240

e. Location of Well
UNIT LETTER A LOCATE 400 FEET FROM THE North LINE
AND 400 FEET FROM THE East LINE OF SEC. 27 TWP. 7S R. 28E

5A. Indicate Type of Lease
STATE ☐ FEE ☒

5. State Oil & Gas Lease No.

7. Unit Agreement Name

8. Farm or Lease Name
J. G. O'Brien

9. Well No.
1

10. Field and Pool, or Wildcat
Wildcat

12. County
Chaves

19. Proposed Depth 3100	19A. Formation San Andres	20. Rotary or C.T. Rotary
21A. Kind & Status Plug. Bond Blanket	21B. Drilling Contractor Baber Well Service	22. Approx. Date Work will start 3/28/80

23. PROPOSED CASING AND CEMENT PROGRAM

SIZE OF HOLE	SIZE OF CASING	WEIGHT PER FOOT	SETTING DEPTH	SACKS OF CEMENT	EST. TOP
11	8 5/8	24#	400	150	Circ
6 3/4	4 1/2	10.5#	3100	250	1300

Completion to be conventional perforation & treatment

Blowout preventor: 10" series 900 Shafer double ram

EXPIRES 6-21-80

IN ABOVE SPACE DESCRIBE PROPOSED PROGRAM; IF PROPOSAL IS TO DEEPEN OR PLUG BACK, GIVE DATA ON PRESENT PRODUCTIVE ZONE AND PROPOSED NEW PRODUCTIVE ZONE. GIVE BLOWOUT PREVENTER PROGRAM, IF ANY.

I hereby certify that the information above is true and complete to the best of my knowledge and belief.

Signed W. A. Gressett Title Agent Date 3/18/80

(This space for State Use)

APPROVED BY W. A. Gressett TITLE SUPERVISOR, DISTRICT II DATE MAR 21 1980

CONDITIONS OF APPROVAL, IF ANY:

WELL LOCATION AND ACREAGE DEDICATION PLAT

Form 1-1977
Superseded Edition
Effective 1-1-80

All distances must be from the outer boundaries of the Section


Phoenix Resources Inc. Company		Lease J.C. O'Brien		#1	
A	27	7 South	28 East	CHAVEZ	
400 feet from the North		400 feet from the East			
Producing Formation	San Andres		Pool	Wildcat	
				40	

1. Outline the acreage dedicated to the subject well by colored pencil or hatchure marks on the plat below.
2. If more than one lease is dedicated to the well, outline each and identify the ownership thereof, both as to working interest and royalty.
3. If more than one lease of different ownership is dedicated to the well, have the interests of the well been consolidated by communitization, unitization, force-pooling, etc?

Yes ☐ No ☐ If answer is "yes," type of consolidation _____

If answer is "no" list the owners and tract descriptions which have actually been consolidated (if so) or state "no" if necessary) _____

No allowable will be assigned to the well until all interests have been consolidated (by communitization, unitization, forced-pooling, or otherwise) or until a non-standard unit, eliminating such interests, has been approved by the Comptroller.

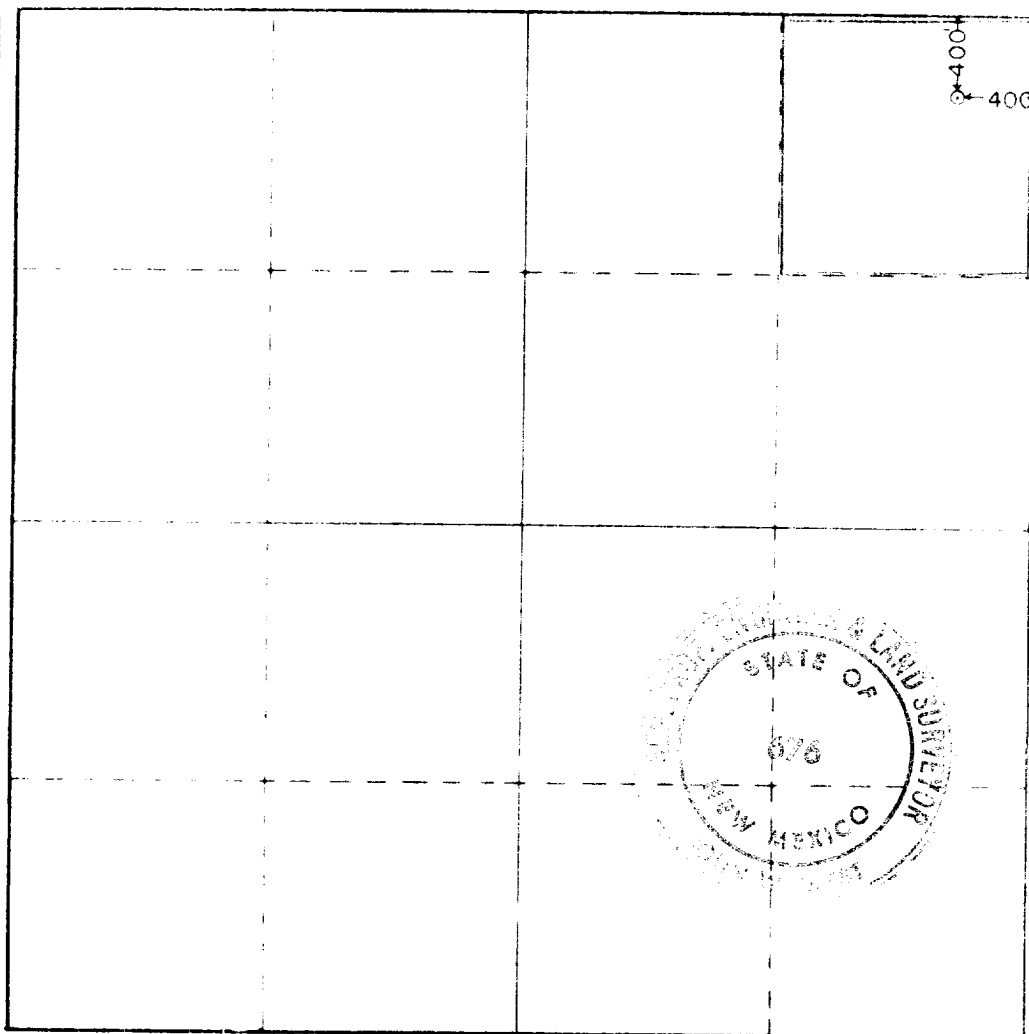

I hereby certify that the information furnished on this plat is true and correct to the best of my knowledge and belief.

Wanda Deller

Agent

Phoenix Resources Company

3/18/80

I hereby certify that the well location shown on this plat was plotted from the notes of actual surveys made by me or under my supervision, and that the same is true and correct to the best of my knowledge and belief.

March 17, 1980

Certification No. JOHN W. WEST 876
PATRICK A. ROMERO 6863
Ronald J. Eidson 3239