

STA NEW MEXICO  
ENERGY & MINERALS DEPARTMENT

OIL CONSERVATION DIVISION  
P. O. BOX 2088  
SANTA FE, NEW MEXICO

AMENDED *See Top*

30-005-60683  
Form C-101  
Revised 10-1-78

| NO. OF COPIES RECEIVED |   |
|------------------------|---|
| DISTRIBUTION           |   |
| SANTA FE               | 1 |
| FILE                   | 1 |
| U.S.G.S.               | 2 |
| LAND OFFICE            |   |
| OPERATOR               | 1 |

MAR 26 1980

5A. Indicate Type of Lease  
STATE ☐ FEE ☒

5. State Oil & Gas Lease No.

APPLICATION FOR PERMIT TO DRILL, DEEPEN, OR PLUG BACK

1a. Type of Work

DRILL ☒

DEEPEN ☐

PLUG BACK ☐

b. Type of Well

OIL WELL ☒

GAS WELL ☐

OTHER

SINGLE ZONE ☒

MULTIPLE ZONE ☐

2. Name of Operator

Phoenix Resources Company

3. Address of Operator

c/o Oil Reports & Gas Services, Inc., Box 763, Hobbs, NM 88240

4. Location of Well

UNIT LETTER A LOCATED 400 FEET FROM THE North LINE

AND 500 FEET FROM THE East LINE OF SEC. 27 TWP. 7S RGE. 28E NMPM

7. Unit Agreement Name

8. Farm or Lease Name

J. G. O'Brien

9. Well No.

1

10. Field and Pool, or Wildcat

Wildcat

12. County

Chaves

19. Proposed Depth

3100

19A. Formation

San Andres

20. Rotary or C.T.

Rotary

21. Elevations (Show whether DF, RT, etc.)

4010.3

21A. Kind & Status Plug. Bond

Blanket

21B. Drilling Contractor

BABer Well Service

22. Approx. Date Work will start

4/12/80

23.

PROPOSED CASING AND CEMENT PROGRAM

| SIZE OF HOLE | SIZE OF CASING | WEIGHT PER FOOT | SETTING DEPTH | SACKS OF CEMENT | EST. TOP |
|--------------|----------------|-----------------|---------------|-----------------|----------|
| 11           | 8 5/8          | 24#             | 400           | 150             | Circ.    |
| 7 7/8        | 4 1/2          | 10.5#           | 3100          | 250             | 2000     |

Completion to be conventional perforation & treatment  
Blowout preventor: 10" series 900 Shafer double ram  
Filed to amend footage location from 400' FNL & 400'  
FEL to 400' FNL & 500' FEL.

APPROVAL VALID  
FOR 90 DAYS UNLESS  
DRILLING COMMENCED

EXPIRES 6-28-80

IN ABOVE SPACE DESCRIBE PROPOSED PROGRAM: IF PROPOSAL IS TO DEEPEN OR PLUG BACK, GIVE DATA ON PRESENT PRODUCTIVE ZONE AND PROPOSED NEW PRODUCTIVE ZONE. GIVE BLOWOUT PREVENTER PROGRAM, IF ANY.

hereby certify that the information above is true and complete to the best of my knowledge and belief.

Signed William R. Noll Title Agent Date 3/25/80

(This space for State Use)

APPROVED BY W. A. Gressett TITLE SUPERVISOR, DISTRICT II DATE MAR 28 1980

CONDITIONS OF APPROVAL, IF ANY:

NEW MEXICO OIL CONSERVATION COMMISSION  
WELL LOCATION AND ACREAGE TEST REPORT

Form  
Supersedes 1-1-78  
1-1-78

All data must be from the date of the survey

Phoenix Resources company

J.C. O'Brien

1

A 27

7 South

28 East

Chaves

400

North

500

East

4010.3

San Andres

Wildcat

40

1. To use the acreage dedicated to the subject well by colored pencil or machine marks on the plat below

RECEIVED

2. If more than one lease is dedicated to the well, outline each and identify the ownership thereof (trusts, etc.) and interest and royalty.

MAR 26 1980

3. If more than one lease of different ownership is dedicated to the well, state the interests of all owners hereon (as stated for commonization, unitization, force-pooling, etc.)


O. C. D.

ARTESIA, OFFICE

Yes No If answer is "yes" type of consolidation

If answer is "no" list the owners and tract descriptions which have a claim to be consolidated (if so reverse side this form if necessary)

No allowable will be assigned to the well until all interests have been consolidated (by commonization, unitization, force-pooling, or otherwise) or until a non-standard unit, encompassing such interests, has been approved by the Commission.

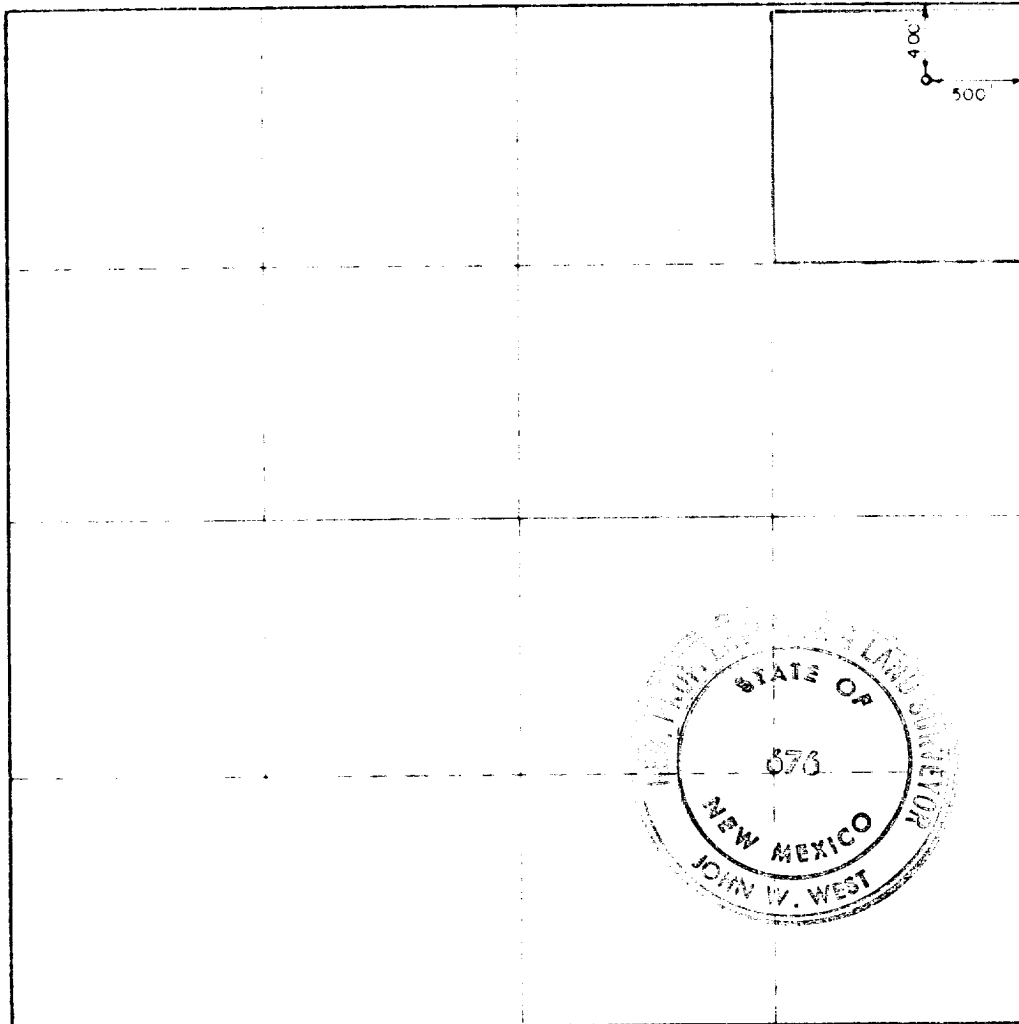

WELL LOCATION

I hereby certify that the information furnished to me hereon is true and complete to the best of my knowledge and belief.

*John W. West*

Agent

Phoenix Resources Company

3/25/80

I hereby certify that the well location shown on this plat is a credit to the record of public surveys made by me or under my supervision and that the same is true to the best of my knowledge and belief.

March 17, 1980

*John W. West*

Certified by JOHN W. WEST 876  
PATRICK A. ROMERO 6668  
Ronald J. Eidson 3239