

138-30-039-06933

60-30-039-06916

DATA SHEET FOR DEEP GROUND BED CATHODIC PROTECTION WELLS
NORTHWESTERN NEW MEXICO
(Submit 3 copies to OCD Aztec Office)

Operator Union Oil Company of California Location: Unit Sec. 25 Twp. 27N Rng. 7W

Name of Well/Wells or Pipeline Serviced Rincon #138 DK Rincon #60 PC

Elevation 6721' Completion Date 8-11-89 Total Depth 295' Land Type* F

Casing, Sizes, Types & Depths None

If Casing is cemented, show amounts & types used None

If Cement or Bentonite Plugs have been placed, show depths & amounts used
None

Depths & thickness of water zones with description of water when possible:
Fresh, Clear, Salty, Sulphur, Etc. 200' Deep - SEE ATTACHED SHEET

Depths gas encountered: NA

Type & amount of coke breeze used: Carbo 60 4040 lbs

Depths anodes placed: 220' to 290'

Depths vent pipes placed: 290'


Vent pipe perforations: 220'

Remarks: Union Oil Company was the operator at the time this ground bed was installed.


Second ground bed installed on this location.

If any of the above data is unavailable, please indicate so. Copies of all logs, including Drillers Log, Water Analyses & Well Bore Schematics should be submitted when available. Unplugged abandoned wells are to be included

*Land Type may be shown: F-Federal; I-Indian; S-State; P-Fee.
If Federal or Indian, add Lease Number.

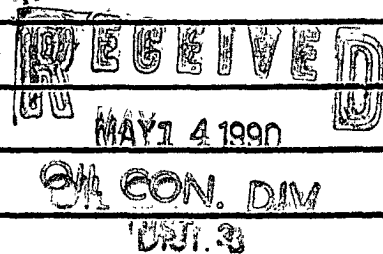

Cathodic Protection Services Company
P. O. Box 388
Farmington, New Mexico 87499
1608 Schofield Lane
Farmington, New Mexico 87401
(505) 325-1946

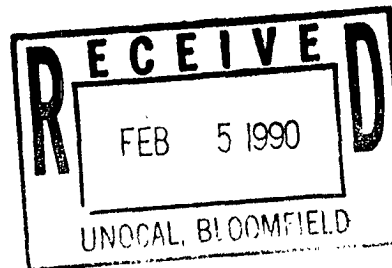

February 2, 1990

Unocal Corporation
3300 N. Butler, Suite 201
Farmington, NM 87401

Attention: Mr. Steve Gregory

Subject: Major Water Zones in Cathodic Protection Deep-Well Groundbeds

Dear Mr. Gregory:

Per your recent request for information concerning the cathodic protection deep-well groundbeds for your well casings in the San Juan Basin area, we are pleased to submit the following information.

Township & Range	Depths Ranging From Shallowest to Deepest	Average Depth	Average Thickness of Water Zone
T-25N - R-10W	110' - 140'	122.5'	20'
T-25N - R-11W	60' - 140'	93.3'	45'
T-26N - R-7W	80' - 150'	112.5'	30'
T-27N - R-7W	80' - 200'	123.3'	22.5'
T-27N - R-6W	80' - 200'	131.1'	30'

This data reflects information supplied by the drilling logs acquired at the time the wells were drilled. The depths shown are based on the type of sand which was being extruded from the drilled hole and the dampness of the sand.

The thickness of the water zones are determined by the change in the strata which was being drilled.

It has been a pleasure providing this information to your company. If you have any further questions or desire additional information, please do not hesitate to contact us.

Sincerely,

Cathodic Protection Services Company


John Kerr, Corrosion Technician

cc: Mike Tabet



JOB No. ¹⁷⁵¹⁻00027 DATE: 8-11-89

BEST NAME TOO

WINDY STRONG 700 10 755
1.3.6

LIDA STRING


V.P. 290
V.P.P. 220'

GROUNDING RESISTANCE: (1) VOLTS 17.34 - AMPS 860 - 1.55 OHMS

(2) VIDEOGROUND _____ OHM

GENERAL CATHODIC PROTECTION SERVICES CO.

4. LUKENS : 20047

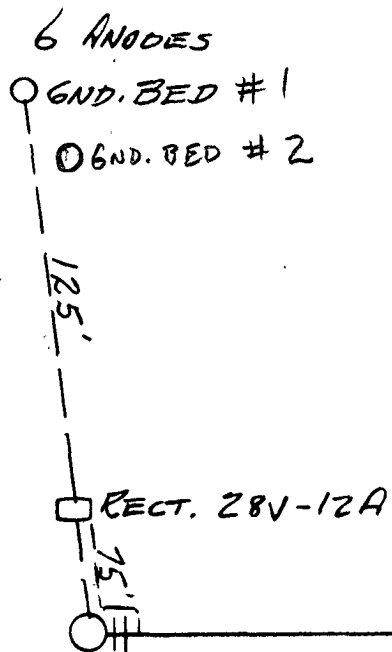

RINCON #138

NOTE: PC WELL #60 DELETED.

NE 25-27-7

CATHODIC PROTECTION		
EL PASO NATURAL GAS COMPANY		
RINCON #138 CPS-717W		
SCALE <i>NONE</i>	DATE <i>5-25-65</i>	No. <i>34</i>
DRAWN BY <i>SEA</i>	CHECKED BY	