

97-30-039-60094

157-30-039-07026

DATA SHEET FOR DEEP GROUND BED CATHODIC PROTECTION WELLS
NORTHWESTERN NEW MEXICO
(Submit 3 copies to OCD Aztec Office)

Operator Union Oil Company of California Location: Unit Sec. 18 Twp 27N Rng 6WName of Well/Wells or Pipeline Serviced Rincon Unit 97 MV & Rincon Unit 157 DK
Rincon Unit 239 FCElevation 6662' Completion Date 12/11/89 Total Depth 425' Land Type* FCasing, Sizes, Types & Depths NoneIf Casing is cemented, show amounts & types used NoneIf Cement or Bentonite Plugs have been placed, show depths & amounts used
None

Depths & thickness of water zones with description of water when possible:

Fresh, Clear, Salty, Sulphur, Etc. 120' deep ? thickDepths gas encountered: NAType & amount of coke breeze used: Carbo 50 2500 lbsDepths anodes placed: 240Depths vent pipes placed: 240'Vent pipe perforations: 150'Remarks: Unocal operator of well when this ground bed was installed. Second
ground bed installed at this location.

If any of the above data is unavailable, please indicate so. Copies of all logs, including Drillers Log, Water Analyses & Well Bore Schematics should be submitted when available. Unplugged abandoned wells are to be included.

*Land Type may be shown: F-Federal; I-Indian; S-State; P-Fee.
If Federal or Indian, add Lease Number.

RECEIVED

MAY 03 1990

OIL CON. DIV.

DIST. 3

COMPANY UNOCAL JOB NO. 00027 DATE: 11-2-89
 WELL: Pincon # 239 PIPELINE: Pincon
 LOCATION: SEC. 18 TWP. 27 RGE. 6 CO. Santa Cruz STATE N.M.
 ELEV. _____ FT: ROTARY 300 FT: CABLE TOOL 0 FT: CASING 0 FT:
 GROUNDED: DEPTH 300 FT. DIA. 6 IN. GAS 3000 LBS. ANODES LIDA string


DEPTH, FT.	DRILLER'S LOG	EXPLORING ANODE TO STRUCTURE			NO COKE	WITH COKE	ANODE NO.	DEPTH, TOP OF ANODES
		E	I	R				
	<u>First Water #120</u>							
	<u>0-200 sand</u>							
<u>200</u>			<u>3.2</u>					
<u>5</u>	<u>Top of LIDA Anodes</u>		<u>3.4</u>			<u>3.7</u>	<u>5.8</u>	<u>205</u>
<u>10</u>			<u>3.6</u>					
<u>5</u>			<u>3.6</u>					
<u>20</u>			<u>3.5</u>					
<u>5</u>			<u>3.2</u>					
<u>30</u>			<u>3.9</u>					
<u>5</u>			<u>3.0</u>					
<u>40</u>			<u>3.2</u>					<u>240</u>
<u>5</u>			<u>2.9</u>					
<u>50</u>			<u>2.7</u>					
<u>5</u>			<u>1.9</u>					
<u>60</u>			<u>1.0</u>					
<u>5</u>			<u>0.9</u>					
<u>70</u>			<u>0.9</u>					
<u>5</u>			<u>1.0</u>					
<u>80</u>			<u>1.3</u>					
<u>5</u>			<u>1.6</u>					
<u>90</u>			<u>1.4</u>					
<u>5</u>			<u>1.0</u>					
<u>300</u>	<u>T.D. 300</u>							

GROUNDED RESISTANCE: (1) VOLTS 11.4 - AMPS 5.8 - 1.96 OHMS

(2) VIBROGROUND _____ OHMS

GENERAL CATHODIC PROTECTION SERVICES CO.

A LUKENS COMPANY

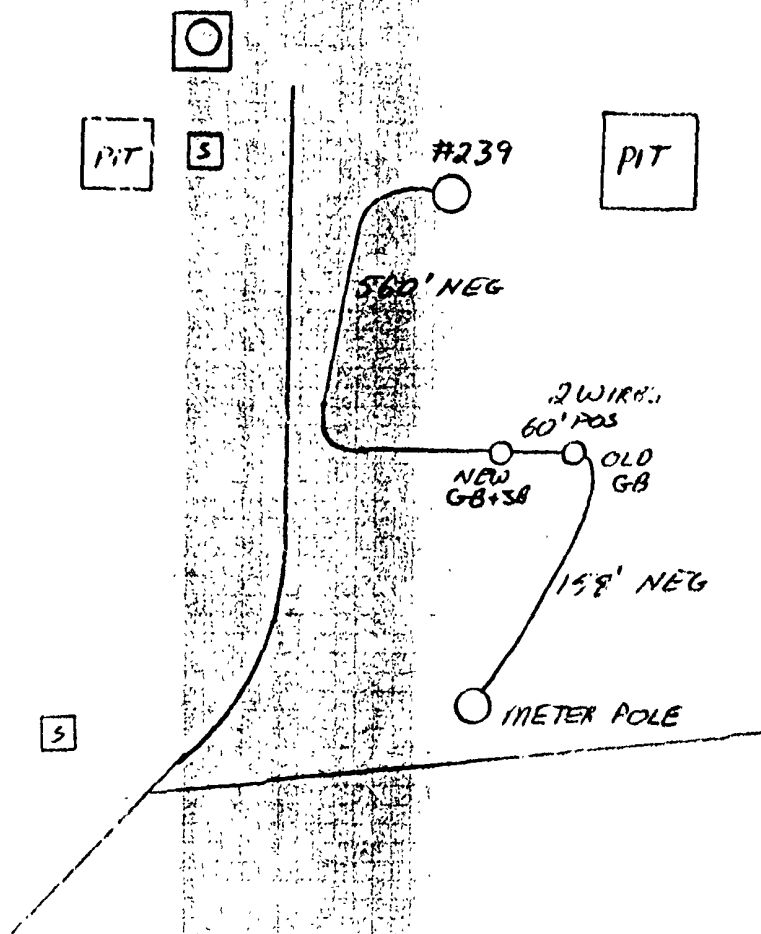

CPS

684

Cathodic Protection Services

A **LUKENS** COMPANY

RINCON UNIT #239
" " #97

DES **CF**
DR **JK**
SCALE **NONE**

CK
APP
DATE **12-11-89**

DWG NO
00027 - 17

REV.

NO

REV'SION

DATE