

RECEIVED

UNITED STATES
DEPARTMENT OF THE INTERIOR
BUREAU OF LAND MANAGEMENT

JUN 07 2010

Bureau of Land Management
Hatch, NM 88401

Sundry Notices and Reports on Wells

1. Type of Well
GAS
2. Name of Operator
BURLINGTON
RESOURCES OIL & GAS COMPANY LP
3. Address & Phone No. of Operator
PO Box 4289, Farmington, NM 87499 (505) 326-9700
4. Location of Well, Footage, Sec., T, R, M
Surface: Unit J (NWSE), 1830' FSL & 1560' FEL, Section 10, T25N, R6W, NMPM
5. Lease Number
SF-078885
6. If Indian, All. or
Tribe Name
7. Unit Agreement Name
8. Well Name & Number
Canyon Largo Unit 292F
9. API Well No.
30-039-30952
10. Field and Pool
Basin Dakota
11. County and State
Rio Arriba, NM

12. CHECK APPROPRIATE BOX TO INDICATE NATURE OF NOTICE, REPORT, OTHER DATA

Type of Submission	Type of Action		
☒ Notice of Intent	☐ Abandonment	☐ Change of Plans	☒ Other - ☐ Change Plans
☐ Subsequent Report	☐ Recompletion	☐ New Construction	RCVD AUG 24 '10 OIL CONS. DIV. DIST. 3
☐ Final Abandonment	☐ Plugging	☐ Non-Routine Fracturing	
	☐ Casing Repair	☐ Water Shut off	
	☐ Altering Casing	☐ Conversion to Injection	

13. Describe Proposed or Completed Operations

Burlington Resources wishes to move the subject well from the APD approved footages of Unit J (NWSE), 1725' FSL, 1535' FEL to Unit J (NWSE), ~~1860'~~ FSL, ~~1495'~~ FEL. The new plat, pad diagram, cut & fill and project proposal are attached.

1830' 1560'

14. I hereby certify that the foregoing is true and correct.

Signed *Dollie L. Busse* Dollie L. Busse Title Staff Regulatory Technician Date June 3, 2010

(This space for Federal or State Office use)

APPROVED BY Troy L. Salyers Title Petroleum Engineer Date 8/18/2010

CONDITION OF APPROVAL, if any:

Title 18 U.S.C. Section 1001, makes it a crime for any person knowingly and willfully to make any department or agency of the United States any false, fictitious or fraudulent statements or representations as to any matter within its jurisdiction

NMOC

DISTRICT II
1301 West Grand Avenue, Artesia, N.M. 88210

OIL CONSERVATION DIVISION

1220 South St. Francis Dr.
Santa Fe, NM 87505

Submit to Appropriate District Office
State Lease - 4 Copies
Fee Lease - 3 Copies

DISTRICT III
1000 Rio Brazos Rd., Aztec, N.M. 87410

DISTRICT IV
1220 S. St. Francis Dr., Santa Fe, NM 87505

☒ AMENDED REPORT

WELL LOCATION AND ACREAGE DEDICATION PLAT

¹ API Number 30-039 - 30952	² Pool Code 71599	³ Pool Name BASIN DAKOTA
⁴ Property Code 7462	⁵ Property Name CANYON LARGO UNIT	⁶ Well Number 292F
⁷ GRID No. 14538	⁸ Operator Name BURLINGTON RESOURCES OIL & GAS COMPANY LP	⁹ Elevation 6712'

¹⁰ Surface Location


UL or lot no.	Section	Township	Range	Lot Idn	Feet from the	North/South line	Feet from the	East/West line	County
J	10	25-N	6-W		1830	SOUTH	1560	EAST	RIO ARRIBA

¹¹ Bottom Hole Location If Different From Surface

UL or lot no.	Section	Township	Range	Lot Idn	Feet from the	North/South line	Feet from the	East/West line	County
¹³ Dedicated Acres DK 320.00 ACRES E/2			¹² Joint or Infill		¹⁴ Consolidation Code		¹⁵ Order No.		

NO ALLOWABLE WILL BE ASSIGNED TO THIS COMPLETION UNTIL ALL INTERESTS HAVE BEEN CONSOLIDATED
OR A NON-STANDARD UNIT HAS BEEN APPROVED BY THE DIVISION

18

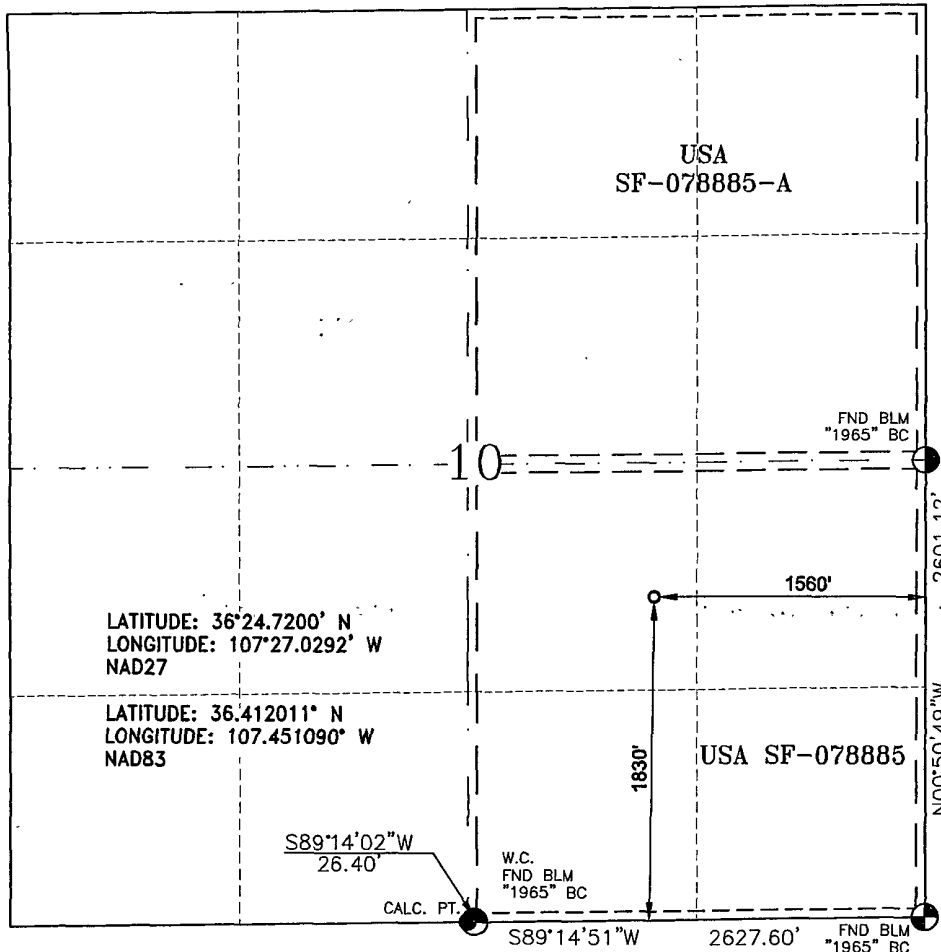

17 OPERATOR CERTIFICATION

I hereby certify that the information contained herein is true and complete to the best of my knowledge and belief, and that this organization either owns a working interest or unless mineral interest in the land including the proposed bottom hole location or has a right to drill this well at this location pursuant to an agreement with an owner, such a mineral or working interest, or a voluntary pooling agreement or a compulsory pooling order heretofore entered by the division.

Signature

Dollie L. Busse

Printed Name _____


18 SURVEYOR CERTIFICATION

I hereby certify that the well location shown on this plat was plotted from field notes of actual surveys made by me or under my supervision, and that the same is true and correct to the best of my belief.

JUNE 1, 2010

Date of Survey

Signature and Seal of _____

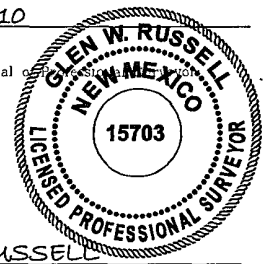


GLEN W. RUSSELL

Certificate Number

15703


BURLINGTON RESOURCES OIL & GAS COMPANY LP

CANYON LARGO UNIT #292F, 1830' FSL & 1560' FEL
SECTION 10, T-25-N, R-6-W, NMPM, RIO ARriba COUNTY, NM
GROUND ELEVATION: 6712', DATE: MAY 13, 2010

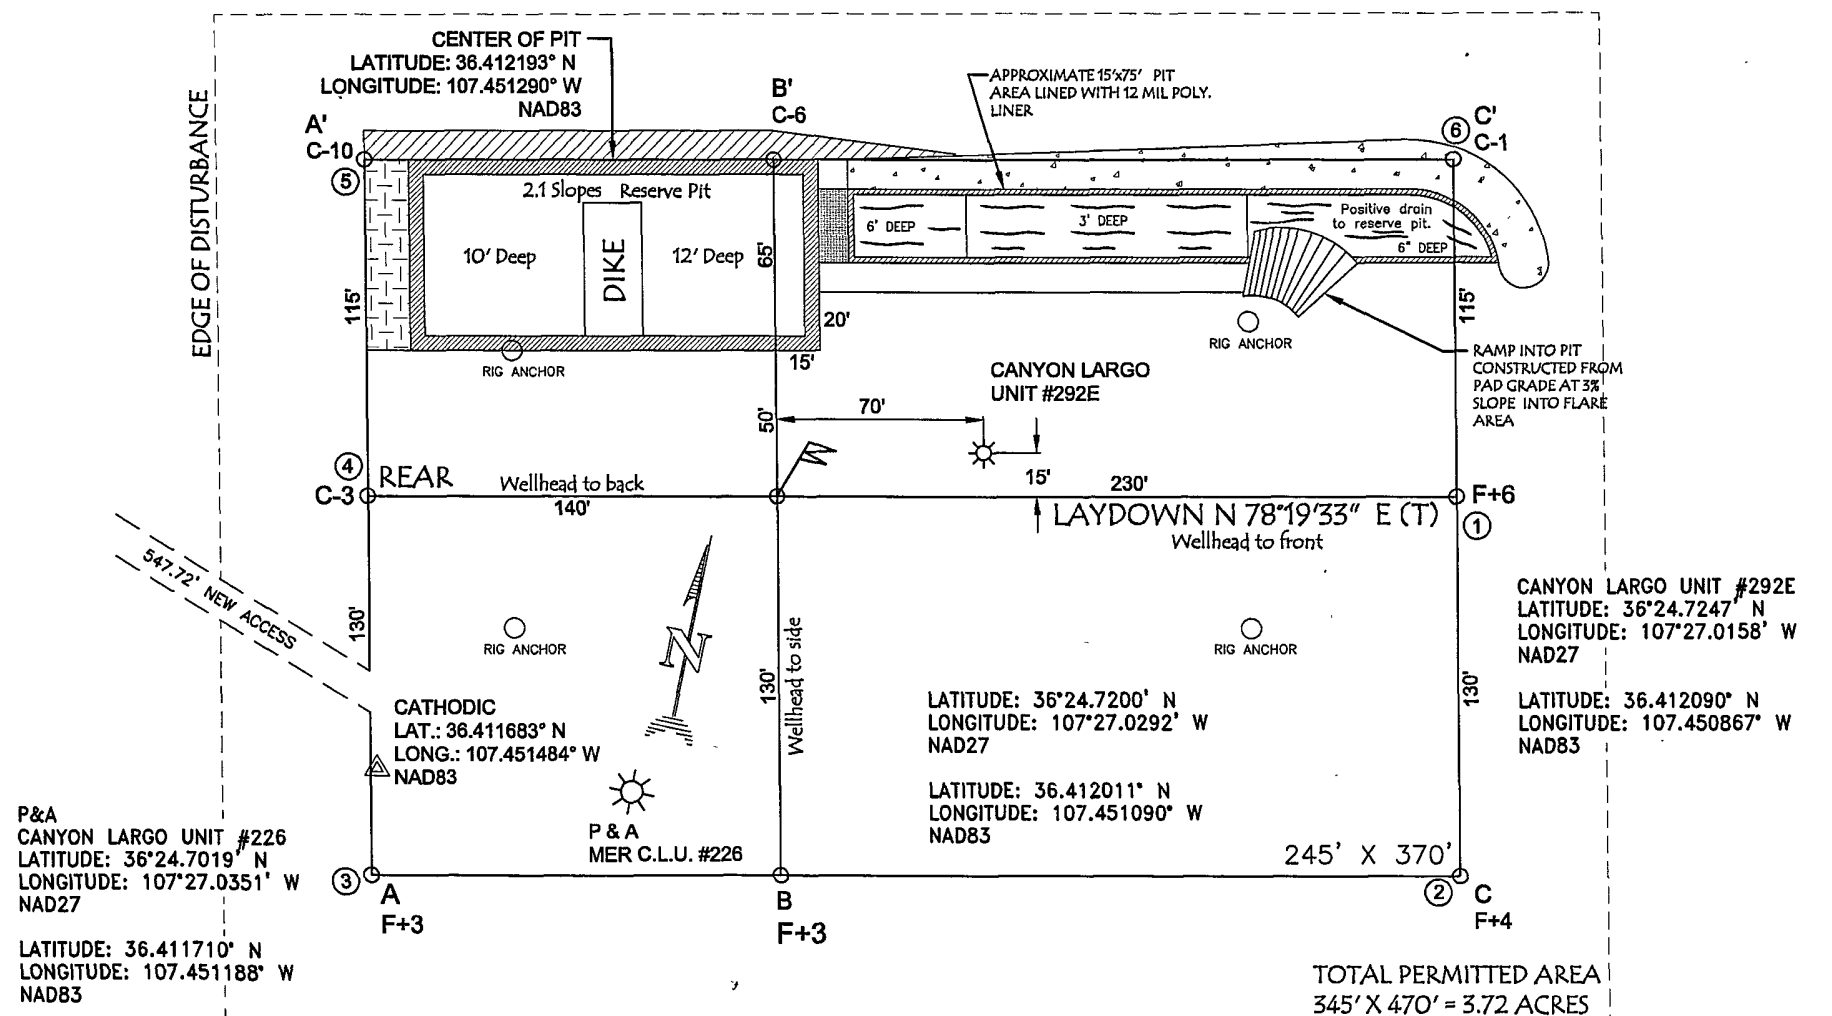


NOTES:

- VECTOR SURVEYS IS NOT LIABLE FOR UNDERGROUND UTILITIES OR PIPELINES. CONTRACTOR SHOULD CALL ONE-CALL FOR LOCATION OF ANY MARKED OR UNMARKED BURIED PIPELINES OR CABLES ON WELL PAD AND OR ACCESS ROAD AT LEAST TWO (2) WORKING DAYS PRIOR TO CONSTRUCTION.
- RESERVE PIT DIKE: TO BE 8' ABOVE DEEP SIDE (OVERFLOW - 3' WIDE AND 1' ABOVE SHALLOW SIDE).

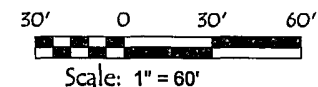

BURLINGTON RESOURCES OIL & GAS COMPANY LP
 CANYON LARGO UNIT #292F, 1830' FSL & 1560' FEL
 SECTION 10, T-25-N, R-6-W, NMPM, RIO ARriba COUNTY, NM
 GROUND ELEVATION: 6712', DATE: MAY 13, 2010

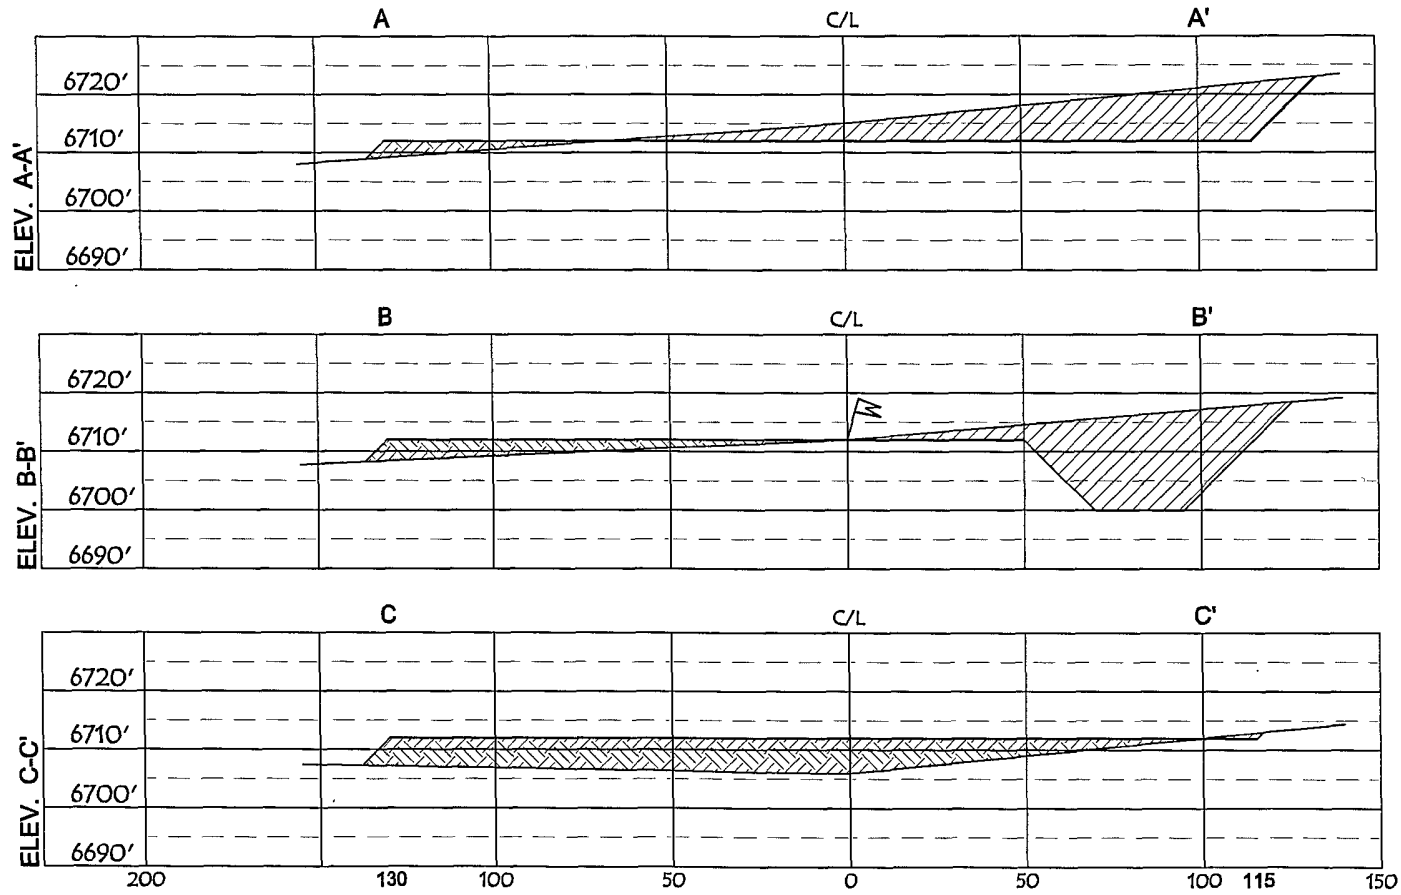

HORIZ. SCALE: 1" = 50'
 VERT. SCALE: 1" = 30'

NOTE:

VECTOR SURVEYS IS NOT LIABLE FOR UNDERGROUND UTILITIES OR PIPELINES. CONTRACTOR SHOULD CALL ONE-CALL FOR LOCATION OF ANY MARKED OR UNMARKED BURIED PIPELINES OR CABLES ON WELL PAD AND OR ACCESS ROAD AT LEAST TWO (2) WORKING DAYS PRIOR TO CONSTRUCTION.

PROJECT PROPOSAL - New Drill / Sidetrack

San Juan Business Unit

CANYON LARGO UNIT 292F

DEVELOPMENT

Lease:		AFE #: WAN.CDR.9052				AFE \$: 1,189,576.96	
Field Name: SAN JUAN		Rig: XXX 2011 Holding Rig #1		State: NM	County: RIO ARRIBA		API #: 3003930952
Geologist:		Phone:		Geophysicist:		Phone:	
Geoscientist:		Phone:		Prod. Engineer:		Phone:	
Res. Engineer:		Phone:		Proj. Field Lead:		Phone:	
Primary Objective (Zones):							
Zone	Zone Name						
FRR	BASIN DAKOTA (PRORATED GAS)						
Location: Surface Datum Code: NAD 27 Straight Hole							
Latitude: 36.412000		Longitude: -107.450486		X:	Y:	Section: 10	Range: 006W
Footage X: 1560 FEL		Footage Y: 1830 FSL		Elevation: 6712 (FT)	Township: 025N		
Tolerance:							
Location Type: Year Round		Start Date (Est.): 1/1/2011		Completion Date:		Date In Operation:	
Formation Data: Assume KB = 6728 Units = FT							
Formation Call & Casing Points	Depth (TVD in Ft)	SS (Ft)	Depletion (Yes/No)	BHP (PSIG)	BHT	Remarks	
Surface Casing	325	6403	☐			320' 8 5/8" 24 ppf, J-55, STC/LTC casing. Cement with 226 cuft. Circulate cement to surface.	
NACIMIENTO	1050	5678	☐				
OJO ALAMO	2136	4592	☐				
KIRTLAND	2309	4419	☐				
FRUITLAND	2418	4310	☐			Possible Gas	
PICTURED CLIFFS	2790	3938	☐				
LEWIS	2858	3870	☐				
HUERFANITO BENTONITE	3176	3552	☐				
CHACRA	3638	3090	☐				
UPPER CLIFF HOUSE	4233	2495	☐				
MASSIVE CLIFF HOUSE	4395	2333	☐	735			
MENEFEE	4434	2294	☐				
POINT LOOKOUT	5000	1728	☐			GAS	
MANCOS	5314	1414	☐				
UPPER GALLUP	6031	697	☐				
GREENHORN	6925	-197	☐				
GRANEROS	6975	-247	☐				
TWO WELLS	7032	-304	☐	3035		Gas; Est. Top Perf - 7029 (-306)	
PAGUATE	7073	-345	☐				
UPPER CUBERO	7116	-388	☐				
LOWER CUBERO	7148	-420	☐				
OAK CANYON	7175	-447	☐			Will need to either run shorter mud shoe or set extra casing to avoid drilling Burro Canyon with only surface casing set - offset wells barely perf'd into Encinal or stayed above.	
ENCINAL	7222	-494	☐			Est. Btm Perf - 7237 (-514) based on offset wells	
BURRO CANYON	7256	-528	☐			TD - 80' below T/ENCN to allow for mud shoe	
Total Depth	7302	-574	☐			7 7/8" hole, 4-1/2" 11.6 ppf, L-80/N-80 STC/LTC casing. Cement with 2147 cuft. Circulate cement to surface.	

PROJECT PROPOSAL - New Drill / Sidetrack

San Juan Business Unit

CANYON LARGO UNIT 292F

DEVELOPMENT

MORRISON	7328	-600	☐
Reference Wells:			
Reference Type	Well Name	Comments	
Production	Canyon Largo 163	25N 6W 10 NE SW NE	
Production	Canyon Largo 465E	25N 6W 10 SW NE SW	
Production	Canyon Largo 292	25N 6W 10 NW SE NE	
Production	Canyon Largo 203	25N 6W 10 SW NE SW	

Logging Program:			
Intermediate Logs:	☐ Log only if show	☐ GR/ILD	☐ Triple Combo

TD Logs:	☐ Triple Combo	☐ Dipmeter	☐ RFT	☐ Sonic	☐ VSP	☐ TDT	☒ Other
Cased Hole GR / CBL							
Mudlog from 100' above top of GRHN to TD - mudlogger will call TD.							
Mudlog to determine if gas show warrants completion in Encinal.							

Additional Information:					
Log Type	Stage	From (Ft)	To (Ft)	Tool Type/Name	Remarks