



All distances must be from the outer boundaries of the Section


Operator WOOSLEY OIL COMPANY		Lease State Lease LG-6571		Well No.
				State #4
Unit Letter J	Section 16	Township 19 NORTH	Range 6 WEST	County McKINLEY
Actual Footage Location of Well:				
1980 feet from the SOUTH line and		1650 feet from the EAST line		
Ground Level Elev. 6885	Producing Formation Mesa Verde	Pool Star Mesa Verde Ext.	Dedicated Acreage: 40 Acres	

1. Outline the acreage dedicated to the subject well by colored pencil or hatchure marks on the plat below.
2. If more than one lease is dedicated to the well, outline each and identify the ownership thereof (both as to working interest and royalty).
3. If more than one lease of different ownership is dedicated to the well, have the interests of all owners been consolidated by communitization, unitization, force-pooling, etc?

☐ Yes ☐ No If answer is "yes," type of consolidation \_\_\_\_\_

If answer is "no," list the owners and tract descriptions which have actually been consolidated. (Use reverse side of this form if necessary.) \_\_\_\_\_

No allowable will be assigned to the well until all interests have been consolidated (by communitization, unitization, forced-pooling, or otherwise) or until a non-standard unit, eliminating such interests, has been approved by the Division

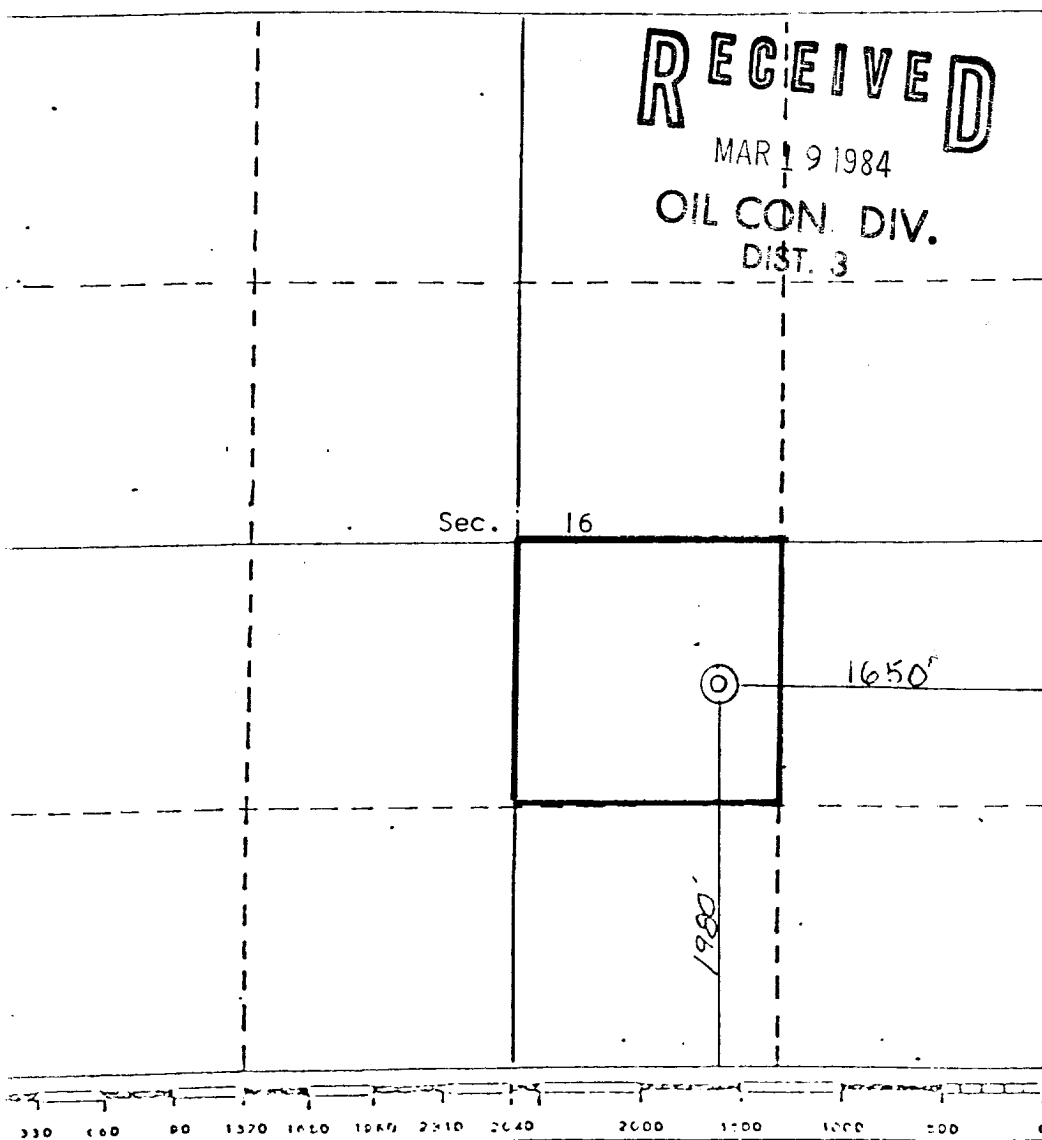

## CERTIFICATION

I hereby certify that the information contained herein is true and complete to the best of my knowledge and belief.

*James P. Woosley*  
Name James P. Woosley  
Operator

Position

Woosley Oil Company

Company

March 16, 1984


Date

I hereby certify that the well location shown on this plat was plotted from field notes of actual surveys made by me or under my supervision, and that the same is true and correct to the best of my knowledge and belief.

REGISTERED LAND  
30 January, 1984

*Curtis C. Stocking*  
Registered Professional Engineer  
and/or Land Surveyor  
Curtis C. Stocking

Certificate No.  
5980

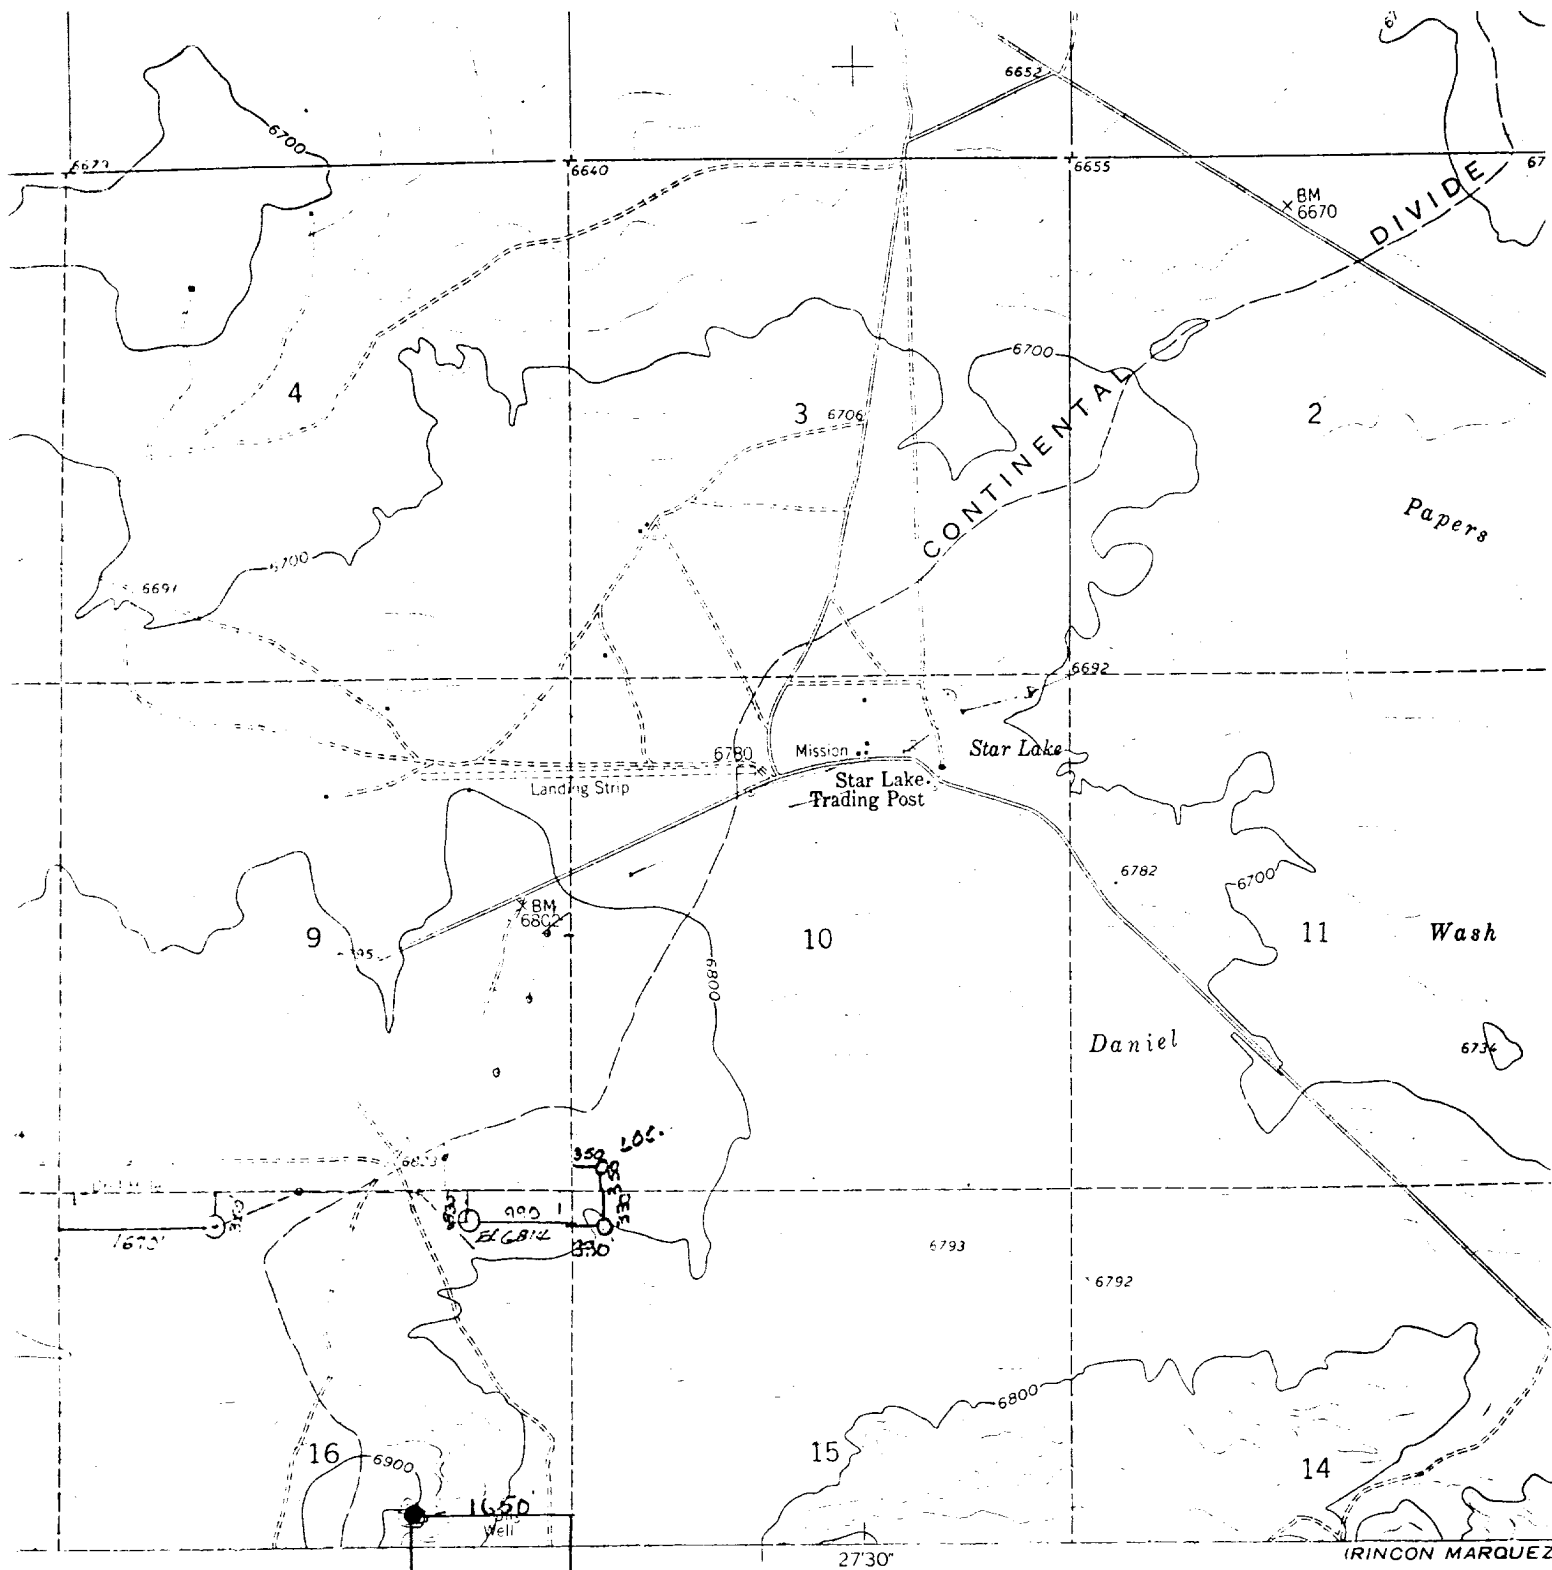


ned by the Geological Survey

hods from aerial  
ked 1961

merican datum  
ico coordinate system, west zone  
ercator grid ticks.

ed fence and field lines where  
ns. This information is unchecked

13 1/2°  
TRUE NORTH  
MAGNETIC NORTH  
APPROXIMATE MEAN  
DECLINATION, 1961

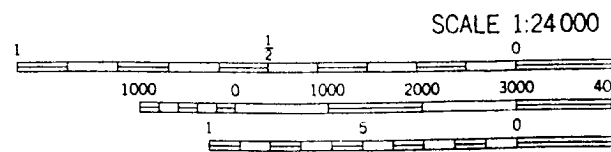

SCALE 1:24000

CONTOUR INTERVAL 20 F  
DOTTED LINES REPRESENT 10-FOOT  
MEAN SEA LEVEL

### VICINITY MAP WOOSLEY OIL

Well Location in NW/4SE/4 of Sec. 16  
T19N, R6W, N.M.P.M., McKinley Co.,  
New Mexico

IONAL MAP ACC  
VER 25, C  
PS AND SYMB

Scale: 1"=2000'