

UNITED STATES
DEPARTMENT OF THE INTERIOR
BUREAU OF LAND MANAGEMENT

Sundry Notices and Reports on Wells

1. Type of Well
GAS

2. Name of Operator

~~El Paso Natural Gas Company~~ *Meridian Oil Inc.*

3. Address & Phone No. of Operator

Box 4289, Farmington, NM 87499 (505) 326-9700

4. Location of Well, Footage, Sec, T, R, M.

1820'S, 1590'W Sec.32, T-28-N, R-6-W, NMPM

5. Lease Number

SF-079051

6. If Indian, All.or
Tribe Name

7. Unit Agreement Name

San Juan 28-6 Unit

8. Well Name & Number

San Juan 28-6 Unit #464

9. API Well No.

10. Field and Pool

Basin Fruitland Coal

11. County and State

Rio Arriba County, NM

12. CHECK APPROPRIATE BOX TO INDICATE NATURE OF NOTICE, REPORT, OTHER DATA

Type of Submission

Type of Action

☐ Notice of Intent

☐ Abandonment

☐ Change of Plans

☐ Subsequent Report

☐ Recompletion

☐ New Construction

☐ Final Abandonment

☐ Plugging Back

☐ Non-Routine Fracturing

☐ Casing Repair

☐ Water Shut Off

☐ Altering Casing

☐ Conversion to Injection

☐ Other

13. Describe Proposed or Completed Operations

Attached is a copy of the C-102, cut and fill diagram, and laydown for the revised location of this well.

RECEIVED

JAN 17 1991

OIL CON. DIV.
DIST. 3

14. I hereby certify that the foregoing is true and correct

Signed *[Signature]* Title Regulatory Affairs Date 11-26-90

(This space for Federal or State office use)

APPROVED BY _____ TITLE _____ DATE _____

CONDITION OF APPROVAL, IF ANY:

NMUCD

Submit to Appropriate
District Office
this Lease - 4 copies
to Lease - 3 copies

State of New Mexico
Energy, Minerals and Natural Resources Department

Form C-102
Revised 1-1-89

OIL CONSERVATION DIVISION

P.O. Box 2088
Santa Fe, New Mexico 87504-2088

TRACT I

Box 1980, Hobbs, NM 88240

TRACT II

Box 1980, Hobbs, NM 88240

TRACT III


Box 1980, Hobbs, NM 88240

WELL LOCATION AND ACREAGE DEDICATION PLAT

All Distances must be from the outer boundaries of the section

Section		Lease		Well No.	
El Paso Natural Gas Company		San Juan 28-6 UNit		464	
Section	Township	Range	County		
K	32	28 North	6 West	Rio arriba	
Count Footage Location of Well:					
1820 feet from the South line and		1590 feet from the West line			
Count level Elev.	Producing Formation	Pool	Dedicated Acreage:		
6216'	Fruitland Coal	Basin	325.23 Acres		

- Outline the acreage dedicated to the subject well by colored pencil or hectare marks on the plat below.
- If more than one lease is dedicated to the well, outline each and identify the ownership thereof (both as to working interest and royalty).
- If more than one lease of different ownership is dedicated to the well, have the interest of all owners been consolidated by communitization, unitization, force-pooling, etc.?
☒ Yes ☐ No If answer is "yes" type of consolidation unitization
If answer is "no" list the owners and tract descriptions which have actually been consolidated. (Use reverse side of this form if necessary.)
No allowable will be assigned to the well until all interests have been consolidated (by communitization, unitization, force-pooling, or otherwise) or until a non-standard unit, eliminating such interest, has been approved by the Division.

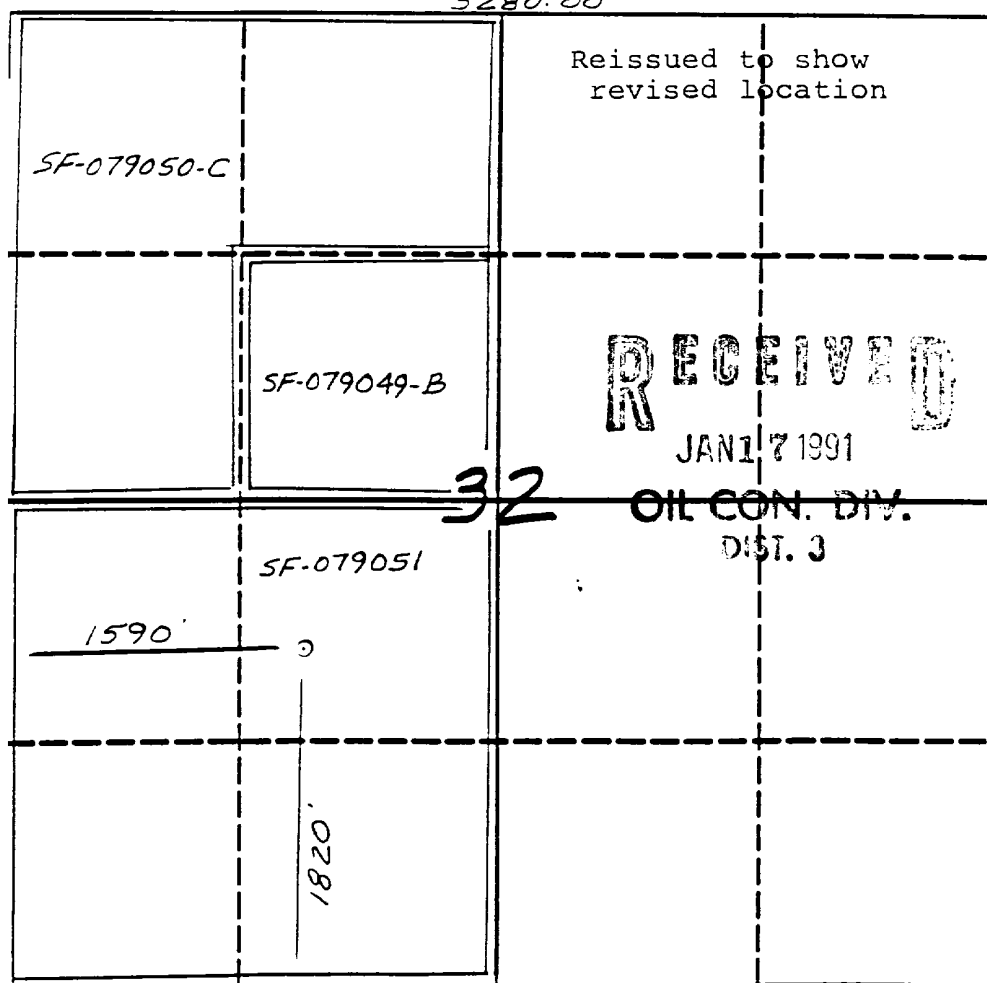

OPERATOR CERTIFICATION

I hereby certify that the information contained herein is true and complete to the best of my knowledge and belief.

Peggy Bradfield

Signature
Peggy Bradfield

Printed Name
Regulatory Affairs

Position
El Paso Natural Gas

Company
11-26-90

Date

SURVEYOR CERTIFICATION

I hereby certify that the well location shown on this plat was plotted from field notes of actual surveys made by me or under my supervision, and that the same is true and correct to the best of my knowledge and belief.

11-12-90

Date Surveyed

Signature
Professional Surveyor

NEW MEXICO
6857
6857
REGISTERED LAND SURVEYOR

Neale Edwards


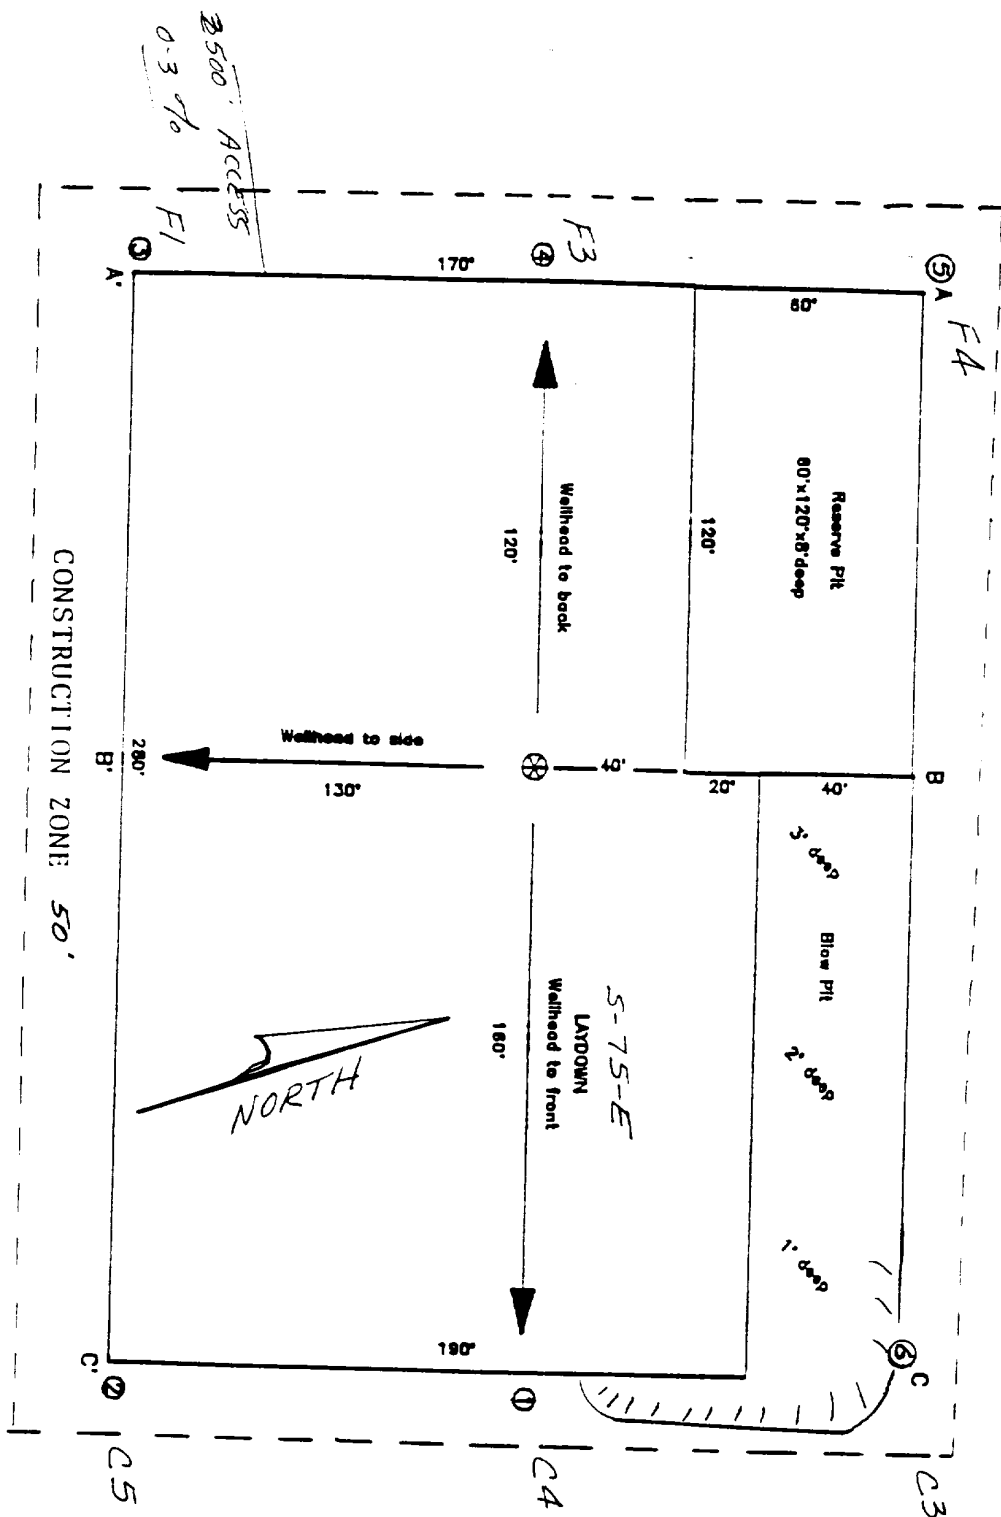


EXHIBIT: _____	
Name: EPNG San Juan 28-6 UNit #464	
Footage: 1820' FSL, 1590' FWL, _____	
Sec 32	T- 28 -N, R- 6 -W NMMPM
Co. Rio Arriba	St. NM
Elevation: 6216'	Date: 11-12-90

Plat 2
2/3/90


A - A' Vert.:1" = 20' Horiz.:1" = 50'

C/L

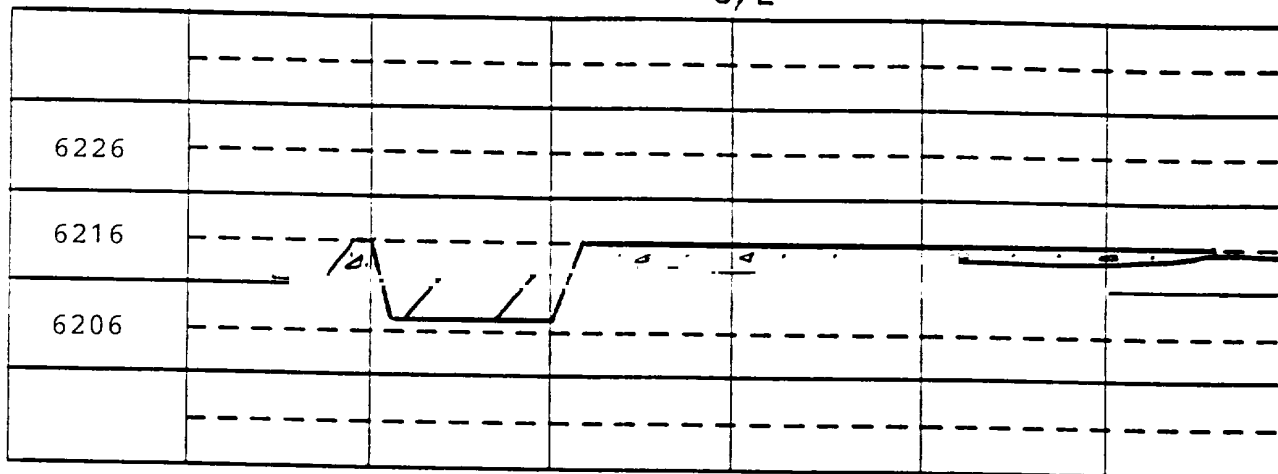

B - B'

C/L

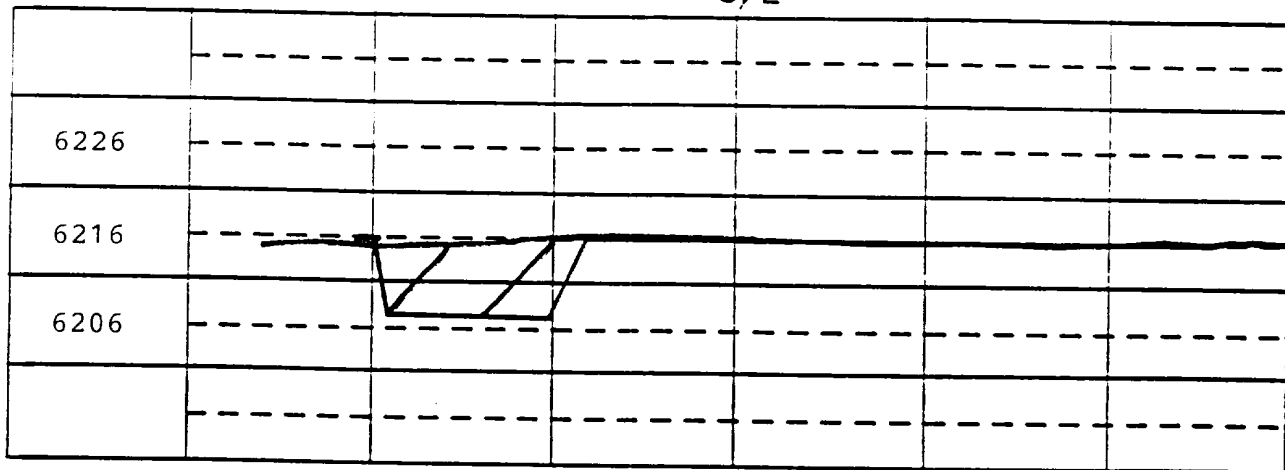

C - C'

C/L

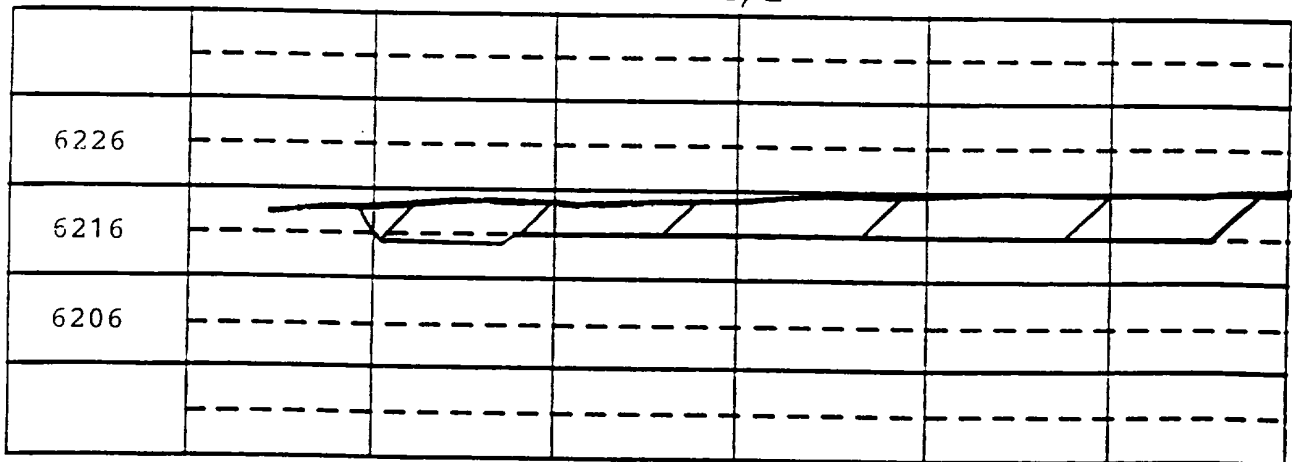


EXHIBIT:

Name: EPNG San Juan 28-6 Unit #464

Footage: 1820' FSL, 1590' FWL,

Sec 32 T- 28 -N,R- 6 -W NMPM

Co. Rio Arriba St. NM

Elevation: 6216' Date: 11-12-90

Plot XC
2/4/90