

NEW MEXICO
OIL CONSERVATION COMMISSION

NSL-62

WELL LOCATION AND/OR GAS PROPORTION PLAT

to be issued 10/14/56

MARCH 6, 1956

OCC - Aztec
and 9/24/56

EL PASO NATURAL GAS COMPANY

JOHNSTON

NM 04202

2

9

28-N

9-W

1800

SOUTH

870

EAST

6262

SAN JUAN


PICTURED CLIFF

AZTEC

20387

(1916 PLAT)

Enorm - is this
okay

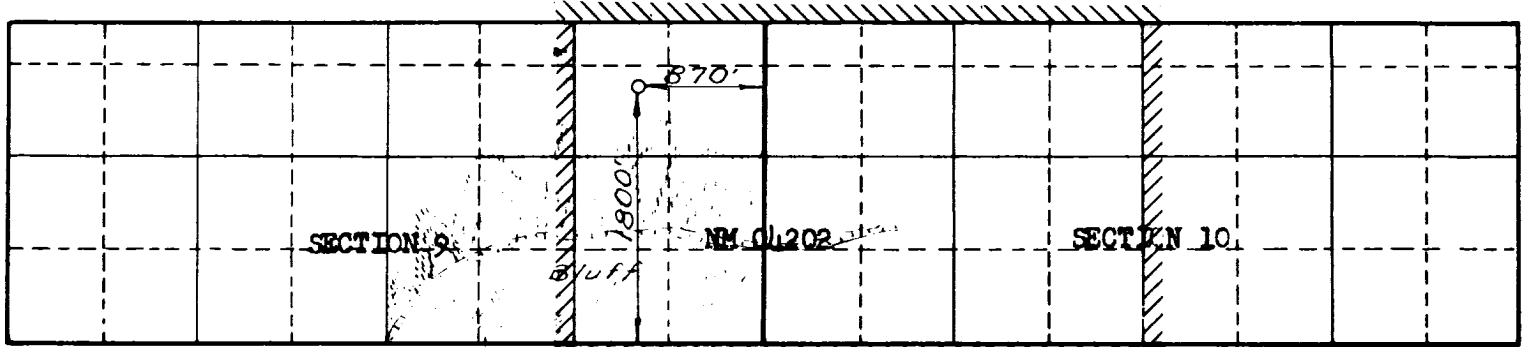

NWU - OK
K-891

al

Scale 4 inches equal 1 mile

NOTE

This section of
form is to be used
for gas wells only

This is to certify that the above plat was prepared from
field notes of actual surveys made by me or under my
supervision and that the same are true and correct to the
best of my knowledge and belief.

Date Surveyed FEBRUARY 13, 1956

E. O. Walker
Registered Professional Engineer and/or Land Surveyor

1. Is this well a Dual Comp.

Yes _____ No _____

2. If the answer to Question 1

is yes, are there any other dually
completed wells within the
dedicated acreage.


Yes _____ No _____

Name _____

Position _____

Representing _____

Address _____

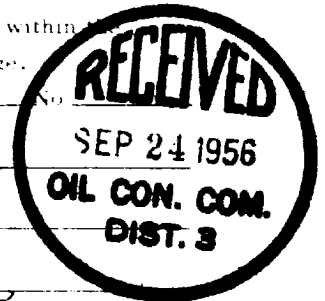


(Seal)


Farmington, New Mexico

NOTE: THIS PLAT IS RE-ISSUED TO SHOW CORRECTED ACREAGE DEDICATION.

PLAT SHOWING UNORTHODOX LOCATION AND
OFFSET ACREAGE OF JOHNSTON #2

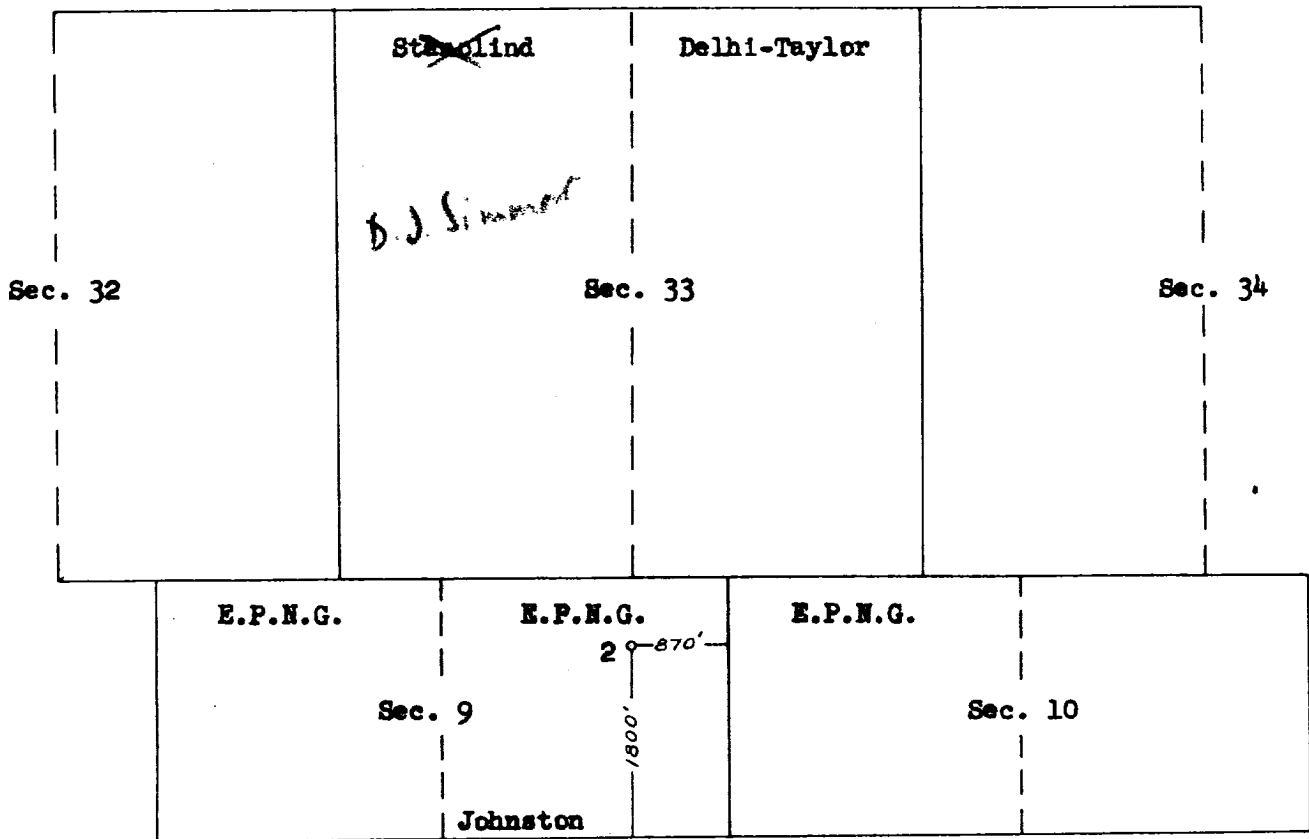

| | | |
|---|------------|-----|
| EL PASO NATURAL GAS COMPANY EL PASO, TEXAS | | |
| SCALE | DATE | No. |
| DRAWN BY | CHECKED BY | |

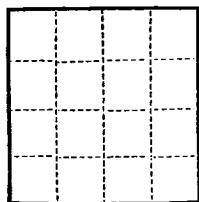

(SUBMIT IN TRIPLICATE)
UNITED STATES
DEPARTMENT OF THE INTERIOR
GEOLOGICAL SURVEY

Land Office New Mexico
Lease No. 04202
Unit Johnston

SUNDRY NOTICES AND REPORTS ON WELLS

| | | | |
|--|-------------------------------------|--|--|
| NOTICE OF INTENTION TO DRILL | <input checked="" type="checkbox"/> | SUBSEQUENT REPORT OF WATER SHUT-OFF | |
| NOTICE OF INTENTION TO CHANGE PLANS | | SUBSEQUENT REPORT OF SHOOTING OR ACIDIZING | |
| NOTICE OF INTENTION TO TEST WATER SHUT-OFF | | SUBSEQUENT REPORT OF ALTERING CASING | |
| NOTICE OF INTENTION TO RE-DRILL OR REPAIR WELL | | SUBSEQUENT REPORT OF RE-DRILLING OR REPAIR | |
| NOTICE OF INTENTION TO SHOOT OR ACIDIZE | | SUBSEQUENT REPORT OF ABANDONMENT | |
| NOTICE OF INTENTION TO PULL OR ALTER CASING | | SUPPLEMENTARY WELL HISTORY | |
| NOTICE OF INTENTION TO ABANDON WELL | | | |

(INDICATE ABOVE BY CHECK MARK NATURE OF REPORT, NOTICE, OR OTHER DATA)

July 13, 1956

Well No. 2 is located 1800 ft. from ~~N~~ S line and 870 ft. from ~~W~~ E line of sec. 9

SE Section 9 28N 9W NMFM
($\frac{1}{4}$ Sec. and Sec. No.) (Twp.) (Range) (Meridian)

Astec P.C. San Juan New Mexico
(Field) (County or Subdivision) (State or Territory)

The elevation of the derrick floor above sea level is 6272 ft.

DETAILS OF WORK

(State names of and expected depths to objective sands; show sizes, weights, and lengths of proposed casings; indicate mudding jobs, cementing points, and all other important proposed work)

It is intended to drill a well thru the Pictured Cliff formation using rotary tools and to perforate and water fracture possible producing zones. Estimated Total Depth 2651'.

Casing Program:

9 5/8" at 120' with 125 sacks regular cement circulated to the surface.
5 1/2" at 2651' with 75 sacks regular cement, 75 sacks Pozmix.

E/2 E/2 Section 9 and W/2 Section 10 is dedicated to this well.
NM 04202, W/2 Sec. 10 E/2 E/2 Sec. 9.

I understand that this plan of work must receive approval in writing by the Geological Survey before operations may be commenced.

Company El Paso Natural Gas Company

Address Box 997

Farmington, New Mexico

By (s) Ewell N. Walsh

Title Petroleum Engineer

