

UNITED STATES
DEPARTMENT OF THE INTERIOR
BUREAU OF LAND MANAGEMENT

SUNDRY NOTICES AND REPORTS ON WELLS

1. TYPE OF WELL GAS		5. LEASE NUMBER SF-078764	
2. OPERATOR MERIDIAN OIL INC. 14538		6. IF INDIAN, ALL. OR TRIBE NAME	
3. ADDRESS & PHONE NO. OF OPERATOR P O BOX 4289 FARMINGTON, NM 87499		7. UNIT AGREEMENT NAME ROSA UNIT	
4. LOCATION OF WELL 630'FNL 315'FWL		8. FARM OR LEASE NAME ROSA UNIT 7440	
		9. WELL NO. 221	
		10. FIELD, POOL, OR WILDCAT 71629 BASIN FRUITLAND COAL	
		11. SEC. T. R. M OR BLK. C SEC. 18 T31N R05W NMPM	
14. PERMIT NO.	15. ELEVATIONS 6355'GL	12. COUNTY RIO ARRIBA	13. STATE NM
16. OTHER: Revision			
17. Describe proposed or completed operations <i>Report Change from NW pipeline</i>			

Attached is a revised copy of the C-102 showing the resurveyed footages for this well, an archaeological report, and a new cut-and-fill diagram. This resurvey was conducted by Meridian Oil Incorporated to verify or correct the location of the stake as reported in the Northwest Pipeline APD. The location of the stake has been moved to avoid archaeological sites and unorthodox footages.

NWPL Survey	630'FNL	315'FWL
MOI Survey	990'FNL	1260'FWL

RECEIVED

AUG 13 1990

OIL CON. DIV
DIST. 3

18. AUTHORIZED BY: *J. Caldwell*
REGULATORY AFFAIRS

7/27/90
DATE

NOTE: THIS FORMAT IS ISSUED IN LIEU OF US BLM FORM 3160-5.

=====

(This space for Federal or State office use)

APPROVED BY _____ TITLE _____
CONDITION OF APPROVAL, IF ANY:

NMOCD

DATE 7/27/90
[Signature]
15 APR 1991

Submit to Appropriate
District Office
State Lease - 4 copies
Fee Lease - 3 copies

State of New Mexico
Energy, Minerals and Natural Resources Department

Form C-102
Revised 1-1-89

OIL CONSERVATION DIVISION

P.O. Box 2088
Santa Fe, New Mexico 87504-2088

DISTRICT I
P.O. Box 1980, Hobbs, NM 88240

DISTRICT II
P.O. Drawer 00, Artesia, NM 88210

DISTRICT III
1000 Rio Brazos Rd., Aztec, NM 87410

WELL LOCATION AND ACREAGE DEDICATION PLAT

All Distances must be from the outer boundaries of the section

Operator Meridian Oil Inc.			Lease Rosa Unit(SF-078764)		Well No. 221
Unit Letter A	Section 18	Township 31 North	Range 5 West	County Rio Arriba	
Actual Footage Location of Well: 990 feet from the North line and 1260 feet from the East line					
Ground level Elev. 6460'	Producing Formation Fruitland Coal		Pool Basin	Dedicated Acreage: 231.89 Acres	

- Outline the acreage dedicated to the subject well by colored pencil or machine marks on the plat below.
- If more than one lease is dedicated to the well, outline each and identify the ownership thereof (both as to working interest and royalty).
- If more than one lease of different ownership is dedicated to the well, have the interest of all owners been consolidated by commutation, unitization, force-pooling, etc.?
☒ Yes ☐ No If answer is "yes" type of consolidation unitization
If answer is "no" list the owners and tract descriptions which have actually been consolidated. (Use reverse side of this form if necessary.)
No allowance will be assigned to the well until all interests have been consolidated (by commutation, unitization, forced-pooling, or otherwise) or until a non-standard unit, eliminating such interest, has been approved by the Division.

OPERATOR CERTIFICATION

I hereby certify that the information contained herein is true and complete to the best of my knowledge and belief.

Signature
Peggy Bradfield
Printed Name
Regulatory Affairs
Position
Meridian Oil Inc.
Company

Date

SURVEYOR CERTIFICATION

I hereby certify that the well location shown on this plat was plotted from field notes of actual surveys made by me or under my supervision, and that the same is true and correct to the best of my knowledge and belief.

Date Surveyed
12-12-89
Signature of Surveyor
Noble O. Edwards
Professional Surveyor
6857

License No.

6857

RECEIVED

AUG 3 1990


OIL CON. DIV
DIST. 3

0 300 600 900 1200 1500 1800 2100 2400 2700 3000 3300 3600 3900 4200 4500 4800 5100 5400 5700 6000

IBANCOS 4557

T 32 N
T 31 N

4089
4088
4087

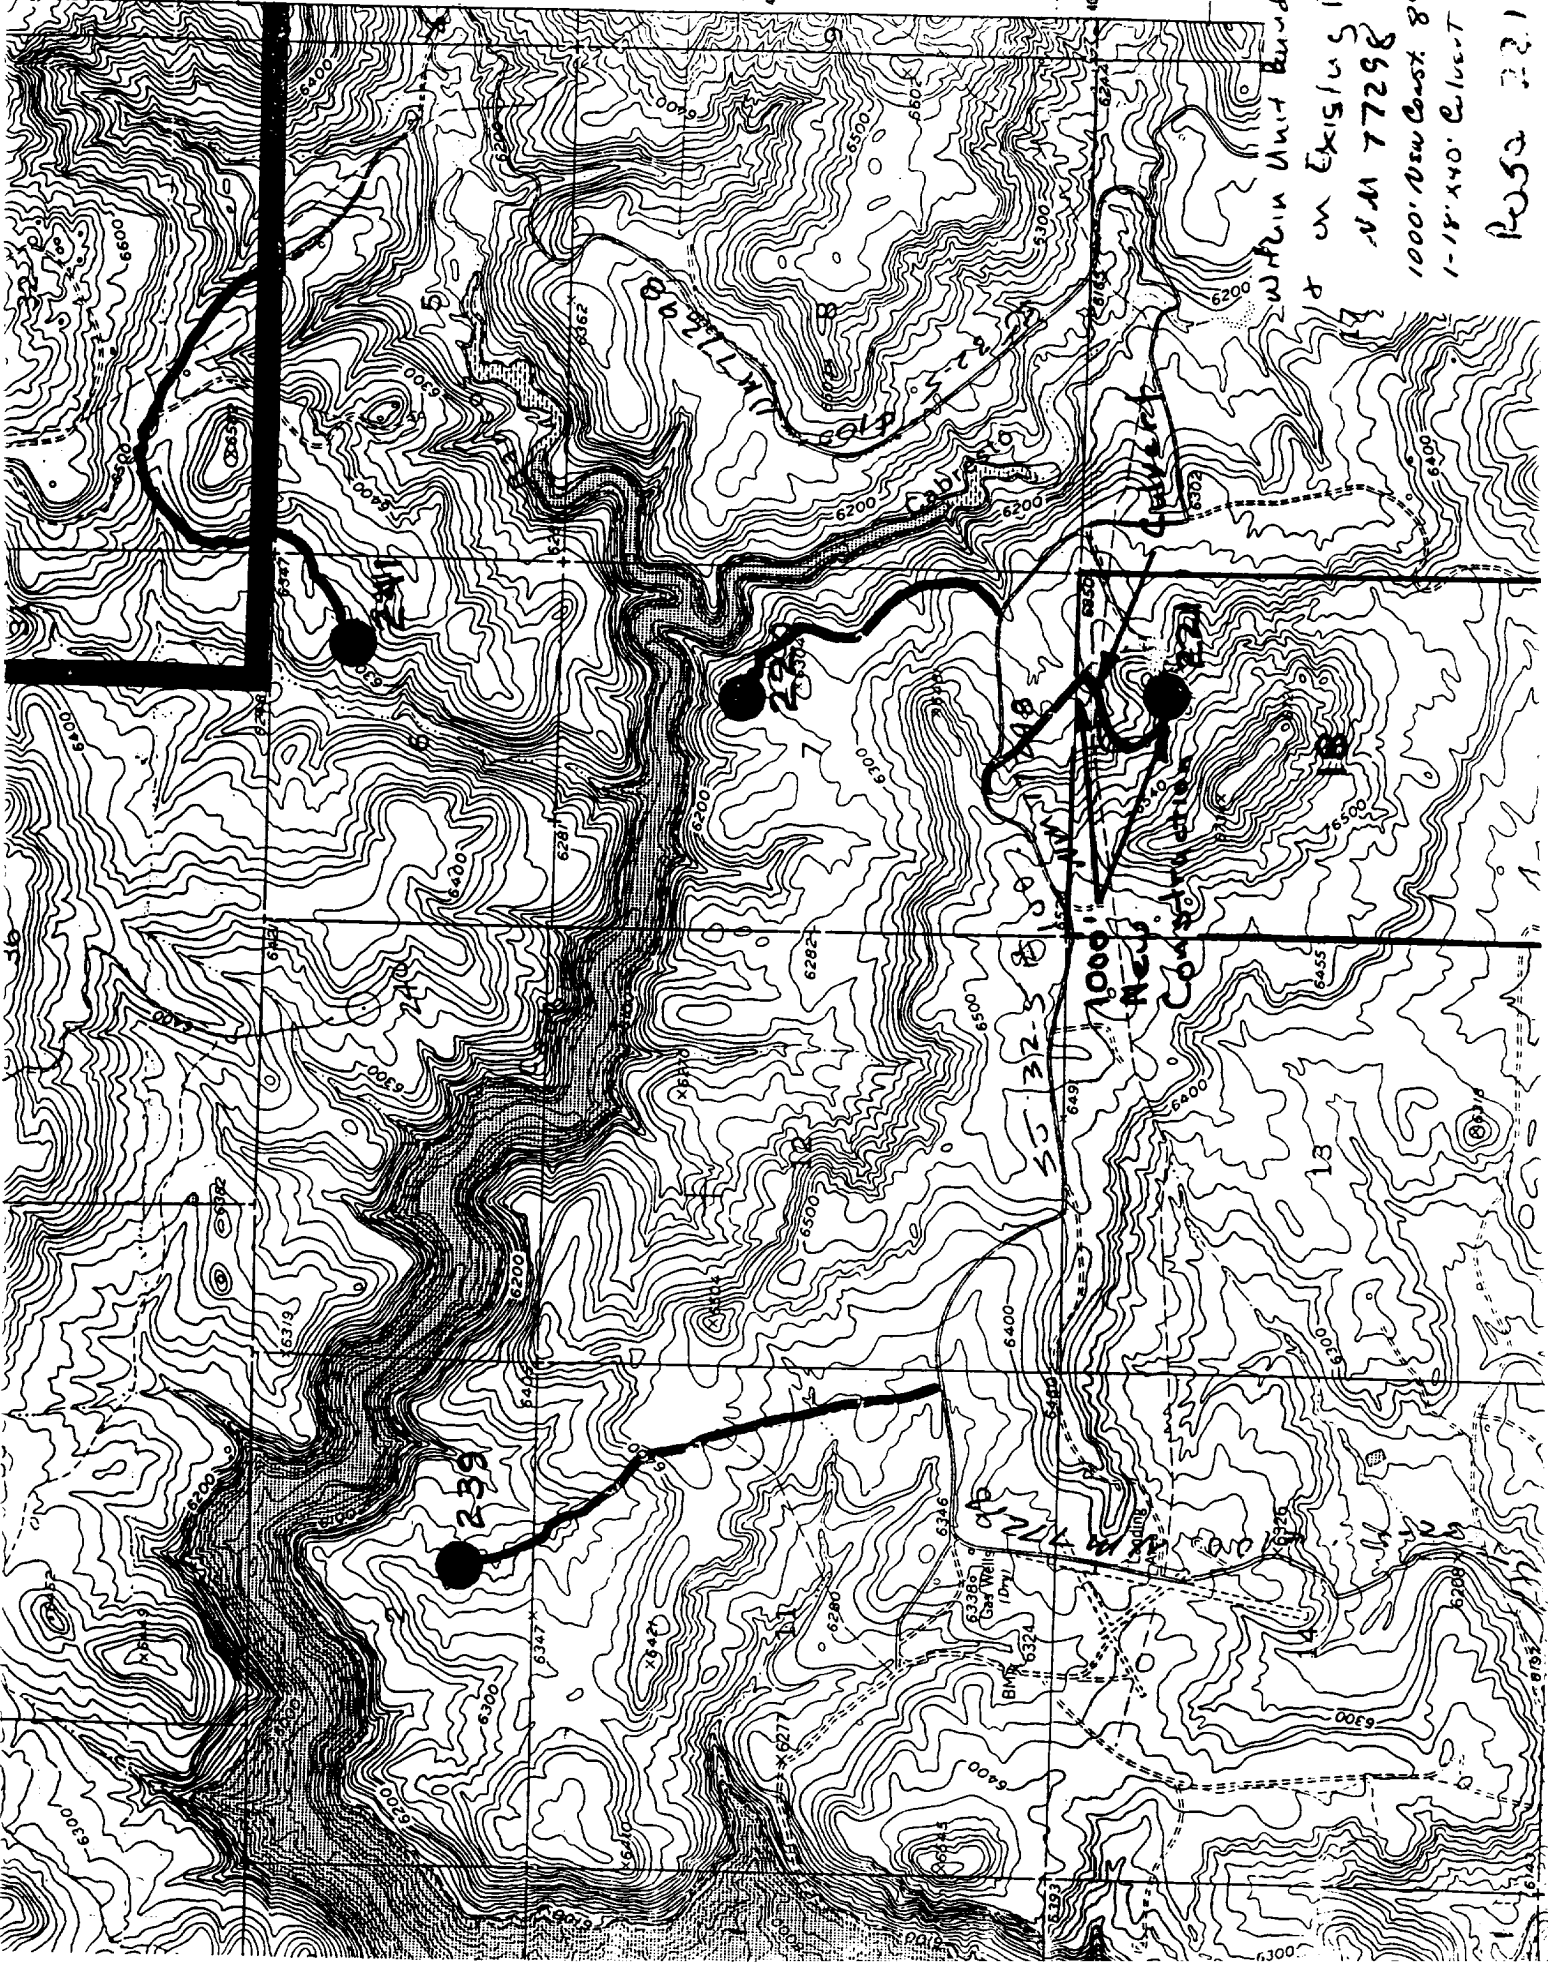

within Unit boundaries
on Existing ROW
NAM 77298
1000' New Const. 8%
1-18' x 40' Culvert
Rosa 221