

All distances must be from the outer boundaries of the Section.

|                                                                                                   |                                       |                                  |                                        |                    |
|---------------------------------------------------------------------------------------------------|---------------------------------------|----------------------------------|----------------------------------------|--------------------|
| Operator<br>Meridian Oil Inc.                                                                     |                                       | Lease<br>Quigley COM (SF-081134) |                                        | Well No.<br>250    |
| Unit Letter<br>N                                                                                  | Section<br>6                          | Township<br>30 North             | Range<br>9 West                        | County<br>San Juan |
| Actual Footage Location of Well:<br>1030 feet from the South line and 850 feet from the West line |                                       |                                  |                                        |                    |
| Ground Level Elev.<br>6550'                                                                       | Producing Formation<br>Fruitland Coal | Pool<br>Undesignated             | Dedicated Acreage:<br>160 100.25 acres |                    |


1. Outline the acreage dedicated to the subject well by colored pencil or hachure marks on the plat below.
2. If more than one lease is dedicated to the well, outline each and identify the ownership thereof (both as to working interest and royalty).
3. If more than one lease of different ownership is dedicated to the well, have the interests of all owners been consolidated by communitization, unitization, force-pooling, etc?

☒ Yes ☐ No If answer is "yes," type of consolidation communitization

If answer is "no," list the owners and tract descriptions which have actually been consolidated. (Use reverse side of this form if necessary.)

No allowable will be assigned to the well until all interests have been consolidated (by communitization, unitization, forced-pooling, or otherwise) or until a non-standard unit, eliminating such interests, has been approved by the Division.

NOTE: reissued to show moved location.

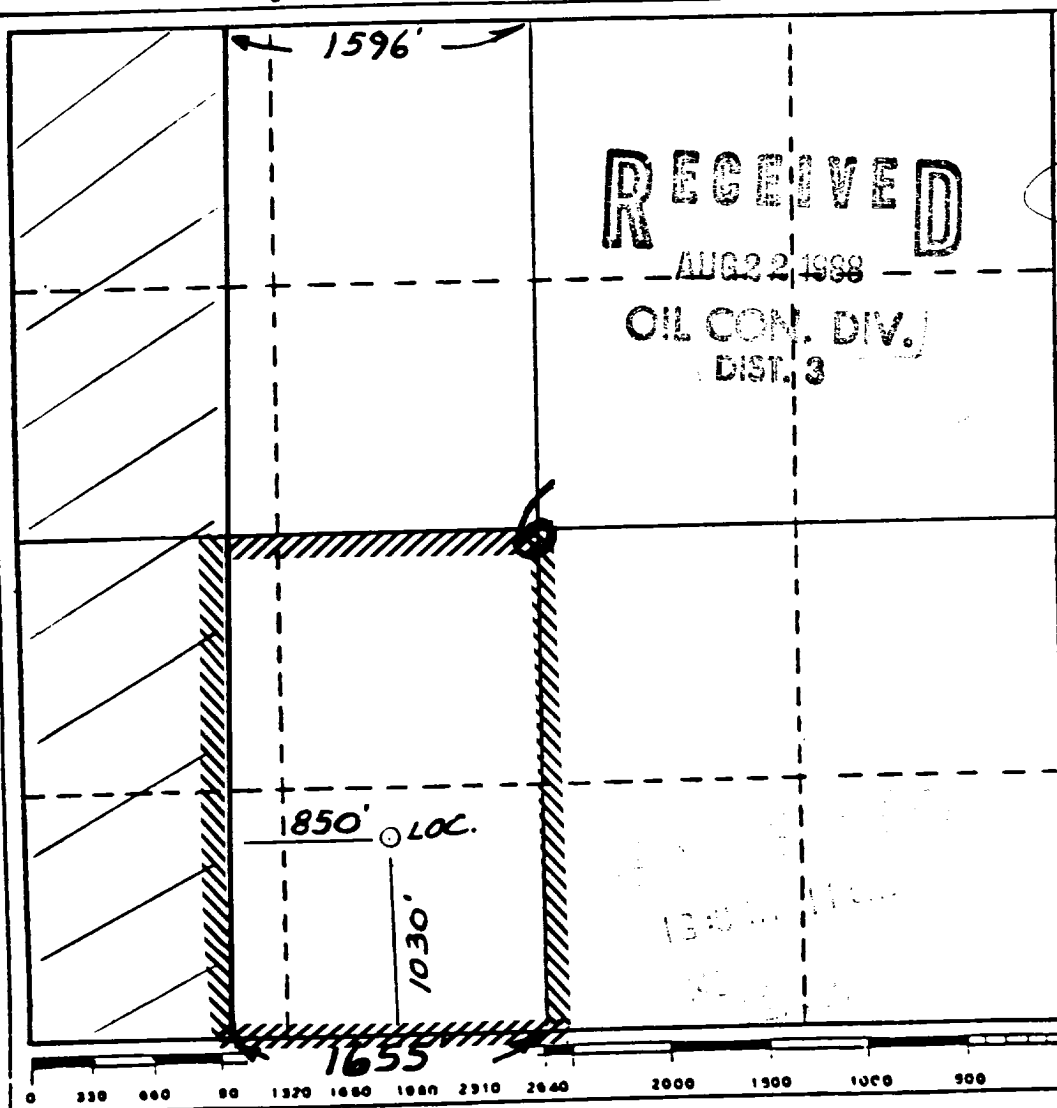

CERTIFICATION

I hereby certify that the information contained herein is true and complete to the best of my knowledge and belief.

*[Signature]*

Name  
Regulatory Affairs

Position  
Meridian Oil Inc.

Company  
*[Signature]*

Date  
*[Signature]*

I hereby certify that the well location shown on this plat is plotted from field notes of actual surveys made by me or under my supervision, and that the same is true to the best of my knowledge and belief.

*[Signature]*

Date Surveyed  
7-18-88

Registered Professional Engineer  
and/or Land Surveyor

Neale C. Edwards

Certificate No.

8857


# MERIDIAN OIL

WELL NAME

Meridian Oil Inc.

Quigley #250

1030' FSL, 850' FWL,  
Sec.6, T30N, R9W, N.M.P.M.  
San Juan Co., N.M.

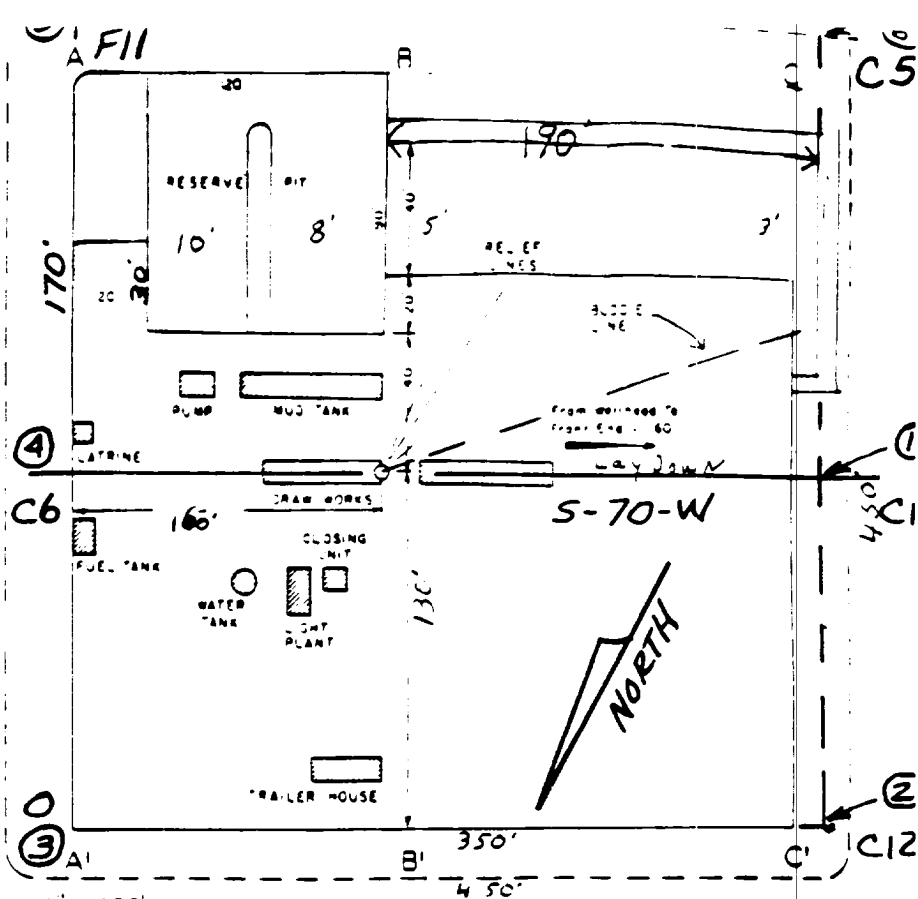


A - A'

Vert. L' = 30'


Horiz. 1" = 100'

C / L

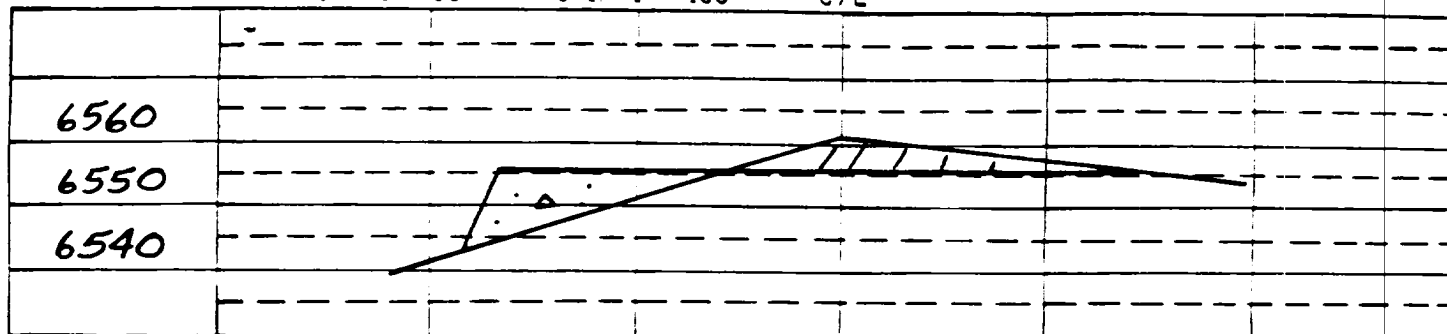

11 - 12

C/L

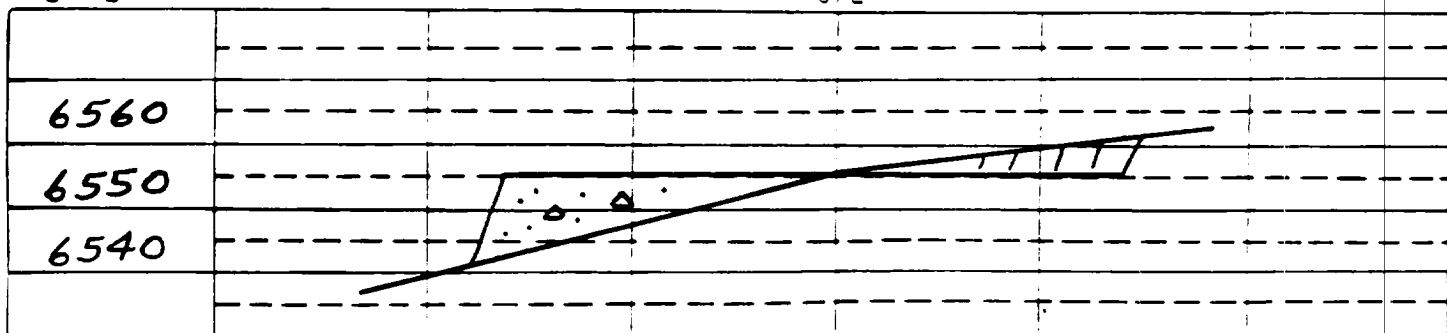

C - C

C/L

