

UNITED STATES
DEPARTMENT OF THE INTERIOR
GEOLOGICAL SURVEY

SUNDRY NOTICES AND REPORTS ON WELLS

(Do not use this form for proposals to drill or to deepen or plug back to a different reservoir. Use Form 9-331-C for such proposals.)

1. oil ☐ gas ☒ other ☐

2. NAME OF OPERATOR
Blackwood and Nichols Co., LTD

3. ADDRESS OF OPERATOR
P.O. Box 1237, Durango, CO 81302-1237

4. LOCATION OF WELL (REPORT LOCATION CLEARLY. See space 17 below.)
AT SURFACE: 1200' FNL - 1610' FEL
AT TOP PROD. INTERVAL:
AT TOTAL DEPTH:

16. CHECK APPROPRIATE BOX TO INDICATE NATURE OF NOTICE, REPORT, OR OTHER DATA

REQUEST FOR APPROVAL TO:

SUBSEQUENT REPORT OF:

TEST WATER SHUT-OFF ☐

FRACTURE TREAT ☐

SHOOT OR ACIDIZE ☐

REPAIR WELL ☐

PULL OR ALTER CASING ☐

MULTIPLE COMPLETE ☐

CHANGE ZONES ☐

ABANDON* ☐

(other) Change Footage Location ☐

5. LEASE

SF079082

6. IF INDIAN, ALLOTTEE OR TRIBE NAME

7. UNIT AGREEMENT NAME
Northeast Blanco

8. FARM OR LEASE NAME
Northeast Blanco Unit

9. WELL NO.

471

10. FIELD OR WILDCAT NAME

Basin Fruitland Coal

11. SEC., T., R., M., OR BLK. AND SURVEY OR AREA

Sec. 25, T31N, R8W

12. COUNTY OR PARISH: 13. STATE
San Juan NM

14. API NO.

15. ELEVATIONS (SHOW DF, KDB, AND WD)
6401' GL

(NOTE: Report results of multiple completion or zone change on Form 9-330.)

17. DESCRIBE PROPOSED OR COMPLETED OPERATIONS (Clearly state all pertinent details, and give pertinent dates, including estimated date of starting any proposed work. If well is directionally drilled, give subsurface locations and measured and true vertical depths for all markers and zones pertinent to this work.)^{*}

Change footage location to 1315' FNL - 1710' FEL. New C102 and cut and fill cross section attached.

RECEIVED
OCT 16 1989
OIL CON. DIV.
DIST. 3

APPROVED
OCT 11 1989
John S. Keller
AREA MANAGER

Subsurface Safety Valve: Manu. and Type

Set @ _____ Ft.

18. I hereby certify that the foregoing is true and correct

SIGNED

William F. Blac

TITLE

Operations Manager

DATE

Sept 26, 1985

(This space for Federal or State office use)

APPROVED BY
CONDITIONS OF APPROVAL, IF ANY

TITLE

DATE

Submit to Appropriate
District Office
State Lease - 4 copies
Fee Lease - 3 copies

State of New Mexico
Energy, Minerals and Natural Resources Department

*Change in
footage
of*
Form C-102
Revised 1-1-89

OIL CONSERVATION DIVISION

P.O. Box 2088

Santa Fe, New Mexico 87504-2088

DISTRICT I

P.O. Box 1980, Hobbs, NM 88240

DISTRICT II

P.O. Drawer DD, Artesia, NM 88210

DISTRICT III


1000 Rio Brazos Rd., Aztec, NM 87410

WELL LOCATION AND ACREAGE DEDICATION PLAT

All Distances must be from the outer boundaries of the section

Operator Blackwood & Nichols Co., LTD.			Lease Northeast Blanco Unit		Well No. 471
Unit Letter G	Section 25	Township 31 North	Range 8 West	County San Juan	
Actual Footage Location of Well: 1315 feet from the North line and 1710 feet from the East line					
Ground level Elev. 6401'	Producing Formation Fruitland Coal		Pool Basin Fruitland Coal		Dedicated Acreage: 320 Acres

1. Outline the acreage dedicated to the subject well by colored pencil or hatchure marks on the plat below.
2. If more than one lease is dedicated to the well, outline each and identify the ownership thereof (both as to working interest and royalty).
3. If more than one lease of different ownership is dedicated to the well, have the interest of all owners been consolidated by communitization, unitization, force-pooling, etc.?
☒ Yes ☐ No If answer is "yes" type of consolidation Unitization
If answer is "no" list the owners and tract descriptions which have actually been consolidated. (Use reverse side of this form if necessary.)
No allowable will be assigned to the well until all interests have been consolidated (by communitization, unitization, force-pooling, or otherwise) or until a non-standard unit, eliminating such interest, has been approved by the Division.

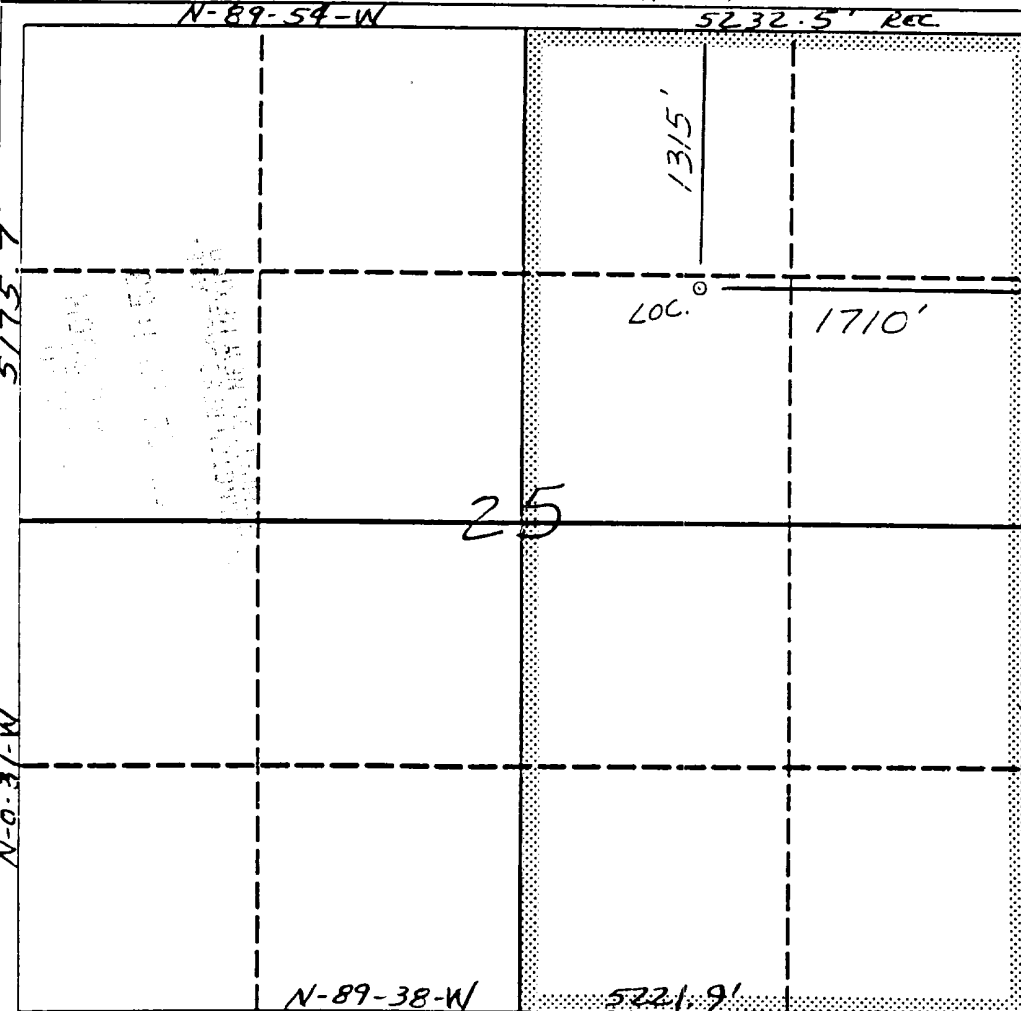

OPERATOR CERTIFICATION

I hereby certify that the information contained herein is true and complete to the best of my knowledge and belief.

William F. Clark
Signature

William F. Clark
Printed Name

Operations Manager
Position

Blackwood & Nichols Co.
Company

Sept 26, 1989
Date

SURVEYOR CERTIFICATION

I hereby certify that the well location shown on this plat was plotted from field notes, actual surveys made by me or under my supervision, and that the same is true and correct to the best of my knowledge and belief.

Neale C. Edwards
Date Surveyed
Signature of Surveyor


Professional Surveyor

Neale C. Edwards
Certificate No.
6857

Blackwood & Nichols
Co., LTD.

Northeast Blanco Unit
#471

1315'FNL, 1710'FEL,
Sec.25, T31N, R8W, N4PM,
San Juan County, NM

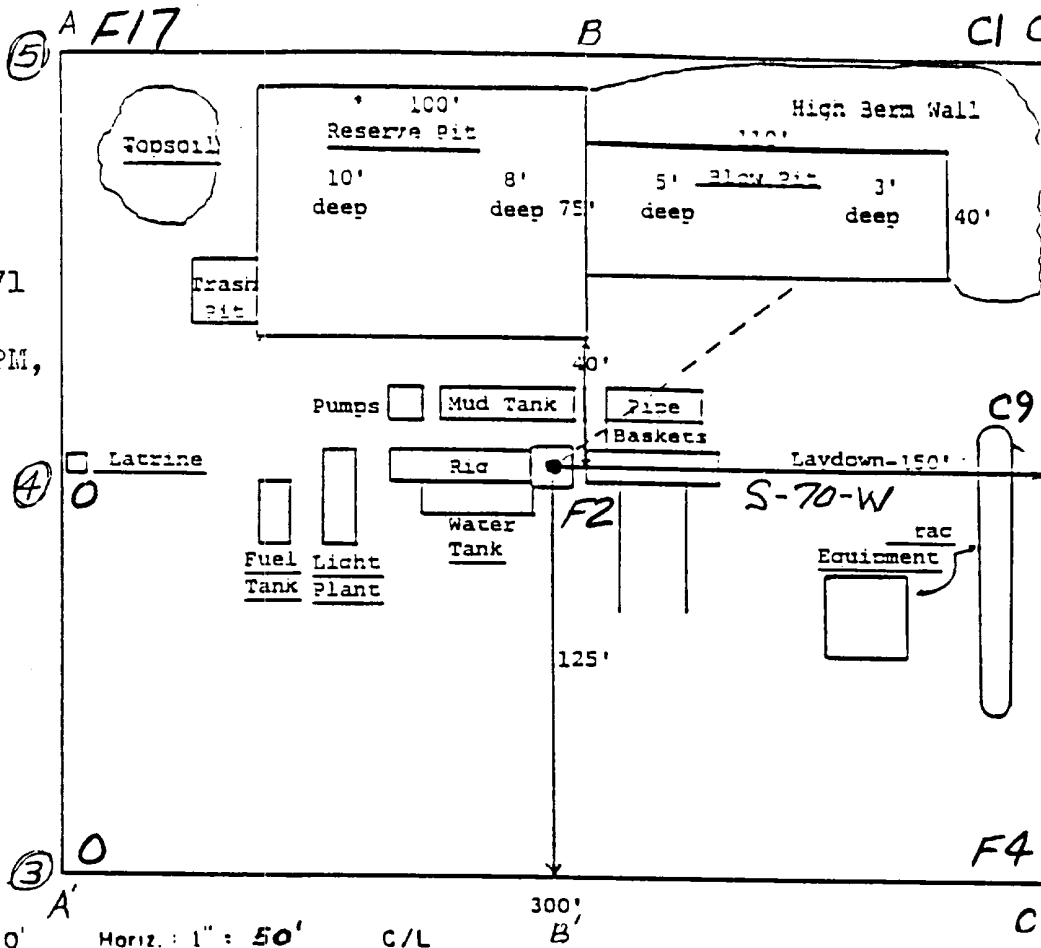

A - A'


Vert.: 1" = 10'

Horiz.: 1" = 50'

C/L


300'
B'

C'

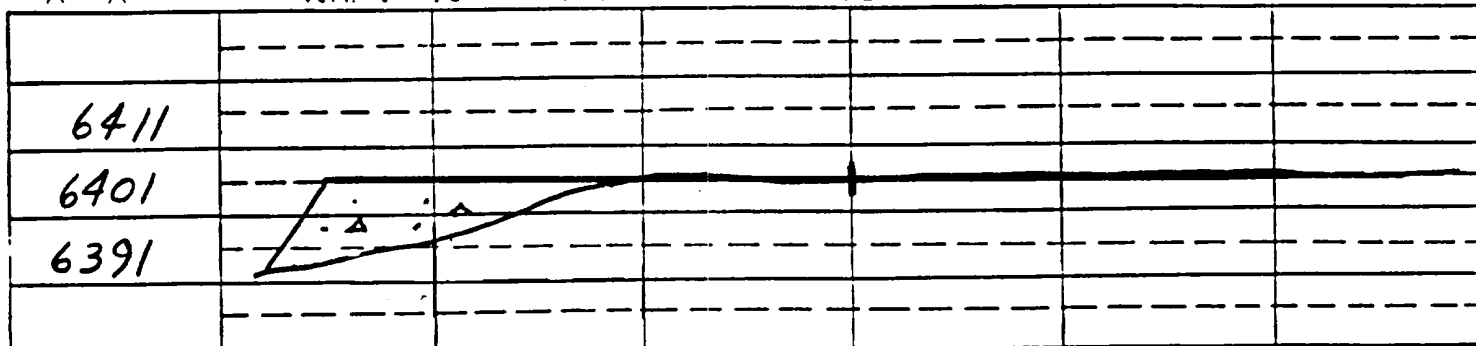

B - B'

C/L

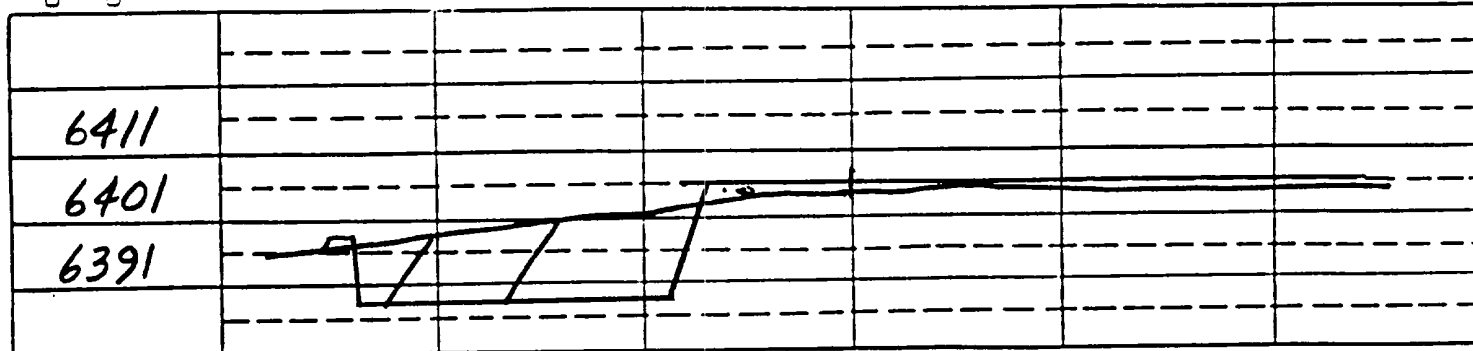

C - C'

C/L

