

UNITED STATES
DEPARTMENT OF THE INTERIOR
BUREAU OF LAND MANAGEMENT

Sundry Notices and Reports on Wells

1. Type of Well GAS	5. Lease Number SF-080376
2. Name of Operator Meridian Oil Inc.	6. If Indian, All.or Tribe Name
3. Address & Phone No. of Operator Box 4289, Farmington, NM 87499 (505) 326-9700	7. Unit Agreement Name San Juan 32-9 Unit
4. Location of Well, Footage, Sec, T, R, M. 1290'N, 845'E Sec. 9, T-31-N, R-9-W, NMPM	8. Well Name & Number San Juan 32-9 Unit #258
	9. API Well No.
	10. Field and Pool Basin Fruitland Coal
	11. County and State San Juan County, NM

12. CHECK APPROPRIATE BOX TO INDICATE NATURE OF NOTICE, REPORT, OTHER DATA

Type of Submission	Type of Action
☐ Notice of Intent	☐ Abandonment
☐ Subsequent Report	☐ Recompletion
☐ Final Abandonment	☐ Plugging Back
	☐ Casing Repair
	☐ Altering Casing
	☐ Other
	☐ Change of Plans
	☐ New Construction
	☐ Non-Routine Fracturing
	☐ Water Shut Off
	☐ Conversion to Injection

13. Describe Proposed or Completed Operations

Attached is a copy of the C-104, cut and fill diagram, and laydown showing the revised location of this well. This well was moved to avoid an archaeological site..

RECEIVED

SEP 11 1990

OIL CON. DIV
DIST. 3

APPROVED

[Signature]
AREA MANAGER

14. I hereby certify that the foregoing is true and correct
Signed *[Signature]* Title Regulatory Affairs Date 7-27-90

(This space for Federal or State office use)

APPROVED BY _____ TITLE _____ DATE _____
CONDITION OF APPROVAL, IF ANY:

[Signature]

Submit to Assignments
District Office
State Lease - 4 copies
Fee Lease - 3 copies

State of New Mexico
Energy, Minerals and Natural Resources Department

Form C-482
Revised 1-1-80

OIL CONSERVATION DIVISION

P.O. Box 2088

Santa Fe, New Mexico 87504-2088

DISTRICT I
P.O. Box 1980, Hobbs, NM 88240

DISTRICT II
P.O. Drawer DD, Artesa, NM 88210

DISTRICT III
1000 Rio Brazos Rd., Aztec, NM 87410

WELL LOCATION AND ACREAGE DEDICATION PLAT


All Distances must be from the outer boundaries of the section

Operator Meridian Oil Inc.			Lease San Juan 32-9 Unit (SF-080376)		Well No. 258
Unit Lease A	Section 9	Township 31 North	Range 9 West	County NMEN San Juan	
Actual Footage Location of Well: 1290 feet from the North line and 845 feet from the East line					
Ground level Elev. 6673'		Producing Formation Fruitland Coal		Pool Basin	
					Dedicated Acreage: 316.35 Acres

- Outline the acreage dedicated to the subject well by colored pencil or ballpoint marker on the plat below.
- If more than one lease is dedicated to the well, outline each and identify the ownership thereof (both as to working interest and royalty).
- If more than one lease of different ownership is dedicated to the well, have the interest of all owners been consolidated by communitization, unitization, force-pooling, etc.?
☒ Yes ☐ No If answer is "yes" type of consolidation: unitization

If answer is "no" list the owners and tract descriptions which have actually been consolidated. (Use reverse side of this form if necessary.)

No allowance will be assigned to the well until all interests have been consolidated (by communitization, unitization, force-pooling, or otherwise) or until a acre-standard unit, eliminating such interest, has been approved by the Division.

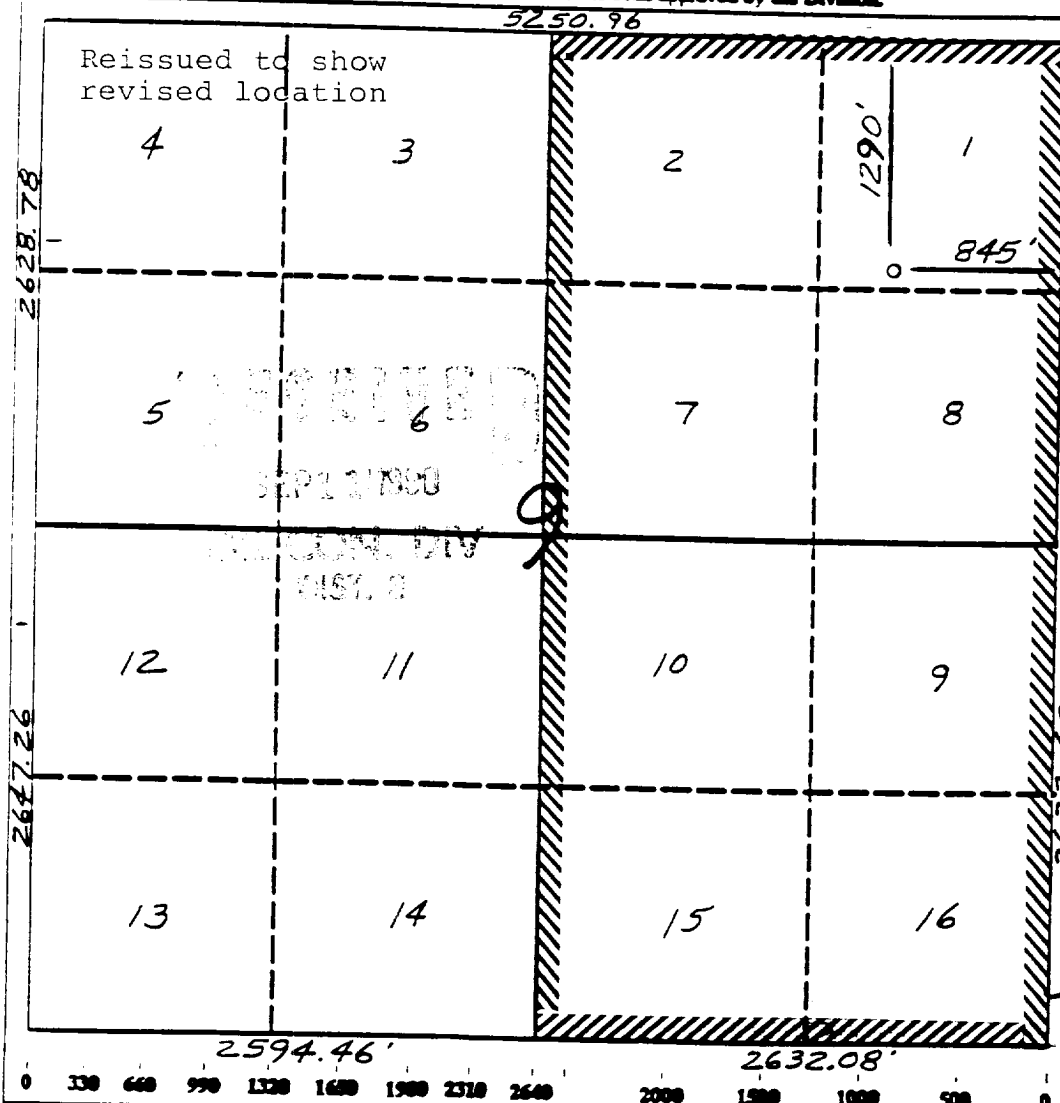

OPERATOR CERTIFICATION

I hereby certify that the information contained herein is true and complete to the best of my knowledge and belief.

Signature
Peggy Bradfield

Printed Name
Regulatory Affairs

Position
Meridian Oil Inc.

Company
7-27-90

Date

Signature of Seal of Professional Surveyor

6857

Certification No.

6857

SURVEYOR CERTIFICATION

I hereby certify that the well location shown on this plat was plotted from field notes of actual surveys made by me or under my supervision, and that the same is true and correct to the best of my knowledge and belief.

Date Surveyed

NEALE C. EDWARDS

Signature of Seal of Professional Surveyor


6857

Certification No.

6857


A - A' Vert: 1" = 20' Horiz: 1" = 50'

C/L

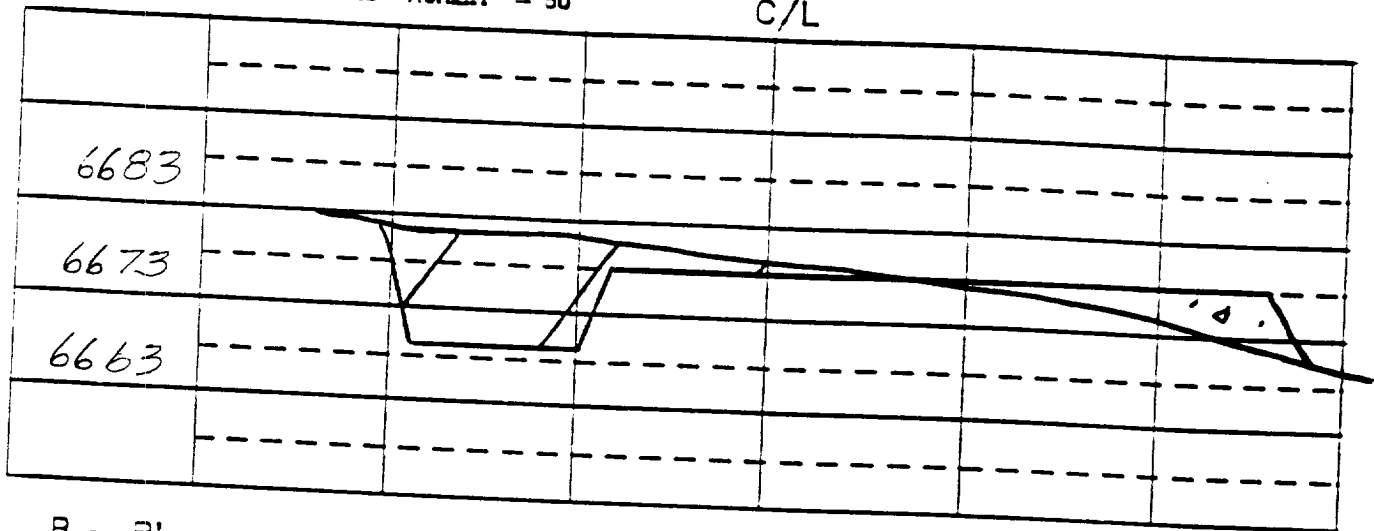

B - B'

C/L

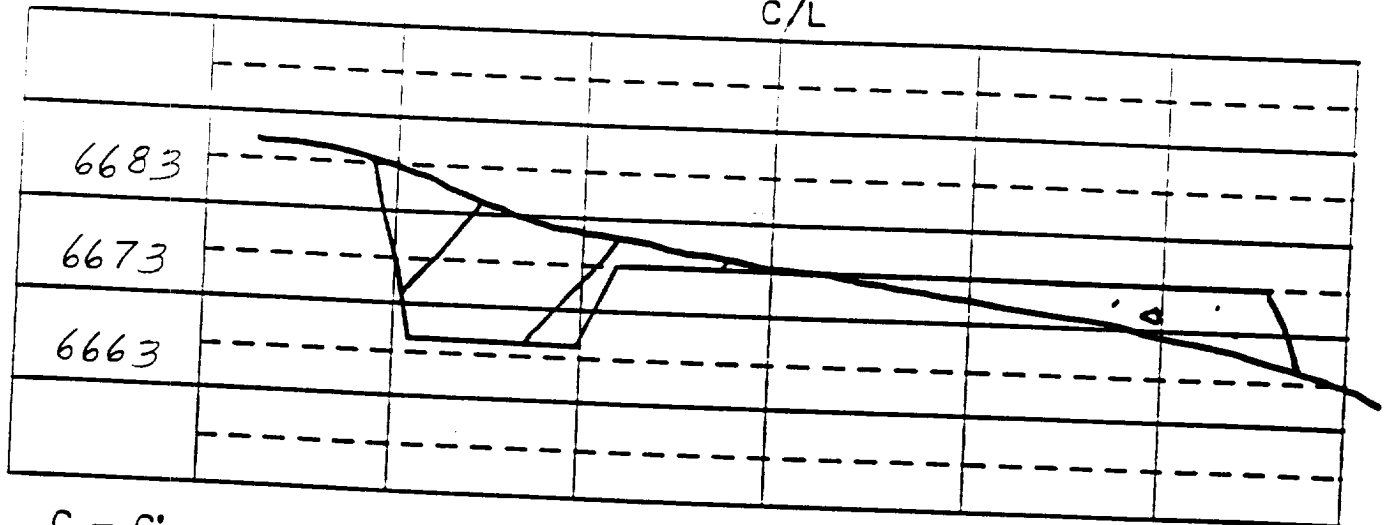

C - C'

C/L

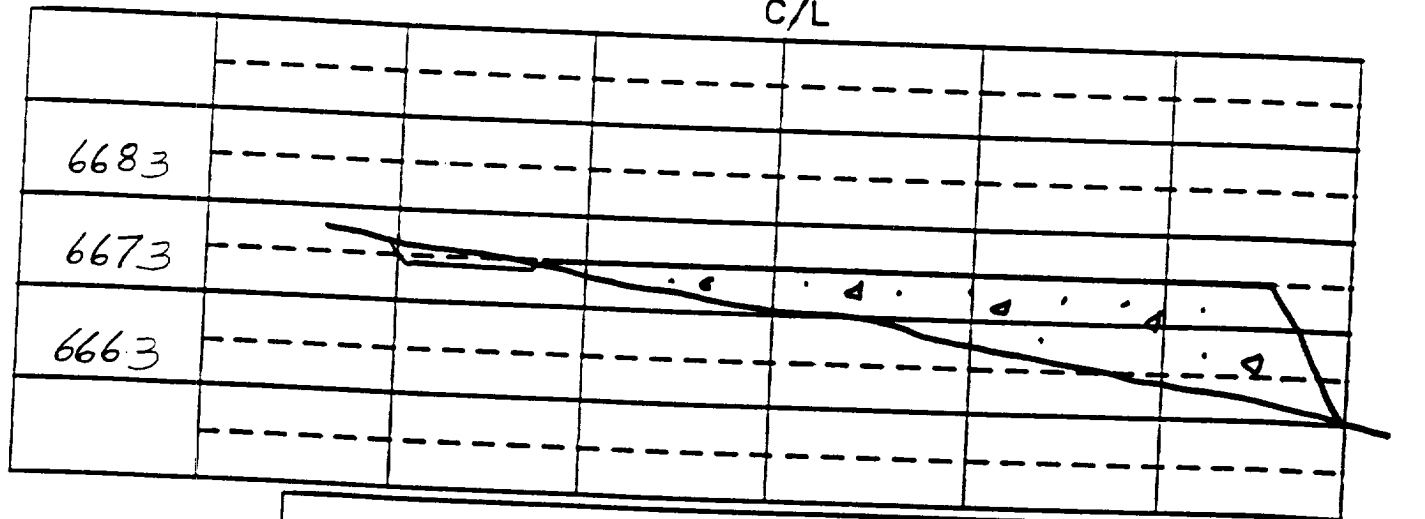


EXHIBIT: _____

Name: MOI SAN JUAN 32-9 UNIT # 258

Footage: 1290' FNL 845' FEL

Sec 9 T- 31 -N,R- 9 -W NMPM

Co. SAN JUAN St. NM

Elevation: 6673 Date: 7-27-90

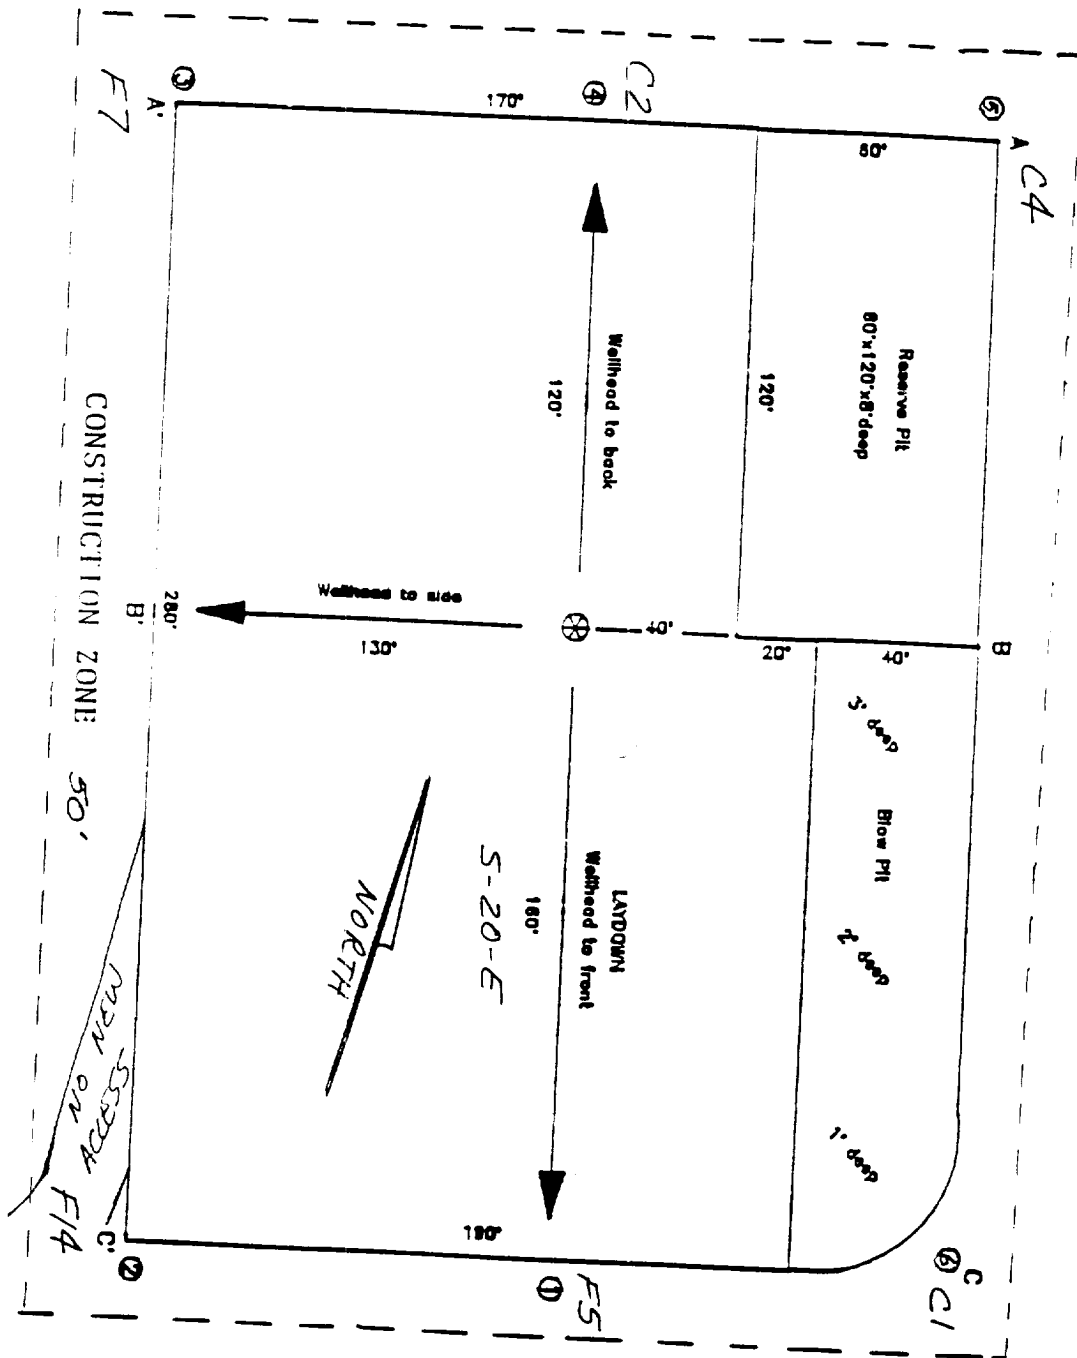


EXHIBIT: _____	
Name: <u>MOI SAN JUAN 32-9 UNIT # 258</u>	
Footage: <u>1290' FNL</u> <u>845' FEL</u>	
Sec <u>9</u>	T- <u>31</u> -N, R- <u>9</u> -W NMPM
Co. <u>SAN JUAN</u>	St. <u>NM</u>
Elevation: <u>6673</u>	Date: <u>7-27-90</u>

Plot 2
2/3/90