

UNITED STATES
DEPARTMENT OF THE INTERIOR
BUREAU OF LAND MANAGEMENT

FORM APPROVED
Budget Bureau No. 1004-0135
Expires: March 31, 1993

SUNDRY NOTICES AND REPORTS ON WELLS

Do not use this form for proposals to drill or to deepen or reentry to a different reservoir.
Use "APPLICATION FOR PERMIT - " for such proposals

5. Lease Designation and Serial No.

SF-078766

6. If Indian, Allottee or Tribe Name

7. If Unit or CA, Agreement Designation

8. Well Name and No.

Rosa Unit /DK/ #96

9. API Well No.

3004528983

10. Field and Pool, or Exploratory Area

Basin Dakota

11. County or Parish, State

San Juan, New Mexico

1. Type of Well
☐ Oil Well ☒ Gas Well ☐ Other

2. Name of Operator

Amoco Production Company

Attention:

DeAnne Tallant

3. Address and Telephone No.

P.O. Box 800, Denver, Colorado 80201

(303) 630-4040

4. Location of Well (Footage, Sec., T., R., M., or Survey Description)

1080' ^{ESL} ~~REL~~ 1015' ^{FWL} ~~REL~~

Sec. 17 T 31N R 6W

12. CHECK APPROPRIATE BOX(s) TO INDICATE NATURE OF NOTICE, REPORT, OR OTHER DATA

TYPE OF SUBMISSION

- ☐ Notice of Intent
☒ Subsequent Report
☐ Final Abandonment Notice

TYPE OF ACTION

- ☐ Abandonment
☐ Recompletion
☐ Plugging Back
☐ Casing Repair
☐ Altering Casing
☒ Other Construct Surface Line

- ☐ Change of Plans
☐ New Construction
☐ Non-Routine Fracturing
☐ Water Shut-Off
☐ Conversion to Injection
☐ Dispose Water

(Note: Report results of multiple completion on Well Completion or Recompletion Report and Log form.)

13. Describe Proposed or Completed Operations (Clearly state all pertinent details, and give pertinent dates, including estimated date of starting any proposed work, if well is directionally drilled, give subsurface locations and measured and true vertical depths for all markers and zones pertinent to this work.)

Amoco intends to construct a surface line for the Rosa #96 using 2.375" pipe, EUE J-55 TBG, 4.7#/foot.

RECEIVED
JAN 10 1994
OIL CON. DIV
DIST. 3

A NW PIPELINE LOT WILL BE HAND DELIVERED TO THE BLM BY
MIKE ROLAND.

If you have any questions, please contact Mike Rolland at (505) 725-9230.

14. I hereby certify that the foregoing is true and correct

Signed

DeAnne Tallant

Title

Staff Assistant

APPROVED 12-30-1993

(This space for Federal or State office use)

Approved by

Conditions of approval, if any:

Title

JAN - 6 1994

DISTRICT MANAGER

This 18 U.S.C. Section 1001, makes it a crime for any person knowingly and willfully to make to any department or agency of the United States any false, fictitious, or fraudulent statements or representations as to any matter within its jurisdiction.

* See Instructions on Reverse Side

AMCOO copies returned
for your attention

100-111111-111111

SUBDIVISION		OWNER	LEASE	FEET	MINES	ACRES	RODS
20+81.7	TO 28+95.4	BUREAU OF RECLAMATION		801.4	0.152		48.57
28+95.4	TO 36+47.2	BUREAU OF LAND MANAGEMENT		751.8	0.142		45.56
36+47.2	TO 69+46.5	BUREAU OF RECLAMATION		3299.3	0.625		199.95
69+46.5	TO 74+00.2	BUREAU OF LAND MANAGEMENT		453.7	0.086		27.49

NO	DATE	BY	REVISION DESCRIPTION	APP	NO	DATE	BY	REVISION DESCRIPTION	APP
1	8/25/93	CJF	REVISED PER LINE CHANGE DATED 8/19/93 & NAME CHANGE FROM (AMOCO #4)	AY					

SAN JUAN

GATHERING SYSTEM

WILLIAMS GAS PROCESSING COMPANY

ONE OF THE WILLIAMS COMPANIES

LINE AMOCO PRODUCTION - ROSA #96

FROM 0+00 = 17+50.8 ON ROSA #273

(REF 12N765 0-5-1)

COUNTY SAN JUAN STATE NEW MEXICO

SECTION 8 TOWNSHIP 31N RANGE 6W

SCALE 1"=1000'

ENG. NO. 12N765 0-6-1

DRAWN BY FAD

DATE 7/20/93

CHECKED BY CJF

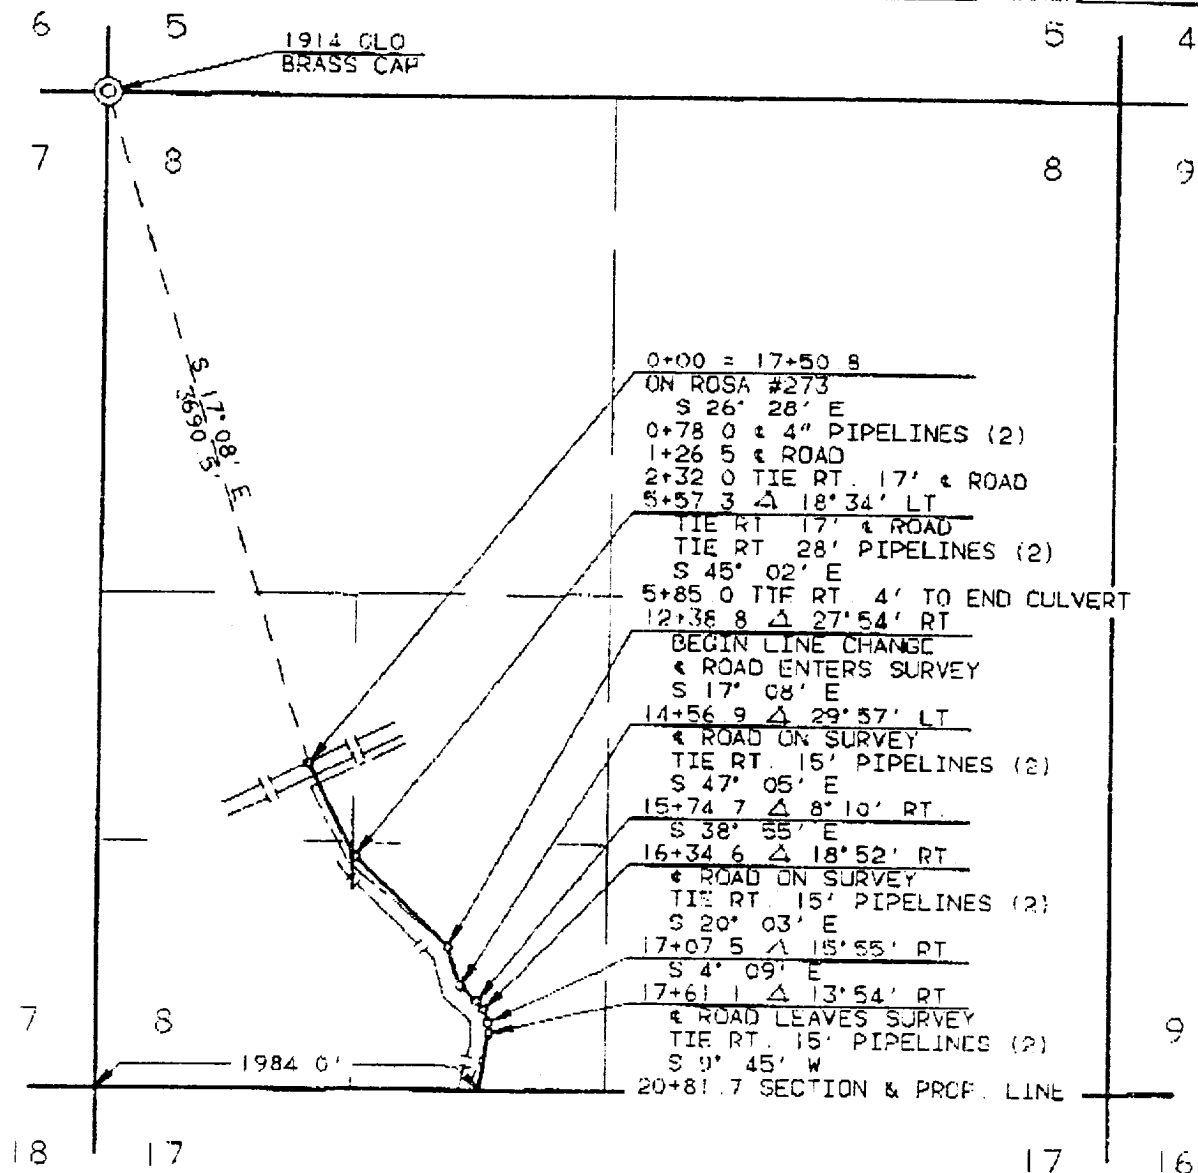
SURVEYED 7/12/93

APPROVED KWB

P.O. NO. 10396

APPROVED CKL

RAW NO. 01436

NOTE
BEARINGS ARE BASED ON
ASTRONOMIC DATA

APPLICATION CWS. DATE METER NO.

RECEIVED

JAN 1 01994

OIL CON. DIV
DIST. 3

Williams Field Services

of pages 2

To	Mike Berard	From	C. Lehman
Co	AMOCO	Co.	Williams Field Services
Dept.		Phone #	632-4631
Fax #	326-9262	Fax #	

OWNER'S	SUBDIVISION		OWNER		LEASE		FEET	MINES	ACRES	RODS
	0+00 TO 20+81.7		BUREAU OF LAND MANAGEMENT				2081.7	0.394		126.16
1	8/21/93	CJF	REVISED PER LINE CHANGE DATED 8/19/93							
			& NAME CHANGE FROM (AMOCO #4)							
NO	DATE	BY	REVISION DESCRIPTION				DATE	BY	REVISION DESCRIPTION	