

HOBBS OCD

DISTRICT I
1825 N. FRENCH DR., HOBBS, NM 88240
Phone: (575) 393-8181 Fax: (575) 393-0720

DISTRICT II
811 S. FIRST ST., ARTESIA, NM 88210
Phone: (575) 748-1283 Fax: (575) 748-9720

DISTRICT III
1000 RIO BRAZOS RD., AZTEC, NM 87410
Phone: (505) 334-6178 Fax: (505) 334-6170

DISTRICT IV
1220 S. ST. FRANCIS DR., SANTA FE, NM 87505
Phone: (505) 476-3460 Fax: (505) 476-3462

State of New Mexico
Energy, Minerals & Natural Resources Department

OIL CONSERVATION DIVISION

1220 SOUTH ST. FRANCIS DR.
Santa Fe, New Mexico 87505

JAN 15 2020**RECEIVED**

Form C-102

Revised August 1, 2011

Submit one copy to appropriate
District Office☒ AMENDED REPORT
As Drilled**WELL LOCATION AND ACREAGE DEDICATION PLAT**

API Number 30-025-45278	Pool Code 98098	Pool Name WC-025 G-09 S243532M; WOLFBONE
Property Code 322742	Property Name FEZ FEDERAL COM	Well Number 702H
OGRID No. 229137	Operator Name COG OPERATING, LLC	Elevation 3251.8'

Surface Location

UL or lot No. M	Section 9	Township 25-S	Range 35-E	Lot Idn	Feet from the 280	North/South line SOUTH	Feet from the 1115	East/West line WEST	County LEA
--------------------	--------------	------------------	---------------	---------	----------------------	---------------------------	-----------------------	------------------------	---------------

Bottom Hole Location If Different From Surface

UL or lot No. 3	Section 4	Township 25-S	Range 35-E	Lot Idn	Feet from the 201	North/South line NORTH	Feet from the 1569	East/West line WEST	County LEA
--------------------	--------------	------------------	---------------	---------	----------------------	---------------------------	-----------------------	------------------------	---------------

Dedicated Acres 641.72	Joint or Infill	Consolidation Code	Order No.
---------------------------	-----------------	--------------------	-----------

NO ALLOWABLE WILL BE ASSIGNED TO THIS COMPLETION UNTIL ALL INTERESTS HAVE BEEN CONSOLIDATED
OR A NON-STANDARD UNIT HAS BEEN APPROVED BY THE DIVISION


SEE PAGE 2

PAGE 1 OF 2


W.O. #19-2175

DRAWN BY: WN

Property Code 322742	Property Name FEZ FEDERAL COM	Well Number 702H
OGRID No. 229137	Operator Name COG OPERATING, LLC	Elevation 3251.8'

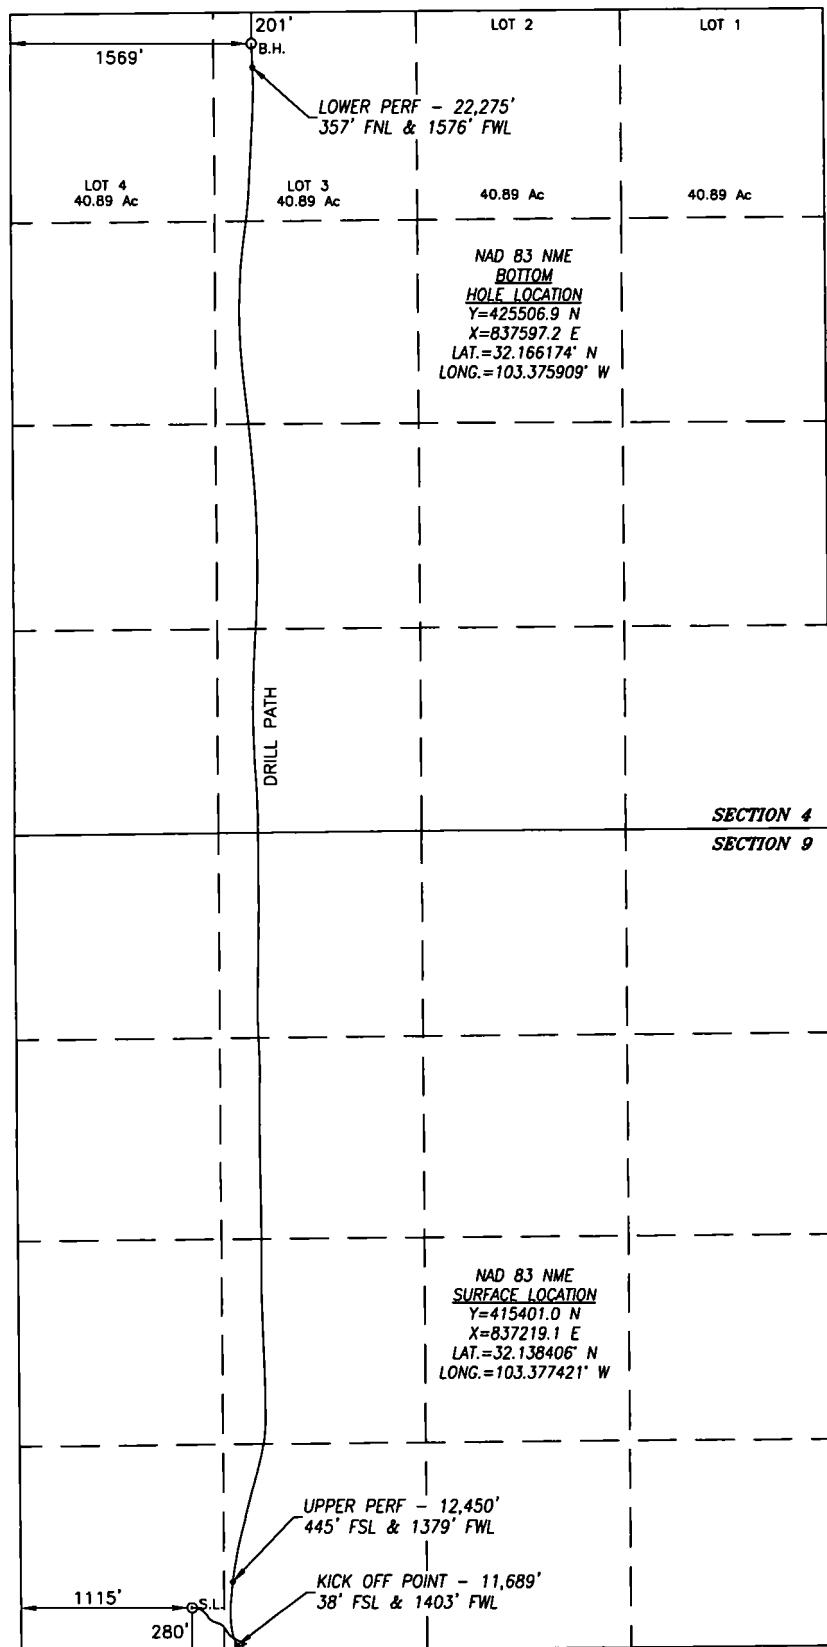

SURFACE INFO AND BOREPATH SHOWN HEREON IS BASED ON DIRECTIONAL SURVEY REPORT PROVIDED BY COG OPERATING, LLC FOR THE FEZ FEDERAL COM #702H SUPPLIED TO HARCROW SURVEYING, LLC ON NOVEMBER 18, 2019

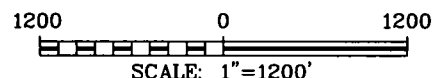

OPERATOR CERTIFICATION

I hereby certify that the information herein is true and complete to the best of my knowledge and belief, and that this organization either owns a working interest or unleased mineral interest in the land including the proposed bottom hole location or has a right to drill this well at this location pursuant to a contract with an owner of such mineral or working interest, or to a voluntary pooling agreement or a compulsory pooling order heretofore entered by the division.

Amanda Avery 12/3/19
Signature Date

Amanda Avery

Printed Name

aavery@concho.com

E-mail Address

SURVEYOR CERTIFICATION

I hereby certify that the well location shown on this plat was plotted from field notes of actual surveys made by me or under my supervision, and that the same is true and correct to the best of my belief.

DEC. 2, 2017/APR. 1, 2019

Date of Survey/Date of Geographic Survey

Signature & Seal of Professional Surveyor



Chad Harcrow 11/26/19
Certificate No. CHAD HARCROW 17777

HOBBS OCD

JAN 15 2020

Intent ☐ As Drilled ☒**RECEIVED**

API # 30-025-45278		Operator Name: COG OPERATING, LLC		Property Name: FEZ FEDERAL COM		Well Number 702H	
-----------------------	--	--------------------------------------	--	-----------------------------------	--	---------------------	--

Kick Off Point (KOP)

UL N	Section 9	Township 25S	Range 35E	Lot	Feet 38	From N/S SOUTH	Feet 1403	From E/W WEST	County LEA
Latitude 32.137742					Longitude -103.376491				NAD 83

First Take Point (FTP)

UL N	Section 9	Township 25S	Range 35E	Lot	Feet 445	From N/S SOUTH	Feet 1379	From E/W WEST	County LEA
Latitude 32.138859					Longitude -103.376566				NAD 83

Last Take Point (LTP)

UL 3	Section 4	Township 25S	Range 35E	Lot	Feet 357	From N/S NORTH	Feet 1576	From E/W WEST	County LEA
Latitude 32.165746					Longitude -103.375889				NAD 83

Is this well the defining well for the Horizontal Spacing Unit?

☐ No

Is this well an infill well?

☐ Yes

If infill is yes please provide API if available, Operator Name and well number for Defining well for Horizontal Spacing Unit.

API # 30-025-45275		Operator Name: COG Operating LLC		Property Name: Fez Federal Com		Well Number 602H	
-----------------------	--	-------------------------------------	--	-----------------------------------	--	---------------------	--

KZ 06/29/2018