

I. REQUEST FOR ALLOWABLE MINERAL AUTHORIZATION TO TRANSPORT

¹ Operator name and Address EOG RESOURCES INC PO BOX 2267 MIDLAND, TEXAS 79702		² OGRID Number 7377	
		³ Reason for Filing Code/ Effective Date NW 12/09/2021	
⁴ API Number 30 - 025-47608	⁵ Pool Name WC025 G09 S253309P;UPPER WOLFCAMP		⁶ Pool Code 98180
⁷ Property Code 329310	⁸ Property Name RESOLUTE 12 FEDERAL COM		⁹ Well Number 704H

II. ¹⁰ Surface Location

Ul or lot no. N	Section 12	Township 25S	Range 32E	Lot Idn	Feet from the 431'	North/South Line SOUTH	Feet from the 2196'	East/West line WEST	County LEA
--------------------	---------------	-----------------	--------------	---------	-----------------------	---------------------------	------------------------	------------------------	---------------

¹¹ Bottom Hole Location

UL or lot no. B	Section 1	Township 25S	Range 32E	Lot Idn	Feet from the 112'	North/South line NORTH	Feet from the 2058'	East/West line EAST	County LEA
¹² Lse Code	¹³ Producing Method Code FLOWING	¹⁴ Gas Connection Date	¹⁵ C-129 Permit Number		¹⁶ C-129 Effective Date		¹⁷ C-129 Expiration Date		

III. Oil and Gas Transporters

¹⁸ Transporter OGRID	¹⁹ Transporter Name and Address	²⁰ O/G/W
372812	EOGRM	OIL
151618	ENTERPRISE FIELD SERVICES	GAS
298751	REGENCY FIELD SERVICES	GAS
36785	DCP MIDSTREAM	GAS

IV. Well Completion Data

²¹ Spud Date 06/17/2021	²² Ready Date 12/09/2021	²³ TD 22,668'	²⁴ PBTD 22,636'	²⁵ Perforations 12,607 - 22,636	²⁶ DHC, MC
²⁷ Hole Size		²⁸ Casing & Tubing Size		²⁹ Depth Set	
12 1/4"		9 5/8"		1079'	
8 3/4"		7 5/8"		11,604'	
6 3/4"		5 1/2"		22,645'	
				1130 SXS CL H TOC 2800' CBL	

V. Well Test Data

³¹ Date New Oil 12/09/2021	³² Gas Delivery Date 12/09/2021	³³ Test Date 12/18/2021	³⁴ Test Length 24 HRS	³⁵ Tbg. Pressure	³⁶ Csg. Pressure 1447
³⁷ Choke Size 70	³⁸ Oil 4316	³⁹ Water 10848	⁴⁰ Gas 9251		⁴¹ Test Method
⁴² I hereby certify that the rules of the Oil Conservation Division have been complied with and that the information given above is true and complete to the best of my knowledge and belief. Signature: Kay Maddox			OIL CONSERVATION DIVISION		
Printed name: Kay Maddox			Approved by: Sarah McGrath		
Title: SENIOR REGULATORY SPECIALIST			Title: Petroleum Specialist - A		
E-mail Address: kay_maddox@eogresources.com			Approval Date: 08/25/2022		
Date: 12/22/2021		Phone: 432-638-8475	File 3160-4 Completion Report within 10 days to NMOCD after BLM approval.		

District I
1625 N. French Dr., Hobbs, NM 88240
Phone: (575) 393-6161 Fax: (575) 393-0720
District II
811 S. First St., Artesia, NM 88210
Phone: (575) 748-1283 Fax: (575) 748-9720
District III
1000 Rio Brazos Road, Aztec, NM 87410
Phone: (505) 334-6178 Fax: (505) 334-6170
District IV
1220 S. St. Francis Dr., Santa Fe, NM 87505
Phone: (505) 476-3460 Fax: (505) 476-3462

State of New Mexico
Energy, Minerals & Natural Resources
Department
OIL CONSERVATION DIVISION
1220 South St. Francis Dr.
Santa Fe, NM 87505

FORM C-102

Revised August 1, 2011

Submit one copy to appropriate

District Office

☐ AMENDED REPORT

AS-COMPLETED

WELL LOCATION AND ACREAGE DEDICATION PLAT

¹ API Number 30-025-47608	² Pool Code 98180	³ Pool Name WC025 G09 S253309P; UPPER WOLFCAMP
⁴ Property Code 329310	⁵ Property Name RESOLUTE 12 FED COM	⁶ Well Number 704H
⁷ OGRID No. 7377	⁸ Operator Name EOG RESOURCES, INC.	⁹ Elevation 3501'

¹⁰Surface Location


UL or lot no.	Section	Township	Range	Lot Idn	Feet from the	North/South line	Feet from the	East/West line	County
N	12	25-S	32-E	-	431'	SOUTH	2196'	WEST	LEA


¹¹Bottom Hole Location If Different From Surface

UL or lot no.	Section	Township	Range	Lot Idn	Feet from the	North/South line	Feet from the	East/West line	County
2	1	25-S	32-E	-	112'	NORTH	2058'	EAST	LEA

¹² Dedicated Acres 640.21	¹³ Joint or Infill	¹⁴ Consolidation Code	¹⁵ Order No.
--	-------------------------------	----------------------------------	-------------------------

No allowable will be assigned to this completion until all interests have been consolidated or a non-standard unit has been approved by the division.

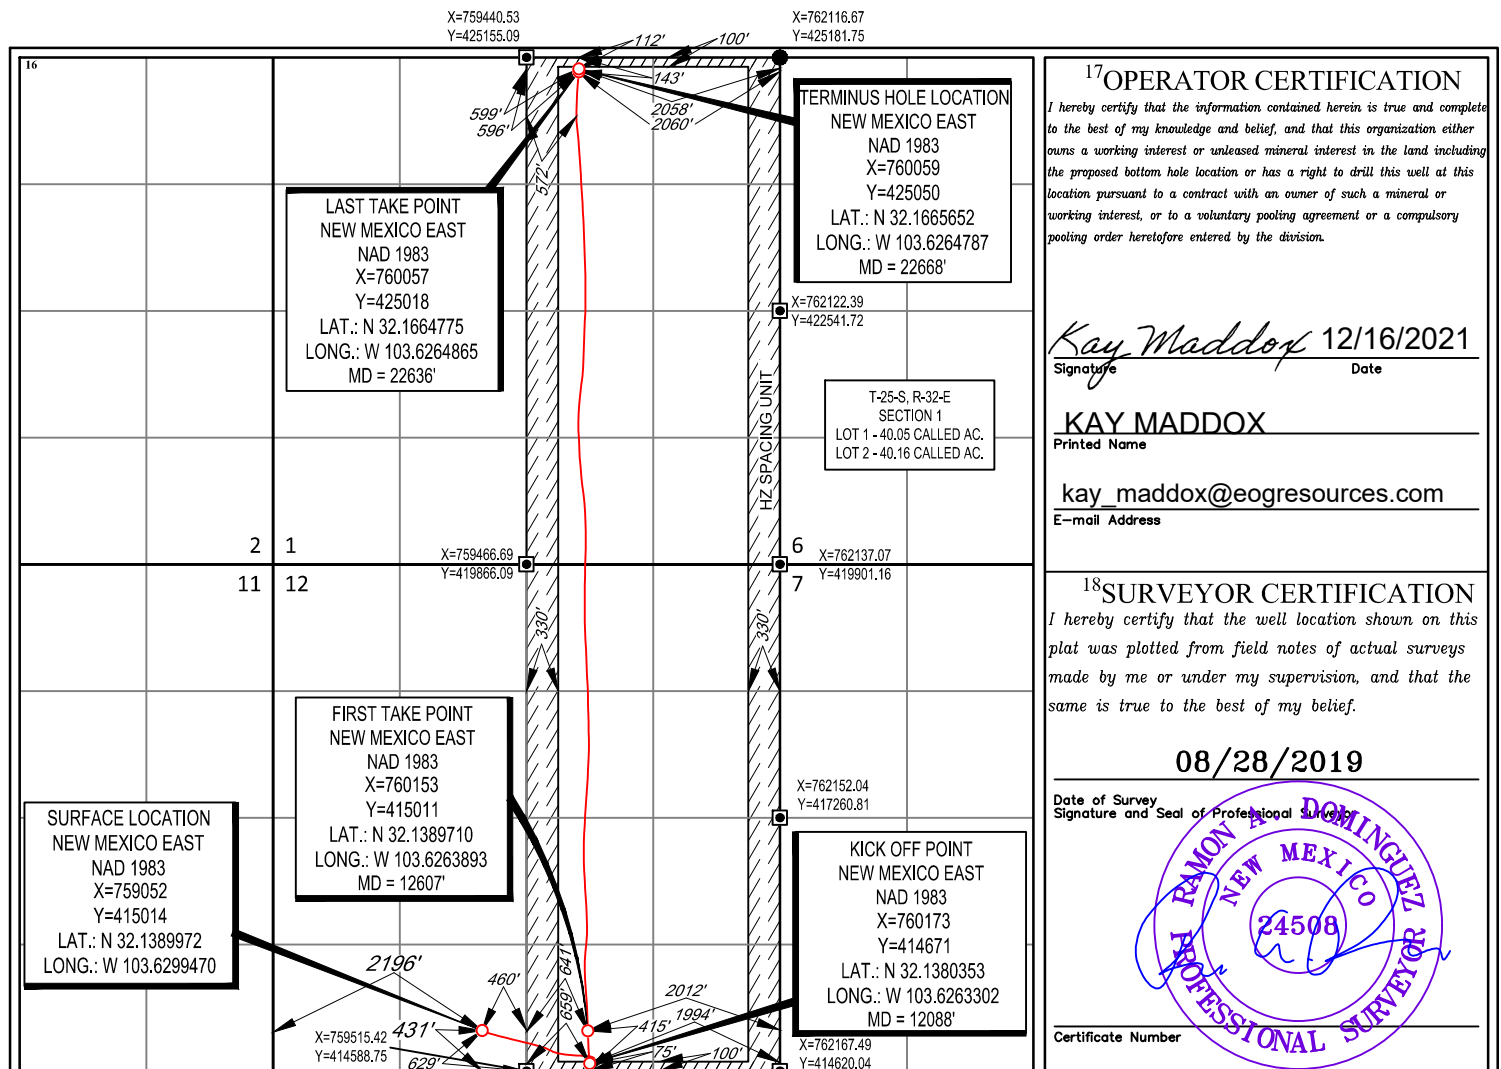


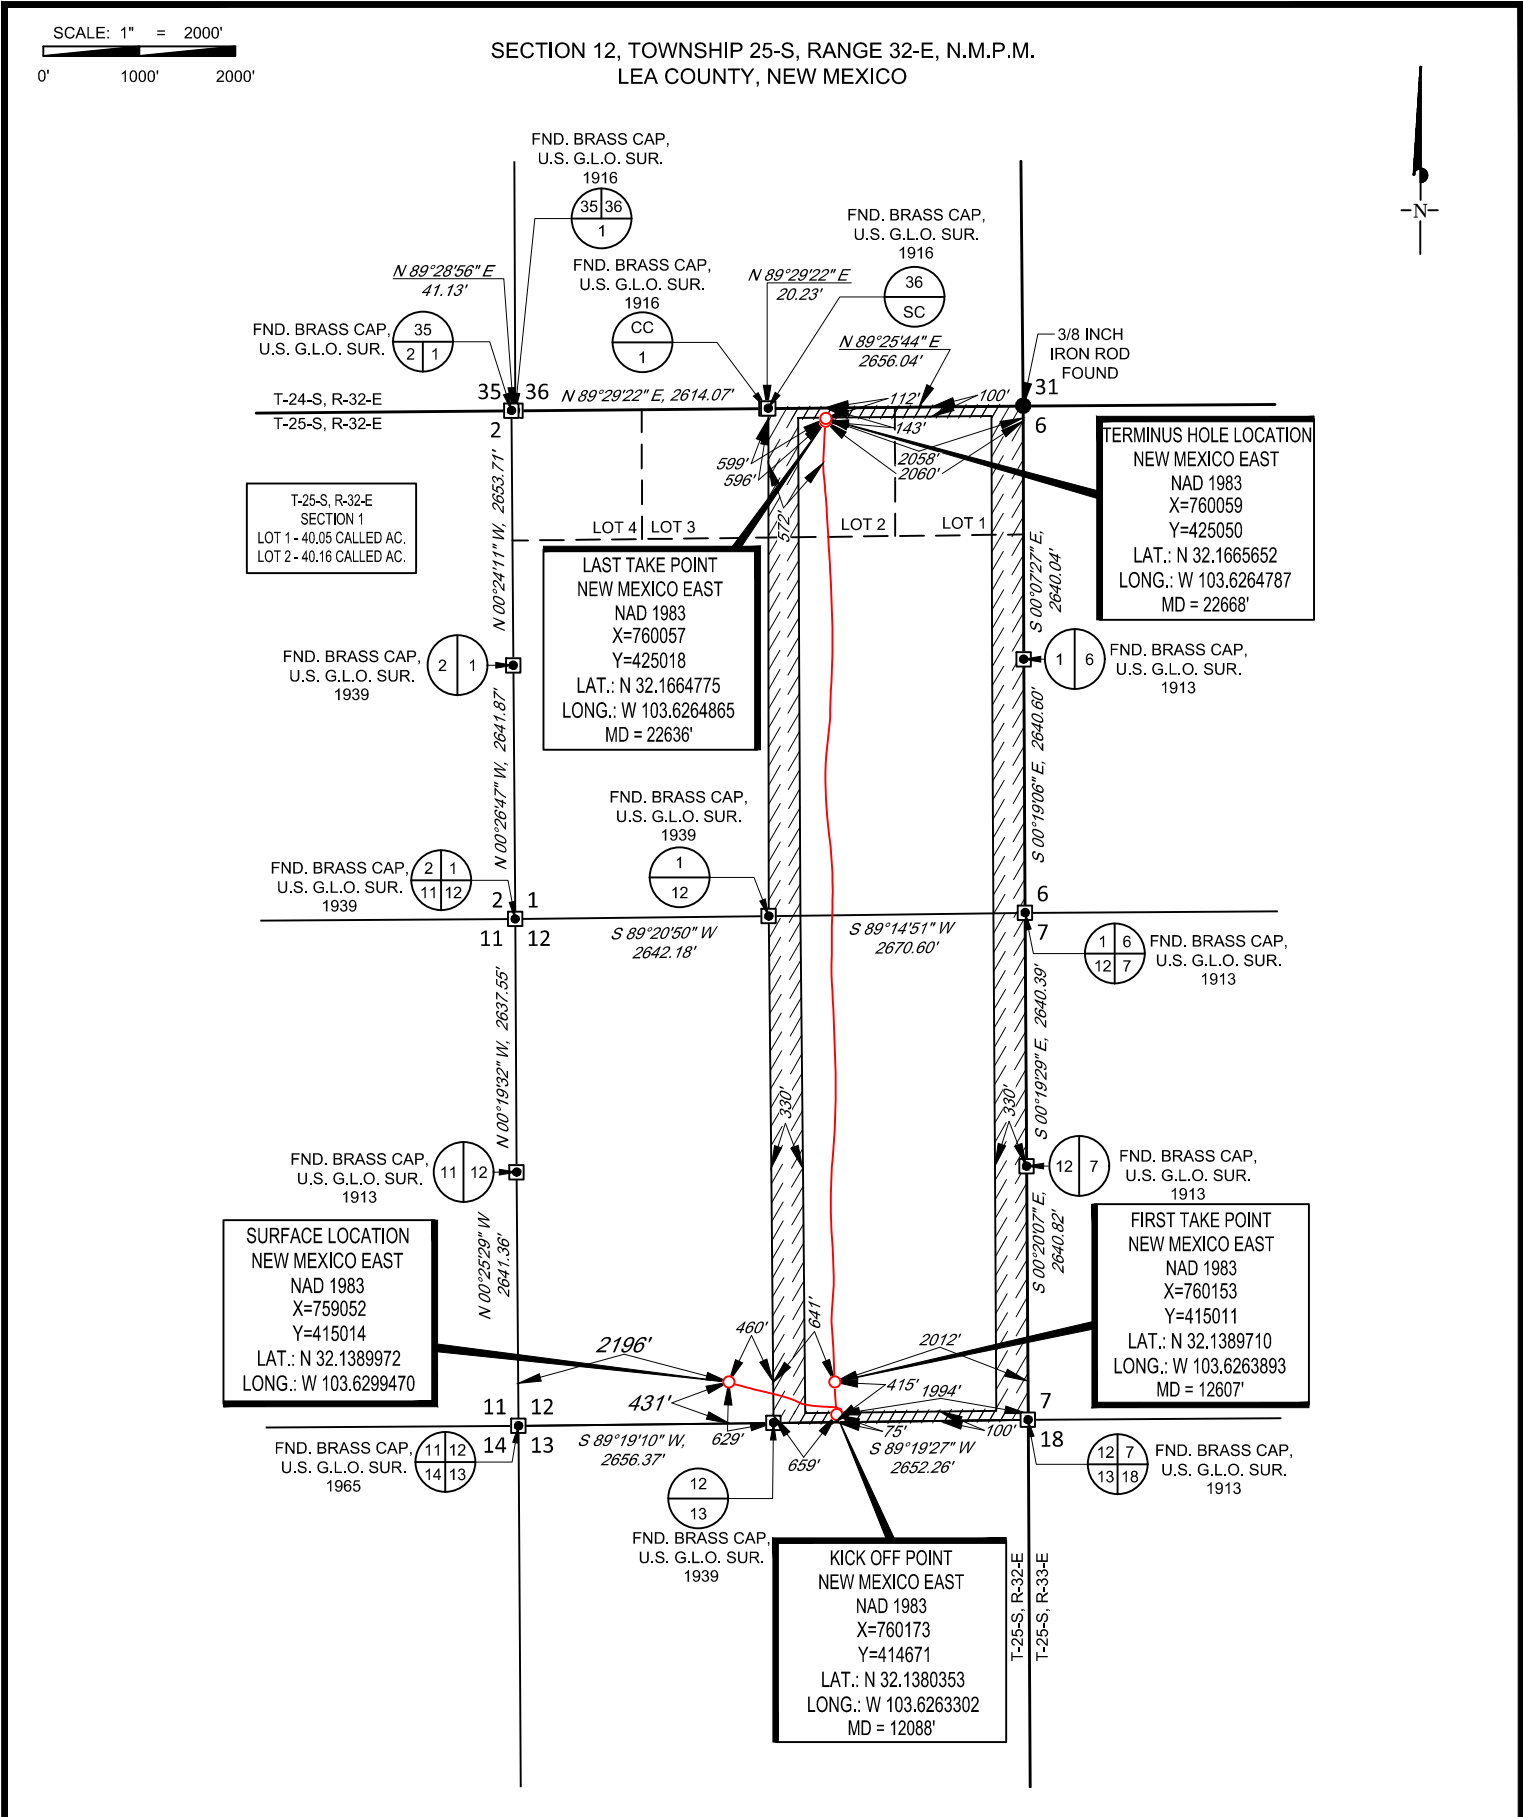

LEASE NAME & WELL NO.: RESOLUTE 12 FED COM 704H
SECTION 12 TWP 25-S RGE 32-E SURVEY N.M.P.M.
COUNTY LEA STATE NM ELEVATION 3501'
DESCRIPTION 431' FSL & 2196' FWL



1400 EVERMAN PARKWAY, Ste. 146 • FT. WORTH, TEXAS 76140
TELEPHONE: (817) 744-7512 • FAX (817) 744-7554
TEXAS FIRM REGISTRATION NO. 10042504
WWW.TOPOGRAPHIC.COM

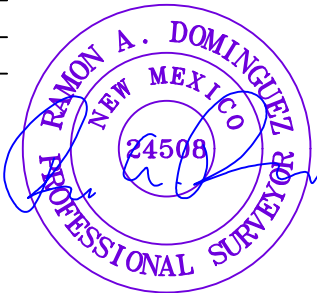

Ramon A. Dominguez, P.S. No. 24508
November 11, 2021



RESOLUTE 12 FED COM 704H AS-DRILLED	REVISION:		NOTES: 1. ORIGINAL DOCUMENT SIZE: 8.5" X 14" 2. ALL BEARINGS, DISTANCES, AND COORDINATE VALUES CONTAINED HEREIN ARE GRID BASED UPON THE NEW MEXICO COORDINATE SYSTEM OF 1983, EAST ZONE, U.S. SURVEY FEET. 3. THIS WELL LOCATION SHOWN HEREON HAS BEEN SURVEYED ON THE GROUND UNDER MY SUPERVISION AND PREPARED ACCORDING TO THE EVIDENCE FOUND AT THE TIME OF SURVEY, AND DATA PROVIDED BY EOG RESOURCES, INC. THIS CERTIFICATION IS MADE AND LIMITED TO THOSE PERSONS OR ENTITIES SHOWN ON THE FACE OF THIS PLAT AND IS NON-TRANSFERABLE. THIS SURVEY IS CERTIFIED FOR THIS TRANSACTION ONLY. 4. ADJOINER INFORMATION SHOWN FOR INFORMATIONAL PURPOSES ONLY.
DATE:	11/11/2021		
FILE:AD_RESOLUTE_12_FED_COM_704H			
DRAWN BY:	IMU		
SHEET :	2 OF 2		



Midland

Lea County, NM (NAD 83 NME)

Resolute 12 Fed Com

#704H

OH

Design: OH

Final PVA

21 July, 2021



Final PVA

Company: Midland Project: Lea County, NM (NAD 83 NME) Site: Resolute 12 Fed Com Well: #704H Wellbore: OH Design: OH		Local Co-ordinate Reference: Well #704H TVD Reference: KB = 32' @ 3533.0usft MD Reference: KB = 32' @ 3533.0usft North Reference: Grid Survey Calculation Method: Minimum Curvature Database: PEDM	
--	--	---	--

Project Lea County, NM (NAD 83 NME)			
Map System:	US State Plane 1983	System Datum:	Mean Sea Level
Geo Datum:	North American Datum 1983		
Map Zone:	New Mexico Eastern Zone		

Site Resolute 12 Fed Com			
Site Position:		Northing:	414,863.00 usft
From: Map		Easting:	761,539.00 usft
Position Uncertainty:	0.0 usft	Slot Radius:	13-3/16 "
		Latitude:	32° 8' 18.736 N
		Longitude:	103° 37' 18.893 W
		Grid Convergence:	0.38 °

Well #704H			
Well Position	+N/-S	0.0 usft	Northing:
	+E/-W	0.0 usft	Easting:
Position Uncertainty	0.0 usft		Wellhead Elevation:
			usft
			Latitude:
			32° 8' 20.392 N
			Longitude:
			103° 37' 47.806 W
			Ground Level:
			3,501.0 usft

Wellbore OH					
Magnetics	Model Name	Sample Date	Declination (°)	Dip Angle (°)	Field Strength (nT)
	IGRF2020	6/29/2021	6.56	59.81	47,433.29720332

Design OH					
Audit Notes:					
Version:	1.0	Phase:	ACTUAL	Tie On Depth:	0.0
Vertical Section:	Depth From (TVD) (usft)	+N/-S (usft)	+E/-W (usft)	Direction (°)	
	0.0	0.0	0.0	5.94	

Survey Program Date 7/21/2021					
From (usft)	To (usft)	Survey (Wellbore)	Tool Name	Description	
200.0	22,668.0	Driltech MWD (OH)	EOG MWD+IFR1	MWD + IFR1	

Company:	Midland	Local Co-ordinate Reference:	Well #704H
Project:	Lea County, NM (NAD 83 NME)	TVD Reference:	KB = 32' @ 3533.0usft
Site:	Resolute 12 Fed Com	MD Reference:	KB = 32' @ 3533.0usft
Well:	#704H	North Reference:	Grid
Wellbore:	OH	Survey Calculation Method:	Minimum Curvature
Design:	OH	Database:	PEDM

Survey											
MD (usft)	Inc (°)	Azi (azimuth) (°)	TVD (usft)	N/S (usft)	E/W (usft)	DLeg (°/100usft)	Build (°/100usft)	Turn (°/100usft)	High to Plan (usft)	Right to Plan (usft)	
0.0	0.00	0.00	0.0	0.0	0.0	0.00	0.00	0.00	0.0	0.0	
200.0	0.09	61.36	200.0	0.1	0.1	0.04	0.04	0.00	-0.2	0.0	
314.0	0.26	35.96	314.0	0.3	0.4	0.16	0.15	-22.28	-0.5	-0.1	
504.0	0.26	71.46	504.0	0.8	1.0	0.08	0.00	18.68	-1.2	0.4	
694.0	0.70	332.67	694.0	2.0	0.9	0.41	0.23	-51.99	-1.3	-1.7	
884.0	1.32	312.37	884.0	4.5	-1.2	0.37	0.33	-10.68	-3.9	-2.5	
979.0	0.70	141.07	979.0	4.8	-1.7	2.12	-0.65	-180.32	4.8	1.7	
1,030.0	1.41	133.16	1,029.9	4.1	-1.0	1.42	1.39	-15.51	3.6	2.3	
1,163.0	2.81	150.30	1,162.9	0.2	1.8	1.14	1.05	12.89	-0.7	1.6	
1,354.0	7.74	109.08	1,353.0	-8.1	16.3	3.10	2.58	-21.58	-13.9	-2.4	
1,544.0	12.49	105.48	1,540.0	-17.8	48.2	2.52	2.50	-1.89	-30.7	-3.2	
1,734.0	13.10	104.60	1,725.3	-28.7	88.8	0.34	0.32	-0.46	-44.0	-1.9	
1,924.0	13.37	106.79	1,910.3	-40.5	130.7	0.30	0.14	1.15	-49.8	1.7	
2,114.0	13.72	103.98	2,095.0	-52.3	173.6	0.39	0.18	-1.48	-56.4	1.3	
2,304.0	13.63	105.12	2,279.6	-63.6	217.1	0.15	-0.05	0.60	-63.3	5.2	
2,494.0	13.81	103.19	2,464.2	-74.6	260.7	0.26	0.09	-1.02	-70.6	5.9	
2,684.0	14.07	103.19	2,648.6	-85.0	305.3	0.14	0.14	0.00	-78.6	9.5	
2,875.0	13.81	103.81	2,834.0	-95.8	350.0	0.16	-0.14	0.32	-86.4	13.8	
3,064.0	13.89	102.75	3,017.5	-106.1	394.1	0.14	0.04	-0.56	-94.3	15.6	
3,160.0	13.81	103.72	3,110.7	-111.4	416.4	0.26	-0.08	1.01	-97.9	19.0	
3,350.0	13.72	103.45	3,295.2	-122.0	460.4	0.06	-0.05	-0.14	-105.3	21.9	
3,540.0	12.49	105.65	3,480.3	-132.8	502.1	0.70	-0.65	1.16	-109.5	28.6	
3,730.0	11.17	105.39	3,666.2	-143.2	539.6	0.70	-0.69	-0.14	-110.4	30.2	
3,920.0	10.73	105.04	3,852.8	-152.7	574.4	0.23	-0.23	-0.18	-108.6	31.7	
4,111.0	9.58	106.18	4,040.8	-161.8	606.9	0.61	-0.60	0.60	-103.1	35.8	
4,301.0	9.32	108.20	4,228.2	-171.0	636.7	0.22	-0.14	1.06	-94.7	40.2	
4,491.0	8.53	111.63	4,415.9	-181.0	664.4	0.50	-0.42	1.81	-83.4	44.6	

Company:	Midland	Local Co-ordinate Reference:	Well #704H
Project:	Lea County, NM (NAD 83 NME)	TVD Reference:	KB = 32' @ 3533.0usft
Site:	Resolute 12 Fed Com	MD Reference:	KB = 32' @ 3533.0usft
Well:	#704H	North Reference:	Grid
Wellbore:	OH	Survey Calculation Method:	Minimum Curvature
Design:	OH	Database:	PEDM

Survey										
MD (usft)	Inc (°)	Azi (azimuth) (°)	TVD (usft)	N/S (usft)	E/W (usft)	DLeg (°/100usft)	Build (°/100usft)	Turn (°/100usft)	High to Plan (usft)	Right to Plan (usft)
4,681.0	8.79	114.79	4,603.7	-192.2	690.7	0.29	0.14	1.66	-71.3	45.7
4,871.0	8.00	115.58	4,791.7	-204.0	715.8	0.42	-0.42	0.42	-60.4	42.2
5,061.0	6.68	116.73	4,980.1	-214.7	737.6	0.70	-0.69	0.61	-45.8	38.3
5,251.0	7.47	112.77	5,168.7	-224.5	758.8	0.49	0.42	-2.08	-33.4	31.5
5,442.0	11.96	100.99	5,356.9	-233.1	789.7	2.56	2.35	-6.17	-32.9	26.6
5,632.0	11.87	99.05	5,542.8	-239.9	828.4	0.22	-0.05	-1.02	-35.3	31.2
5,822.0	12.66	97.29	5,728.5	-245.6	868.3	0.46	0.42	-0.93	-39.2	37.0
6,012.0	11.96	95.71	5,914.1	-250.2	908.5	0.41	-0.37	-0.83	-43.5	43.8
6,202.0	11.78	93.60	6,100.1	-253.4	947.5	0.25	-0.09	-1.11	-47.2	51.4
6,392.0	11.70	92.81	6,286.1	-255.5	986.1	0.09	-0.04	-0.42	-49.8	60.8
6,582.0	11.78	92.10	6,472.1	-257.2	1,024.7	0.09	0.04	-0.37	-52.6	70.8
6,678.0	11.52	92.81	6,566.1	-258.0	1,044.1	0.31	-0.27	0.74	-52.5	76.8
6,868.0	10.82	92.98	6,752.5	-259.9	1,080.8	0.37	-0.37	0.09	-52.3	87.2
7,058.0	9.94	100.01	6,939.4	-263.7	1,114.8	0.81	-0.46	3.70	-39.8	100.5
7,248.0	7.83	109.51	7,127.1	-270.8	1,143.2	1.35	-1.11	5.00	-27.1	107.9
7,438.0	5.45	126.82	7,315.9	-280.6	1,162.6	1.62	-1.25	9.11	-3.3	111.0
7,628.0	0.97	186.94	7,505.6	-287.6	1,169.6	2.65	-2.36	31.64	88.9	64.4
7,818.0	1.41	163.65	7,695.5	-291.4	1,170.1	0.34	0.23	-12.26	52.3	93.6
8,008.0	1.23	165.93	7,885.5	-295.6	1,171.2	0.10	-0.09	1.20	51.7	91.5
8,198.0	1.41	170.85	8,075.4	-299.9	1,172.1	0.11	0.09	2.59	54.9	87.0
8,388.0	1.32	186.59	8,265.4	-304.4	1,172.2	0.20	-0.05	8.28	72.0	69.4
8,578.0	1.58	190.01	8,455.3	-309.2	1,171.5	0.14	0.14	1.80	71.2	65.1
8,768.0	1.58	199.77	8,645.2	-314.2	1,170.2	0.14	0.00	5.14	76.1	52.6
8,958.0	1.32	199.77	8,835.2	-318.7	1,168.5	0.14	-0.14	0.00	71.2	52.6
9,148.0	0.88	214.36	9,025.1	-322.0	1,167.0	0.27	-0.23	7.68	78.6	33.5
9,338.0	0.88	255.32	9,215.1	-323.6	1,164.7	0.32	0.00	21.56	78.7	-25.3
9,528.0	1.58	254.00	9,405.1	-324.6	1,160.8	0.37	0.37	-0.69	75.2	-23.5

Company:	Midland	Local Co-ordinate Reference:	Well #704H
Project:	Lea County, NM (NAD 83 NME)	TVD Reference:	KB = 32' @ 3533.0usft
Site:	Resolute 12 Fed Com	MD Reference:	KB = 32' @ 3533.0usft
Well:	#704H	North Reference:	Grid
Wellbore:	OH	Survey Calculation Method:	Minimum Curvature
Design:	OH	Database:	PEDM

Survey										
MD (usft)	Inc (°)	Azi (azimuth) (°)	TVD (usft)	N/S (usft)	E/W (usft)	DLeg (°/100usft)	Build (°/100usft)	Turn (°/100usft)	High to Plan (usft)	Right to Plan (usft)
9,718.0	1.58	278.00	9,595.0	-325.0	1,155.7	0.35	0.00	12.63	54.1	-51.0
9,909.0	1.76	308.23	9,785.9	-322.8	1,150.8	0.46	0.09	15.83	15.9	-70.0
10,099.0	1.41	262.97	9,975.8	-321.3	1,146.2	0.66	-0.18	-23.82	56.5	-40.1
10,289.0	1.58	258.22	10,165.8	-322.1	1,141.3	0.11	0.09	-2.50	54.7	-35.5
10,480.0	1.41	263.49	10,356.7	-322.9	1,136.4	0.11	-0.09	2.76	46.2	-40.1
10,670.0	0.88	273.51	10,546.7	-323.1	1,132.6	0.30	-0.28	5.27	34.8	-47.1
10,860.0	1.06	213.91	10,736.7	-324.5	1,130.2	0.51	0.09	-31.37	55.7	4.9
11,050.0	1.06	171.20	10,926.6	-327.7	1,129.5	0.41	0.00	-22.48	34.6	40.2
11,240.0	1.06	191.15	11,116.6	-331.1	1,129.4	0.19	0.00	10.50	42.8	26.6
11,430.0	2.02	187.81	11,306.5	-336.2	1,128.6	0.51	0.51	-1.76	36.1	29.0
11,631.0	1.76	178.49	11,507.4	-342.8	1,128.2	0.20	-0.13	-4.64	24.3	33.9
11,726.0	0.88	163.73	11,602.4	-344.9	1,128.4	0.99	-0.93	-15.54	12.8	38.6
11,822.0	1.23	352.69	11,698.4	-344.6	1,128.5	2.19	0.36	-178.17	-18.9	-36.2
11,917.0	0.88	276.05	11,793.4	-343.5	1,127.7	1.41	-0.37	-80.67	29.9	-27.8
12,012.0	2.55	251.79	11,888.3	-344.1	1,124.9	1.88	1.76	-25.54	35.6	-12.5
12,088.0	3.78	323.25	11,964.2	-342.6	1,121.8	5.04	1.62	94.02	5.3	-29.7
KOP, MD:12088.0', TVD:11964.2', N/S:-342.6', E/W:1121.8', INC:3.78										
12,105.0	4.48	330.19	11,981.2	-341.6	1,121.1	5.04	4.10	40.84	4.0	-28.0
12,200.0	18.38	0.34	12,074.1	-323.3	1,119.4	15.45	14.63	31.74	5.0	-24.7
12,216.8	22.02	358.10	12,089.9	-317.5	1,119.3	22.12	21.64	-13.33	7.9	-24.3
FTP Crossing, MD:12216.8', TVD:12089.9', N/S:-317.5', E/W:1119.3', INC:22.02										
12,295.0	39.13	352.96	12,157.0	-278.1	1,115.8	22.12	21.89	-6.57	12.5	-20.1
12,390.0	63.49	355.94	12,215.9	-204.8	1,109.0	25.75	25.64	3.14	-2.4	-14.9
12,485.0	66.48	358.67	12,256.1	-118.8	1,104.9	4.08	3.15	2.87	-20.6	-11.4
12,580.0	70.70	358.23	12,290.8	-30.4	1,102.6	4.46	4.44	-0.46	-24.9	-9.4
12,675.0	86.17	356.65	12,309.8	62.3	1,098.4	16.36	16.28	-1.66	-25.7	-5.6
12,770.0	87.32	359.37	12,315.2	157.0	1,095.1	3.10	1.21	2.86	-22.9	-2.6

Company:	Midland	Local Co-ordinate Reference:	Well #704H
Project:	Lea County, NM (NAD 83 NME)	TVD Reference:	KB = 32' @ 3533.0usft
Site:	Resolute 12 Fed Com	MD Reference:	KB = 32' @ 3533.0usft
Well:	#704H	North Reference:	Grid
Wellbore:	OH	Survey Calculation Method:	Minimum Curvature
Design:	OH	Database:	PEDM

Survey										
MD (usft)	Inc (°)	Azi (azimuth) (°)	TVD (usft)	N/S (usft)	E/W (usft)	DLeg (°/100usft)	Build (°/100usft)	Turn (°/100usft)	High to Plan (usft)	Right to Plan (usft)
12,865.0	87.58	356.91	12,319.4	251.9	1,092.0	2.60	0.27	-2.59	-18.7	0.0
12,960.0	88.72	356.21	12,322.5	346.7	1,086.3	1.41	1.20	-0.74	-15.8	5.3
13,055.0	88.55	356.30	12,324.7	441.4	1,080.1	0.20	-0.18	0.09	-13.6	11.0
13,150.0	88.81	355.68	12,326.9	536.2	1,073.5	0.71	0.27	-0.65	-11.5	17.2
13,245.0	89.60	357.70	12,328.2	631.0	1,068.0	2.28	0.83	2.13	-10.3	22.2
13,340.0	91.01	3.77	12,327.7	725.9	1,069.2	6.56	1.48	6.39	-10.9	20.5
13,435.0	92.68	4.82	12,324.7	820.6	1,076.3	2.08	1.76	1.11	-14.1	12.9
13,530.0	88.99	5.17	12,323.3	915.2	1,084.6	3.90	-3.88	0.37	-15.5	4.2
13,625.0	90.22	3.42	12,323.9	1,010.0	1,091.7	2.25	1.29	-1.84	-15.0	-3.3
13,720.0	90.75	356.56	12,323.1	1,104.9	1,091.7	7.24	0.56	-7.22	-15.9	-3.7
13,814.0	89.34	359.11	12,323.1	1,198.8	1,088.1	3.10	-1.50	2.71	-16.1	-0.6
13,909.0	86.70	357.44	12,326.3	1,293.7	1,085.3	3.29	-2.78	-1.76	-12.9	1.8
14,004.0	87.05	355.51	12,331.5	1,388.4	1,079.4	2.06	0.37	-2.03	-7.8	7.1
14,099.0	90.40	356.74	12,333.6	1,483.1	1,073.0	3.76	3.53	1.29	-5.8	13.1
14,194.0	91.80	357.97	12,331.8	1,578.0	1,068.6	1.96	1.47	1.29	-7.7	17.0
14,289.0	90.66	355.86	12,329.8	1,672.8	1,063.5	2.52	-1.20	-2.22	-9.9	21.7
14,384.0	89.60	0.87	12,329.5	1,767.8	1,060.8	5.39	-1.12	5.27	-10.2	23.9
14,479.0	88.64	358.58	12,331.0	1,862.7	1,060.4	2.61	-1.01	-2.41	-8.8	23.9
14,574.0	87.85	0.25	12,333.9	1,957.7	1,059.4	1.94	-0.83	1.76	-6.0	24.4
14,669.0	91.01	4.65	12,334.9	2,052.6	1,063.4	5.70	3.33	4.63	-5.2	19.9
14,764.0	92.15	1.13	12,332.2	2,147.4	1,068.2	3.89	1.20	-3.71	-7.9	14.7
14,859.0	92.15	3.24	12,328.7	2,242.3	1,071.8	2.22	0.00	2.22	-11.6	10.6
14,954.0	88.20	5.79	12,328.4	2,336.9	1,079.3	4.95	-4.16	2.68	-11.9	2.7
15,049.0	84.68	3.77	12,334.3	2,431.4	1,087.2	4.27	-3.71	-2.13	-6.1	-5.7
15,144.0	87.49	4.47	12,340.8	2,525.9	1,094.0	3.05	2.96	0.74	0.2	-12.9
15,239.0	88.72	2.45	12,343.9	2,620.7	1,099.8	2.49	1.29	-2.13	3.3	-19.1
15,333.0	90.40	1.39	12,344.6	2,714.6	1,102.9	2.11	1.79	-1.13	3.9	-22.7

Company:	Midland	Local Co-ordinate Reference:	Well #704H
Project:	Lea County, NM (NAD 83 NME)	TVD Reference:	KB = 32' @ 3533.0usft
Site:	Resolute 12 Fed Com	MD Reference:	KB = 32' @ 3533.0usft
Well:	#704H	North Reference:	Grid
Wellbore:	OH	Survey Calculation Method:	Minimum Curvature
Design:	OH	Database:	PEDM

Survey											
MD (usft)	Inc (°)	Azi (azimuth) (°)	TVD (usft)	N/S (usft)	E/W (usft)	DLeg (°/100usft)	Build (°/100usft)	Turn (°/100usft)	High to Plan (usft)	Right to Plan (usft)	
15,457.0	90.09	3.15	12,344.1	2,838.5	1,107.8	1.44	-0.25	1.42	3.3	-28.2	
15,552.0	87.19	0.87	12,346.4	2,933.4	1,111.2	3.88	-3.05	-2.40	5.4	-32.0	
15,647.0	86.92	359.72	12,351.2	3,028.3	1,111.6	1.24	-0.28	-1.21	10.2	-33.0	
15,741.0	87.54	359.02	12,355.8	3,122.2	1,110.6	0.99	0.66	-0.74	14.6	-32.4	
15,836.0	88.68	358.93	12,358.9	3,217.1	1,108.9	1.20	1.20	-0.09	17.7	-31.1	
15,931.0	88.33	358.41	12,361.4	3,312.1	1,106.7	0.66	-0.37	-0.55	20.1	-29.4	
16,026.0	88.51	358.14	12,364.0	3,407.0	1,103.9	0.34	0.19	-0.28	22.6	-27.0	
16,121.0	92.02	358.41	12,363.6	3,501.9	1,101.0	3.71	3.69	0.28	22.0	-24.6	
16,216.0	90.35	357.61	12,361.6	3,596.8	1,097.7	1.95	-1.76	-0.84	20.0	-21.7	
16,311.0	89.91	357.61	12,361.4	3,691.7	1,093.7	0.46	-0.46	0.00	19.7	-18.2	
16,406.0	90.88	357.44	12,360.7	3,786.7	1,089.6	1.04	1.02	-0.18	18.9	-14.6	
16,501.0	92.02	358.05	12,358.3	3,881.6	1,085.9	1.36	1.20	0.64	16.4	-11.3	
16,596.0	89.65	357.53	12,357.0	3,976.5	1,082.2	2.55	-2.49	-0.55	14.9	-8.1	
16,692.0	85.17	356.47	12,361.3	4,072.2	1,077.2	4.80	-4.67	-1.10	19.1	-3.6	
16,786.0	87.01	357.09	12,367.7	4,165.8	1,072.0	2.07	1.96	0.66	25.4	1.3	
16,881.0	90.00	358.93	12,370.2	4,260.7	1,068.7	3.70	3.15	1.94	27.8	4.1	
16,976.0	91.85	0.43	12,368.6	4,355.7	1,068.1	2.51	1.95	1.58	26.2	4.2	
17,071.0	92.64	0.78	12,364.9	4,450.6	1,069.1	0.91	0.83	0.37	22.4	2.7	
17,166.0	89.30	0.52	12,363.3	4,545.6	1,070.2	3.53	-3.52	-0.27	20.7	1.2	
17,261.0	89.65	0.34	12,364.2	4,640.6	1,070.9	0.41	0.37	-0.19	21.4	0.0	
17,356.0	87.89	1.04	12,366.2	4,735.6	1,072.1	1.99	-1.85	0.74	23.4	-1.6	
17,451.0	87.98	1.13	12,369.6	4,830.5	1,073.9	0.13	0.09	0.09	26.7	-3.8	
17,546.0	87.71	1.83	12,373.2	4,925.4	1,076.3	0.79	-0.28	0.74	30.2	-6.7	
17,640.0	90.18	1.04	12,374.9	5,019.3	1,078.7	2.76	2.63	-0.84	31.8	-9.5	
17,735.0	87.36	0.08	12,377.0	5,114.3	1,079.6	3.14	-2.97	-1.01	33.7	-10.9	
17,834.0	84.73	358.76	12,383.8	5,213.0	1,078.6	2.97	-2.66	-1.33	40.4	-10.4	
17,929.0	92.72	357.79	12,385.9	5,307.9	1,075.7	8.47	8.41	-1.02	42.5	-8.0	

Company:	Midland	Local Co-ordinate Reference:	Well #704H
Project:	Lea County, NM (NAD 83 NME)	TVD Reference:	KB = 32' @ 3533.0usft
Site:	Resolute 12 Fed Com	MD Reference:	KB = 32' @ 3533.0usft
Well:	#704H	North Reference:	Grid
Wellbore:	OH	Survey Calculation Method:	Minimum Curvature
Design:	OH	Database:	PEDM

Survey										
MD (usft)	Inc (°)	Azi (azimuth) (°)	TVD (usft)	N/S (usft)	E/W (usft)	DLeg (°/100usft)	Build (°/100usft)	Turn (°/100usft)	High to Plan (usft)	Right to Plan (usft)
18,024.0	91.14	356.56	12,382.7	5,402.7	1,071.1	2.11	-1.66	-1.29	39.2	-3.8
18,119.0	89.65	356.03	12,382.1	5,497.5	1,064.9	1.66	-1.57	-0.56	38.4	1.9
18,214.0	87.80	352.78	12,384.2	5,592.0	1,055.7	3.94	-1.95	-3.42	40.4	10.7
18,309.0	88.86	352.61	12,387.0	5,686.2	1,043.6	1.13	1.12	-0.18	43.2	22.2
18,404.0	91.41	354.63	12,386.7	5,780.6	1,033.0	3.42	2.68	2.13	42.9	32.3
18,500.0	94.75	355.33	12,381.6	5,876.1	1,024.6	3.55	3.48	0.73	37.2	40.3
18,595.0	94.22	355.59	12,374.1	5,970.5	1,017.1	0.62	-0.56	0.27	29.0	47.3
18,689.0	95.19	358.32	12,366.4	6,064.0	1,012.2	3.07	1.03	2.90	20.2	51.9
18,785.0	90.88	356.82	12,361.4	6,159.8	1,008.1	4.75	-4.49	-1.56	14.2	55.5
18,880.0	91.41	358.05	12,359.5	6,254.7	1,003.9	1.41	0.56	1.29	11.4	59.3
18,975.0	91.14	1.39	12,357.3	6,349.6	1,003.4	3.53	-0.28	3.52	8.3	59.3
19,070.0	88.51	2.45	12,357.6	6,444.6	1,006.6	2.98	-2.77	1.12	7.8	55.7
19,165.0	91.14	5.52	12,357.9	6,539.3	1,013.2	4.26	2.77	3.23	7.0	48.6
19,260.0	88.07	6.14	12,358.6	6,633.8	1,022.8	3.30	-3.23	0.65	7.0	38.5
19,355.0	87.01	6.93	12,362.7	6,728.1	1,033.6	1.39	-1.12	0.83	10.2	27.2
19,450.0	89.74	7.46	12,365.3	6,822.3	1,045.5	2.93	2.87	0.56	11.9	14.9
19,545.0	86.48	1.04	12,368.5	6,916.9	1,052.6	7.58	-3.43	-6.76	14.1	7.4
19,640.0	87.28	1.13	12,373.7	7,011.8	1,054.3	0.85	0.84	0.09	18.6	5.2
19,736.0	90.88	2.98	12,375.2	7,107.7	1,057.8	4.22	3.75	1.93	19.4	1.3
19,831.0	89.30	2.36	12,375.0	7,202.6	1,062.2	1.79	-1.66	-0.65	18.6	-3.6
19,926.0	88.42	2.71	12,376.9	7,297.5	1,066.4	1.00	-0.93	0.37	19.8	-8.2
20,021.0	88.24	2.27	12,379.7	7,392.3	1,070.5	0.50	-0.19	-0.46	21.9	-12.8
20,116.0	89.30	3.33	12,381.7	7,487.2	1,075.2	1.58	1.12	1.12	23.2	-17.9
20,211.0	85.87	359.20	12,385.7	7,582.1	1,077.3	5.65	-3.61	-4.35	26.5	-20.5
20,306.0	87.01	0.34	12,391.6	7,676.9	1,076.9	1.70	1.20	1.20	31.8	-20.6
20,401.0	85.34	0.43	12,398.0	7,771.7	1,077.5	1.76	-1.76	0.09	37.4	-21.7
20,496.0	86.48	358.32	12,404.8	7,866.4	1,076.5	2.52	1.20	-2.22	43.5	-21.1

Company:	Midland	Local Co-ordinate Reference:	Well #704H
Project:	Lea County, NM (NAD 83 NME)	TVD Reference:	KB = 32' @ 3533.0usft
Site:	Resolute 12 Fed Com	MD Reference:	KB = 32' @ 3533.0usft
Well:	#704H	North Reference:	Grid
Wellbore:	OH	Survey Calculation Method:	Minimum Curvature
Design:	OH	Database:	PEDM

Survey										
MD (usft)	Inc (°)	Azi (azimuth) (°)	TVD (usft)	N/S (usft)	E/W (usft)	DLeg (°/100usft)	Build (°/100usft)	Turn (°/100usft)	High to Plan (usft)	Right to Plan (usft)
20,591.0	87.45	357.97	12,409.8	7,961.2	1,073.4	1.09	1.02	-0.37	47.9	-18.4
20,686.0	93.34	357.70	12,409.1	8,056.1	1,069.8	6.21	6.20	-0.28	46.5	-15.3
20,781.0	93.60	358.41	12,403.4	8,150.9	1,066.6	0.79	0.27	0.75	40.1	-12.6
20,876.0	92.29	358.41	12,398.5	8,245.7	1,064.0	1.38	-1.38	0.00	34.5	-10.4
20,971.0	89.03	356.38	12,397.4	8,340.6	1,059.7	4.04	-3.43	-2.14	32.7	-6.5
21,066.0	91.05	357.26	12,397.3	8,435.4	1,054.4	2.32	2.13	0.93	32.0	-1.7
21,162.0	89.91	357.70	12,396.5	8,531.3	1,050.2	1.27	-1.19	0.46	30.5	2.1
21,257.0	89.12	355.68	12,397.3	8,626.2	1,044.7	2.28	-0.83	-2.13	30.6	7.1
21,352.0	88.33	357.09	12,399.5	8,721.0	1,038.7	1.70	-0.83	1.48	32.0	12.6
21,447.0	88.95	357.18	12,401.7	8,815.8	1,034.0	0.66	0.65	0.09	33.6	16.9
21,542.0	87.36	355.59	12,404.8	8,910.6	1,028.0	2.37	-1.67	-1.67	35.9	22.5
21,637.0	87.80	356.82	12,408.8	9,005.3	1,021.7	1.37	0.46	1.29	39.3	28.3
21,732.0	89.03	356.12	12,411.4	9,100.1	1,015.8	1.49	1.29	-0.74	41.2	33.6
21,827.0	90.00	356.03	12,412.2	9,194.8	1,009.3	1.03	1.02	-0.09	41.4	39.7
21,922.0	90.97	354.63	12,411.4	9,289.5	1,001.6	1.79	1.02	-1.47	39.9	46.9
21,950.0	91.14	354.98	12,410.9	9,317.4	999.1	1.39	0.61	1.25	39.2	49.3
22,017.0	90.97	354.10	12,409.7	9,384.1	992.7	1.34	-0.25	-1.31	37.6	55.3
22,112.0	95.71	355.77	12,404.1	9,478.5	984.3	5.29	4.99	1.76	31.4	63.2
22,207.0	95.63	0.95	12,394.7	9,573.0	981.6	5.43	-0.08	5.45	20.9	65.7
22,397.0	91.05	3.59	12,383.7	9,762.4	989.1	2.78	-2.41	1.39	8.6	57.2
22,492.0	89.47	3.94	12,383.2	9,857.2	995.4	1.70	-1.66	0.37	7.6	50.5
Last MWD Survey (MD=22492.0')										
22,668.0	89.47	3.94	12,384.9	10,032.8	1,007.5	0.00	0.00	0.00	7.9	37.5
Projection to Bit (MD=22668.0')										



Final PVA

Company: Midland
Project: Lea County, NM (NAD 83 NME)
Site: Resolute 12 Fed Com
Well: #704H
Wellbore: OH
Design: OH

Local Co-ordinate Reference: Well #704H
TVD Reference: KB = 32' @ 3533.0usft
MD Reference: KB = 32' @ 3533.0usft
North Reference: Grid
Survey Calculation Method: Minimum Curvature
Database: PEDM

Design Annotations

Measured Depth (usft)	Vertical Depth (usft)	Local Coordinates		Comment
		+N/-S (usft)	+E/-W (usft)	
12,088.0	11,964.2	-342.6	1,121.8	KOP, MD:12088.0', TVD:11964.2', N/S:-342.6', E/W:1121.8', INC:3.78
12,216.8	12,089.9	-317.5	1,119.3	FTP Crossing, MD:12216.8', TVD:12089.9', N/S:-317.5', E/W:1119.3', INC:22.02
22,492.0	12,383.2	9,857.2	995.4	Last MWD Survey (MD=22492.0')
22,668.0	12,384.9	10,032.8	1,007.5	Projection to Bit (MD=22668.0')

Checked By: _____ Approved By: _____ Date: _____

I CERTIFY THIS SURVEY TO BE TRUE AND CORRECT TO THE BEST OF MY BELIEF AND KNOWLEDGE
 KAY MADDOX 12/14/2021



Lea County, NM (NAD 83 NME)

Resolute 12 Fed Com #704H

Plan #1

PROJECT DETAILS: Lea County, NM (NAD 83 NME)


Geodetic System: US State Plane 1983
Datum: North American Datum 1983
Ellipsoid: GRS 1980
Zone: New Mexico Eastern Zone
System Datum: Mean Sea Level

WELL DETAILS: #704H

KB = 32' @ 3533.0usft
Northing 415014.00 Easting 759052.00 Latitude 32° 8' 20.392 N Longitude 103° 37' 47.806 W

SECTION DETAILS

Sec	MD	Inc	Azi	TVD	+N/-S	+E/-W	Dleg	TFace	Vsect	Target
1	0.0	0.00	0.00	0.0	0.0	0.0	0.00	0.00	0.0	
2	1200.0	0.00	0.00	1200.0	0.0	0.0	0.00	0.00	0.0	
3	1779.6	11.59	108.58	1775.7	-18.6	55.4	2.00	108.58	-12.8	
4	6946.7	11.59	108.58	6837.3	-349.4	1039.6	0.00	0.00	-239.9	
5	7526.3	0.00	359.72	7413.0	-368.0	1095.0	2.00	180.00	-252.6	Brushy Top(Res 12 FC #704H)
6	11973.8	0.00	359.72	11860.5	-368.0	1095.0	0.00	359.72	-252.6	
7	12723.3	89.94	359.72	12338.0	109.0	1092.7	12.00	359.72	221.5	
8	18435.4	89.94	359.72	12344.0	5821.0	1065.3	0.00	0.00	5900.0	TGT 1 (Res 12 FC #704H)
9	18460.0	89.45	359.72	12344.1	5845.6	1065.1	2.00	180.00	5924.5	TGT 2 (Res 12 FC #704H)
10	19481.6	89.45	359.72	12354.0	6867.1	1060.2	0.00	0.00	6940.0	
11	19488.5	89.58	359.72	12354.1	6874.0	1060.2	2.00	0.00	6946.8	
12	22652.6	89.58	359.72	12377.0	10038.0	1045.0	0.00	0.00	10092.2	PBHL(Res 12 FC #704H)

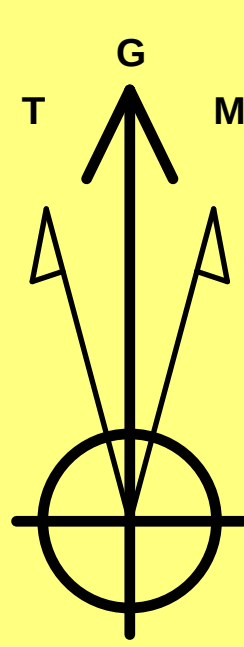

Azimuths to Grid North
True North: -0.37°
Magnetic North: 6.19°

Magnetic Field
Strength: 47433.3nT
Dip Angle: 59.81°
Date: 6/29/2021
Model: IGRF2020







To convert a Magnetic Direction to a Grid Direction, Add 6.19°
To convert a Magnetic Direction to a True Direction, Add 6.56° East
To convert a True Direction to a Grid Direction, Subtract 0.37°

CASING DETAILS

No casing data is available

WELLBORE TARGET DETAILS (MAP CO-ORDINATES)

Name	TVD	+N/-S	+E/-W	Northing	Easting
Brushy Top(Res 12 FC #704H)	7413.0	-368.0	1095.0	414646.00	760147.00
FTP(Res 12 FC #704H)	12338.0	-318.0	1095.0	414696.00	760147.00
TGT 1 (Res 12 FC #704H)	12344.0	5821.0	1065.3	420835.00	760117.26
TGT 2 (Res 12 FC #704H)	12354.0	6867.1	1060.2	421881.10	760112.24
PBHL(Res 12 FC #704H)	12377.0	10038.0	1045.0	425052.00	760097.00

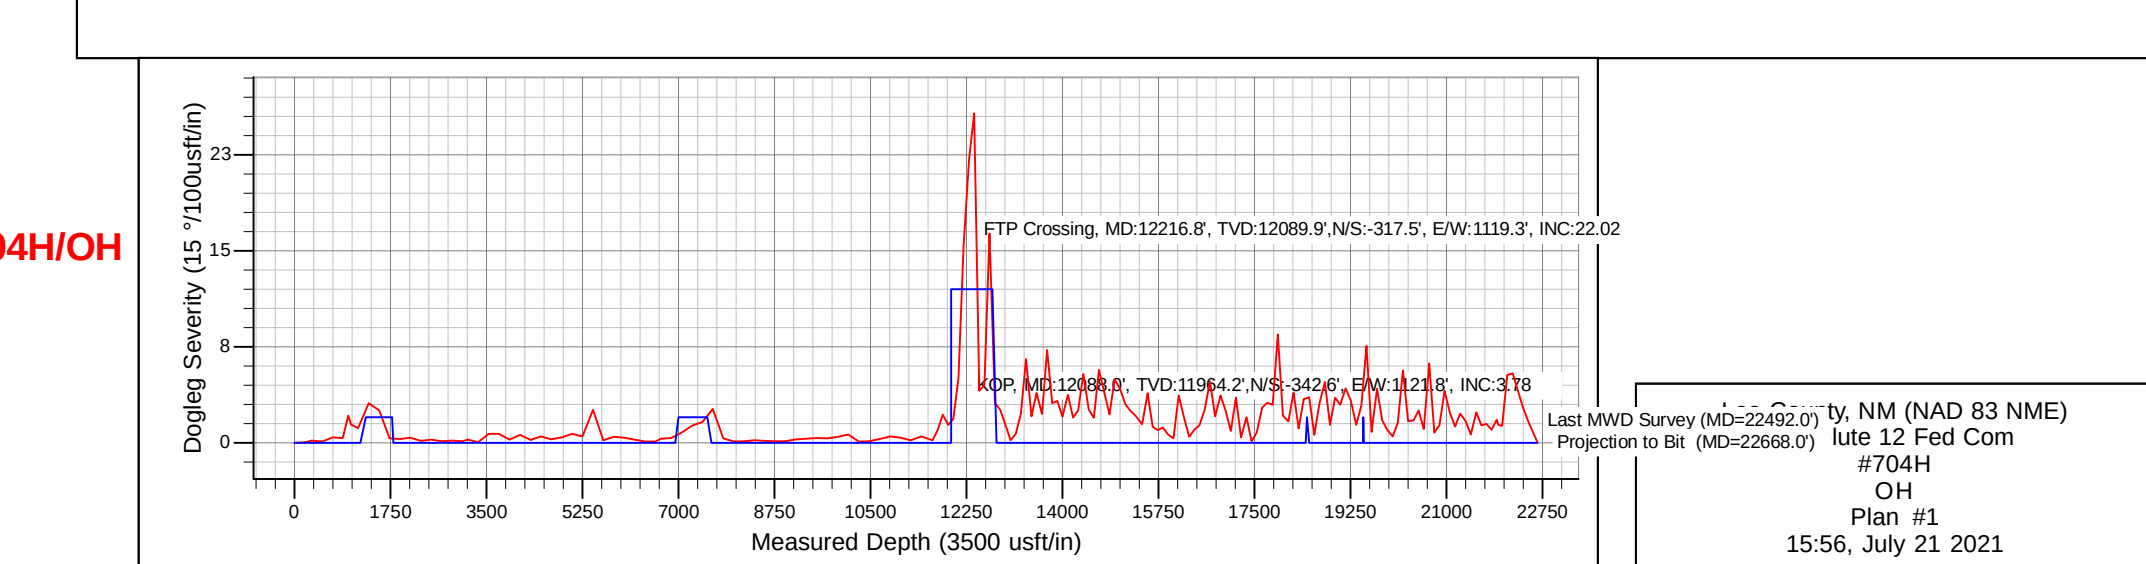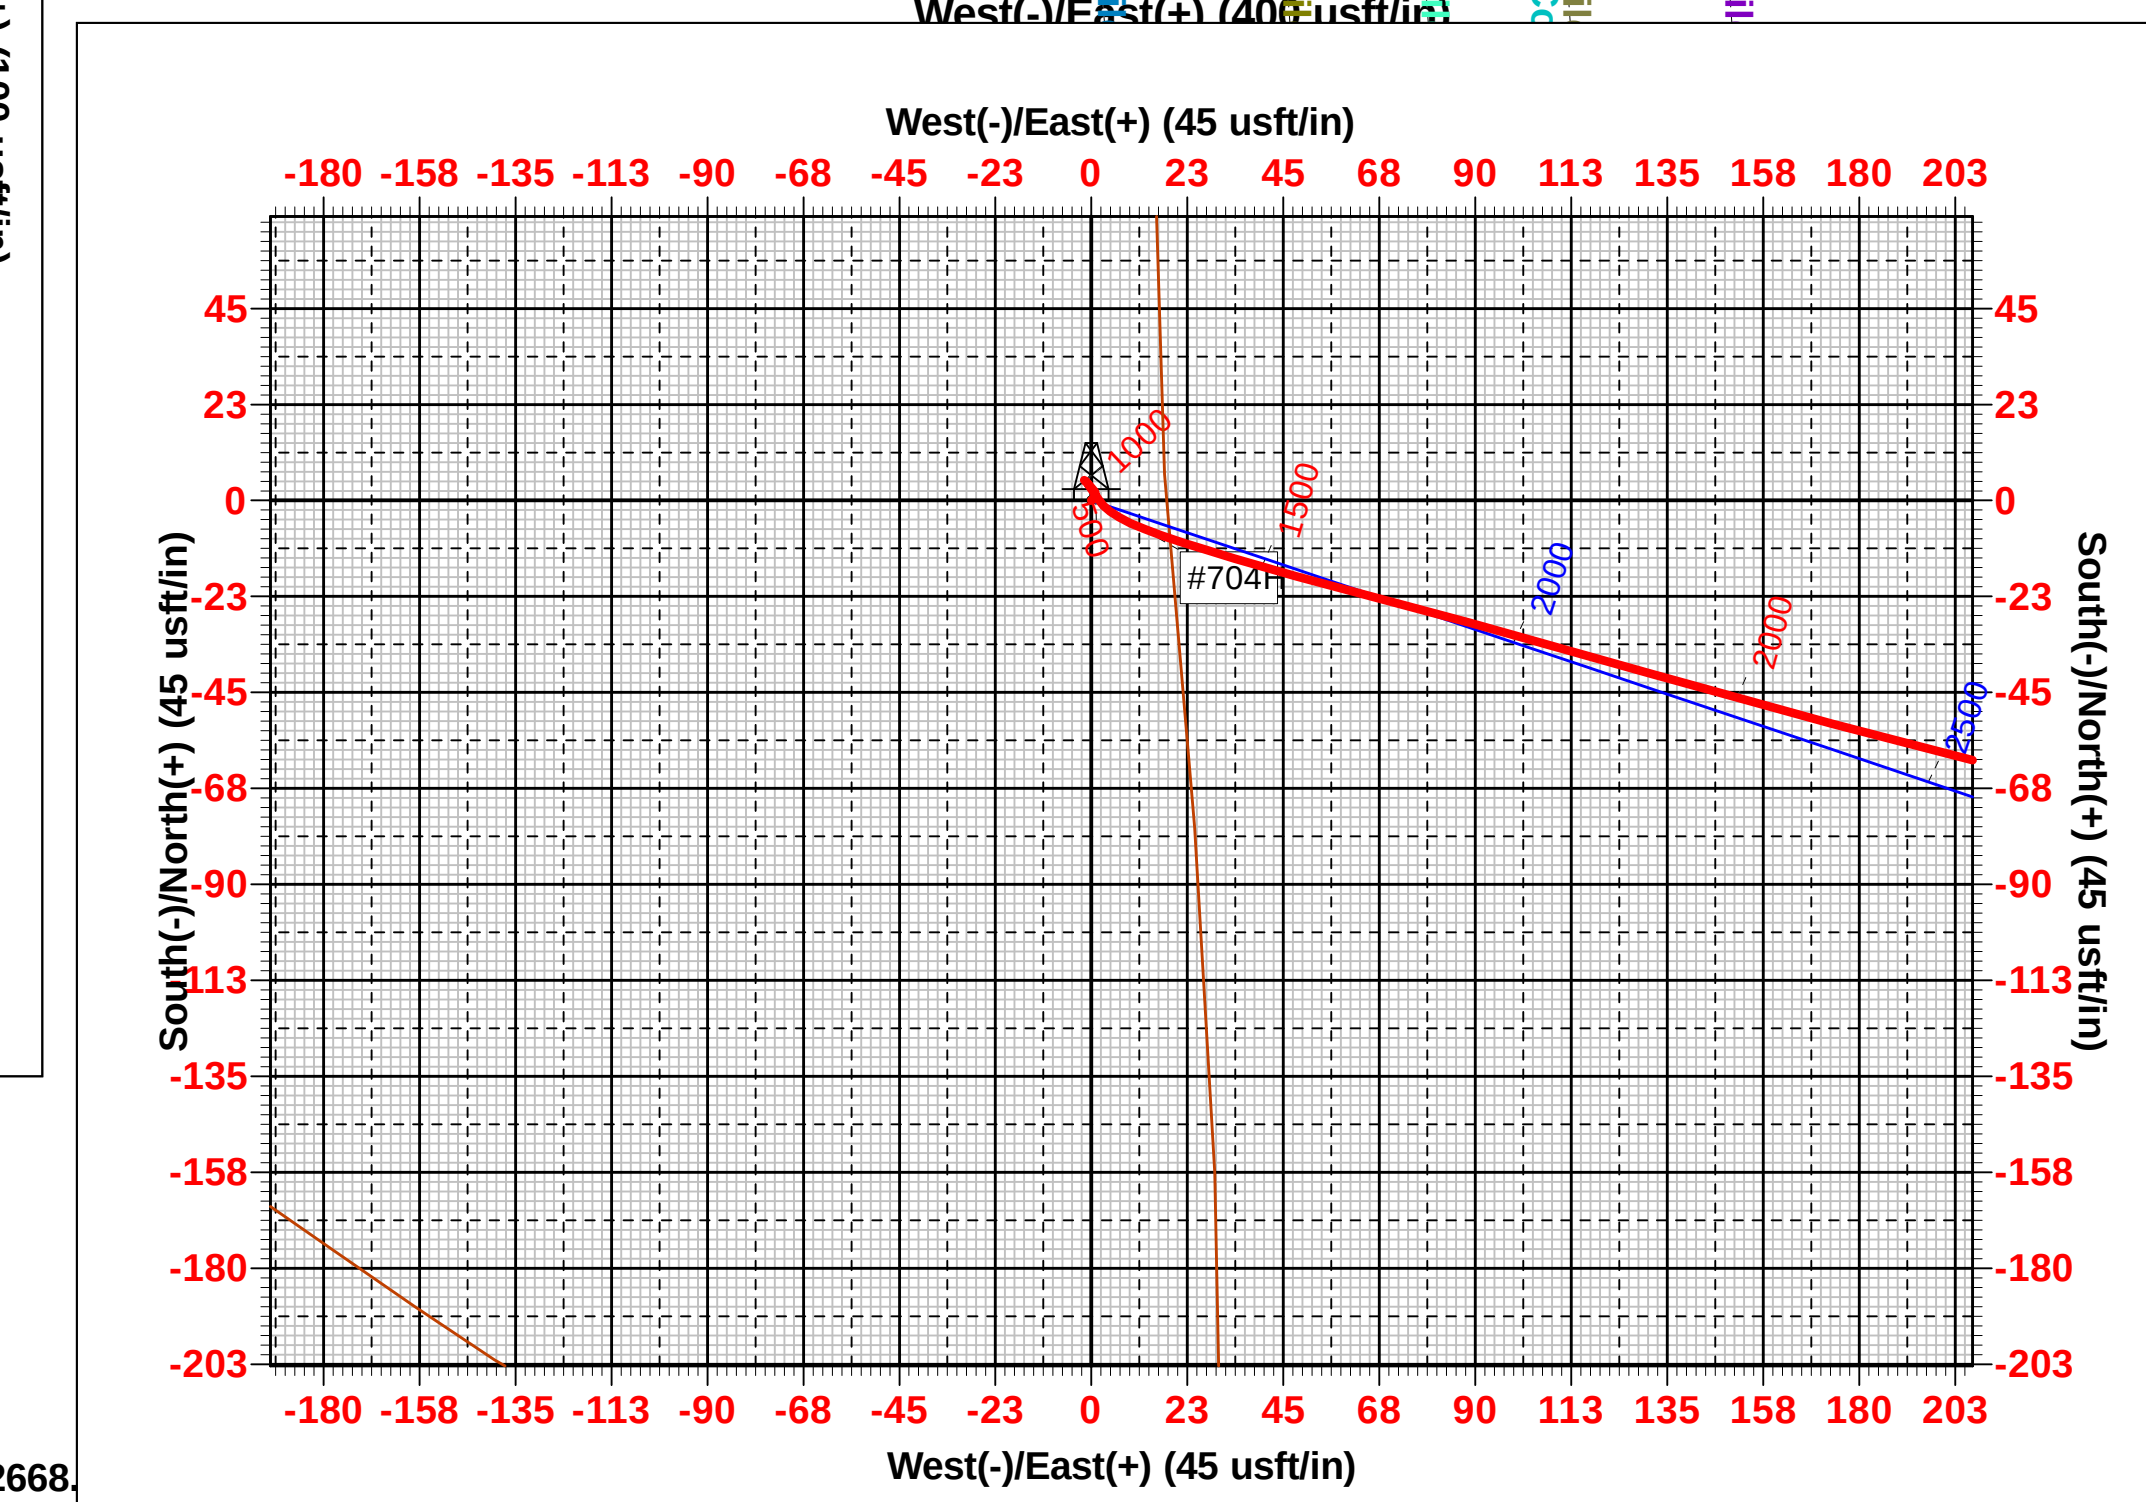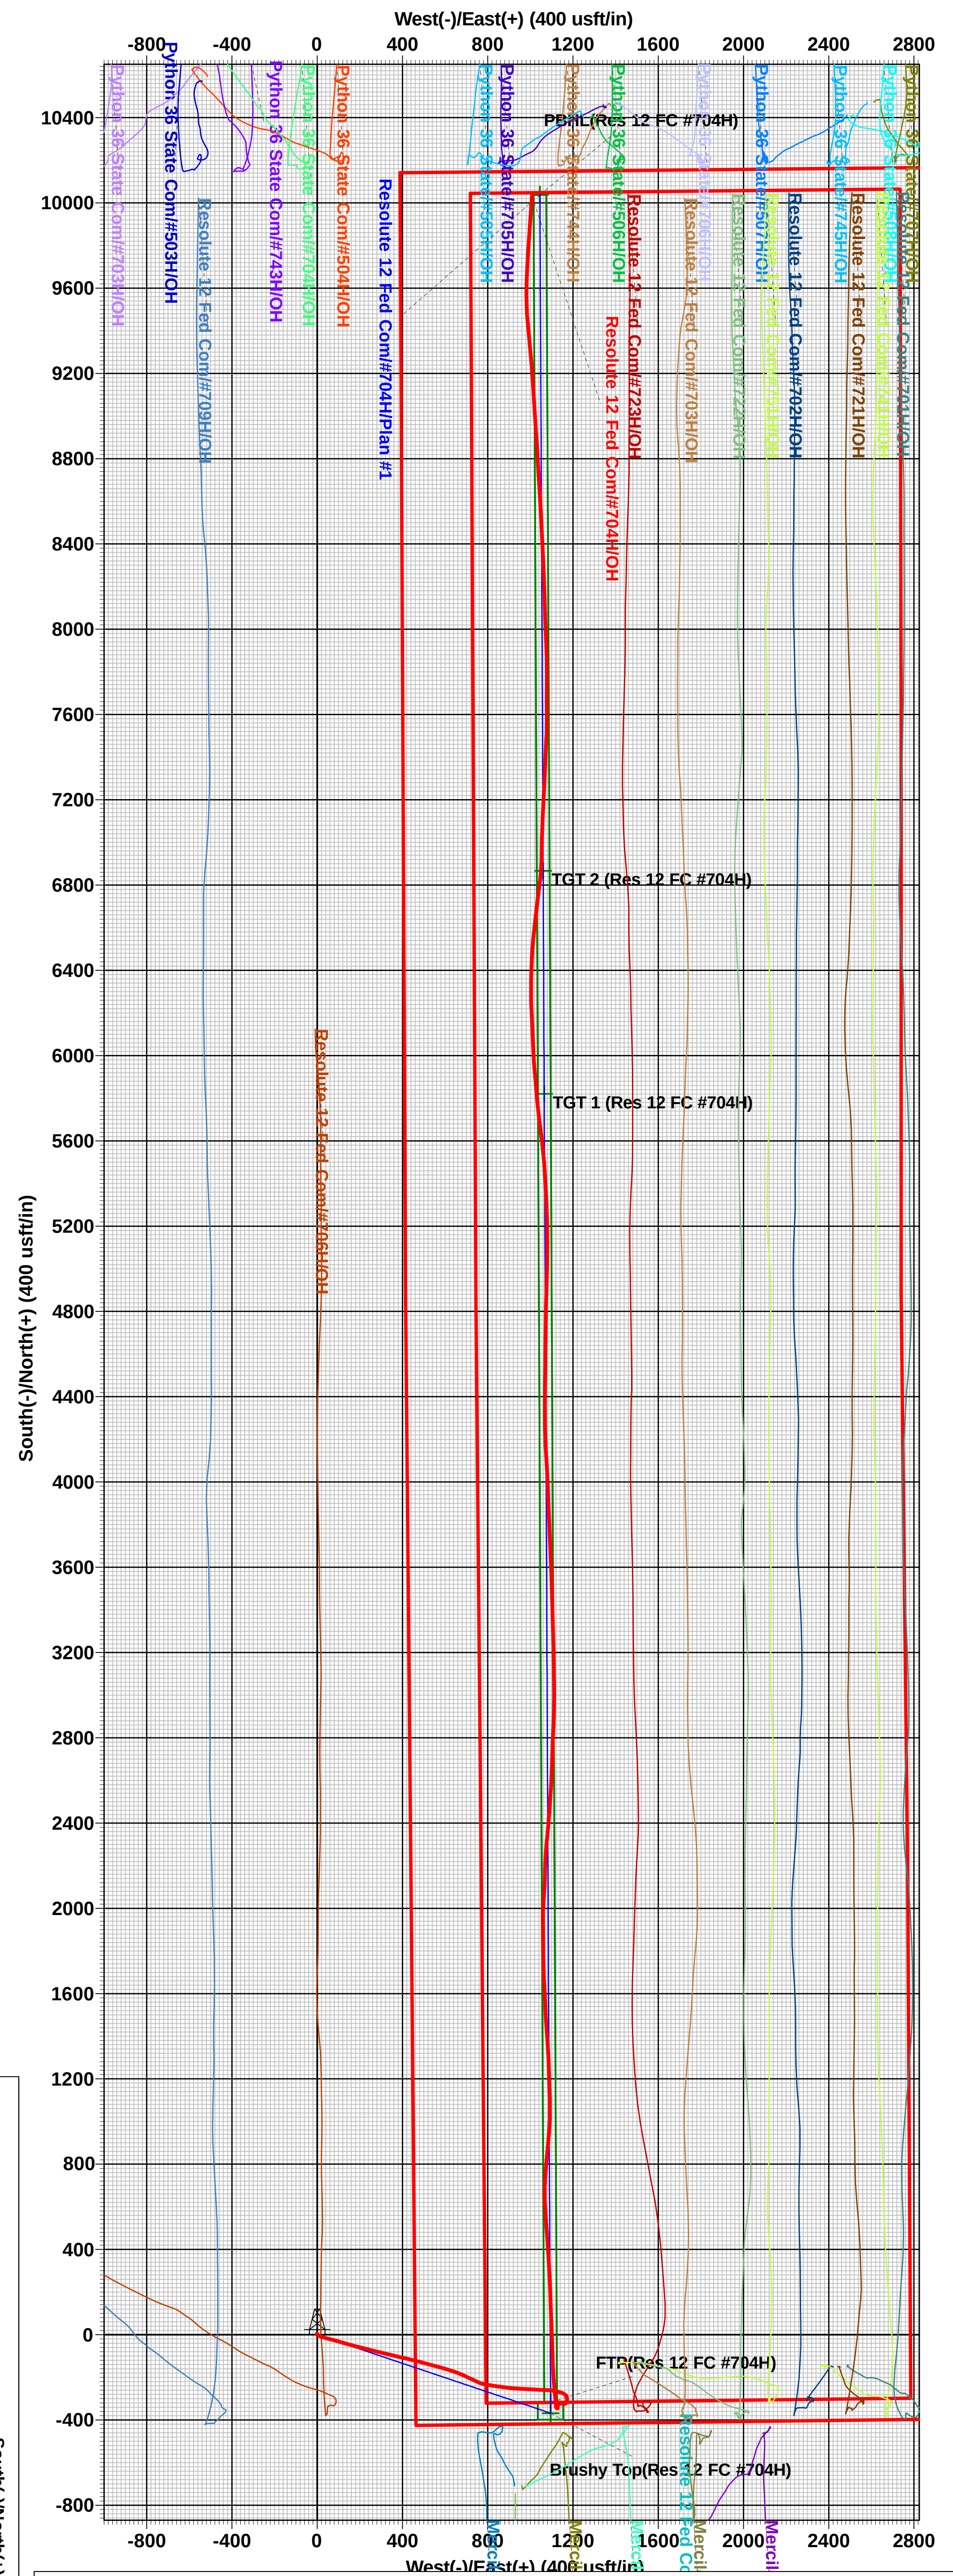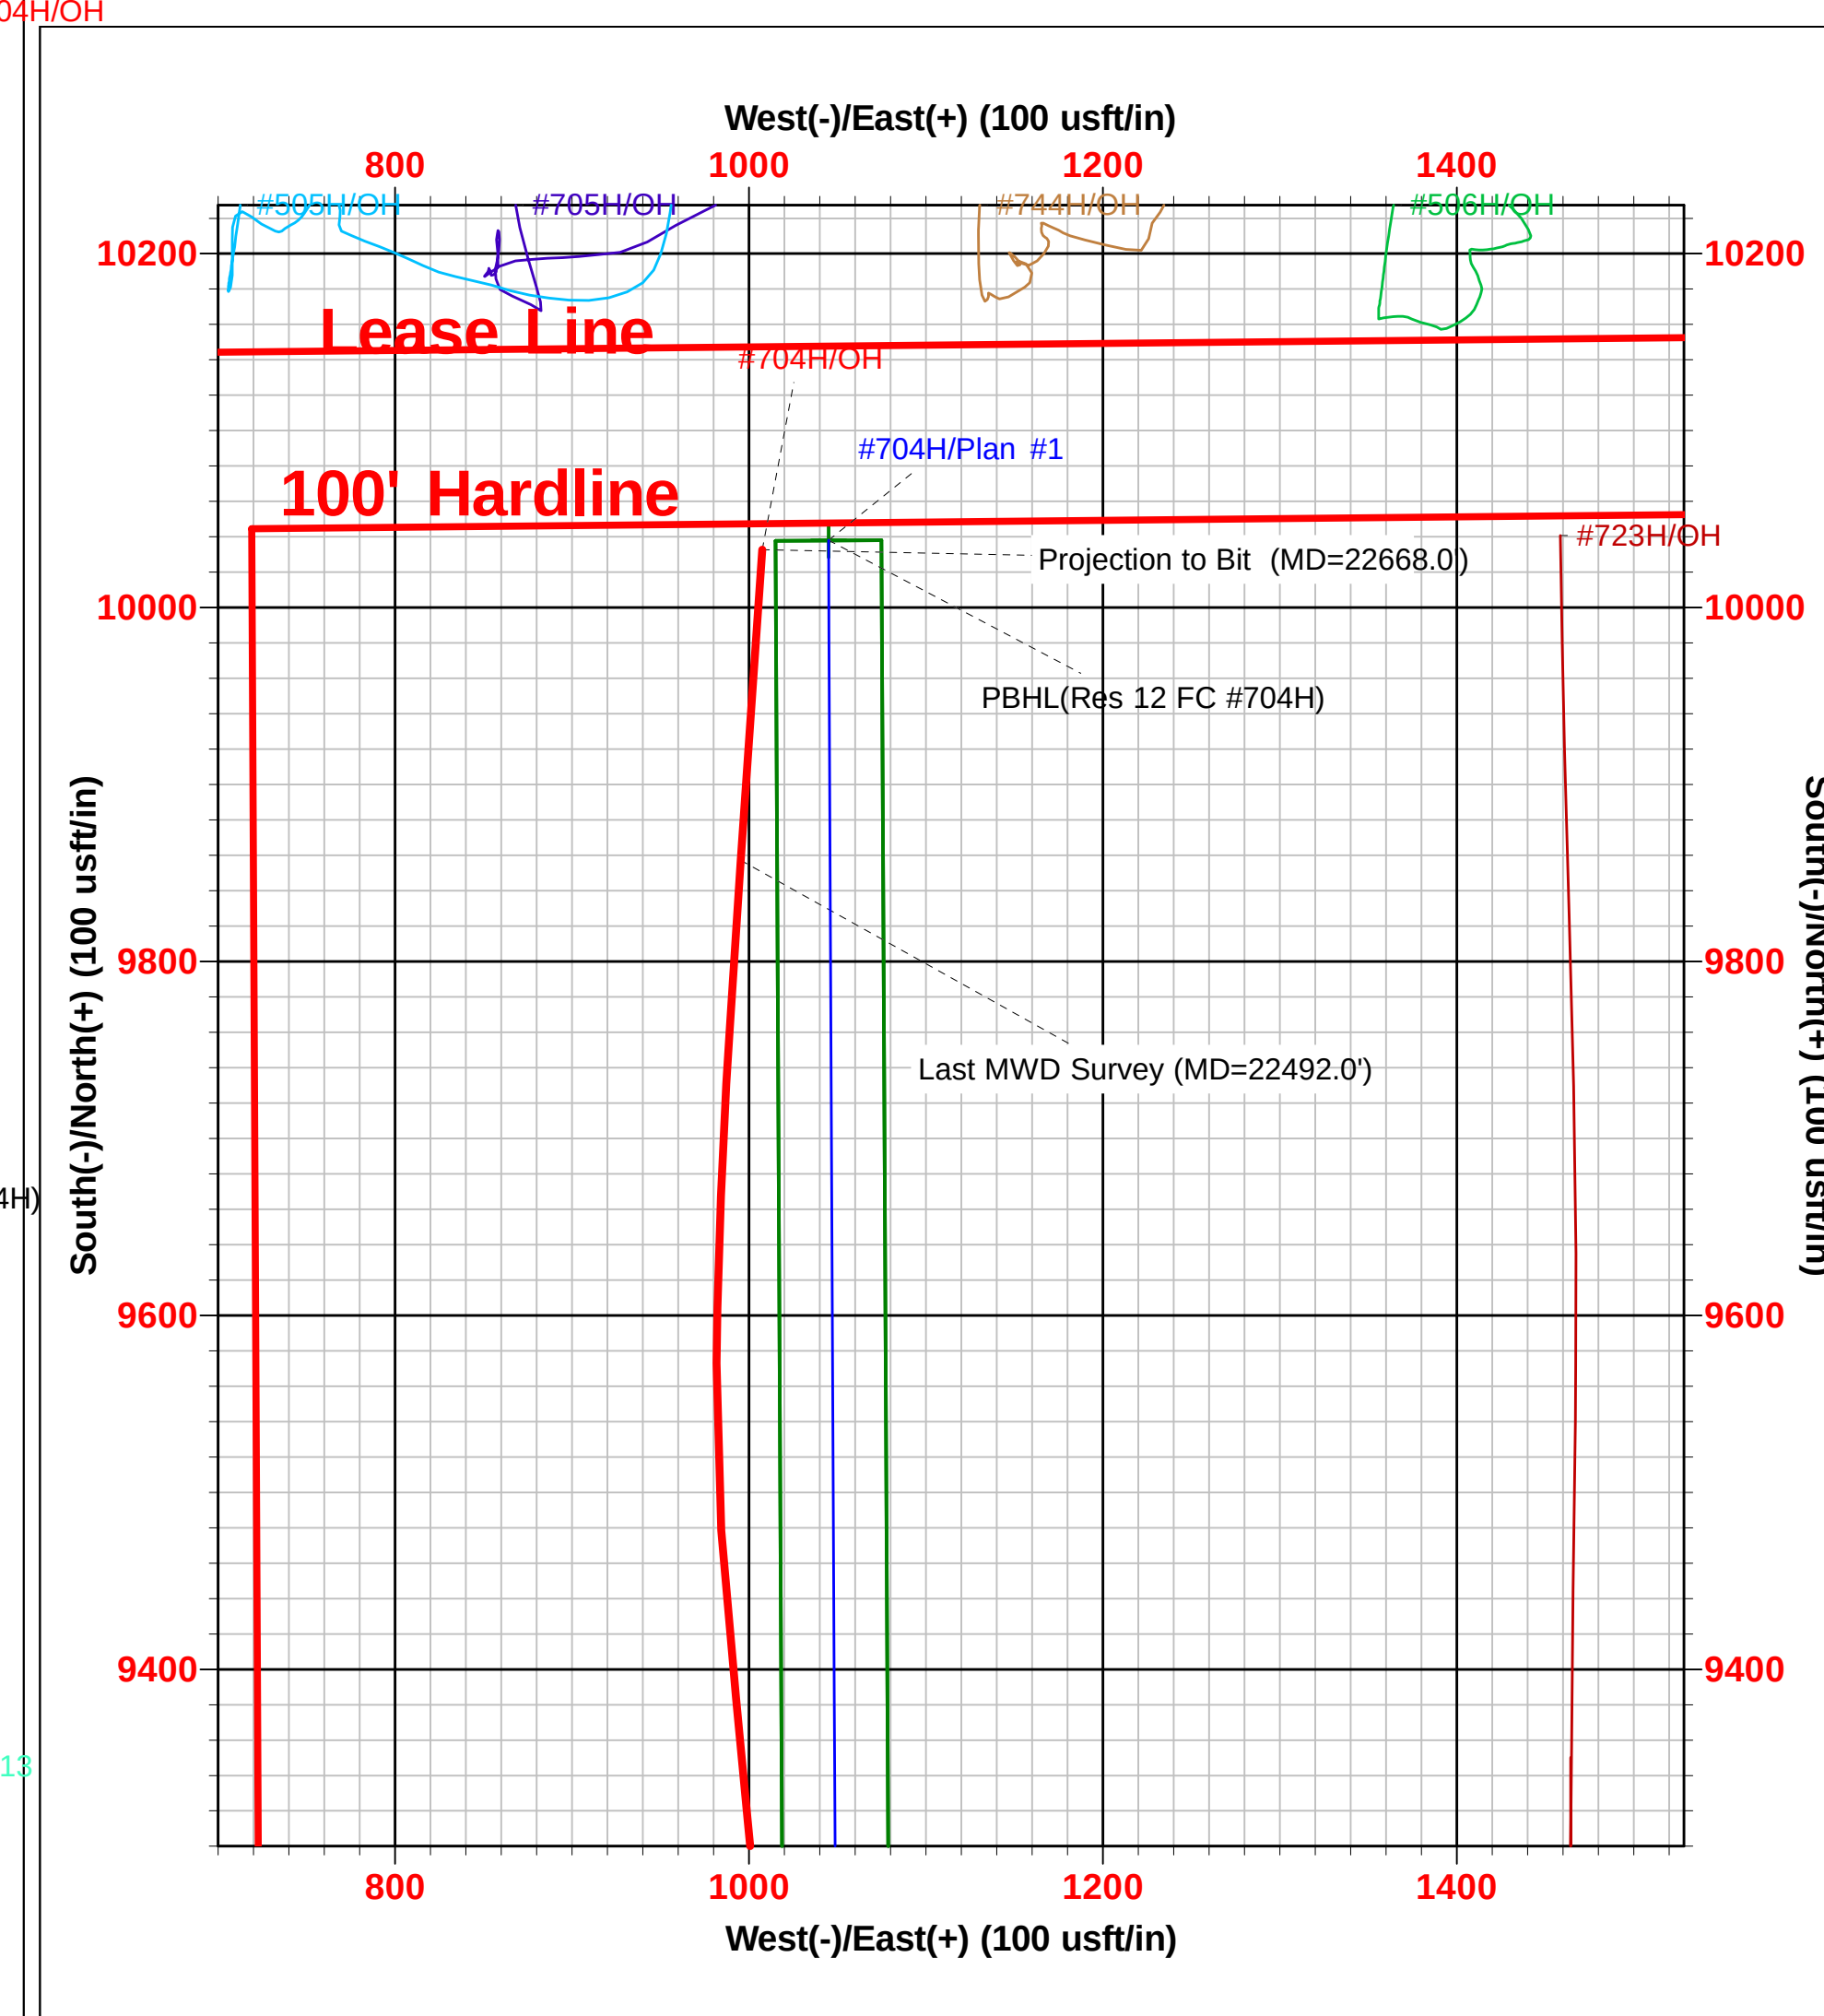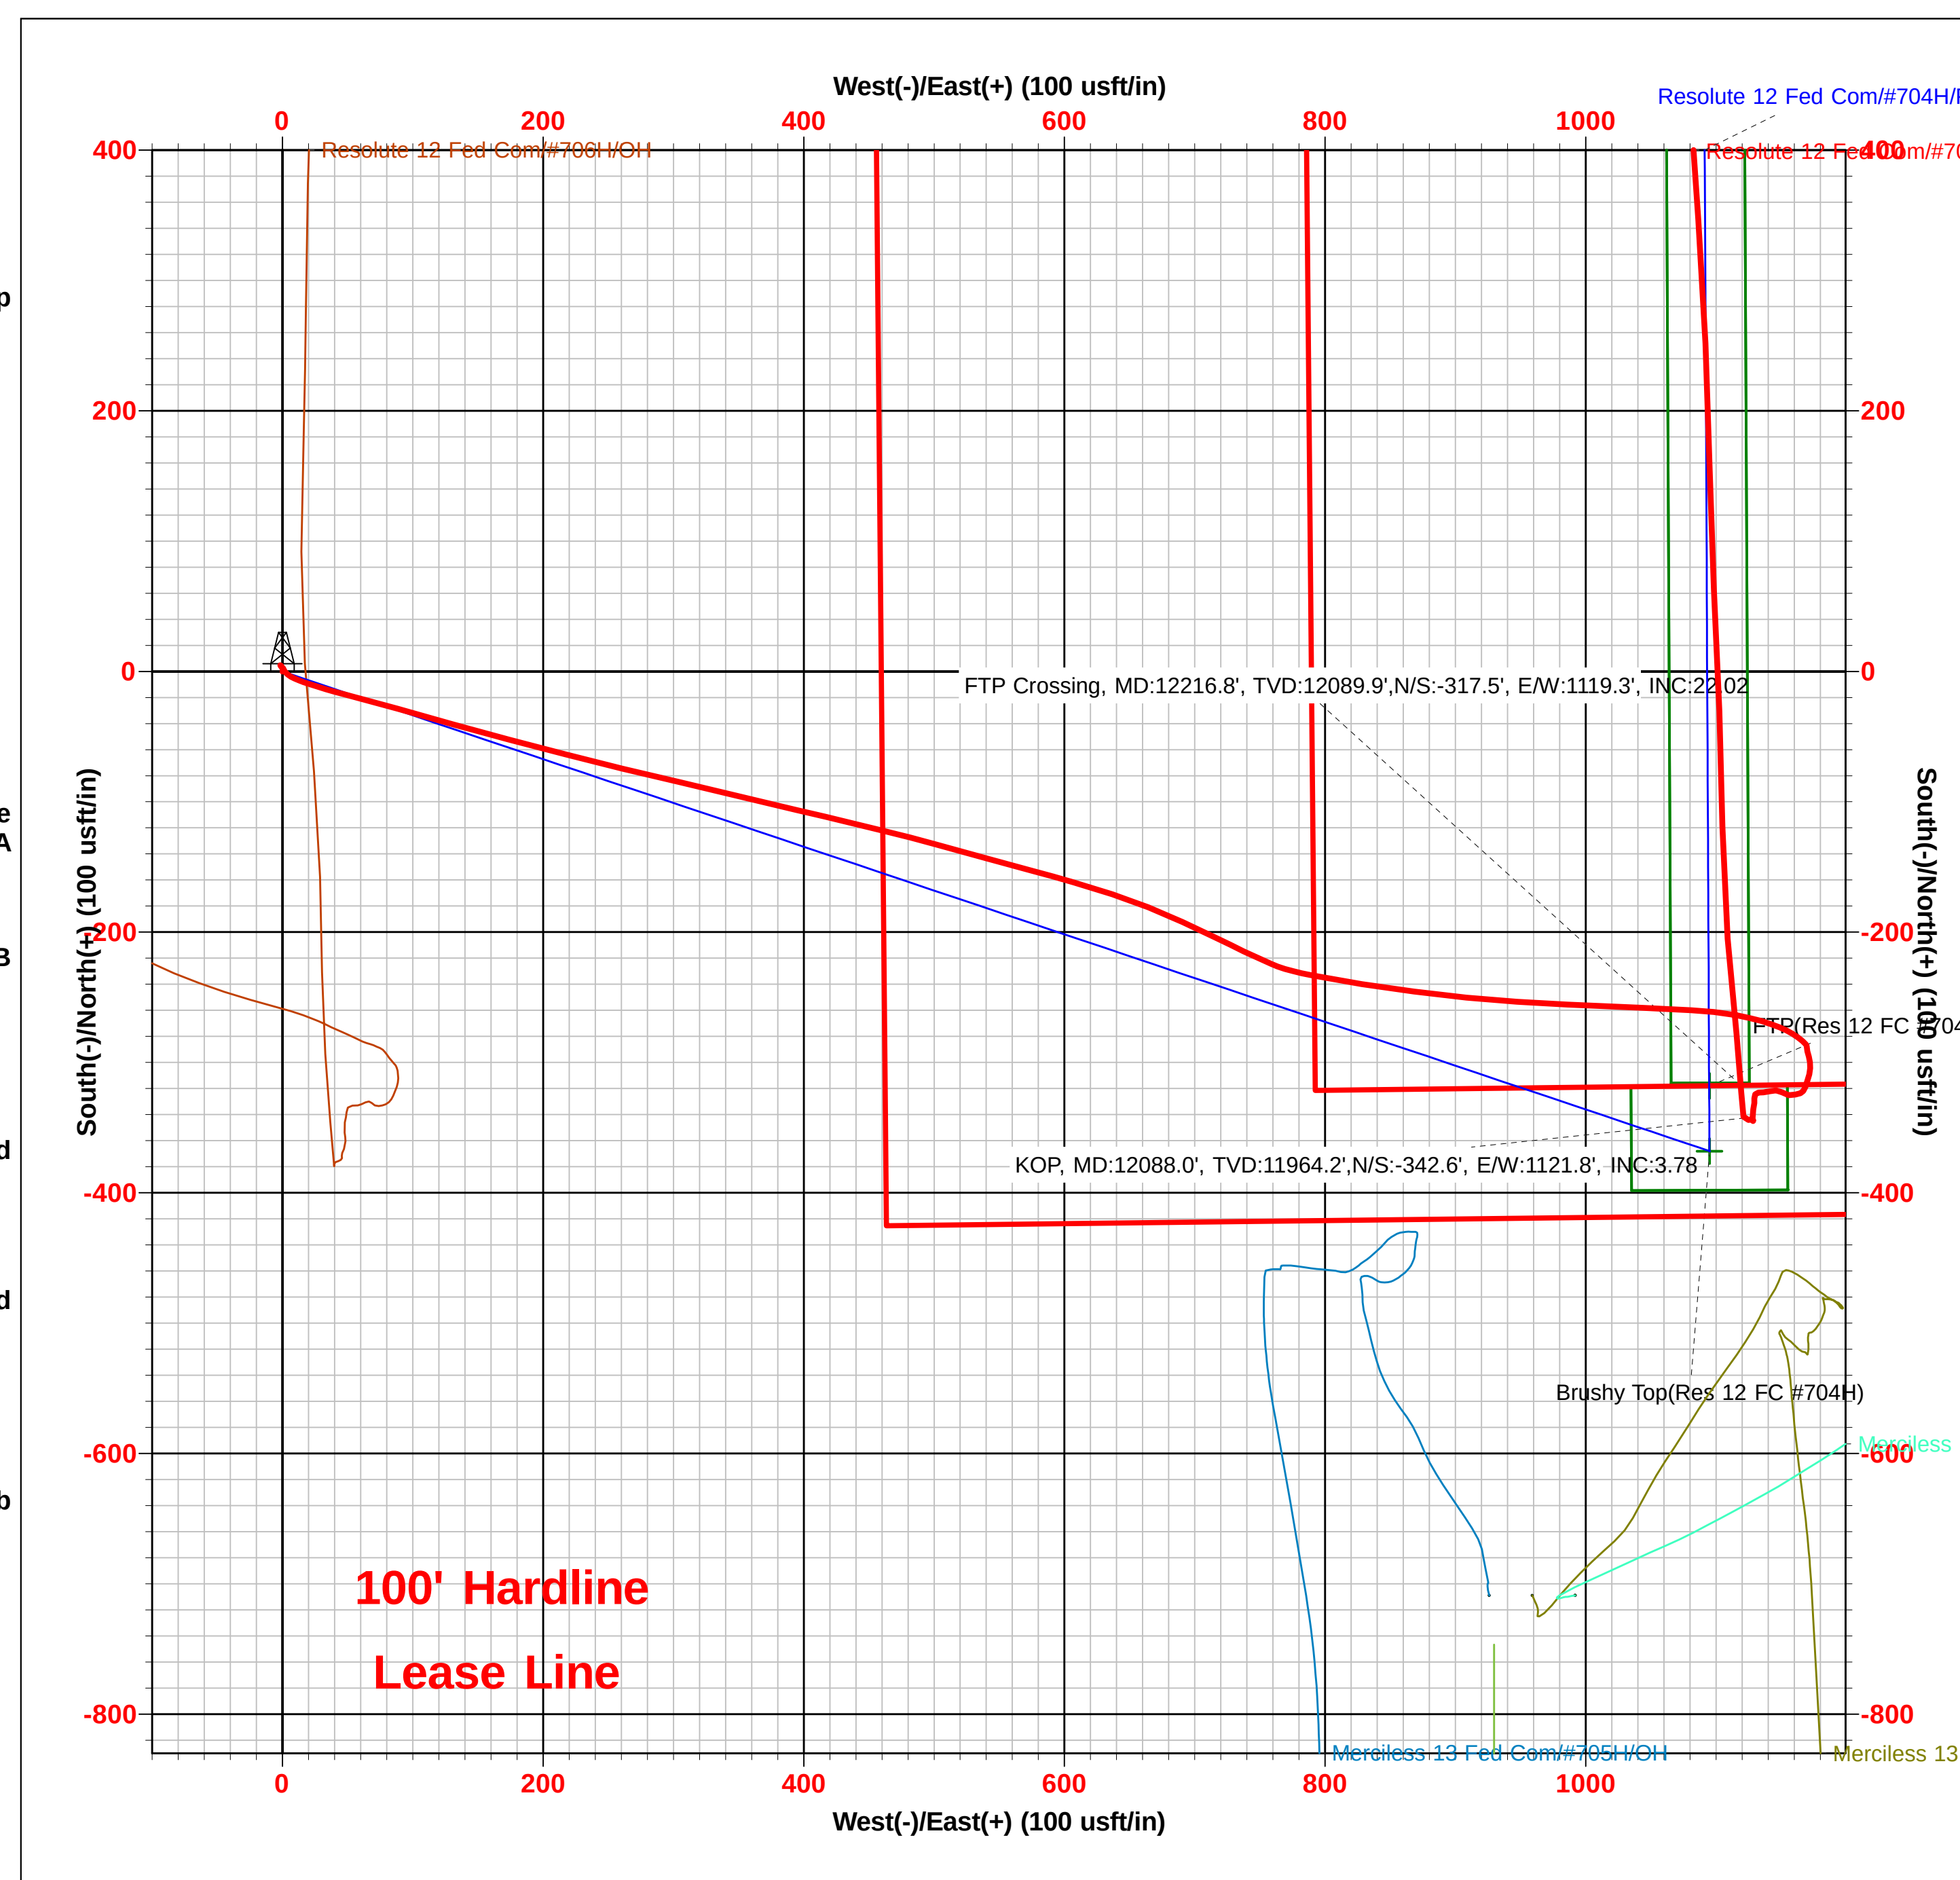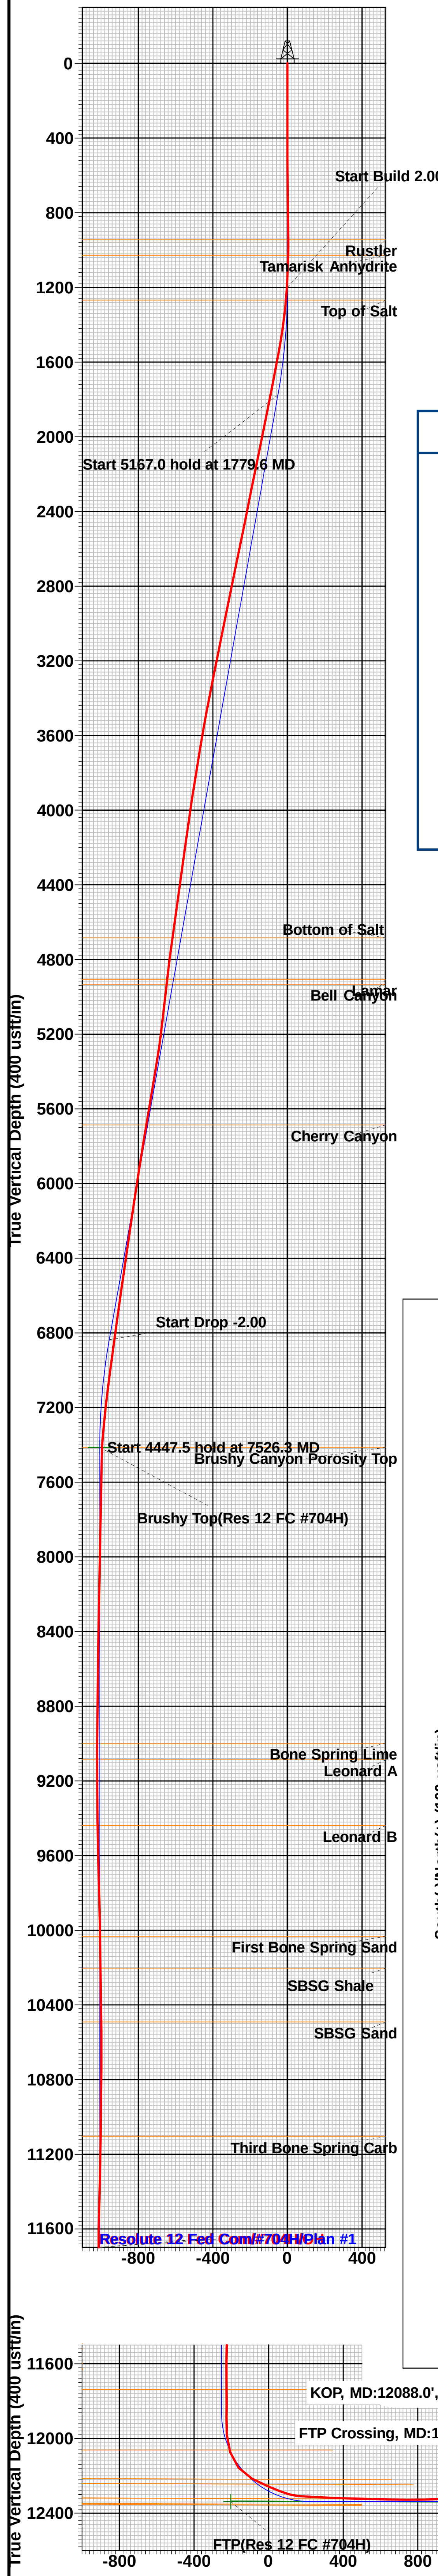

Intent ☐ As Drilled ☐

API #		
Operator Name:	Property Name:	Well Number

Kick Off Point (KOP)

UL	Section	Township	Range	Lot	Feet	From N/S	Feet	From E/W	County
Latitude					Longitude				NAD

First Take Point (FTP)

UL	Section	Township	Range	Lot	Feet	From N/S	Feet	From E/W	County
Latitude					Longitude				NAD

Last Take Point (LTP)

UL	Section	Township	Range	Lot	Feet	From N/S	Feet	From E/W	County
Latitude					Longitude				NAD

Is this well the defining well for the Horizontal Spacing Unit? ☐Is this well an infill well? ☐

If infill is yes please provide API if available, Operator Name and well number for Defining well for Horizontal Spacing Unit.

API #		
Operator Name:	Property Name:	Well Number

KZ 06/29/2018

Submit To Appropriate District Office Two Copies <u>District I</u> 1625 N. French Dr., Hobbs, NM 88240 <u>District II</u> 811 S. First St., Artesia, NM 88210 <u>District III</u> 1000 Rio Brazos Rd., Aztec, NM 87410 <u>District IV</u> 1220 S. St. Francis Dr., Santa Fe, NM 87505		State of New Mexico Energy, Minerals and Natural Resources Oil Conservation Division 1220 South St. Francis Dr. Santa Fe, NM 87505			Form C-105 Revised August 1, 2011					
WELL COMPLETION OR RECOMPLETION REPORT AND LOG										
4. Reason for filing: ☒ COMPLETION REPORT (Fill in boxes #1 through #31 for State and Fee wells only) ☐ C-144 CLOSURE ATTACHMENT (Fill in boxes #1 through #9, #15 Date Rig Released and #32 and/or #33; attach this and the plat to the C-144 closure report in accordance with 19.15.17.13.K NMAC)								5. Lease Name or Unit Agreement Name RESOLUTE 12 FEDERAL COM		
								6. Well Number: 704H		
7. Type of Completion: ☒ NEW WELL ☐ WORKOVER ☐ DEEPENING ☐ PLUGBACK ☐ DIFFERENT RESERVOIR ☐ OTHER _____										
8. Name of Operator EOG RESOURCES INC							9. OGRID 7377			
10. Address of Operator PO BOX 2267 MIDLAND, TEXAS 79702							11. Pool name or Wildcat WC025 G09 S253309P; UPPER WOLFCAMP			
12. Location	Unit Ltr	Section	Township	Range	Lot	Feet from the	N/S Line	Feet from the	E/W Line	County
Surface:	N	12	25S	32E		431	SOUTH	2196	WEST	LEA
BH:	B	1	25S	32E		112	NORTH	2058	EAST	LEA
13. Date Spudded 06/17/2021	14. Date T.D. Reached 07/18/2021		15. Date Rig Released 07/19/2021			16. Date Completed (Ready to Produce) 12/09/2021		17. Elevations (DF and RKB, RT, GR, etc.) 3501' GL		
18. Total Measured Depth of Well MD 22,668' TVD 12,384'			19. Plug Back Measured Depth MD 22,636' TVD 12,384'			20. Was Directional Survey Made? YES		21. Type Electric and Other Logs Run None		
22. Producing Interval(s), of this completion - Top, Bottom, Name WOLFCAMP 12,607 - 22,636'										
23. CASING RECORD (Report all strings set in well)										
CASING SIZE		WEIGHT LB./FT.		DEPTH SET		HOLE SIZE		CEMENTING RECORD		AMOUNT PULLED
9 5/8"		36# J-55		1079'		12 1/4"		440 CL C/CIRC		
7 5/8"		29.7# HCP 110		11,604'		8 3/4"		1546 CL C & H/CIRC		
5 1/2"		20# ECP 110		22,645'		6 3/4"		1130 CL H TOC 2800' CBL		
24. LINER RECORD						25. TUBING RECORD				
SIZE	TOP	BOTTOM	SACKS CEMENT	SCREEN	SIZE	DEPTH SET	PACKER SET			
26. Perforation record (interval, size, and number) 12,607 -22,636' 3 1/8", 2169 holes						27. ACID, SHOT, FRACTURE, CEMENT, SQUEEZE, ETC.				
						DEPTH INTERVAL		AMOUNT AND KIND MATERIAL USED		
						12,607 -22,636'		FRAC W/25,407,860 lbs proppant, 412,182 bbls load fld		
28. PRODUCTION										
Date First Production 12/09/2021		Production Method (<i>Flowing, gas lift, pumping - Size and type pump</i>) Flowing				Well Status (<i>Prod. or Shut-in</i>) Producing				
Date of Test 12/18/2021	Hours Tested 24	Choke Size 70	Prod'n For Test Period	Oil - Bbl 4316	Gas - MCF 9251	Water - Bbl. 10848	Gas - Oil Ratio 2143			
Flow Tubing Press.	Casing Pressure 1447	Calculated 24-Hour Rate	Oil - Bbl.	Gas - MCF	Water - Bbl.	Oil Gravity - API - (<i>Corr.</i>) 45				
29. Disposition of Gas (<i>Sold, used for fuel, vented, etc.</i>) SOLD								30. Test Witnessed By		
31. List Attachments C-102, C-104, C-103, Directional Survey, H spacing, Gas capture										
32. If a temporary pit was used at the well, attach a plat with the location of the temporary pit.										
33. If an on-site burial was used at the well, report the exact location of the on-site burial:										
Latitude _____ Longitude _____ NAD 1927 1983										
I hereby certify that the information shown on both sides of this form is true and complete to the best of my knowledge and belief										
Signature Kay Maddox			Name Kay Maddox			Title Senior Regulatory Specialist			Date 12/21/2021	
E-mail Address kay_maddox@eogresources.com										

This form is to be filed with the appropriate District Office of the Division not later than 20 days after the completion of any newly-drilled or deepened well and not later than 60 days after completion of closure. When submitted as a completion report, this shall be accompanied by one copy of all electrical and radio-activity logs run on the well and a summary of all special tests conducted, including drill stem tests. All depths reported shall be measured depths. In the case of directionally drilled wells, true vertical depths shall also be reported. For multiple completions, items 11, 12 and 26-31 shall be reported for each zone.

Southeastern New Mexico			Northwestern New Mexico				
T. Anhy	Rustler	945'	T. Canyon	Brushy	7413'	T. Ojo Alamo	T. Penn A"
T. Salt		1268'	T. Strawn			T. Kirtland	T. Penn. "B"
B. Salt		4685'	T. Atoka			T. Fruitland	T. Penn. "C"
T. Yates			T. Miss			T. Pictured Cliffs	T. Penn. "D"
T. 7 Rivers			T. Devonian			T. Cliff House	T. Leadville
T. Queen			T. Silurian			T. Menefee	T. Madison
T. Grayburg			T. Montoya			T. Point Lookout	T. Elbert
T. San Andres			T. Simpson			T. Mancos	T. McCracken
T. Glorieta			T. McKee			T. Gallup	T. Ignacio Otzte
T. Paddock			T. Ellenburger			Base Greenhorn	T. Granite
T. Blinebry			T. Gr. Wash			T. Dakota	
T. Tubb			T. Delaware Sand			T. Morrison	
T. Drinkard			T. Bone Springs			T. Todilto	
T. Abo			T. 1st BS Sand	10,032'		T. Entrada	
T. Wolfcamp		12,218'	T. 2nd BS Sand	10,491'		T. Wingate	
T. Penn			T. 3rd BS Sand	11,737'		T. Chinle	
T. Cisco (Bough C)			T.			T. Permian	

No. 1, from.....to.....
No. 2, from.....to.....
No. 3, from.....to.....
No. 4, from.....to.....

Include data on rate of water inflow and elevation to which water rose in hole.

No. 1, from.....to.....feet.....
 No. 2, from.....to.....feet.....
 No. 3, from.....to.....feet.....

From	To	Thickness In Feet	Lithology

From	To	Thickness In Feet	Lithology

District I

1625 N. French Dr., Hobbs, NM 88240
Phone:(575) 393-6161 Fax:(575) 393-0720

District II

811 S. First St., Artesia, NM 88210
Phone:(575) 748-1283 Fax:(575) 748-9720

District III

1000 Rio Brazos Rd., Aztec, NM 87410
Phone:(505) 334-6178 Fax:(505) 334-6170

District IV

1220 S. St Francis Dr., Santa Fe, NM 87505
Phone:(505) 476-3470 Fax:(505) 476-3462

State of New Mexico
Energy, Minerals and Natural Resources
Oil Conservation Division
1220 S. St Francis Dr.
Santa Fe, NM 87505

ACKNOWLEDGMENTS

Action 68443

ACKNOWLEDGMENTS

Operator: EOG RESOURCES INC P.O. Box 2267 Midland, TX 79702	OGRID: 7377
	Action Number: 68443
	Action Type: [C-104] Completion Packet (C-104C)

ACKNOWLEDGMENTS

☒	I hereby certify that the required Water Use Report has been, or will be, submitted for this wells completion.
☒	I hereby certify that the required FracFocus disclosure has been, or will be, submitted for this wells completion.

District I

1625 N. French Dr., Hobbs, NM 88240
Phone:(575) 393-6161 Fax:(575) 393-0720

District II

811 S. First St., Artesia, NM 88210
Phone:(575) 748-1283 Fax:(575) 748-9720

District III

1000 Rio Brazos Rd., Aztec, NM 87410
Phone:(505) 334-6178 Fax:(505) 334-6170

District IV

1220 S. St Francis Dr., Santa Fe, NM 87505
Phone:(505) 476-3470 Fax:(505) 476-3462

State of New Mexico
Energy, Minerals and Natural Resources
Oil Conservation Division
1220 S. St Francis Dr.
Santa Fe, NM 87505

CONDITIONS

Action 68443

CONDITIONS

Operator: EOG RESOURCES INC P.O. Box 2267 Midland, TX 79702	OGRID: 7377
	Action Number: 68443
	Action Type: [C-104] Completion Packet (C-104C)

CONDITIONS

Created By	Condition	Condition Date
smcgrath	File 3160-4 Completion Report within 10 days to NMOCD after BLM approval.	8/25/2022