

District I
1625 N. French Dr., Hobbs, NM 88240
District II
811 S. First St., Artesia, NM 88210
District III
1000 Rio Brazos Rd., Aztec, NM 87410
District IV
1220 S. St. Francis Dr., Santa Fe, NM 87505

State of New Mexico
Energy, Minerals & Natural
Resources

Form C-104
Revised August 1, 2011

Submit one copy to appropriate District Office

Oil Conservation Division
1220 South St. Francis Dr.

☐ AMENDED REPORT

I. REQUEST FOR ALLOWABLE MINERAL AUTHORIZATION TO TRANSPORT

¹ Operator name and Address EOG RESOURCES INC PO BOX 2267 MIDLAND, TEXAS 79702		² OGRID Number 7377	
		³ Reason for Filing Code/ Effective Date NW 08/21/2022	
⁴ API Number 30 - 025-46100	⁵ Pool Name RED HILLS; LOWER BONE SPRING		⁶ Pool Code 51020
⁷ Property Code 323122	⁸ Property Name GREEN DRAKE 16 FEDERAL COM		⁹ Well Number 403H

II. ¹⁰ Surface Location

Ul or lot no. J	Section 16	Township 25S	Range 33E	Lot Idn	Feet from the 2395	North/South Line SOUTH	Feet from the 1320	East/West line EAST	County LEA
--------------------	---------------	-----------------	--------------	---------	-----------------------	---------------------------	-----------------------	------------------------	---------------

¹¹ Bottom Hole Location

UL or lot no. O	Section 21	Township 25S	Range 33E	Lot Idn	Feet from the 111	North/South line SOUTH	Feet from the 2173	East/West line EAST	County LEA
¹² Lse Code	¹³ Producing Method Code FLOWING	¹⁴ Gas Connection Date	¹⁵ C-129 Permit Number		¹⁶ C-129 Effective Date		¹⁷ C-129 Expiration Date		

III. Oil and Gas Transporters

¹⁸ Transporter OGRID	¹⁹ Transporter Name and Address	²⁰ O/G/W
372812	EOGRM	OIL
151618	ENTERPRISE FIELD SERVICES	GAS
298751	REGENCY FIELD SERVICES	GAS
36785	DCP MIDSTREAM	GAS

IV. Well Completion Data

²¹ Spud Date 05/12/2022	²² Ready Date 08/21/2022	²³ TD 17,996'	²⁴ PBTD 17,969'	²⁵ Perforations 10,737 - 17,969'	²⁶ DHC, MC	
²⁷ Hole Size		²⁸ Casing & Tubing Size		²⁹ Depth Set		³⁰ Sacks Cement
17 1/2"		13 3/8"		1165'		955 SXS CL C/CIRC
12 1/4"		9 5/8"		4862'		1605 SXS CL C/CIRC
8 1/2"		5 1/2"		17,977'		2855 SXS CL C & H TOC 3334' CBL

V. Well Test Data

³¹ Date New Oil 08/21/2022	³² Gas Delivery Date 08/21/2022	³³ Test Date 08/31/2022	³⁴ Test Length 24 HRS	³⁵ Tbg. Pressure	³⁶ Csg. Pressure 593
³⁷ Choke Size	³⁸ Oil 1909	³⁹ Water 7318	⁴⁰ Gas 3053		⁴¹ Test Method
⁴² I hereby certify that the rules of the Oil Conservation Division have been complied with and that the information given above is true and complete to the best of my knowledge and belief. Signature: Kay Maddox			OIL CONSERVATION DIVISION		
Printed name: Kay Maddox			Approved by: PATRICIA MARTINEZ		
Title: SENIOR REGULATORY SPECIALIST			Title: PETROLEUM SPECIALIST		
E-mail Address: kay_maddox@eogresources.com			Approval Date: 1/31/2025		
Date: 09/02/2022		Phone: 432-638-8475			

District I
1625 N. French Dr., Hobbs, NM 88240
Phone: (575) 393-6161 Fax: (575) 393-0720
District II
811 S. First St., Artesia, NM 88210
Phone: (575) 748-1283 Fax: (575) 748-9720
District III
1000 Rio Brazos Road, Aztec, NM 87410
Phone: (505) 334-6178 Fax: (505) 334-6170
District IV
1220 S. St. Francis Dr., Santa Fe, NM 87505
Phone: (505) 476-3460 Fax: (505) 476-3462

State of New Mexico
Energy, Minerals & Natural Resources
Department
OIL CONSERVATION DIVISION
1220 South St. Francis Dr.
Santa Fe, NM 87505

FORM C-102

Revised August 1, 2011

Submit one copy to appropriate

District Office

☐ AMENDED REPORT
AS-COMPLETED

WELL LOCATION AND ACREAGE DEDICATION PLAT

¹ API Number 30-025-46100	² Pool Code 51020	³ Pool Name RED HILLS; LOWER BONE SPRING
⁴ Property Code 323122	⁵ Property Name GREEN DRAKE 16 FED COM	⁶ Well Number 403H
⁷ OGRID No. 7377	⁸ Operator Name EOG RESOURCES, INC.	⁹ Elevation 3390'

¹⁰Surface Location


UL or lot no.	Section	Township	Range	Lot Idn	Feet from the	North/South line	Feet from the	East/West line	County
J	16	25-S	33-E	-	2395'	SOUTH	1320'	EAST	LEA


¹¹Bottom Hole Location If Different From Surface

UL or lot no.	Section	Township	Range	Lot Idn	Feet from the	North/South line	Feet from the	East/West line	County
0	21	25-S	33-E	-	111'	SOUTH	2173'	EAST	LEA


¹² Dedicated Acres 480.00	¹³ Joint or Infill	¹⁴ Consolidation Code	¹⁵ Order No.
--	-------------------------------	----------------------------------	-------------------------

No allowable will be assigned to this completion until all interests have been consolidated or a non-standard unit has been approved by the division.

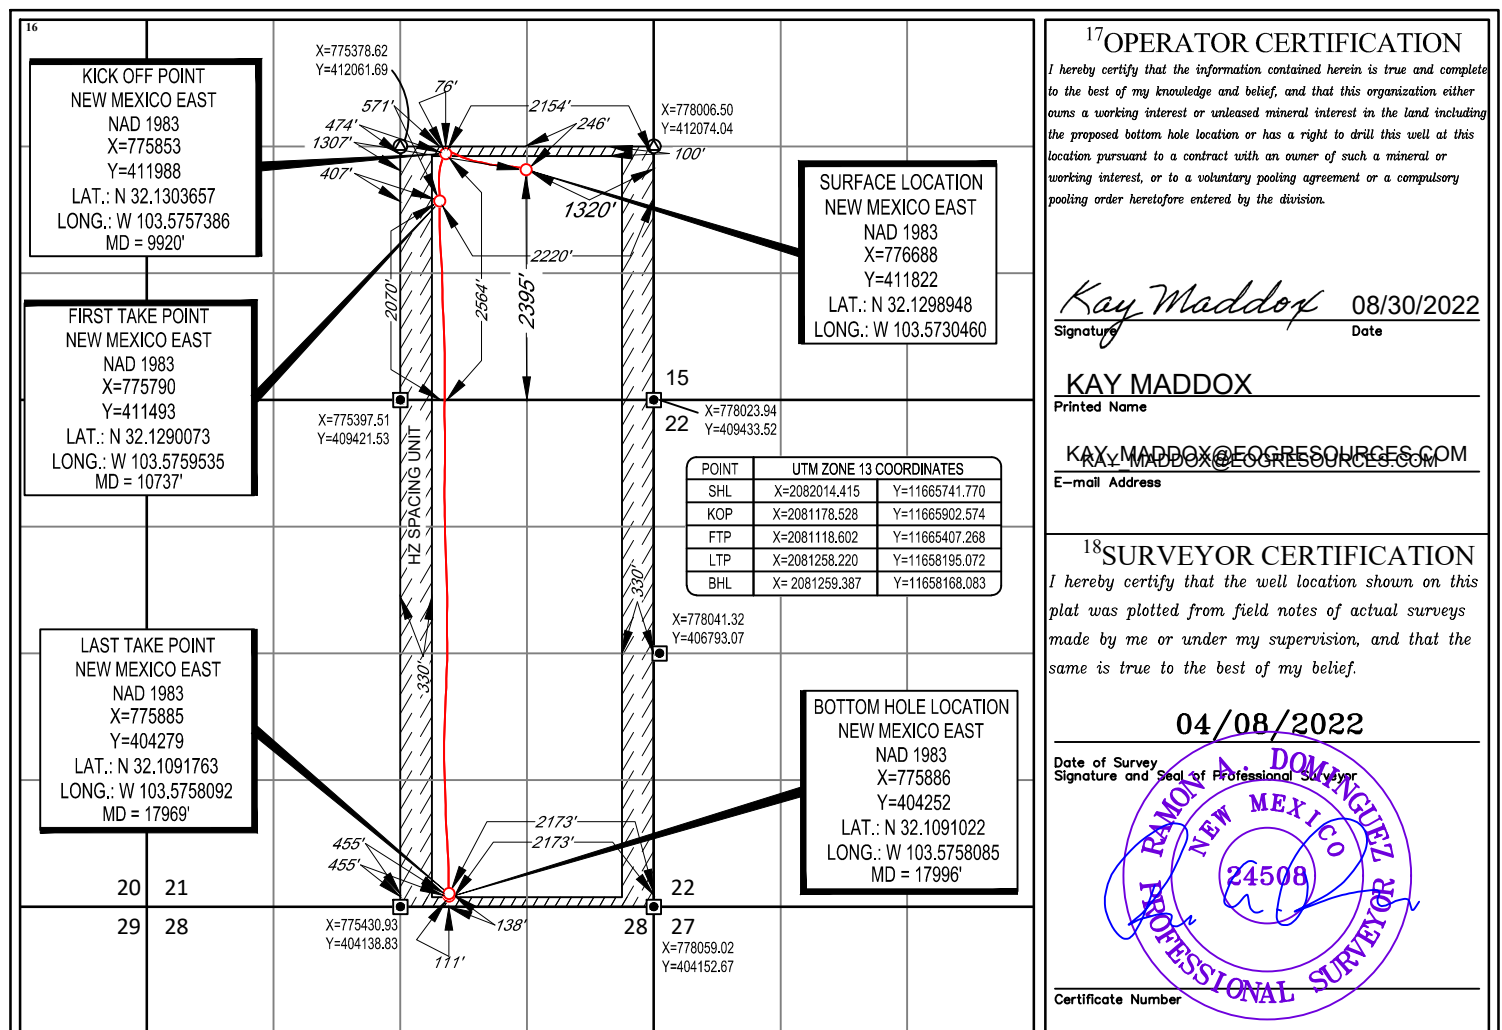

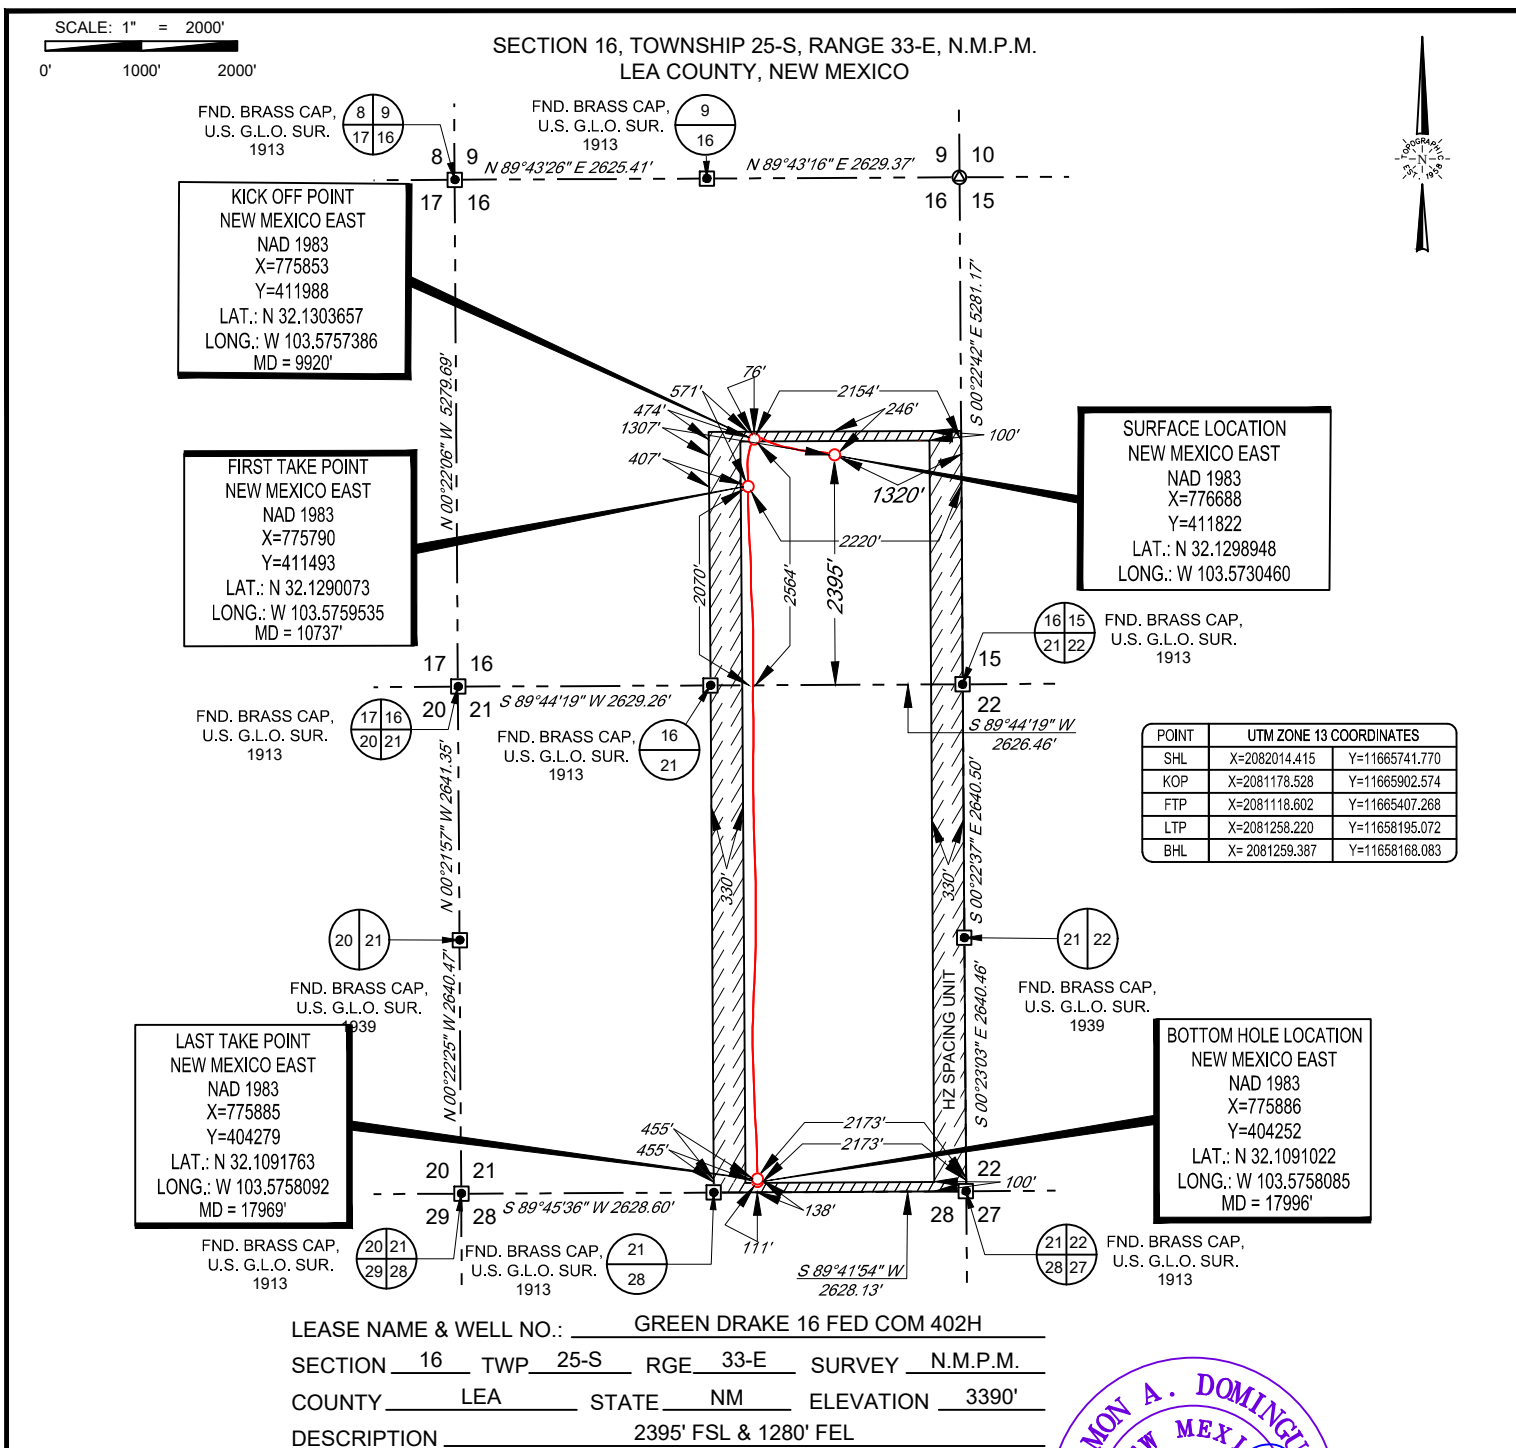

1400 EVERMAN PARKWAY, Ste. 146 • FT. WORTH, TEXAS 76140
TELEPHONE: (817) 744-7512 • FAX (817) 744-7554
2903 NORTH BIG SPRING • MIDLAND, TEXAS 79705
TELEPHONE: (432) 682-1653 OR (800) 767-1653 • FAX (432) 682-1743
WWW.TOPOGRAPHIC.COM

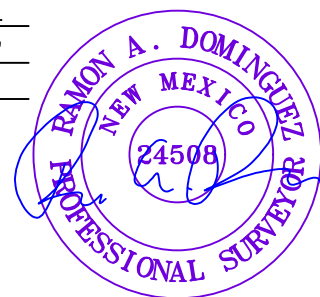

Ramon A. Dominguez, P.S. No. 24508
AUGUST 11, 2022

GREEN DRAKE 16 FED COM
402H
AS-DRILLED

REVISION:

NOTES:


1. ORIGINAL DOCUMENT SIZE: 8.5" X 11"
2. ALL BEARINGS, DISTANCES, AND COORDINATE VALUES CONTAINED HEREIN ARE GRID BASED UPON THE NEW MEXICO COORDINATE SYSTEM OF 1983, EAST ZONE, U.S. SURVEY FEET.
3. THIS WELL LOCATION SHOWN HEREON HAS BEEN SURVEYED ON THE GROUND UNDER MY SUPERVISION AND PREPARED ACCORDING TO THE EVIDENCE FOUND AT THE TIME OF SURVEY, AND DATA PROVIDED BY EOG RESOURCES, INC. THIS CERTIFICATION IS MADE AND LIMITED TO THOSE PERSONS OR ENTITIES SHOWN ON THE FACE OF THIS PLAT AND IS NON-TRANSFERABLE. THIS SURVEY IS CERTIFIED FOR THIS TRANSACTION ONLY.

DATE: 08/09/2022

FILE: AD_GREEN_DRAKE_16_FED_COM_403H

DRAWN BY: A.V.F.

SHEET: 2 OF 2

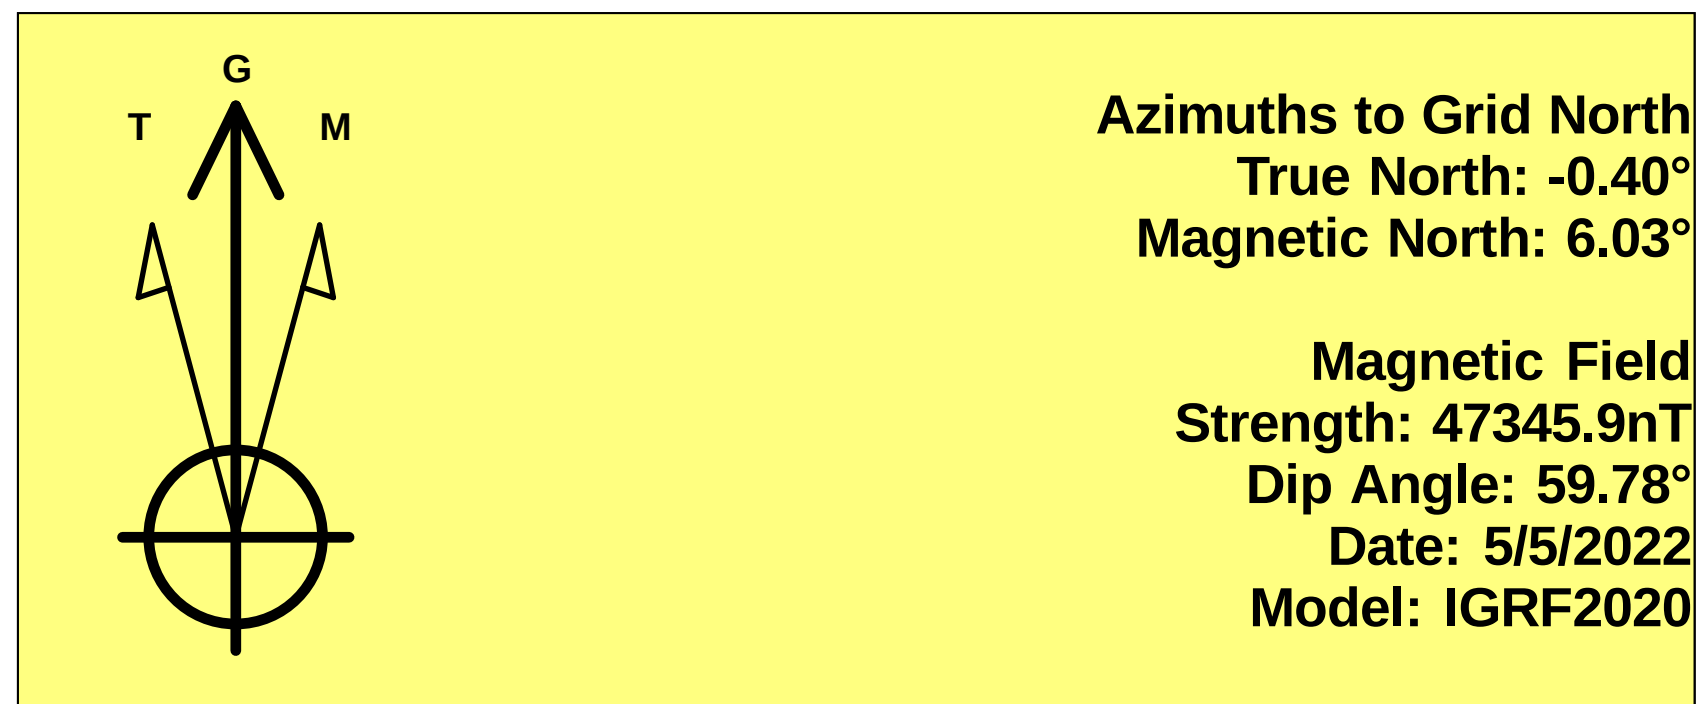

To convert a Magnetic Direction to a Grid Direction, Add 6.03°
To convert a Magnetic Direction to a True Direction, Add 6.43° East
To convert a True Direction to a Grid Direction, Subtract 0.40°










PROJECT DETAILS: Lea County, NM (NAD 83 NME)

Geodetic System: US State Plane 1983
Datum: North American Datum 1983
Ellipsoid: GRS 1980
Zone: New Mexico Eastern Zone
System Datum: Mean Sea Level

WELL DETAILS: #403H

KB = 27' @ 3417.0usft (Nabors 892)

Northings	KB = 27' @ 3417.0usft (Nabors 892)	3390.0
411822.00	Easting	776688.00
	Latitude	32° 7' 47.620 N
	Longitude	103° 34' 22.962 W

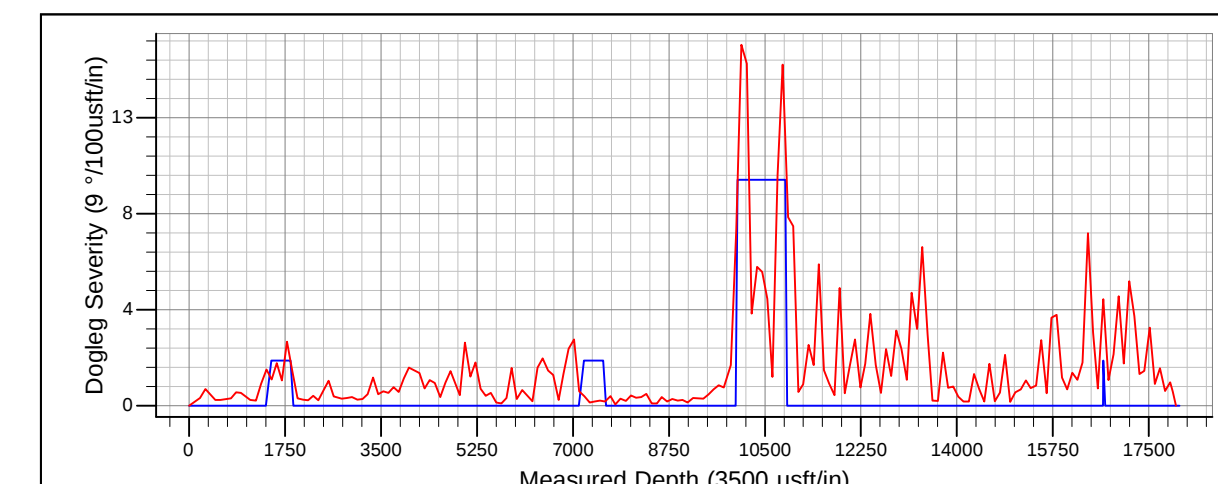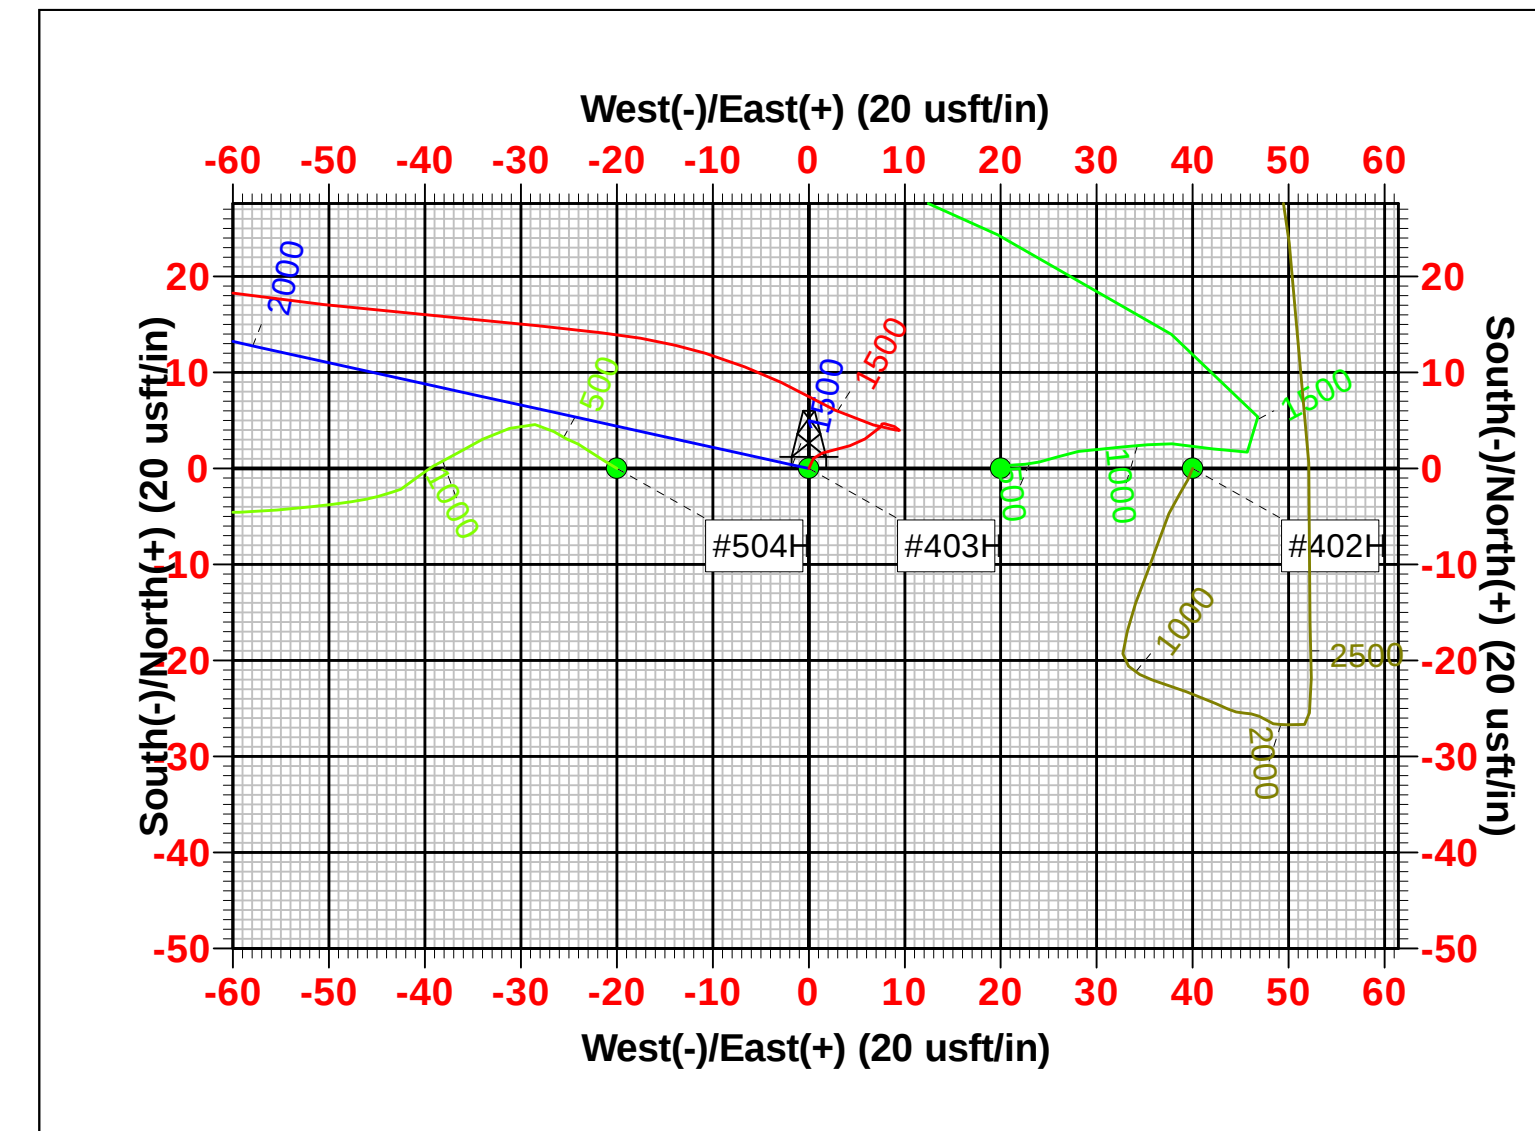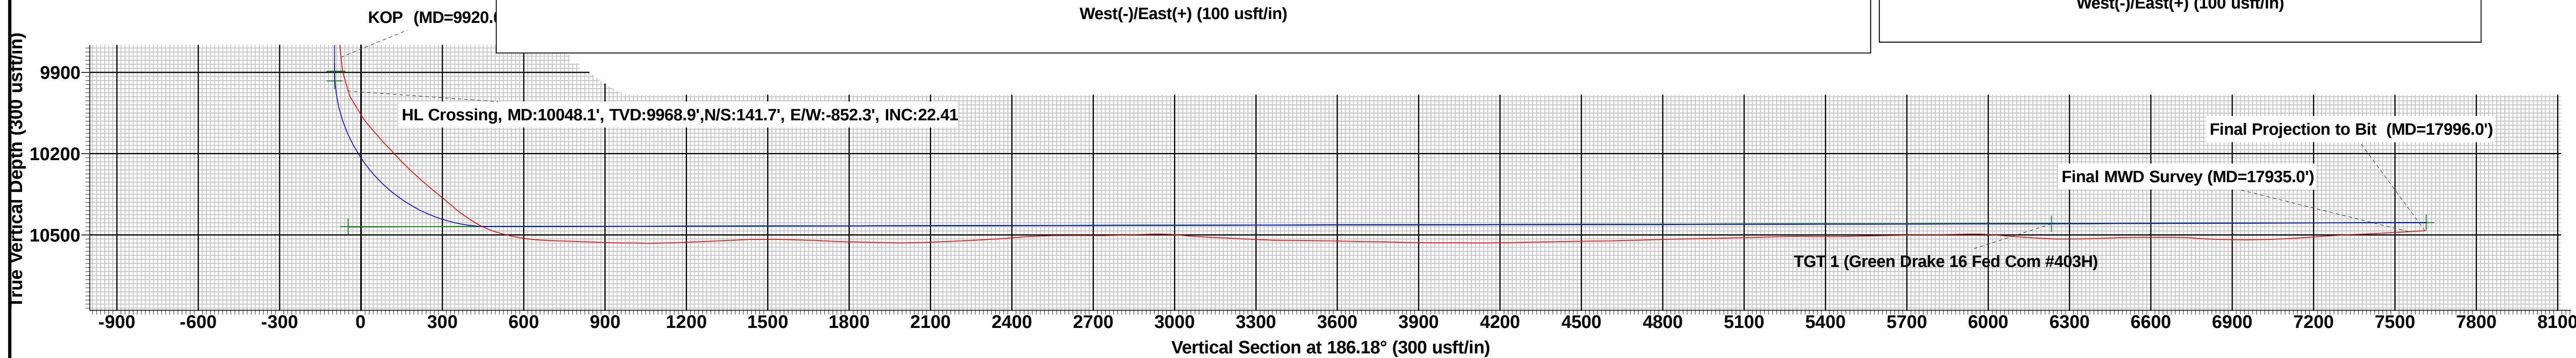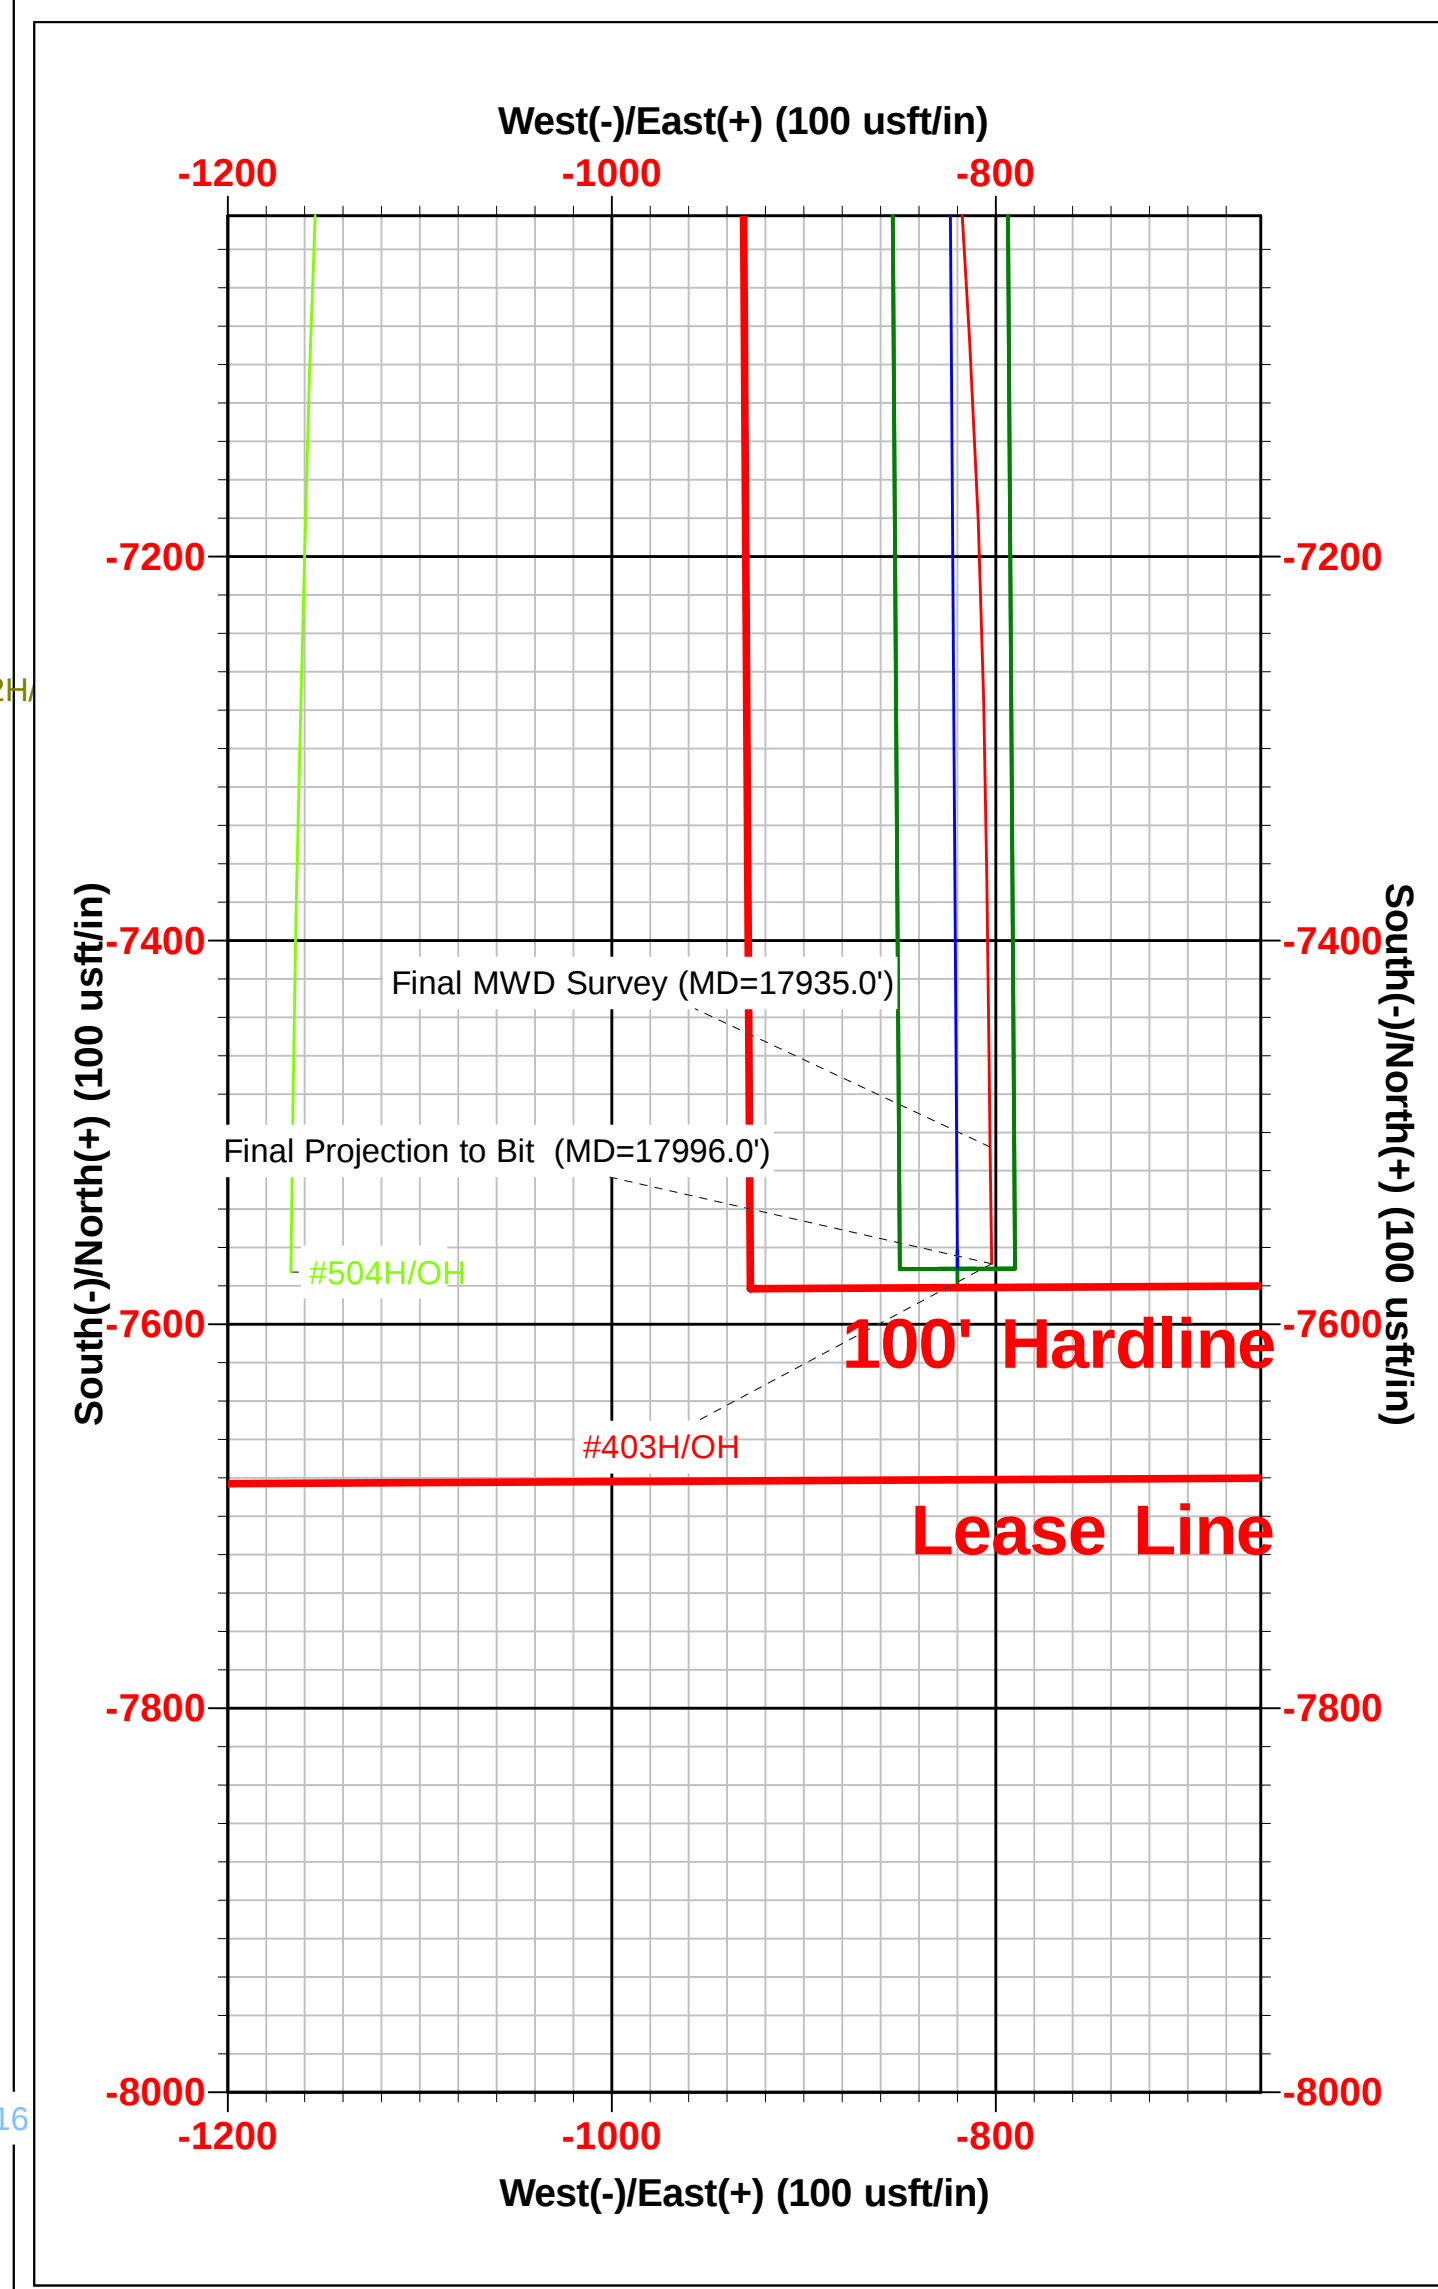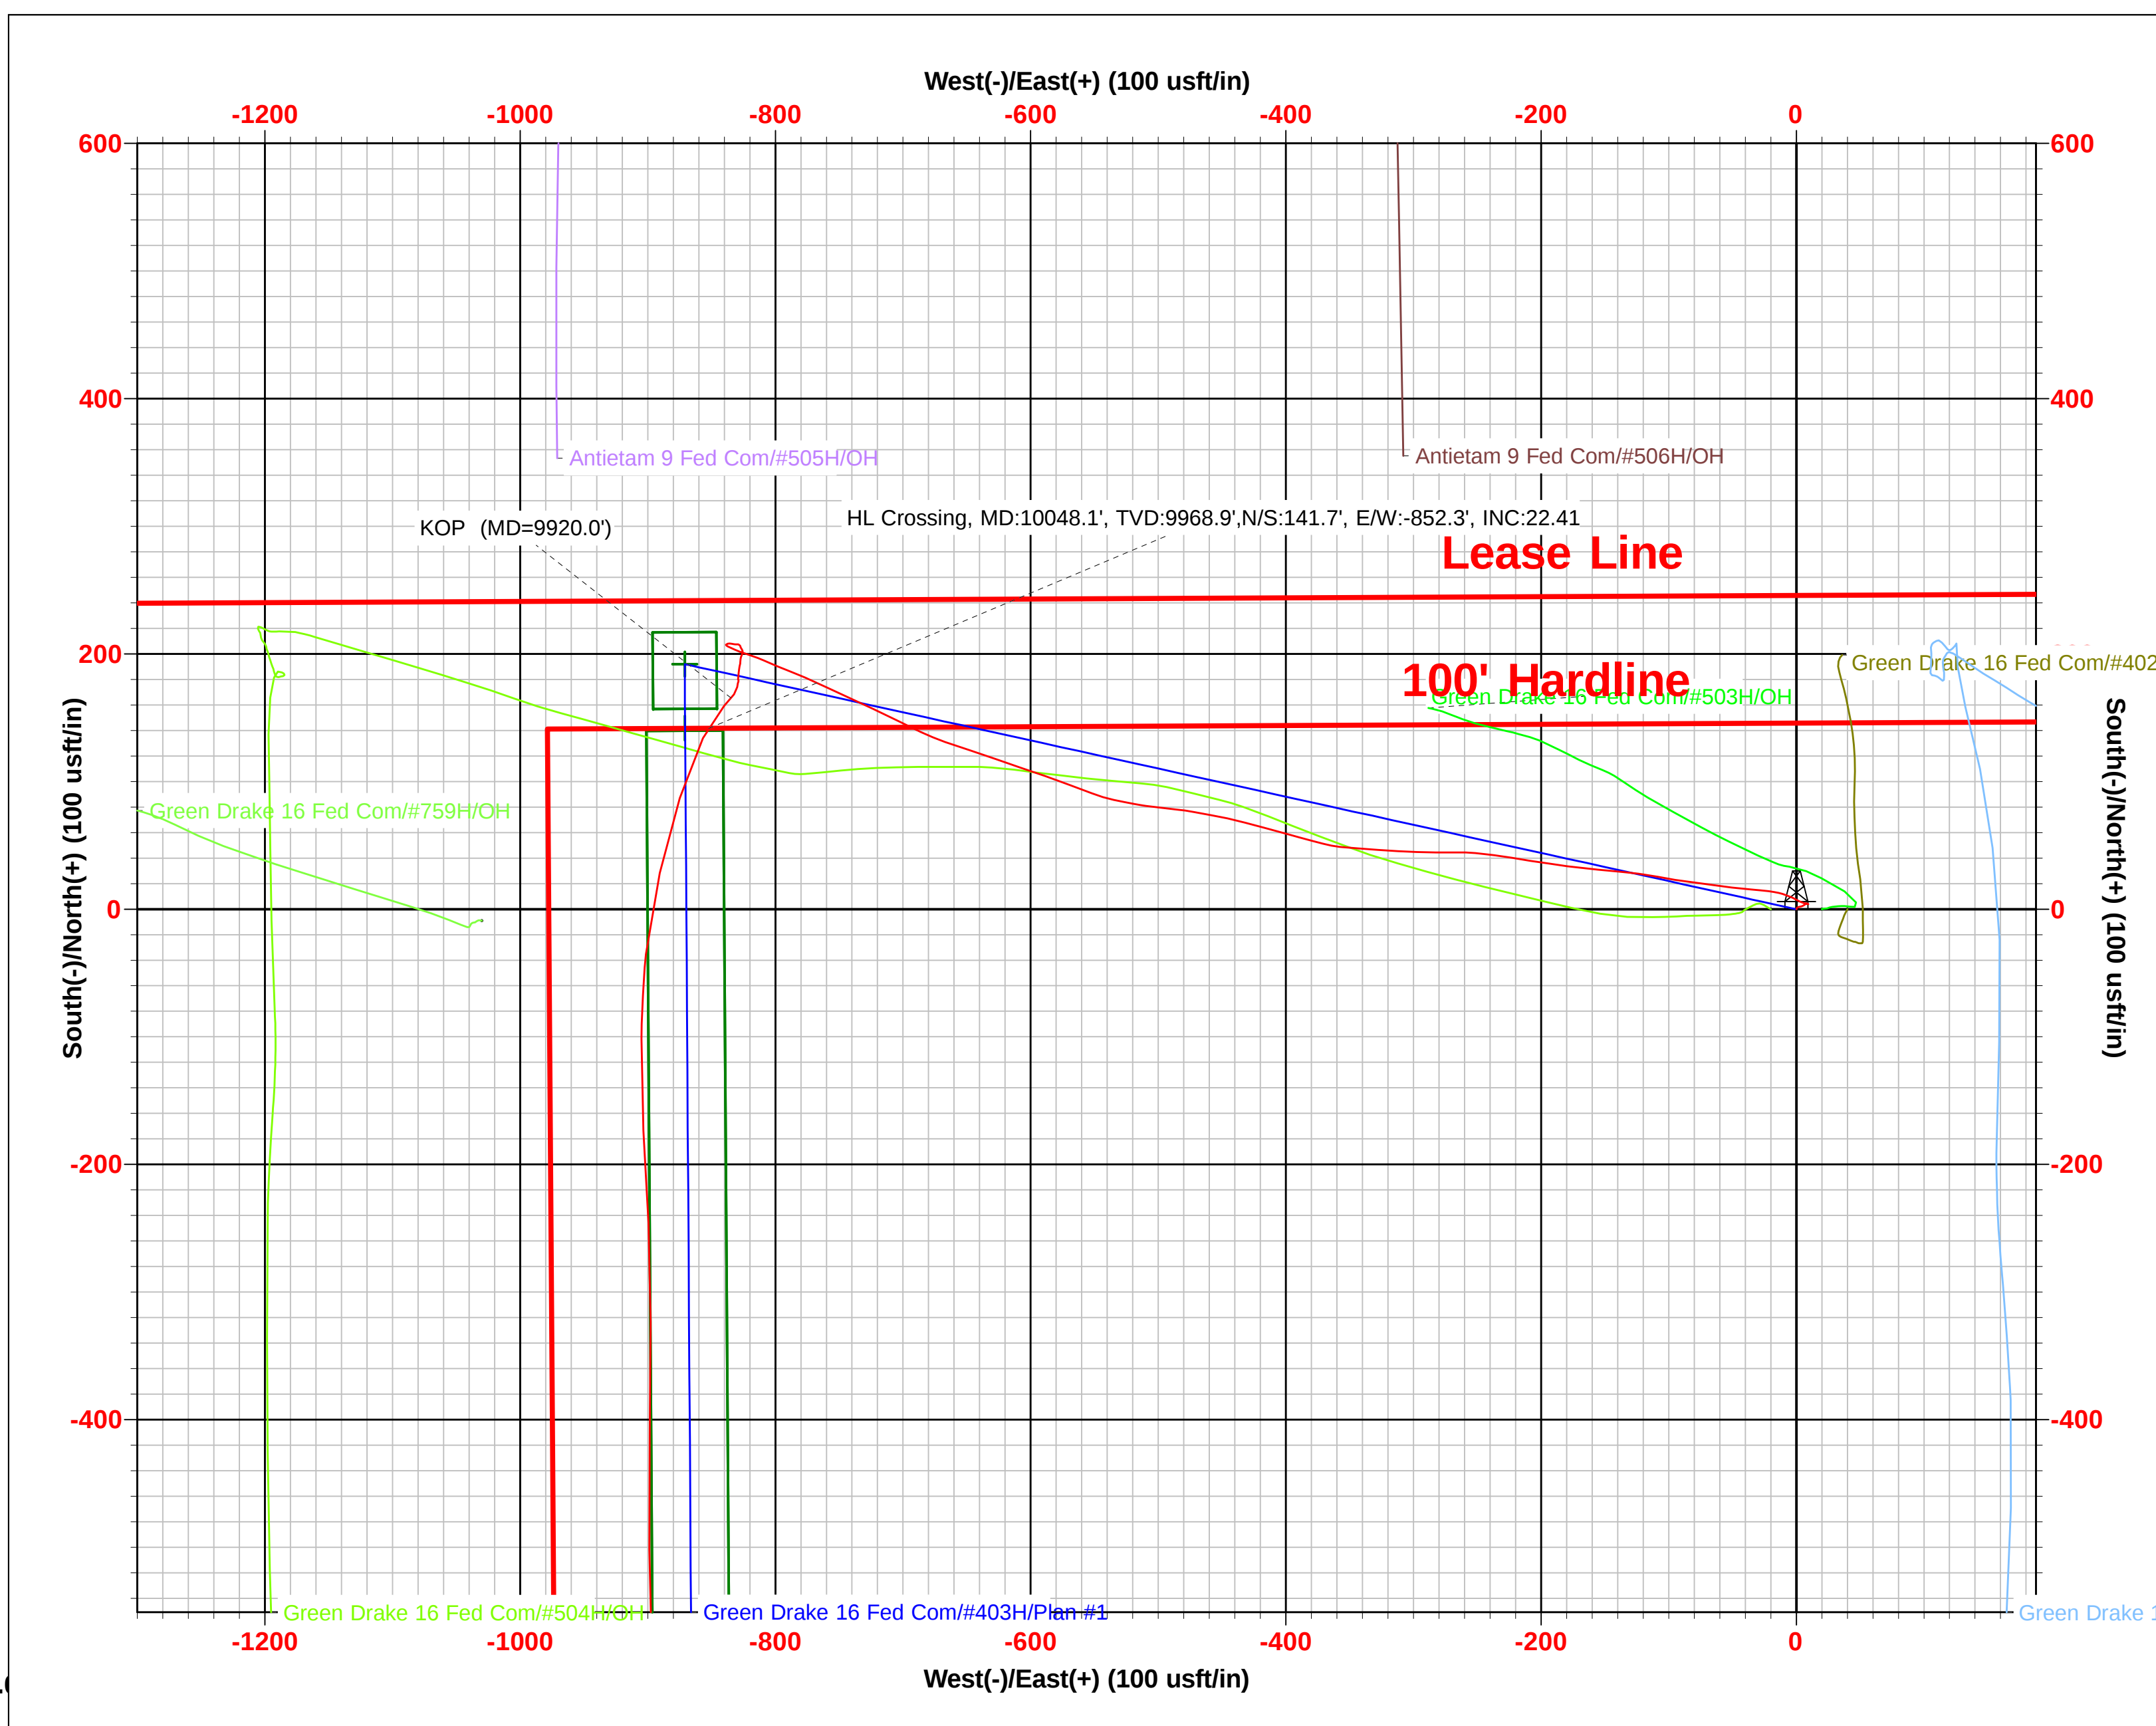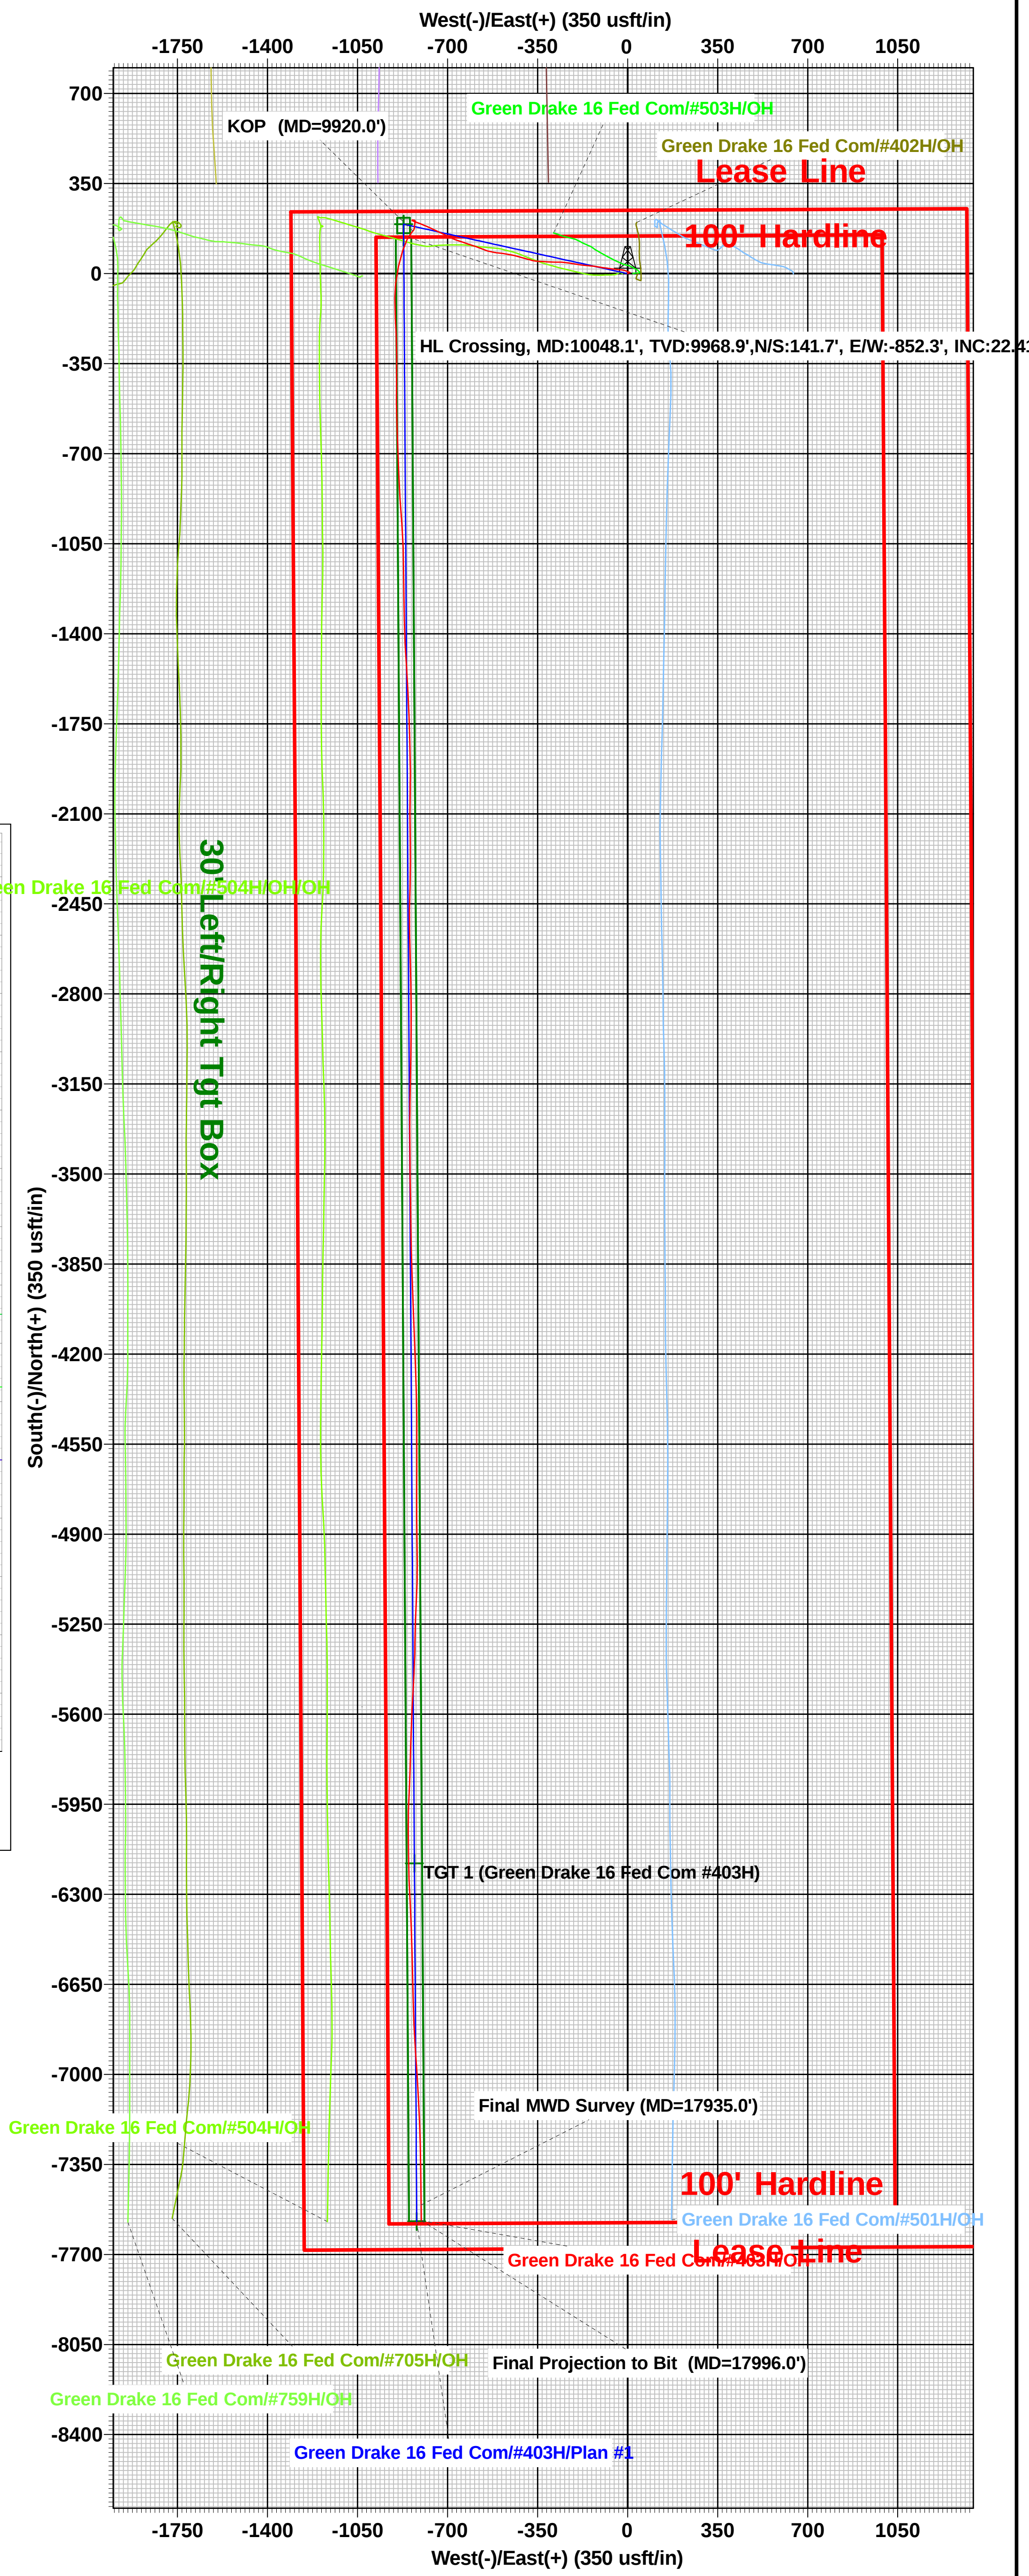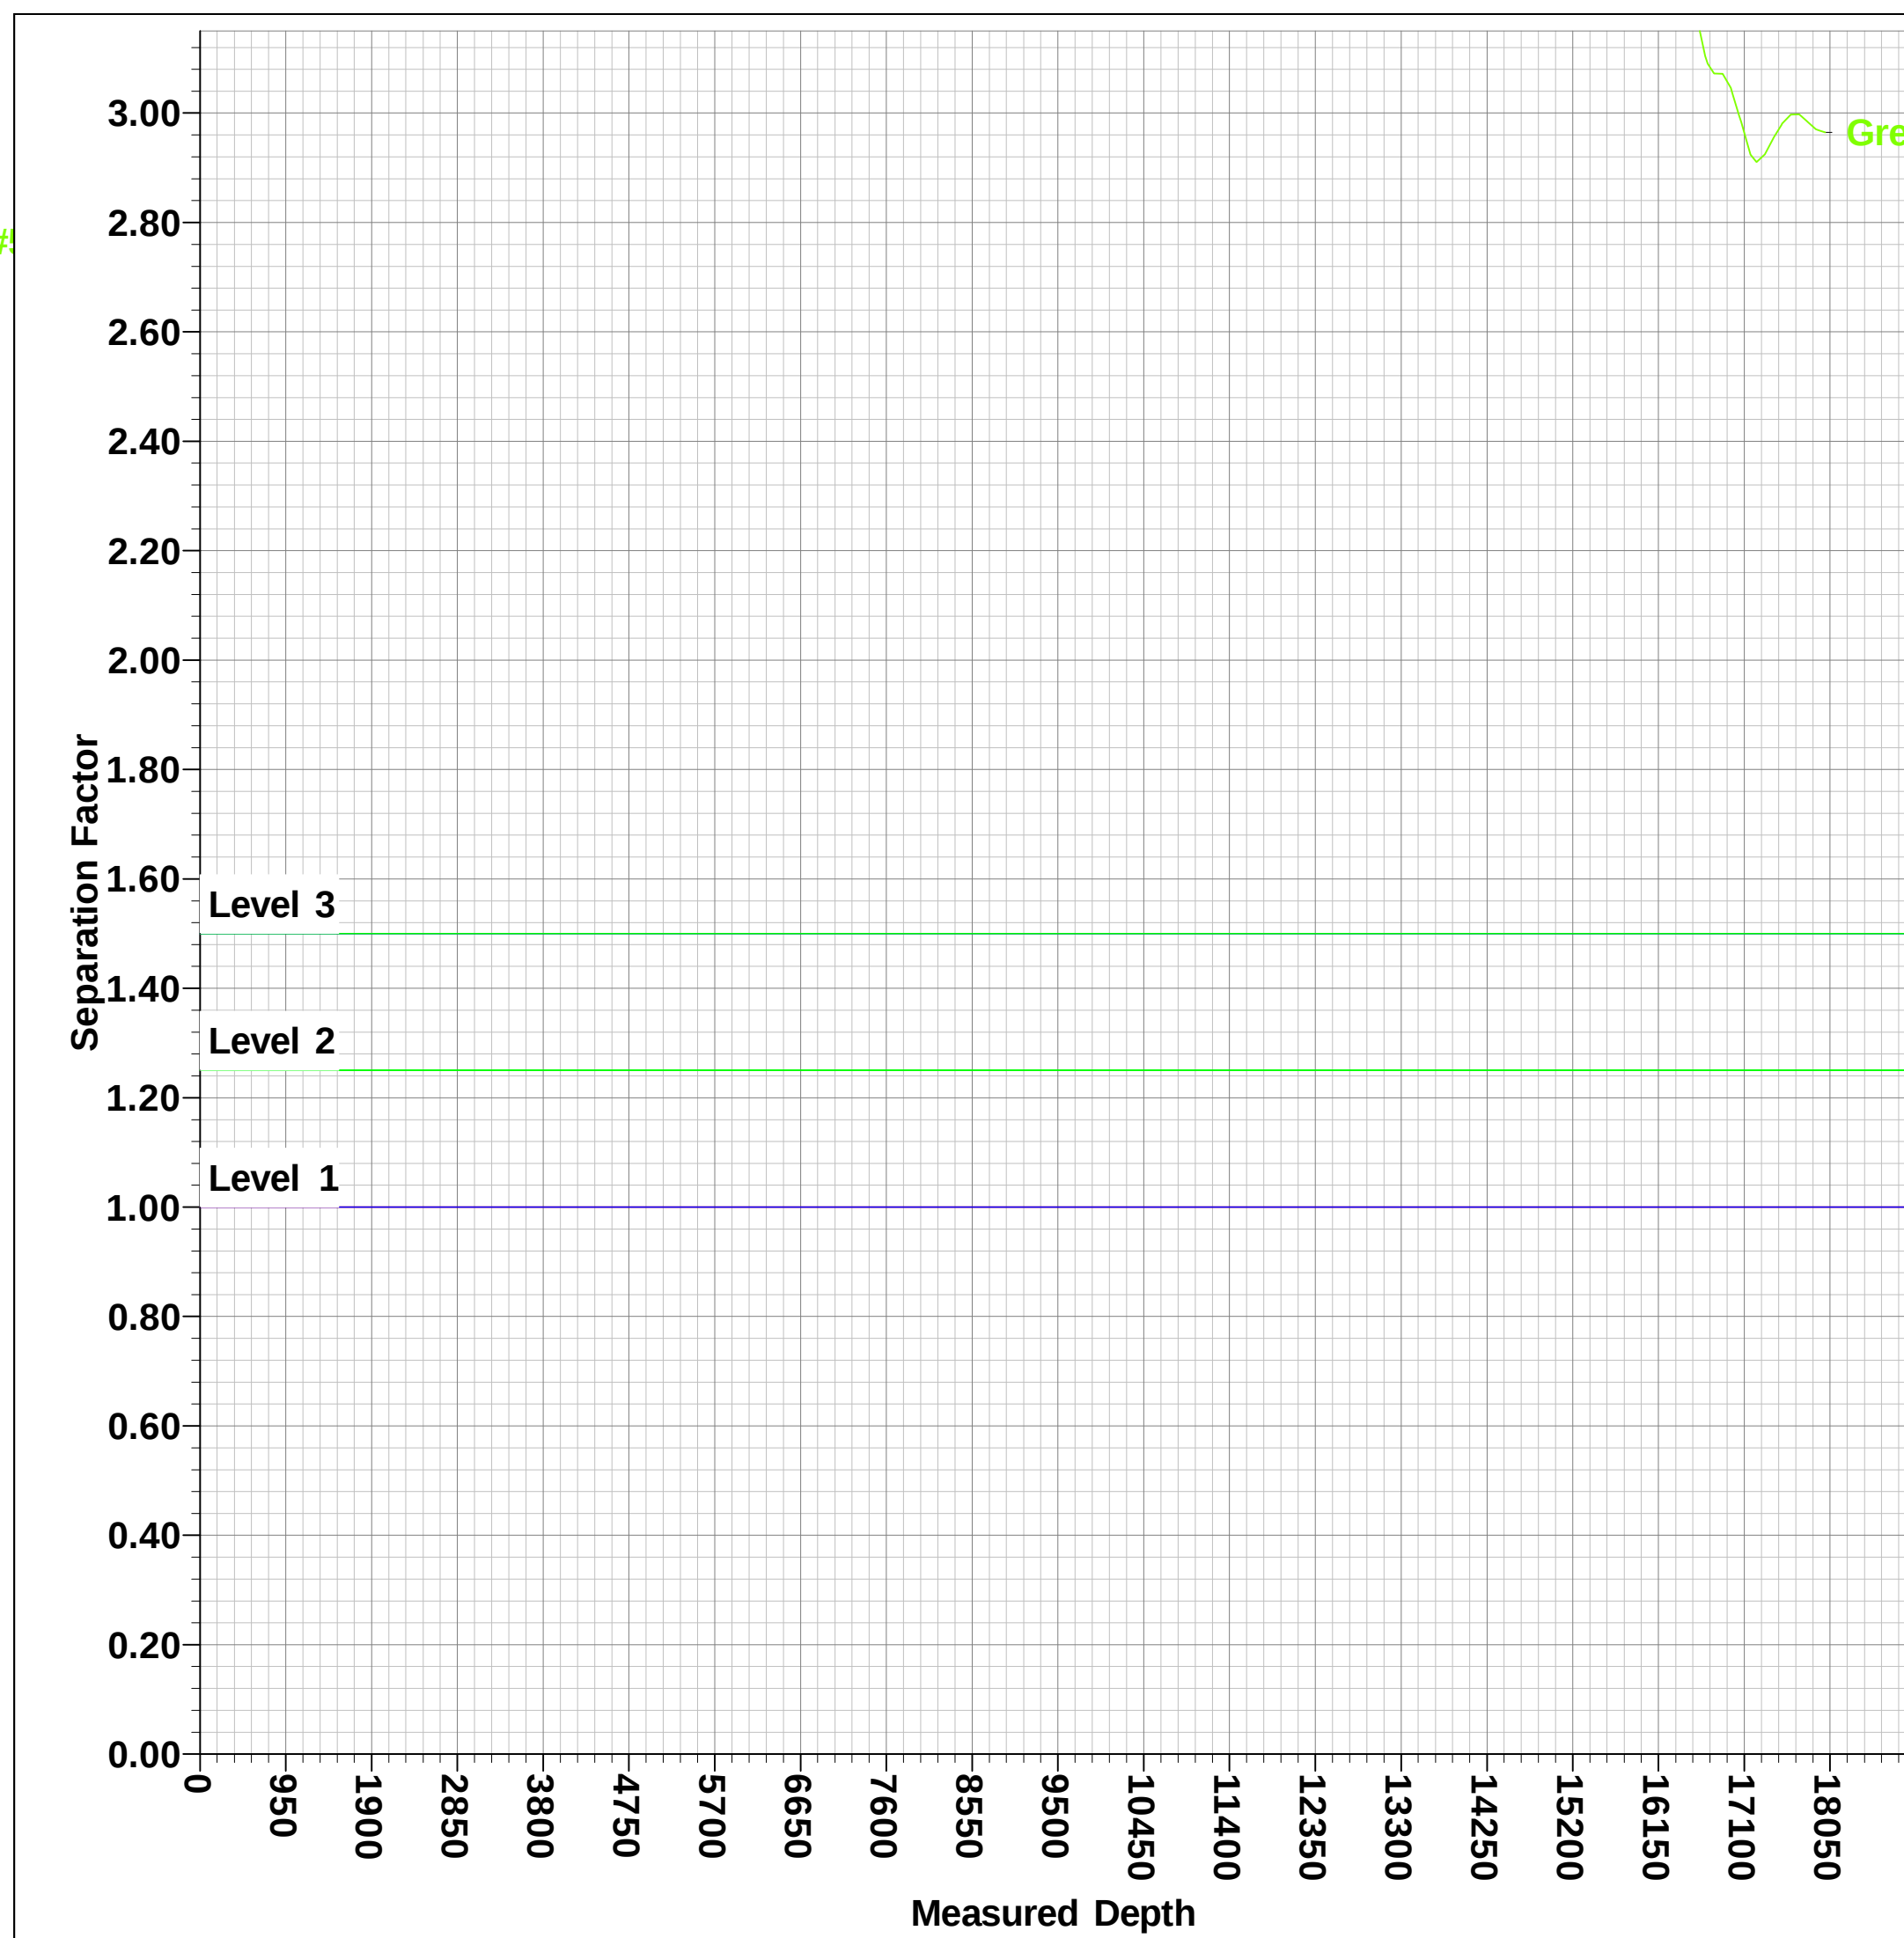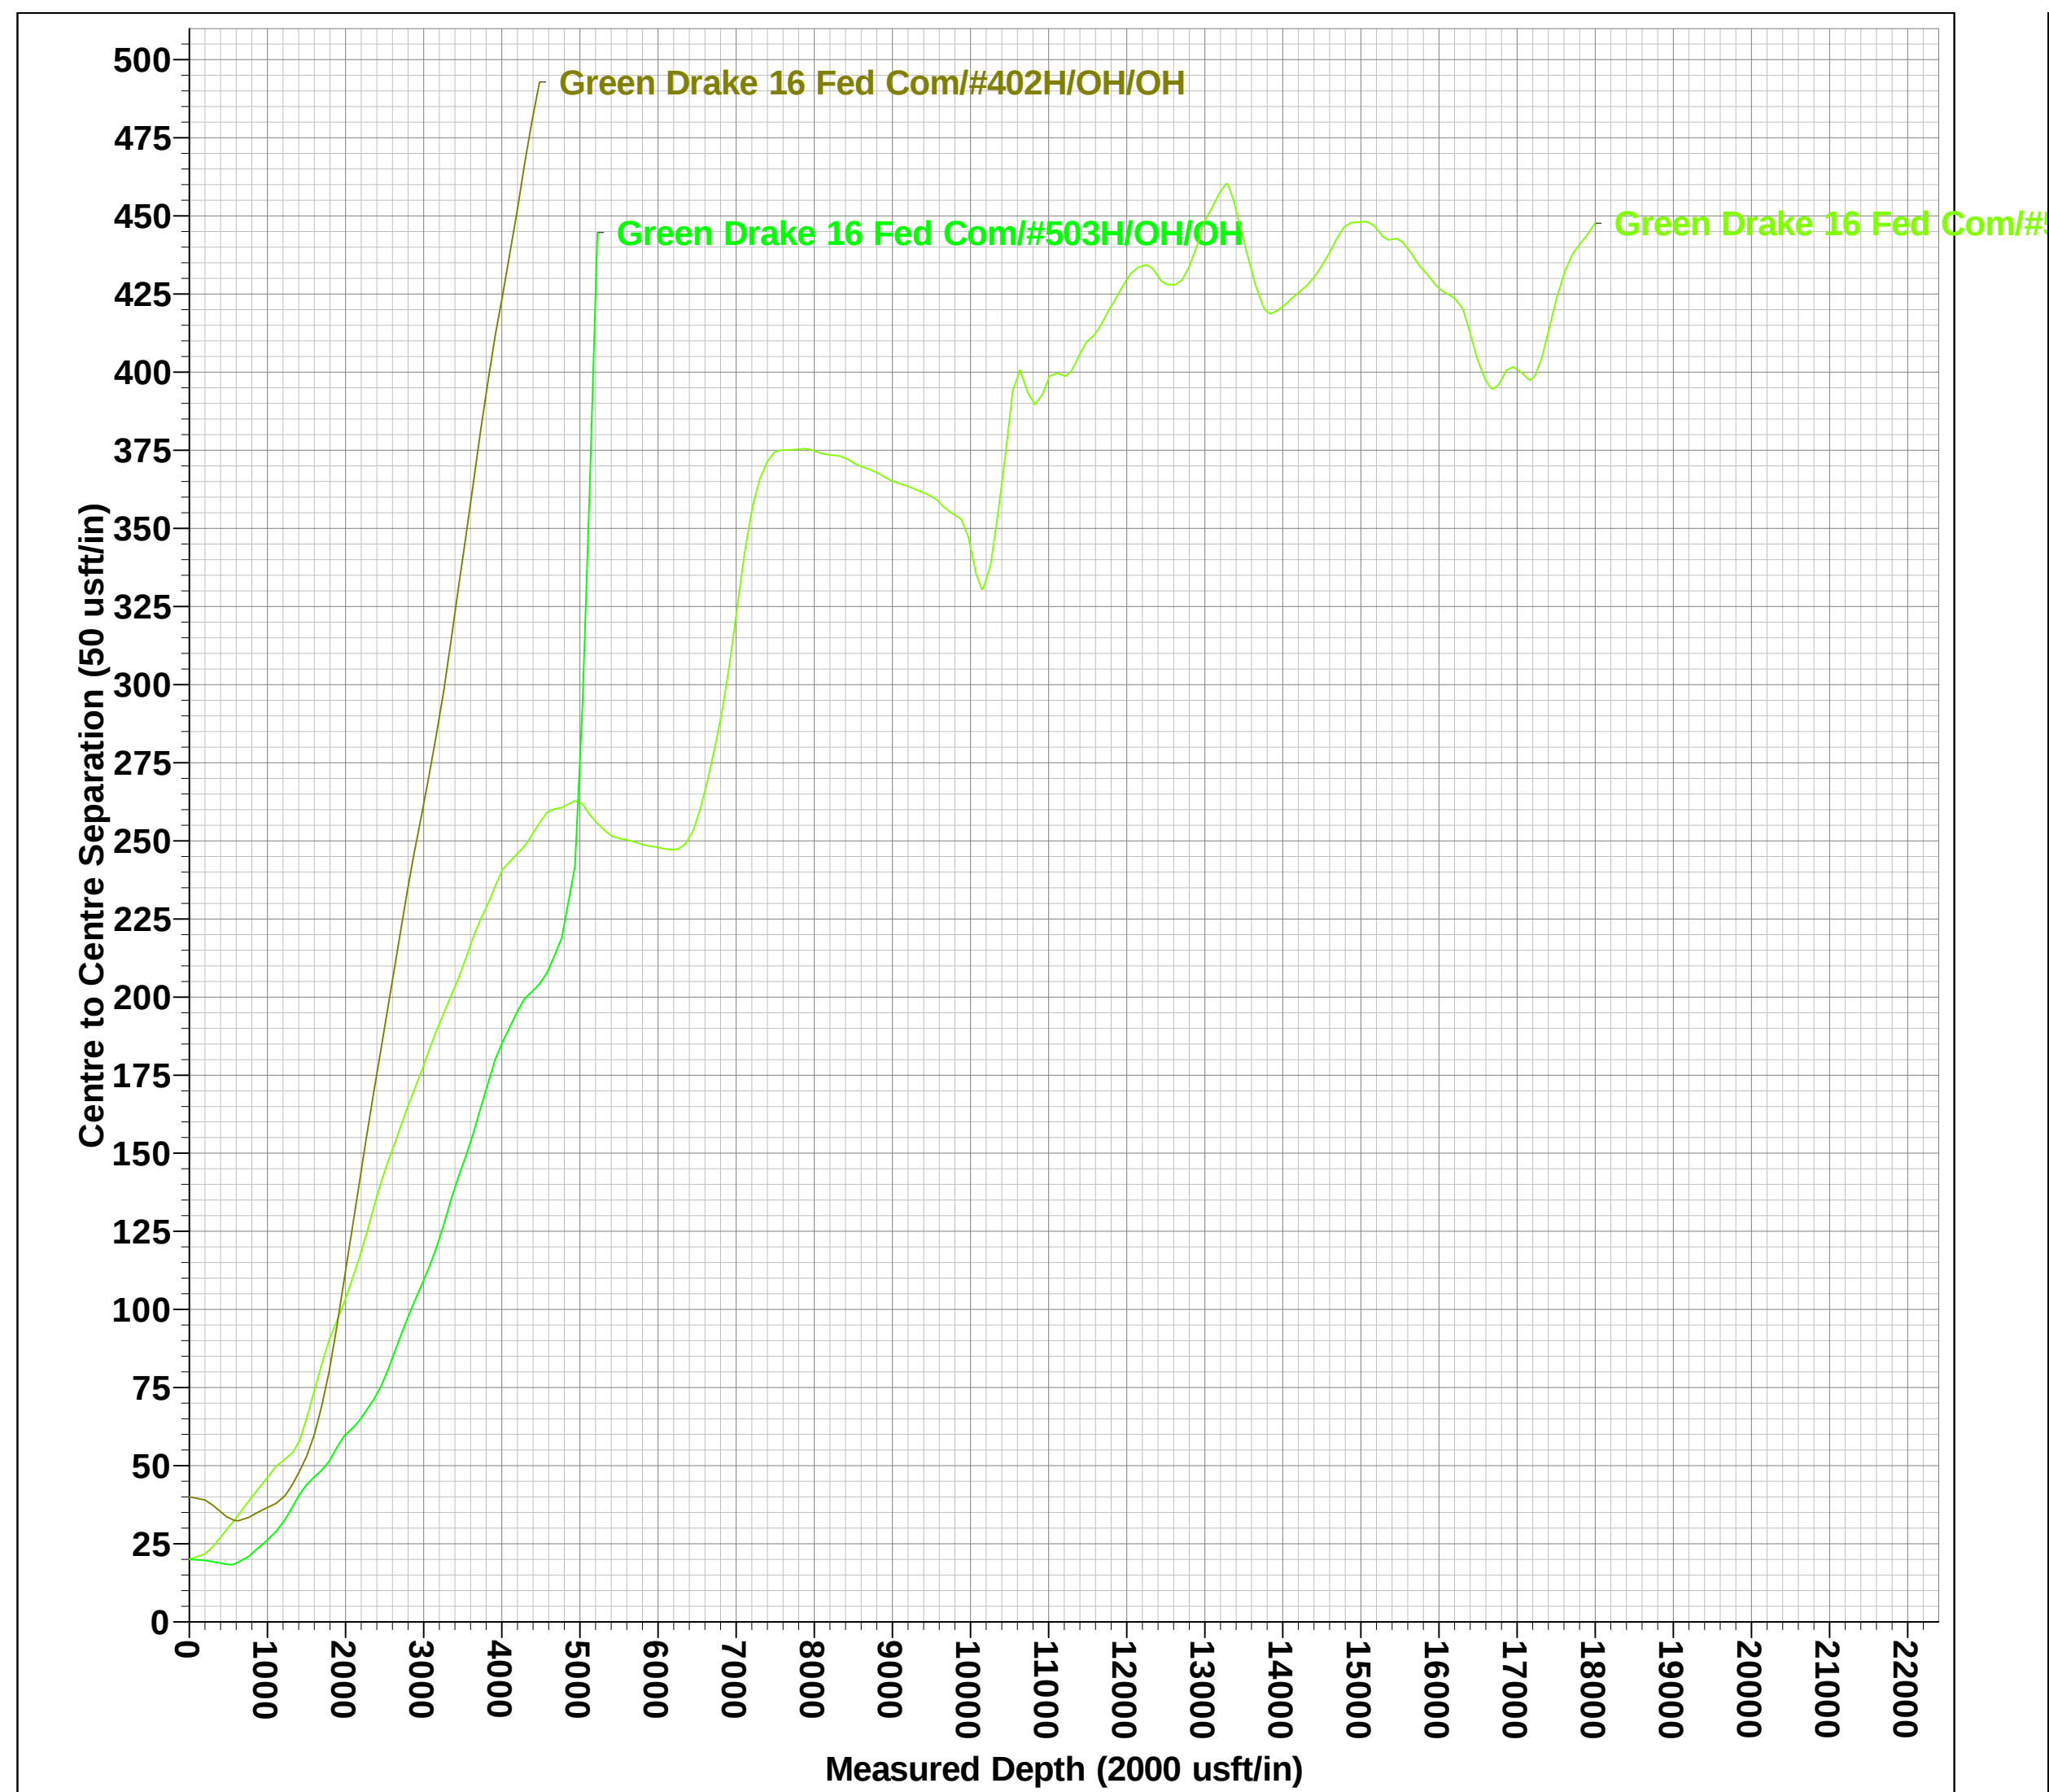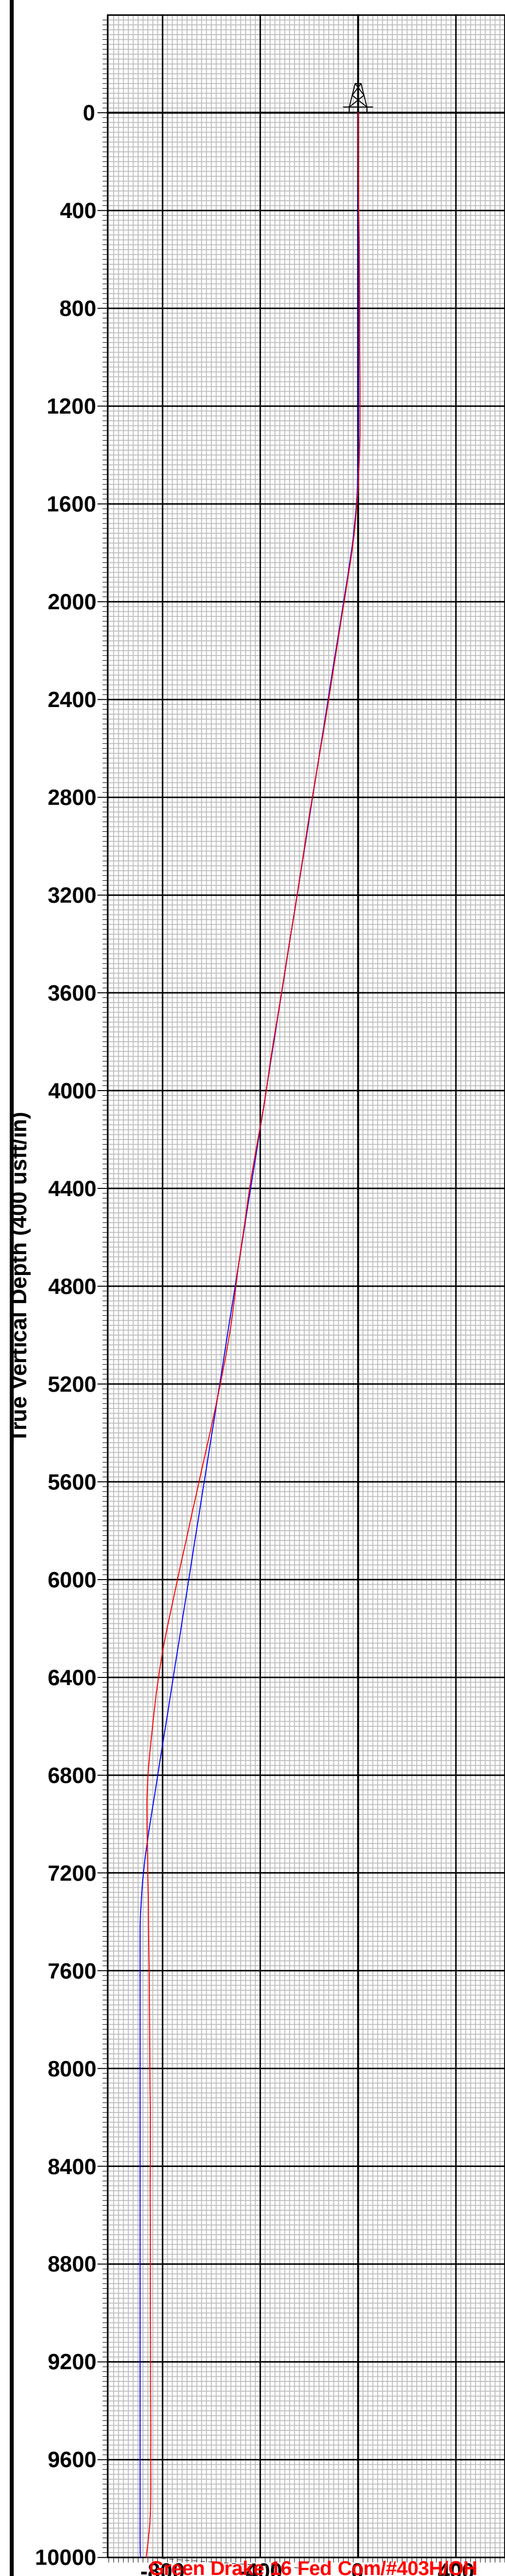



Midland

Lea County, NM (NAD 83 NME)

Green Drake 16 Fed Com

#403H

OH

Design: OH

Final PVA

20 June, 2022



Final PVA

Company:	Midland	Local Co-ordinate Reference:	Well #403H
Project:	Lea County, NM (NAD 83 NME)	TVD Reference:	KB = 27' @ 3417.0usft (Nabors 892)
Site:	Green Drake 16 Fed Com	MD Reference:	KB = 27' @ 3417.0usft (Nabors 892)
Well:	#403H	North Reference:	Grid
Wellbore:	OH	Survey Calculation Method:	Minimum Curvature
Design:	OH	Database:	PEDM

Project	Lea County, NM (NAD 83 NME)		
Map System:	US State Plane 1983	System Datum:	Mean Sea Level
Geo Datum:	North American Datum 1983		
Map Zone:	New Mexico Eastern Zone		

Site	Green Drake 16 Fed Com		
Site Position:		Northing:	411,802.00 usft
From:	Map	Easting:	773,380.00 usft
Position Uncertainty:	0.0 usft	Slot Radius:	13-3/16 "
		Latitude:	32° 7' 47.652 N
		Longitude:	103° 35' 1.431 W
		Grid Convergence:	0.40 °

Well	#403H		
Well Position	+N/-S	0.0 usft	Northing:
	+E/-W	0.0 usft	Easting:
Position Uncertainty	0.0 usft		Wellhead Elevation:
			usft
			Latitude:
			32° 7' 47.620 N
			Longitude:
			103° 34' 22.962 W
			Ground Level:
			3,390.0 usft

Wellbore	OH				
Magnetics	Model Name	Sample Date	Declination (°)	Dip Angle (°)	Field Strength (nT)
	IGRF2020	5/5/2022	6.43	59.78	47,345.88827125

Design	OH				
Audit Notes:					
Version:	1.0	Phase:	ACTUAL	Tie On Depth:	0.0
Vertical Section:	Depth From (TVD) (usft)	+N/-S (usft)	+E/-W (usft)	Direction (°)	
	0.0	0.0	0.0	186.18	

Survey Program	Date	6/20/2022			
From (usft)	To (usft)	Survey (Wellbore)	Tool Name	Description	
200.0	17,996.0	Stryker MWD #1 (OH)	EOG MWD+IFR1	MWD + IFR1	



Final PVA

Company:	Midland	Local Co-ordinate Reference:	Well #403H
Project:	Lea County, NM (NAD 83 NME)	TVD Reference:	KB = 27' @ 3417.0usft (Nabors 892)
Site:	Green Drake 16 Fed Com	MD Reference:	KB = 27' @ 3417.0usft (Nabors 892)
Well:	#403H	North Reference:	Grid
Wellbore:	OH	Survey Calculation Method:	Minimum Curvature
Design:	OH	Database:	PEDM

Survey										
MD (usft)	Inc (°)	Azi (azimuth) (°)	TVD (usft)	N/S (usft)	E/W (usft)	DLeg (°/100usft)	Build (°/100usft)	Turn (°/100usft)	High to Plan (usft)	Right to Plan (usft)
0.0	0.00	0.00	0.0	0.0	0.0	0.00	0.00	0.00	0.0	0.0
200.0	0.66	25.54	200.0	1.0	0.5	0.33	0.33	0.00	-1.2	0.0
300.0	0.79	86.09	300.0	1.6	1.4	0.74	0.13	60.55	-1.5	1.5
478.0	1.14	67.64	478.0	2.4	4.3	0.26	0.20	-10.37	-4.9	0.6
573.0	0.92	63.42	572.9	3.1	5.9	0.24	-0.23	-4.44	-6.6	0.1
761.0	0.44	28.88	760.9	4.4	7.5	0.32	-0.26	-18.37	-7.5	-4.5
855.0	0.13	239.90	854.9	4.6	7.6	0.59	-0.33	-158.49	8.9	-0.2
949.0	0.40	74.40	948.9	4.7	7.9	0.56	0.29	-176.06	-8.8	2.4
1,111.0	0.48	128.90	1,110.9	4.4	8.9	0.25	0.05	33.64	-4.2	9.0
1,222.0	0.22	127.84	1,221.9	4.0	9.5	0.23	-0.23	-0.95	-5.0	8.9
1,316.0	0.70	285.69	1,315.9	4.0	9.0	0.97	0.51	167.93	7.6	-6.3
1,410.0	2.20	281.65	1,409.9	4.5	6.7	1.60	1.60	-4.30	5.7	-5.8
1,505.0	2.99	298.79	1,504.8	6.1	2.8	1.16	0.83	18.04	1.3	-7.2
1,599.0	4.75	295.71	1,598.6	9.0	-2.9	1.88	1.87	-3.28	0.2	-8.4
1,694.0	5.49	287.19	1,693.2	12.0	-10.8	1.11	0.78	-8.97	1.1	-9.5
1,789.0	7.91	276.99	1,787.5	14.2	-21.6	2.83	2.55	-10.74	3.0	-8.9
1,882.0	9.27	274.88	1,879.5	15.6	-35.4	1.50	1.46	-2.27	3.2	-7.2
1,977.0	9.10	276.46	1,973.3	17.1	-50.5	0.32	-0.18	1.66	2.6	-5.6
2,073.0	9.10	278.13	2,068.1	19.0	-65.6	0.28	0.00	1.74	2.3	-4.3
2,168.0	9.01	276.82	2,161.9	20.9	-80.4	0.24	-0.09	-1.38	2.2	-2.9
2,262.0	8.84	279.28	2,254.8	23.0	-94.8	0.44	-0.18	2.62	2.2	-1.9
2,356.0	8.70	280.42	2,347.7	25.4	-108.9	0.24	-0.15	1.21	2.5	-1.3
2,451.0	9.19	277.69	2,441.5	27.7	-123.5	0.68	0.52	-2.87	2.6	-0.3
2,545.0	10.11	274.79	2,534.2	29.4	-139.2	1.11	0.98	-3.09	1.4	1.4
2,639.0	9.76	275.76	2,626.8	30.9	-155.3	0.41	-0.37	1.03	-0.2	3.2
2,784.0	9.41	277.43	2,769.7	33.7	-179.3	0.31	-0.24	1.15	-1.7	5.6
2,877.0	9.14	278.40	2,861.5	35.8	-194.2	0.34	-0.29	1.04	-2.1	6.8



Final PVA

Company: Midland
Project: Lea County, NM (NAD 83 NME)
Site: Green Drake 16 Fed Com
Well: #403H
Wellbore: OH
Design: OH

Local Co-ordinate Reference: Well #403H
TVD Reference: KB = 27' @ 3417.0usft (Nabors 892)
MD Reference: KB = 27' @ 3417.0usft (Nabors 892)
North Reference: Grid
Survey Calculation Method: Minimum Curvature
Database: PEDM

Survey										
MD (usft)	Inc (°)	Azi (azimuth) (°)	TVD (usft)	N/S (usft)	E/W (usft)	DLeg (°/100usft)	Build (°/100usft)	Turn (°/100usft)	High to Plan (usft)	Right to Plan (usft)
2,972.0	8.79	279.10	2,955.4	38.0	-208.8	0.39	-0.37	0.74	-2.0	7.7
3,067.0	8.53	278.92	3,049.3	40.2	-222.9	0.28	-0.27	-0.19	-1.5	8.6
3,161.0	8.75	277.78	3,142.2	42.3	-236.9	0.30	0.23	-1.21	-1.1	9.6
3,256.0	9.01	275.14	3,236.1	43.9	-251.5	0.51	0.27	-2.78	-1.5	11.1
3,351.0	9.71	269.26	3,329.8	44.5	-266.9	1.25	0.74	-6.19	-3.5	13.5
3,445.0	9.36	271.19	3,422.5	44.6	-282.5	0.50	-0.37	2.05	-4.2	16.8
3,540.0	8.75	271.19	3,516.3	44.9	-297.4	0.64	-0.64	0.00	-4.6	19.7
3,634.0	9.19	273.04	3,609.2	45.4	-312.0	0.56	0.47	1.97	-4.1	22.4
3,729.0	9.93	274.44	3,702.9	46.5	-327.8	0.82	0.78	1.47	-4.7	24.8
3,822.0	9.36	274.62	3,794.5	47.7	-343.3	0.61	-0.61	0.19	-5.8	26.8
3,917.0	8.22	274.71	3,888.4	48.9	-357.8	1.20	-1.20	0.09	-5.5	28.8
4,011.0	8.00	285.85	3,981.5	51.2	-370.8	1.69	-0.23	11.85	1.6	29.8
4,200.0	10.73	284.81	4,168.0	59.3	-400.5	1.45	1.44	-0.55	-0.2	28.3
4,295.0	10.02	285.69	4,261.4	63.8	-417.0	0.77	-0.75	0.93	-2.0	27.6
4,389.0	8.97	284.73	4,354.1	67.9	-431.9	1.13	-1.12	-1.02	-3.3	26.9
4,484.0	8.13	281.74	4,448.1	71.1	-445.7	1.00	-0.88	-3.15	-4.0	26.4
4,578.0	7.82	280.51	4,541.1	73.6	-458.5	0.38	-0.33	-1.31	-2.8	26.7
4,673.0	8.79	280.33	4,635.1	76.1	-471.9	1.02	1.02	-0.19	-1.8	27.2
4,767.0	7.47	276.20	4,728.2	78.1	-485.1	1.53	-1.40	-4.39	-2.4	28.1
4,938.0	6.68	276.64	4,897.9	80.4	-506.0	0.46	-0.46	0.26	3.4	30.9
5,033.0	9.27	280.68	4,992.0	82.5	-519.0	2.79	2.73	4.25	7.3	31.4
5,127.0	10.46	282.18	5,084.6	85.7	-534.8	1.30	1.27	1.60	6.7	31.5
5,222.0	11.30	290.70	5,177.9	90.8	-551.9	1.91	0.88	8.97	8.0	29.3
5,316.0	12.00	290.44	5,269.9	97.4	-569.7	0.75	0.74	-0.28	3.4	27.3
5,411.0	12.35	289.30	5,362.8	104.3	-588.6	0.45	0.37	-1.20	-2.5	25.4
5,506.0	12.88	288.86	5,455.5	111.0	-608.2	0.57	0.56	-0.46	-8.8	23.6
5,600.0	12.75	289.03	5,547.2	117.8	-627.9	0.14	-0.14	0.18	-15.1	22.0



Final PVA

Company:	Midland	Local Co-ordinate Reference:	Well #403H
Project:	Lea County, NM (NAD 83 NME)	TVD Reference:	KB = 27' @ 3417.0usft (Nabors 892)
Site:	Green Drake 16 Fed Com	MD Reference:	KB = 27' @ 3417.0usft (Nabors 892)
Well:	#403H	North Reference:	Grid
Wellbore:	OH	Survey Calculation Method:	Minimum Curvature
Design:	OH	Database:	PEDM

Survey										
MD (usft)	Inc (°)	Azi (azimuth) (°)	TVD (usft)	N/S (usft)	E/W (usft)	DLeg (°/100usft)	Build (°/100usft)	Turn (°/100usft)	High to Plan (usft)	Right to Plan (usft)
5,694.0	12.75	288.59	5,638.9	124.5	-647.5	0.10	0.00	-0.47	-21.5	20.2
5,788.0	12.44	288.68	5,730.6	131.0	-667.0	0.33	-0.33	0.10	-27.4	18.7
5,883.0	12.70	295.89	5,823.3	138.9	-686.0	1.67	0.27	7.59	-31.2	19.8
5,977.0	12.97	295.80	5,915.0	148.0	-704.8	0.29	0.29	-0.10	-37.9	16.3
6,072.0	12.31	295.71	6,007.7	157.0	-723.6	0.70	-0.69	-0.09	-44.3	12.8
6,261.0	12.13	294.13	6,192.4	173.9	-759.8	0.20	-0.10	-0.84	-55.9	5.1
6,355.0	10.55	294.30	6,284.5	181.5	-776.7	1.68	-1.68	0.18	-60.0	2.2
6,450.0	8.66	290.44	6,378.2	187.5	-791.3	2.10	-1.99	-4.06	-61.2	-4.4
6,545.0	7.30	294.57	6,472.3	192.5	-803.5	1.55	-1.43	4.35	-60.0	-2.6
6,640.0	6.11	290.44	6,566.6	196.8	-813.7	1.35	-1.25	-4.35	-56.0	-9.4
6,735.0	6.07	288.24	6,661.1	200.2	-823.2	0.25	-0.04	-2.32	-50.8	-13.2
6,829.0	4.88	294.39	6,754.7	203.4	-831.6	1.41	-1.27	6.54	-46.5	-10.3
6,923.0	2.51	294.83	6,848.5	205.9	-837.1	2.52	-2.52	0.47	-38.2	-13.1
7,018.0	0.79	36.87	6,943.4	207.3	-838.6	2.93	-1.81	107.41	-11.3	28.5
7,112.0	1.01	73.17	7,037.4	208.0	-837.4	0.64	0.23	38.62	-6.2	22.8
7,207.0	0.88	96.29	7,132.4	208.2	-835.9	0.42	-0.14	24.34	-11.3	22.3
7,302.0	1.01	96.73	7,227.4	208.0	-834.3	0.14	0.14	0.46	-22.8	21.4
7,396.0	0.92	105.08	7,321.4	207.7	-832.8	0.18	-0.10	8.88	-28.0	24.9
7,490.0	0.84	92.51	7,415.4	207.5	-831.4	0.22	-0.09	-13.37	-38.1	17.4
7,585.0	0.75	82.14	7,510.4	207.6	-830.1	0.18	-0.09	-10.92	-42.7	9.8
7,680.0	0.57	113.60	7,605.4	207.4	-829.0	0.42	-0.19	33.12	-32.3	31.0
7,773.0	0.53	116.42	7,698.4	207.1	-828.2	0.05	-0.04	3.03	-31.6	32.5
7,867.0	0.44	149.20	7,792.4	206.6	-827.6	0.31	-0.10	34.87	-9.7	44.7
7,961.0	0.35	174.60	7,886.4	206.0	-827.4	0.21	-0.10	27.02	9.8	44.7
8,056.0	0.75	158.34	7,981.3	205.1	-827.2	0.45	0.42	-17.12	-4.0	45.6
8,150.0	1.01	144.10	8,075.3	203.9	-826.5	0.36	0.28	-15.15	-16.5	43.0
8,244.0	0.97	165.02	8,169.3	202.4	-825.8	0.38	-0.04	22.26	-1.6	46.4



Final PVA

Company: Midland
Project: Lea County, NM (NAD 83 NME)
Site: Green Drake 16 Fed Com
Well: #403H
Wellbore: OH
Design: OH

Local Co-ordinate Reference: Well #403H
TVD Reference: KB = 27' @ 3417.0usft (Nabors 892)
MD Reference: KB = 27' @ 3417.0usft (Nabors 892)
North Reference: Grid
Survey Calculation Method: Minimum Curvature
Database: PEDM

Survey											
MD (usft)	Inc (°)	Azi (azimuth) (°)	TVD (usft)	N/S (usft)	E/W (usft)	DLeg (°/100usft)	Build (°/100usft)	Turn (°/100usft)	High to Plan (usft)	Right to Plan (usft)	
8,338.0	0.97	194.02	8,263.3	200.9	-825.7	0.52	0.00	30.85	19.6	41.8	
8,433.0	1.01	198.86	8,358.3	199.3	-826.2	0.10	0.04	5.09	21.4	40.0	
8,527.0	1.01	204.04	8,452.3	197.8	-826.8	0.10	0.00	5.51	23.3	38.0	
8,621.0	0.97	182.95	8,546.3	196.2	-827.2	0.39	-0.04	-22.44	6.5	43.5	
8,716.0	1.14	184.18	8,641.3	194.5	-827.3	0.18	0.18	1.29	5.6	43.4	
8,810.0	1.41	188.04	8,735.2	192.4	-827.5	0.30	0.29	4.11	6.5	43.0	
8,905.0	1.32	196.31	8,830.2	190.2	-828.0	0.23	-0.09	8.71	10.3	41.8	
8,999.0	1.41	187.37	8,924.2	188.0	-828.5	0.25	0.10	-9.51	1.5	42.7	
9,093.0	1.54	186.46	9,018.1	185.6	-828.8	0.14	0.14	-0.97	-1.6	42.7	
9,187.0	1.23	185.06	9,112.1	183.3	-829.0	0.33	-0.33	-1.49	-4.9	42.6	
9,375.0	0.66	182.51	9,300.1	180.2	-829.2	0.30	-0.30	-1.36	-9.9	42.3	
9,469.0	0.53	137.95	9,394.1	179.4	-828.9	0.50	-0.14	-47.40	-37.5	22.8	
9,564.0	0.66	206.15	9,489.1	178.6	-828.9	0.71	0.14	71.79	6.5	43.7	
9,657.0	1.49	197.27	9,582.1	176.9	-829.5	0.91	0.89	-9.55	-2.1	44.1	
9,751.0	2.07	181.72	9,676.0	174.1	-829.9	0.80	0.62	-16.54	-16.7	41.6	
9,880.0	3.74	215.62	9,804.9	168.3	-832.4	1.80	1.29	26.28	3.2	45.2	
9,920.0	6.83	220.38	9,844.7	165.4	-834.7	7.80	7.73	11.90	3.3	44.8	
KOP (MD=9920.0')											
9,974.0	11.03	222.57	9,898.0	159.2	-840.3	7.80	7.78	4.05	-3.4	44.8	
10,048.1	22.41	210.43	9,968.9	141.7	-852.3	15.98	15.36	-16.38	-29.5	39.0	
HL Crossing, MD:10048.1', TVD:9968.9',N/S:141.7', E/W:-852.3', INC:22.41											
10,070.0	25.85	208.86	9,988.9	133.9	-856.7	15.98	15.71	-7.18	-36.7	36.5	
10,165.0	38.55	195.94	10,069.2	87.1	-874.9	15.14	13.37	-13.60	-72.3	15.8	
10,259.0	42.15	193.92	10,140.8	28.3	-890.6	4.07	3.83	-2.15	-98.1	0.3	
10,354.0	43.30	185.48	10,210.7	-35.1	-901.4	6.14	1.21	-8.88	-107.4	-23.8	
10,447.0	47.65	180.73	10,275.9	-101.3	-904.8	5.93	4.68	-5.11	-101.4	-34.8	
10,542.0	51.12	176.95	10,337.7	-173.3	-903.3	4.74	3.65	-3.98	-83.6	-37.4	



Final PVA

Company: Midland
Project: Lea County, NM (NAD 83 NME)
Site: Green Drake 16 Fed Com
Well: #403H
Wellbore: OH
Design: OH

Local Co-ordinate Reference: Well #403H
TVD Reference: KB = 27' @ 3417.0usft (Nabors 892)
MD Reference: KB = 27' @ 3417.0usft (Nabors 892)
North Reference: Grid
Survey Calculation Method: Minimum Curvature
Database: PEDM

Survey										
MD (usft)	Inc (°)	Azi (azimuth) (°)	TVD (usft)	N/S (usft)	E/W (usft)	DLeg (°/100usft)	Build (°/100usft)	Turn (°/100usft)	High to Plan (usft)	Right to Plan (usft)
10,636.0	49.93	176.78	10,397.5	-245.8	-899.4	1.27	-1.27	-0.18	-51.5	-34.5
10,731.0	59.08	180.64	10,452.6	-323.0	-897.8	10.18	9.63	4.06	-12.5	-30.5
10,825.0	73.27	180.29	10,490.5	-408.8	-898.4	15.10	15.10	-0.37	20.8	-31.9
10,920.0	81.19	179.94	10,511.5	-501.4	-898.6	8.34	8.34	-0.37	42.5	-32.4
11,013.0	88.22	177.65	10,520.0	-593.9	-896.7	7.95	7.56	-2.46	51.4	-30.8
11,107.0	88.00	178.18	10,523.1	-687.8	-893.3	0.61	-0.23	0.56	54.7	-28.0
11,200.0	87.47	177.48	10,526.8	-780.6	-889.7	0.94	-0.57	-0.75	58.5	-25.1
11,295.0	89.76	176.34	10,529.1	-875.5	-884.6	2.69	2.41	-1.20	61.0	-20.6
11,389.0	88.53	175.19	10,530.5	-969.2	-877.7	1.79	-1.31	-1.22	62.6	-14.3
11,484.0	93.32	178.71	10,529.0	-1,064.0	-872.6	6.26	5.04	3.71	61.2	-9.9
11,578.0	91.91	179.15	10,524.7	-1,157.9	-870.9	1.57	-1.50	0.47	57.1	-8.7
11,673.0	92.84	179.24	10,520.7	-1,252.8	-869.5	0.98	0.98	0.09	53.3	-8.0
11,767.0	92.40	179.24	10,516.5	-1,346.7	-868.3	0.47	-0.47	0.00	49.2	-7.4
11,861.0	88.22	176.69	10,515.9	-1,440.6	-865.0	5.21	-4.45	-2.71	48.8	-4.7
11,955.0	88.70	176.86	10,518.5	-1,534.4	-859.7	0.54	0.51	0.18	51.5	0.0
12,049.0	87.08	176.43	10,521.9	-1,628.2	-854.2	1.78	-1.72	-0.46	55.1	4.9
12,142.0	89.01	178.36	10,525.1	-1,721.0	-849.9	2.93	2.08	2.08	58.4	8.5
12,237.0	88.26	178.18	10,527.4	-1,815.9	-847.1	0.81	-0.79	-0.19	60.9	10.7
12,331.0	89.49	179.41	10,529.2	-1,909.9	-845.1	1.85	1.31	1.31	62.9	12.1
12,425.0	92.88	181.17	10,527.3	-2,003.9	-845.6	4.06	3.61	1.87	61.1	11.0
12,519.0	92.26	179.59	10,523.1	-2,097.8	-846.2	1.80	-0.66	-1.68	57.0	9.8
12,614.0	92.57	179.15	10,519.1	-2,192.7	-845.2	0.57	0.33	-0.46	53.2	10.2
12,708.0	94.64	180.29	10,513.1	-2,286.5	-844.7	2.51	2.20	1.21	47.4	10.0
12,803.0	93.85	181.26	10,506.1	-2,381.2	-846.0	1.31	-0.83	1.02	40.6	8.1
12,897.0	90.73	180.99	10,502.4	-2,475.1	-847.8	3.33	-3.32	-0.29	37.0	5.6
12,989.0	89.76	178.89	10,502.0	-2,567.1	-847.7	2.51	-1.05	-2.28	36.8	5.1
13,084.0	89.49	177.83	10,502.6	-2,662.1	-845.0	1.15	-0.28	-1.12	37.5	7.2



Final PVA

Company: Midland
Project: Lea County, NM (NAD 83 NME)
Site: Green Drake 16 Fed Com
Well: #403H
Wellbore: OH
Design: OH

Local Co-ordinate Reference: Well #403H
TVD Reference: KB = 27' @ 3417.0usft (Nabors 892)
MD Reference: KB = 27' @ 3417.0usft (Nabors 892)
North Reference: Grid
Survey Calculation Method: Minimum Curvature
Database: PEDM

Survey										
MD (usft)	Inc (°)	Azi (azimuth) (°)	TVD (usft)	N/S (usft)	E/W (usft)	DLeg (°/100usft)	Build (°/100usft)	Turn (°/100usft)	High to Plan (usft)	Right to Plan (usft)
13,178.0	93.85	179.59	10,499.8	-2,756.0	-842.9	5.00	4.64	1.87	35.0	8.7
13,273.0	90.64	179.24	10,496.1	-2,850.9	-841.9	3.40	-3.38	-0.37	31.4	9.1
13,367.0	84.18	180.64	10,500.4	-2,944.7	-841.8	7.03	-6.87	1.49	35.8	8.6
13,462.0	87.16	180.82	10,507.5	-3,039.4	-843.0	3.14	3.14	0.19	43.1	6.7
13,556.0	87.30	180.99	10,512.1	-3,133.3	-844.5	0.23	0.15	0.18	47.8	4.6
13,651.0	87.12	181.08	10,516.7	-3,228.2	-846.2	0.21	-0.19	0.09	52.6	2.3
13,746.0	89.05	179.94	10,519.9	-3,323.1	-847.1	2.36	2.03	-1.20	56.0	0.8
13,840.0	89.71	179.59	10,520.9	-3,417.1	-846.7	0.79	0.70	-0.37	57.2	0.6
13,933.0	89.01	179.24	10,521.9	-3,510.1	-845.7	0.84	-0.75	-0.38	58.4	0.9
14,028.0	88.75	178.97	10,523.8	-3,605.1	-844.2	0.39	-0.27	-0.28	60.4	1.8
14,121.0	88.92	178.97	10,525.7	-3,698.0	-842.6	0.18	0.18	0.00	62.4	2.8
14,216.0	88.75	178.97	10,527.6	-3,793.0	-840.9	0.18	-0.18	0.00	64.5	3.9
14,309.0	89.85	178.27	10,528.8	-3,886.0	-838.6	1.40	1.18	-0.75	65.8	5.5
14,404.0	89.85	177.57	10,529.0	-3,980.9	-835.2	0.74	0.00	-0.74	66.2	8.4
14,499.0	89.67	177.57	10,529.4	-4,075.8	-831.2	0.19	-0.19	0.00	66.8	11.8
14,593.0	91.30	178.18	10,528.6	-4,169.8	-827.7	1.85	1.73	0.65	66.2	14.6
14,688.0	91.47	178.10	10,526.3	-4,264.7	-824.6	0.20	0.18	-0.08	64.0	17.1
14,783.0	90.95	177.92	10,524.3	-4,359.6	-821.3	0.58	-0.55	-0.19	62.2	19.8
14,877.0	90.77	180.03	10,522.9	-4,453.6	-819.6	2.25	-0.19	2.24	60.9	20.8
14,971.0	90.90	180.12	10,521.5	-4,547.6	-819.7	0.17	0.14	0.10	59.7	20.1
15,065.0	91.43	179.94	10,519.6	-4,641.5	-819.8	0.60	0.56	-0.19	58.0	19.4
15,160.0	92.09	180.12	10,516.7	-4,736.5	-819.8	0.72	0.69	0.19	55.2	18.8
15,254.0	91.08	179.85	10,514.1	-4,830.5	-819.8	1.11	-1.07	-0.29	52.8	18.2
15,348.0	90.86	179.15	10,512.5	-4,924.4	-819.0	0.78	-0.23	-0.74	51.3	18.4
15,443.0	91.52	179.68	10,510.5	-5,019.4	-818.0	0.89	0.69	0.56	49.5	18.7
15,537.0	91.74	182.40	10,507.9	-5,113.3	-819.7	2.90	0.23	2.89	47.0	16.4
15,632.0	91.25	182.58	10,505.4	-5,208.2	-823.8	0.55	-0.52	0.19	44.7	11.6



Final PVA

Company:	Midland	Local Co-ordinate Reference:	Well #403H
Project:	Lea County, NM (NAD 83 NME)	TVD Reference:	KB = 27' @ 3417.0usft (Nabors 892)
Site:	Green Drake 16 Fed Com	MD Reference:	KB = 27' @ 3417.0usft (Nabors 892)
Well:	#403H	North Reference:	Grid
Wellbore:	OH	Survey Calculation Method:	Minimum Curvature
Design:	OH	Database:	PEDM

Survey											
MD (usft)	Inc (°)	Azi (azimuth) (°)	TVD (usft)	N/S (usft)	E/W (usft)	DLeg (°/100usft)	Build (°/100usft)	Turn (°/100usft)	High to Plan (usft)	Right to Plan (usft)	
15,726.0	88.09	180.73	10,505.9	-5,302.2	-826.6	3.90	-3.36	-1.97	45.4	8.3	
15,820.0	91.60	182.14	10,506.2	-5,396.1	-828.9	4.02	3.73	1.50	45.8	5.3	
15,914.0	91.08	183.19	10,504.0	-5,490.0	-833.3	1.25	-0.55	1.12	43.8	0.4	
16,008.0	91.65	182.84	10,501.7	-5,583.8	-838.2	0.71	0.61	-0.37	41.7	-5.2	
16,101.0	90.55	182.05	10,499.9	-5,676.7	-842.2	1.46	-1.18	-0.85	40.1	-9.8	
16,196.0	90.81	180.99	10,498.8	-5,771.7	-844.7	1.15	0.27	-1.12	39.1	-12.9	
16,290.0	91.91	182.40	10,496.6	-5,865.6	-847.5	1.90	1.17	1.50	37.1	-16.3	
16,385.0	84.66	182.23	10,499.4	-5,960.4	-851.3	7.63	-7.63	-0.18	40.0	-20.9	
16,479.0	86.46	179.76	10,506.7	-6,054.1	-853.0	3.24	1.91	-2.63	47.5	-23.1	
16,573.0	86.33	179.06	10,512.6	-6,147.9	-852.0	0.76	-0.14	-0.74	53.5	-22.7	
16,666.0	90.59	178.01	10,515.1	-6,240.8	-849.6	4.72	4.58	-1.13	56.3	-20.9	
16,761.0	91.21	177.13	10,513.6	-6,335.7	-845.6	1.13	0.65	-0.93	55.2	-17.5	
16,855.0	93.32	177.48	10,509.9	-6,429.6	-841.2	2.28	2.24	0.37	51.8	-13.7	
16,950.0	88.88	178.71	10,508.1	-6,524.5	-838.0	4.85	-4.67	1.29	50.3	-11.2	
17,044.0	90.64	178.62	10,508.5	-6,618.4	-835.8	1.87	1.87	-0.10	51.1	-9.6	
17,139.0	85.41	178.80	10,511.8	-6,713.3	-833.7	5.51	-5.51	0.19	54.7	-8.1	
17,233.0	88.75	177.13	10,516.5	-6,807.1	-830.3	3.97	3.55	-1.78	59.8	-5.4	
17,326.0	89.89	176.51	10,517.6	-6,900.0	-825.2	1.40	1.23	-0.67	61.2	-0.9	
17,420.0	91.30	176.16	10,516.7	-6,993.8	-819.2	1.55	1.50	-0.37	60.6	4.5	
17,514.0	94.46	176.95	10,511.9	-7,087.5	-813.5	3.46	3.36	0.84	56.2	9.6	
17,608.0	93.89	177.65	10,505.1	-7,181.1	-809.1	0.96	-0.61	0.74	49.7	13.4	
17,702.0	92.84	178.80	10,499.6	-7,274.9	-806.2	1.66	-1.12	1.22	44.5	15.7	
17,797.0	92.40	179.24	10,495.2	-7,369.8	-804.6	0.65	-0.46	0.46	40.5	16.6	
17,891.0	93.36	179.41	10,490.5	-7,463.7	-803.5	1.04	1.02	0.18	36.1	17.1	
17,935.0	93.45	179.15	10,487.9	-7,507.6	-802.9	0.62	0.20	-0.59	33.7	17.4	
Final MWD Survey (MD=17935.0')											



Final PVA

Company:	Midland	Local Co-ordinate Reference:	Well #403H
Project:	Lea County, NM (NAD 83 NME)	TVD Reference:	KB = 27' @ 3417.0usft (Nabors 892)
Site:	Green Drake 16 Fed Com	MD Reference:	KB = 27' @ 3417.0usft (Nabors 892)
Well:	#403H	North Reference:	Grid
Wellbore:	OH	Survey Calculation Method:	Minimum Curvature
Design:	OH	Database:	PEDM

Survey										
MD (usft)	Inc (°)	Azi (azimuth) (°)	TVD (usft)	N/S (usft)	E/W (usft)	DLeg (°/100usft)	Build (°/100usft)	Turn (°/100usft)	High to Plan (usft)	Right to Plan (usft)
17,996.0	93.45	179.15	10,484.2	-7,568.5	-802.0	0.00	0.00	0.00	30.2	17.9
Final Projection to Bit (MD=17996.0')										

Design Annotations				
Measured Depth (usft)	Vertical Depth (usft)	Local Coordinates		Comment
		+N/-S (usft)	+E/-W (usft)	
9,920.0	9,844.7	165.4	-834.7	KOP (MD=9920.0')
10,048.1	9,968.9	141.7	-852.3	HL Crossing, MD:10048.1', TVD:9968.9',N/S:141.7', E/W:-852.3', INC:22.41
17,935.0	10,487.9	-7,507.6	-802.9	Final MWD Survey (MD=17935.0')
17,996.0	10,484.2	-7,568.5	-802.0	Final Projection to Bit (MD=17996.0')

Checked By: _____ Approved By: _____ Date: _____

I CERTIFY THIS SURVEY TO BE TRUE AND CORRECT TO THE BEST OF MY BELIEF AND KNOWLEDGE
08/22/2022

Intent ☐ As Drilled ☐

API #		
Operator Name:	Property Name:	Well Number

Kick Off Point (KOP)

UL	Section	Township	Range	Lot	Feet	From N/S	Feet	From E/W	County
Latitude					Longitude				NAD

First Take Point (FTP)

UL	Section	Township	Range	Lot	Feet	From N/S	Feet	From E/W	County
Latitude					Longitude				NAD

Last Take Point (LTP)

UL	Section	Township	Range	Lot	Feet	From N/S	Feet	From E/W	County
Latitude					Longitude				NAD

Is this well the defining well for the Horizontal Spacing Unit? ☐Is this well an infill well? ☐

If infill is yes please provide API if available, Operator Name and well number for Defining well for Horizontal Spacing Unit.

API #		
Operator Name:	Property Name:	Well Number

KZ 06/29/2018

Submit To Appropriate District Office Two Copies <u>District I</u> 1625 N. French Dr., Hobbs, NM 88240 <u>District II</u> 811 S. First St., Artesia, NM 88210 <u>District III</u> 1000 Rio Brazos Rd., Aztec, NM 87410 <u>District IV</u> 1220 S. St. Francis Dr., Santa Fe, NM 87505		State of New Mexico Energy, Minerals and Natural Resources Oil Conservation Division 1220 South St. Francis Dr. Santa Fe, NM 87505			Form C-105 Revised August 1, 2011					
WELL COMPLETION OR RECOMPLETION REPORT AND LOG										
4. Reason for filing: ☒ COMPLETION REPORT (Fill in boxes #1 through #31 for State and Fee wells only) ☐ C-144 CLOSURE ATTACHMENT (Fill in boxes #1 through #9, #15 Date Rig Released and #32 and/or #33; attach this and the plat to the C-144 closure report in accordance with 19.15.17.13.K NMAC)								5. Lease Name or Unit Agreement Name		
								GREEN DRAKE 16 FEDERAL COM 6. Well Number: 403H		
7. Type of Completion:										
☒ NEW WELL ☐ WORKOVER ☐ DEEPENING ☐ PLUGBACK ☐ DIFFERENT RESERVOIR ☐ OTHER _____										
8. Name of Operator								9. OGRID		
EOG RESOURCES INC								7377		
10. Address of Operator								11. Pool name or Wildcat		
PO BOX 2267 MIDLAND, TEXAS 79702								RED HILLS; LOWER BONE SPRING		
12. Location	Unit Ltr	Section	Township	Range	Lot	Feet from the	N/S Line	Feet from the	E/W Line	County
Surface:	J	16	25S	33E		2395	SOUTH	1320	EAST	LEA
BH:	O	21	25S	33E		111	SOUTH	2173	EAST	LEA
13. Date Spudded	14. Date T.D. Reached		15. Date Rig Released			16. Date Completed (Ready to Produce)		17. Elevations (DF and RKB, RT, GR, etc.)		
05/12/2022	06/19/2022		06/20/2022			08/21/2022		3404' GL		
18. Total Measured Depth of Well			19. Plug Back Measured Depth			20. Was Directional Survey Made?		21. Type Electric and Other Logs Run		
MD 17,996' TVD 10,484'			MD 17,969' TVD 10,484'			YES		None		
22. Producing Interval(s), of this completion - Top, Bottom, Name										
BONE SPRING 10,737 - 17,969'										
CASING RECORD (Report all strings set in well)										
CASING SIZE		WEIGHT LB./FT.		DEPTH SET		HOLE SIZE		CEMENTING RECORD		AMOUNT PULLED
13 3/8"		54.5# J-55		1165'		17 1/2"		955 CL C/CIRC		
9 5/8"		40# J-55		4862'		12 1/4"		1605 CL C/CIRC		
5 1/2"		20# HPP 110		17,977'		8 1/2"		2855 CL C & H TOC 3334' CBL		
24. LINER RECORD						25. TUBING RECORD				
SIZE	TOP	BOTTOM	SACKS CEMENT	SCREEN	SIZE	DEPTH SET	PACKER SET			
26. Perforation record (interval, size, and number)						27. ACID, SHOT, FRACTURE, CEMENT, SQUEEZE, ETC.				
10,737 - 17,969' 3 1/8", 1512 holes						DEPTH INTERVAL		AMOUNT AND KIND MATERIAL USED		
						10,737 - 17,969'		FRAC W/17,595,433 lbs proppant, 301,059 bbls load fld		
PRODUCTION										
Date First Production		Production Method (Flowing, gas lift, pumping - Size and type pump)				Well Status (Prod. or Shut-in)				
08/21/2022		Flowing				Producing				
Date of Test	Hours Tested	Choke Size	Prod'n For Test Period	Oil - Bbl	Gas - MCF	Water - Bbl.	Gas - Oil Ratio			
08/31/2022	24			1909	3053	7318	1599			
Flow Tubing Press.	Casing Pressure	Calculated 24-Hour Rate	Oil - Bbl.	Gas - MCF	Water - Bbl.	Oil Gravity - API - (Corr.)				
	593					44				
29. Disposition of Gas (Sold, used for fuel, vented, etc.)								30. Test Witnessed By		
SOLD										
31. List Attachments										
C-102, C-104, C-103, Directional Survey, H spacing										
32. If a temporary pit was used at the well, attach a plat with the location of the temporary pit.										
33. If an on-site burial was used at the well, report the exact location of the on-site burial:										
Latitude _____ Longitude _____ NAD 1927 1983										
I hereby certify that the information shown on both sides of this form is true and complete to the best of my knowledge and belief										
Signature Kay Maddox			Name Kay Maddox			Title Senior Regulatory Specialist			Date 09/02/2022	
E-mail Address kay_maddox@eogresources.com										

This form is to be filed with the appropriate District Office of the Division not later than 20 days after the completion of any newly-drilled or deepened well and not later than 60 days after completion of closure. When submitted as a completion report, this shall be accompanied by one copy of all electrical and radio-activity logs run on the well and a summary of all special tests conducted, including drill stem tests. All depths reported shall be measured depths. In the case of directionally drilled wells, true vertical depths shall also be reported. For multiple completions, items 11, 12 and 26-31 shall be reported for each zone.

Southeastern New Mexico			Northwestern New Mexico				
T. Anhy	Rustler	1041'	T. Canyon	Brushy	7519'	T. Ojo Alamo	T. Penn A "
T. Salt		1392'	T. Strawn			T. Kirtland	T. Penn. "B"
B. Salt		4675'	T. Atoka			T. Fruitland	T. Penn. "C"
T. Yates			T. Miss			T. Pictured Cliffs	T. Penn. "D"
T. 7 Rivers			T. Devonian			T. Cliff House	T. Leadville
T. Queen			T. Silurian			T. Menefee	T. Madison
T. Grayburg			T. Montoya			T. Point Lookout	T. Elbert
T. San Andres			T. Simpson			T. Mancos	T. McCracken
T. Glorieta			T. McKee			T. Gallup	T. Ignacio Otzte
T. Paddock			T. Ellenburger			Base Greenhorn	T. Granite
T. Blinebry			T. Gr. Wash			T. Dakota	
T. Tubb			T. Delaware Sand			T. Morrison	
T. Drinkard			T. Bone Springs			T. Todilto	
T. Abo			T. 1st BS Sand	10,132'		T. Entrada	
T. Wolfcamp			T.			T. Wingate	
T. Penn			T.			T. Chinle	
T. Cisco (Bough C)			T.			T. Permian	

No. 1, from.....to.....
No. 2, from.....to.....
No. 3, from.....to.....
No. 4, from.....to.....

Include data on rate of water inflow and elevation to which water rose in hole.

No. 1, from.....to.....feet.....
 No. 2, from.....to.....feet.....
 No. 3, from.....to.....feet.....

From	To	Thickness In Feet	Lithology

From	To	Thickness In Feet	Lithology

Sante Fe Main Office
Phone: (505) 476-3441

General Information
Phone: (505) 629-6116

Online Phone Directory
<https://www.emnrd.nm.gov/ocd/contact-us>

State of New Mexico
Energy, Minerals and Natural Resources
Oil Conservation Division
1220 S. St Francis Dr.
Santa Fe, NM 87505

ACKNOWLEDGMENTS

Action 140379

ACKNOWLEDGMENTS

Operator: EOG RESOURCES INC 5509 Champions Drive Midland, TX 79706	OGRID: 7377
	Action Number: 140379
	Action Type: [C-104] Completion Packet (C-104C)

ACKNOWLEDGMENTS

☒	I hereby certify that the required Water Use Report has been, or will be, submitted for this wells completion.
☒	I hereby certify that the required FracFocus disclosure has been, or will be, submitted for this wells completion.

Sante Fe Main Office
Phone: (505) 476-3441

General Information
Phone: (505) 629-6116

Online Phone Directory
<https://www.emnrd.nm.gov/ocd/contact-us>

State of New Mexico
Energy, Minerals and Natural Resources
Oil Conservation Division
1220 S. St Francis Dr.
Santa Fe, NM 87505

CONDITIONS

Action 140379

CONDITIONS

Operator: EOG RESOURCES INC 5509 Champions Drive Midland, TX 79706	OGRID: 7377
	Action Number: 140379
	Action Type: [C-104] Completion Packet (C-104C)

CONDITIONS

Created By	Condition	Condition Date
plmartinez	File 3160-4 Completion Report within 10 days of BLM approval.	1/31/2025