

District I
1625 N. French Dr., Hobbs, NM 88240
District II
811 S. First St., Artesia, NM 88210
District III
1000 Rio Brazos Rd., Aztec, NM 87410
District IV
1220 S. St. Francis Dr., Santa Fe, NM 87505

State of New Mexico
Energy, Minerals & Natural
Resources

Form C-104
Revised August 1, 2011

Submit one copy to appropriate District Office

Oil Conservation Division
1220 South St. Francis Dr.

☐ AMENDED REPORT

I. REQUEST FOR ALLOWABLE MINERAL AUTHORIZATION TO TRANSPORT

¹ Operator name and Address EOG RESOURCES INC PO BOX 2267 MIDLAND, TEXAS 79702		² OGRID Number 7377	
		³ Reason for Filing Code/ Effective Date NW 09/12//2022	
⁴ API Number 30 - 025-49947	⁵ Pool Name DOUBLE X; DELAWARE		⁶ Pool Code 19090
⁷ Property Code 331837	⁸ Property Name MODELO 3 FEDERAL COM		⁹ Well Number 1H

II. ¹⁰ Surface Location

Ul or lot no. M	Section 3	Township 24S	Range 32E	Lot Idn	Feet from the 392	North/South Line SOUTH	Feet from the 803	East/West line WEST	County LEA
--------------------	--------------	-----------------	--------------	---------	----------------------	---------------------------	----------------------	------------------------	---------------

¹¹ Bottom Hole Location

UL or lot no. L	Section 15	Township 24S	Range 32E	Lot Idn	Feet from the 1429	North/South line SOUTH	Feet from the 397	East/West line WEST	County LEA
¹² Lse Code	¹³ Producing Method Code FLOWING	¹⁴ Gas Connection Date	¹⁵ C-129 Permit Number		¹⁶ C-129 Effective Date		¹⁷ C-129 Expiration Date		

III. Oil and Gas Transporters

¹⁸ Transporter OGRID	¹⁹ Transporter Name and Address	²⁰ O/G/W
372812	EOGRM	OIL
151618	ENTERPRISE FIELD SERVICES	GAS
298751	REGENCY FIELD SERVICES	GAS
36785	DCP MIDSTREAM	GAS

IV. Well Completion Data

²¹ Spud Date 05/23/2022	²² Ready Date 09/12/2022	²³ TD 17,671	²⁴ PBTD 17,504	²⁵ Perforations 8745 - 17,504'	²⁶ DHC, MC	
²⁷ Hole Size		²⁸ Casing & Tubing Size		²⁹ Depth Set		³⁰ Sacks Cement
17 1/2"		13 3/8"		1322'		1155 SXS CL C/CIRC
12 1/4"		9 5/8"		4755'		1190 SXS CL C/CIRC
8 3/4"		5 1/2"		17,656'		3130 CL H TOC 0 CBL

V. Well Test Data

³¹ Date New Oil 09/12/2022	³² Gas Delivery Date 09/12/2022	³³ Test Date 09/28/2022	³⁴ Test Length 24 HRS	³⁵ Tbg. Pressure	³⁶ Csg. Pressure 270
³⁷ Choke Size	³⁸ Oil 1056	³⁹ Water 6490	⁴⁰ Gas 1412		⁴¹ Test Method

⁴² I hereby certify that the rules of the Oil Conservation Division have been complied with and that the information given above is true and complete to the best of my knowledge and belief. Signature: Kay Maddox Printed name: Kay Maddox Title: SENIOR REGULATORY SPECIALIST E-mail Address: kay_maddox@eogresources.com Date: 10/18/2022	Phone: 432-638-8475	OIL CONSERVATION DIVISION	
	Approved by:		
	Title:		
	Approval Date:		

District I
1625 N. French Dr., Hobbs, NM 88240
Phone: (575) 393-6161 Fax: (575) 393-0720
District II
811 S. First St., Artesia, NM 88210
Phone: (575) 748-1283 Fax: (575) 748-9720
District III
1000 Rio Brazos Road, Aztec, NM 87410
Phone: (505) 334-6178 Fax: (505) 334-6170
District IV
1220 S. St. Francis Dr., Santa Fe, NM 87505
Phone: (505) 476-3460 Fax: (505) 476-3462

State of New Mexico
Energy, Minerals & Natural Resources
Department
OIL CONSERVATION DIVISION
1220 South St. Francis Dr.
Santa Fe, NM 87505

FORM C-102

Revised August 1, 2011

Submit one copy to appropriate

District Office

☐ AMENDED REPORT

AS-DRILLED PLAT

¹ API Number 30-025- 49947	² Pool Code 19090	³ Pool Name DOUBLE X; DELAWARE
⁴ Property Code 331837	⁵ Property Name MODELO 3 FED COM	
⁷ OGRID No. 7377	⁸ Operator Name EOG RESOURCES, INC.	⁶ Well Number 1H
		⁹ Elevation 3652'

¹⁰Surface Location


UL or lot no.	Section	Township	Range	Lot Idn	Feet from the	North/South line	Feet from the	East/West line	County
M	3	24-S	32-E	-	392'	SOUTH	803'	WEST	LEA

¹¹Bottom Hole Location If Different From Surface

UL or lot no.	Section	Township	Range	Lot Idn	Feet from the	North/South line	Feet from the	East/West line	County
L	15	24-S	32-E	-	1429'	SOUTH	397'	WEST	LEA

¹² Dedicated Acres 1000.00	¹³ Joint or Infill	¹⁴ Consolidation Code	¹⁵ Order No.
---	-------------------------------	----------------------------------	-------------------------


No allowable will be assigned to this completion until all interests have been consolidated or a non-standard unit has been approved by the division.

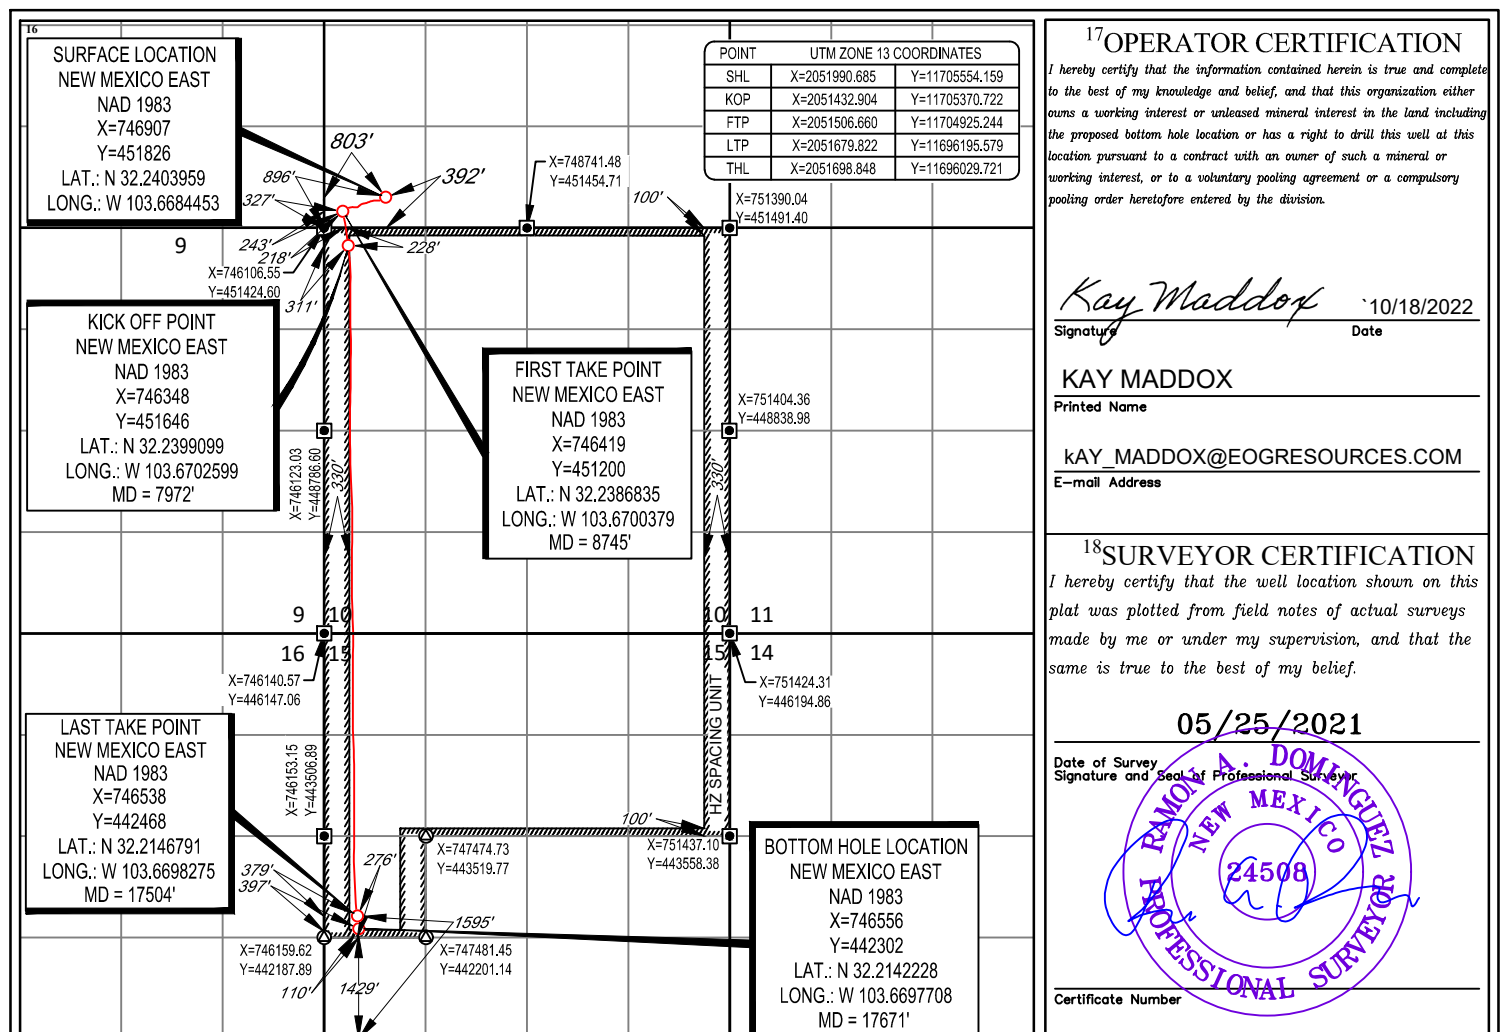

SCALE: 1" = 2000'

0' 1000' 2000'

SECTION 3, TOWNSHIP 24-S, RANGE 32-E, N.M.P.M.
LEA COUNTY, NEW MEXICO

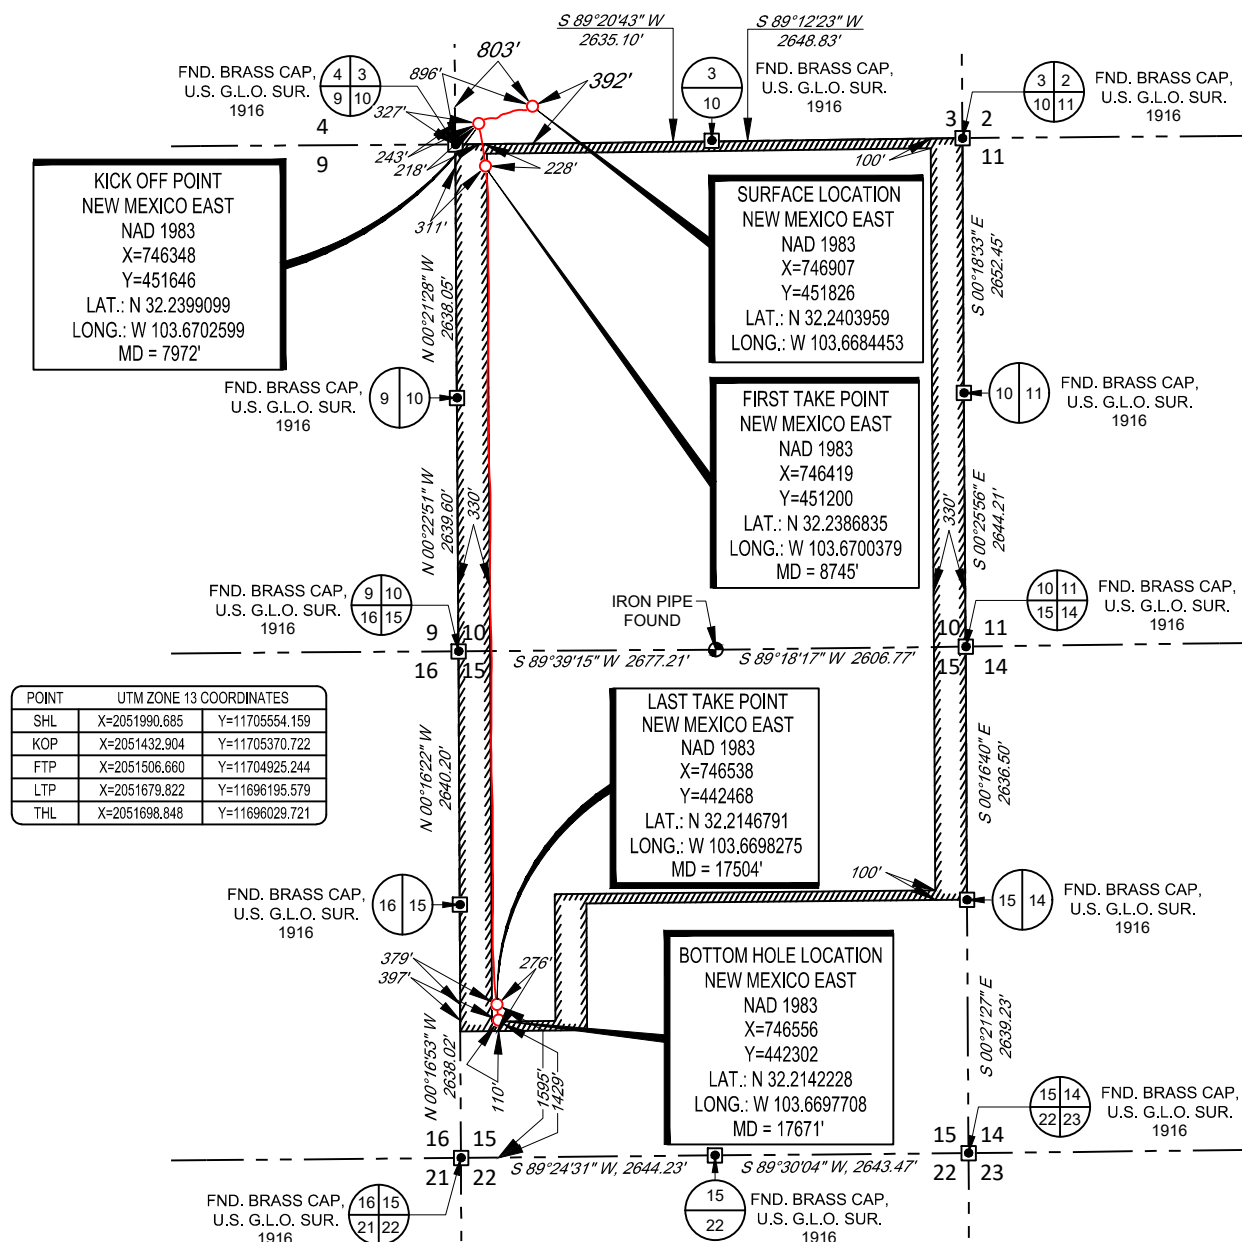

LEASE NAME & WELL NO.: _____ MODELO 3 FED COM 1H
SECTION 3 TWP 24-S RGE 32-E SURVEY N.M.P.M.
COUNTY LEA STATE NM ELEVATION 3652'
DESCRIPTION 392' FSL & 803' FWL



1400 EVERMAN PARKWAY, Ste. 146 • FT. WORTH, TEXAS 76140
TELEPHONE: (817) 744-7512 • FAX (817) 744-7554
TEXAS FIRM REGISTRATION NO. 10042504
WWW.TOPOGRAPHIC.COM



Ramon A. Dominguez, P.S. No. 24508
August 31, 2022



MODELO 3 FED COM 1H AS-DRILLED	REVISION:	NOTES:
DATE: 08/30/2022		1. ORIGINAL DOCUMENT SIZE: 8.5" X 11"
FILE:AD_MODELO_3_FED_COM_1H		2. ALL BEARINGS, DISTANCES, AND COORDINATE VALUES CONTAINED HEREIN ARE GRID BASED UPON THE NEW MEXICO COORDINATE SYSTEM OF 1983, EAST ZONE, U.S. SURVEY FEET.
DRAWN BY: A.V.F.		3. THIS WELL LOCATION SHOWN HEREON HAS BEEN SURVEYED ON THE GROUND UNDER MY SUPERVISION AND PREPARED ACCORDING TO THE EVIDENCE FOUND AT THE TIME OF SURVEY, AND DATA PROVIDED BY EOG RESOURCES, INC. THIS CERTIFICATION IS MADE AND LIMITED TO THOSE PERSONS OR ENTITIES SHOWN ON THE FACE OF THIS PLAT AND IS NON-TRANSFERABLE. THIS SURVEY IS CERTIFIED FOR THIS TRANSACTION ONLY.
SHEET: 2 OF 2		



Lea County, NM (NAD 83 NME)

Modelo 3 Fed Com #1H

H&P 389


OH

PROJECT DETAILS: Lea County, NM (NAD 83 NME)

Geodetic System: US State Plane 1983
Datum: North American Datum 1983
Ellipsoid: GRS 1980
Zone: New Mexico Eastern Zone
System Datum: Mean Sea Level

WELL DETAILS: #1H










KB 25 @ 3677.0usft (H&P 389) 3652.0
Northing 451826.00 Easting 746907.00 Latitude 32° 14' 25.427 N Longitude 103° 40' 6.406 W

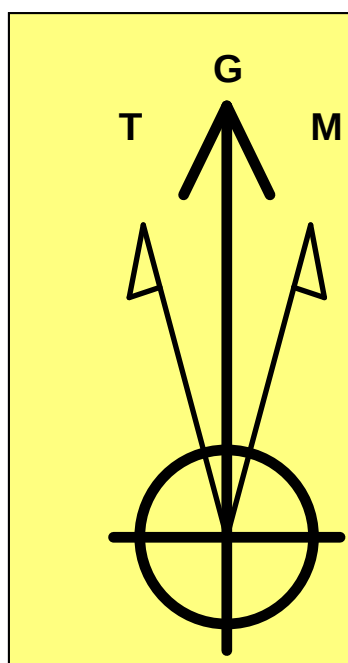

Azimuths to Grid North
True North: -0.35°
Magnetic North: 6.13°

Magnetic Field
Strength: 47394.7nT
Dip Angle: 59.87°
Date: 5/23/2022
Model: IGRF2020

To convert a Magnetic Direction to a Grid Direction, Add 6.13°
To convert a Magnetic Direction to a True Direction, Add 6.48° East
To convert a True Direction to a Grid Direction, Subtract 0.35°

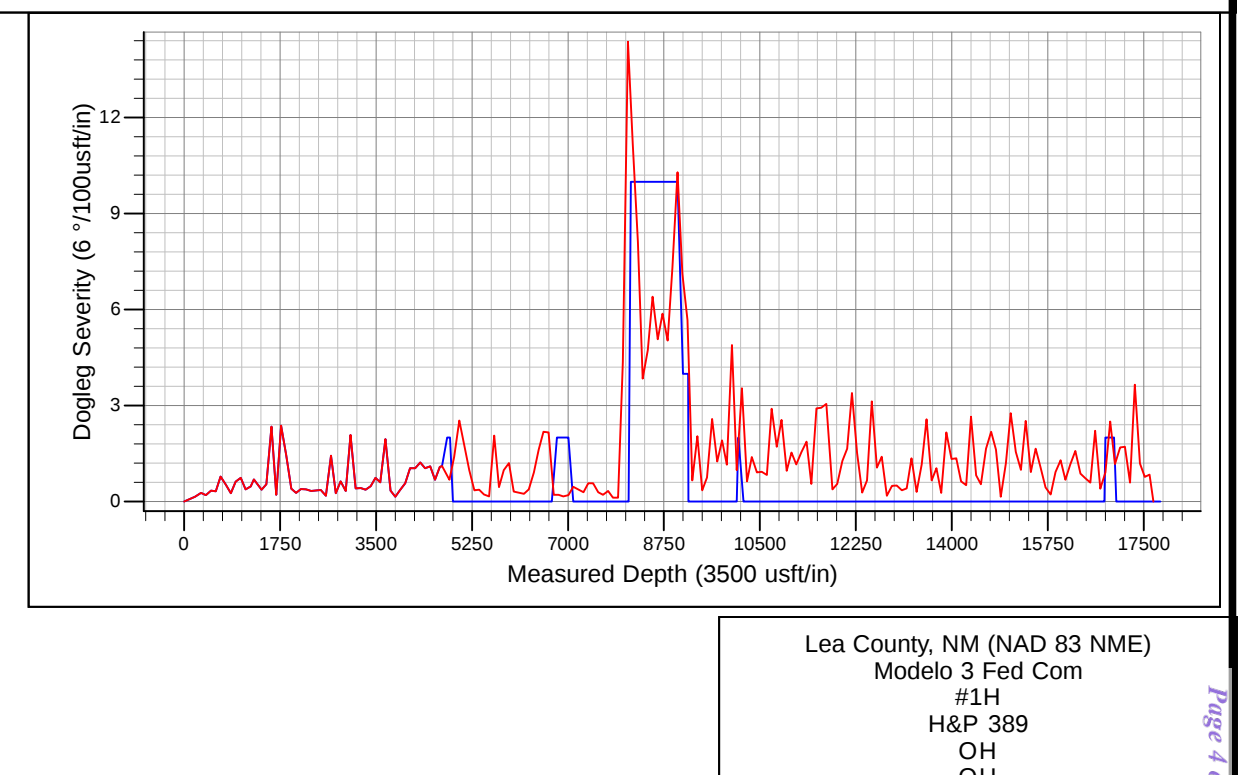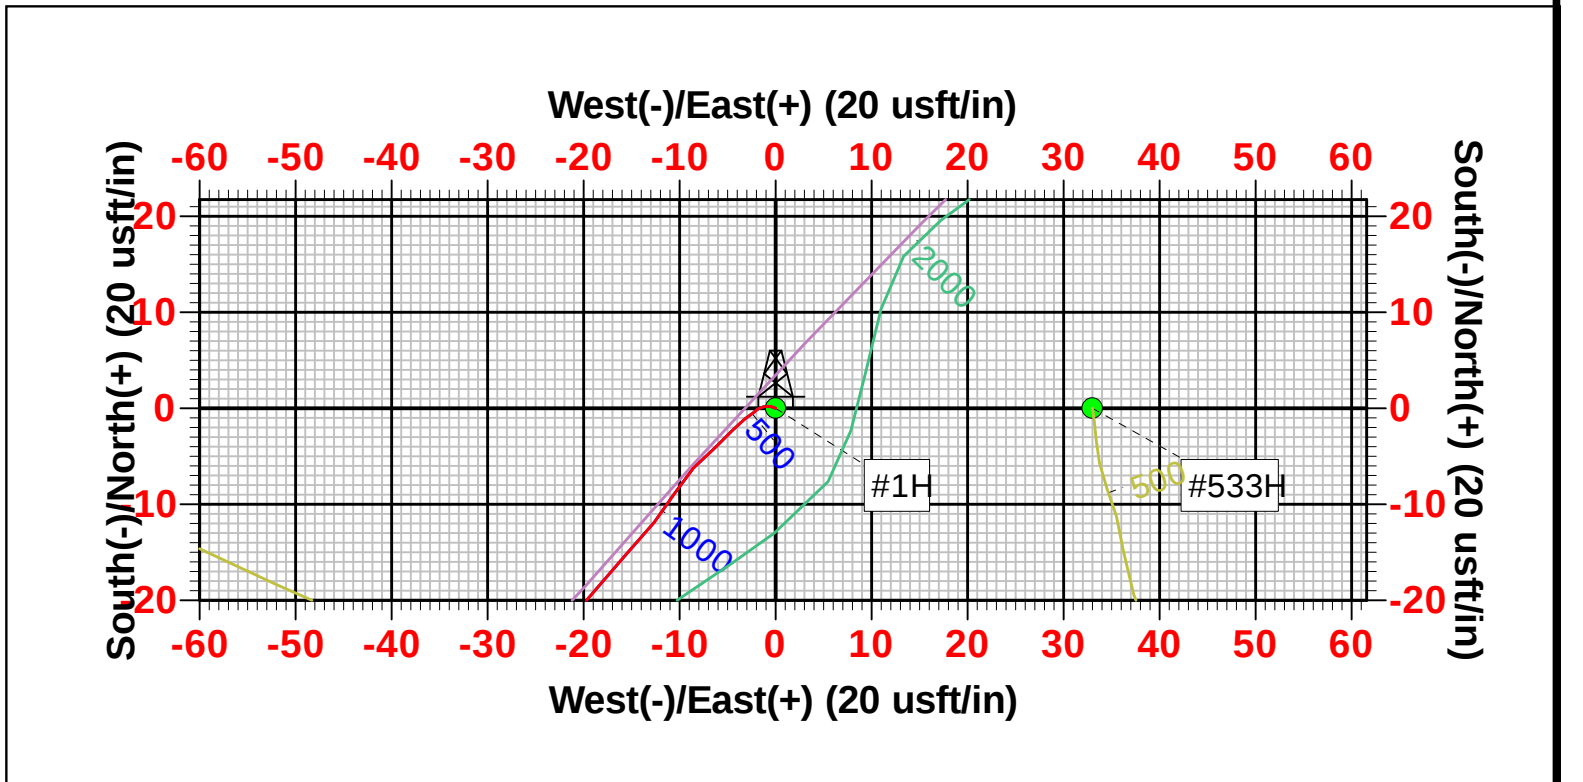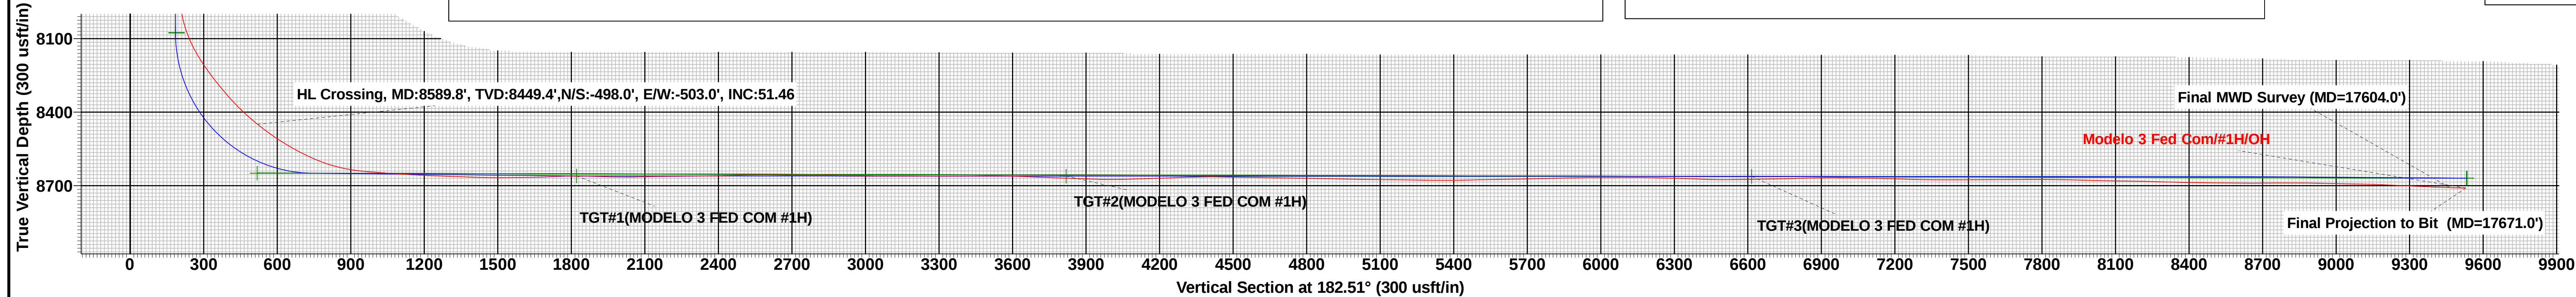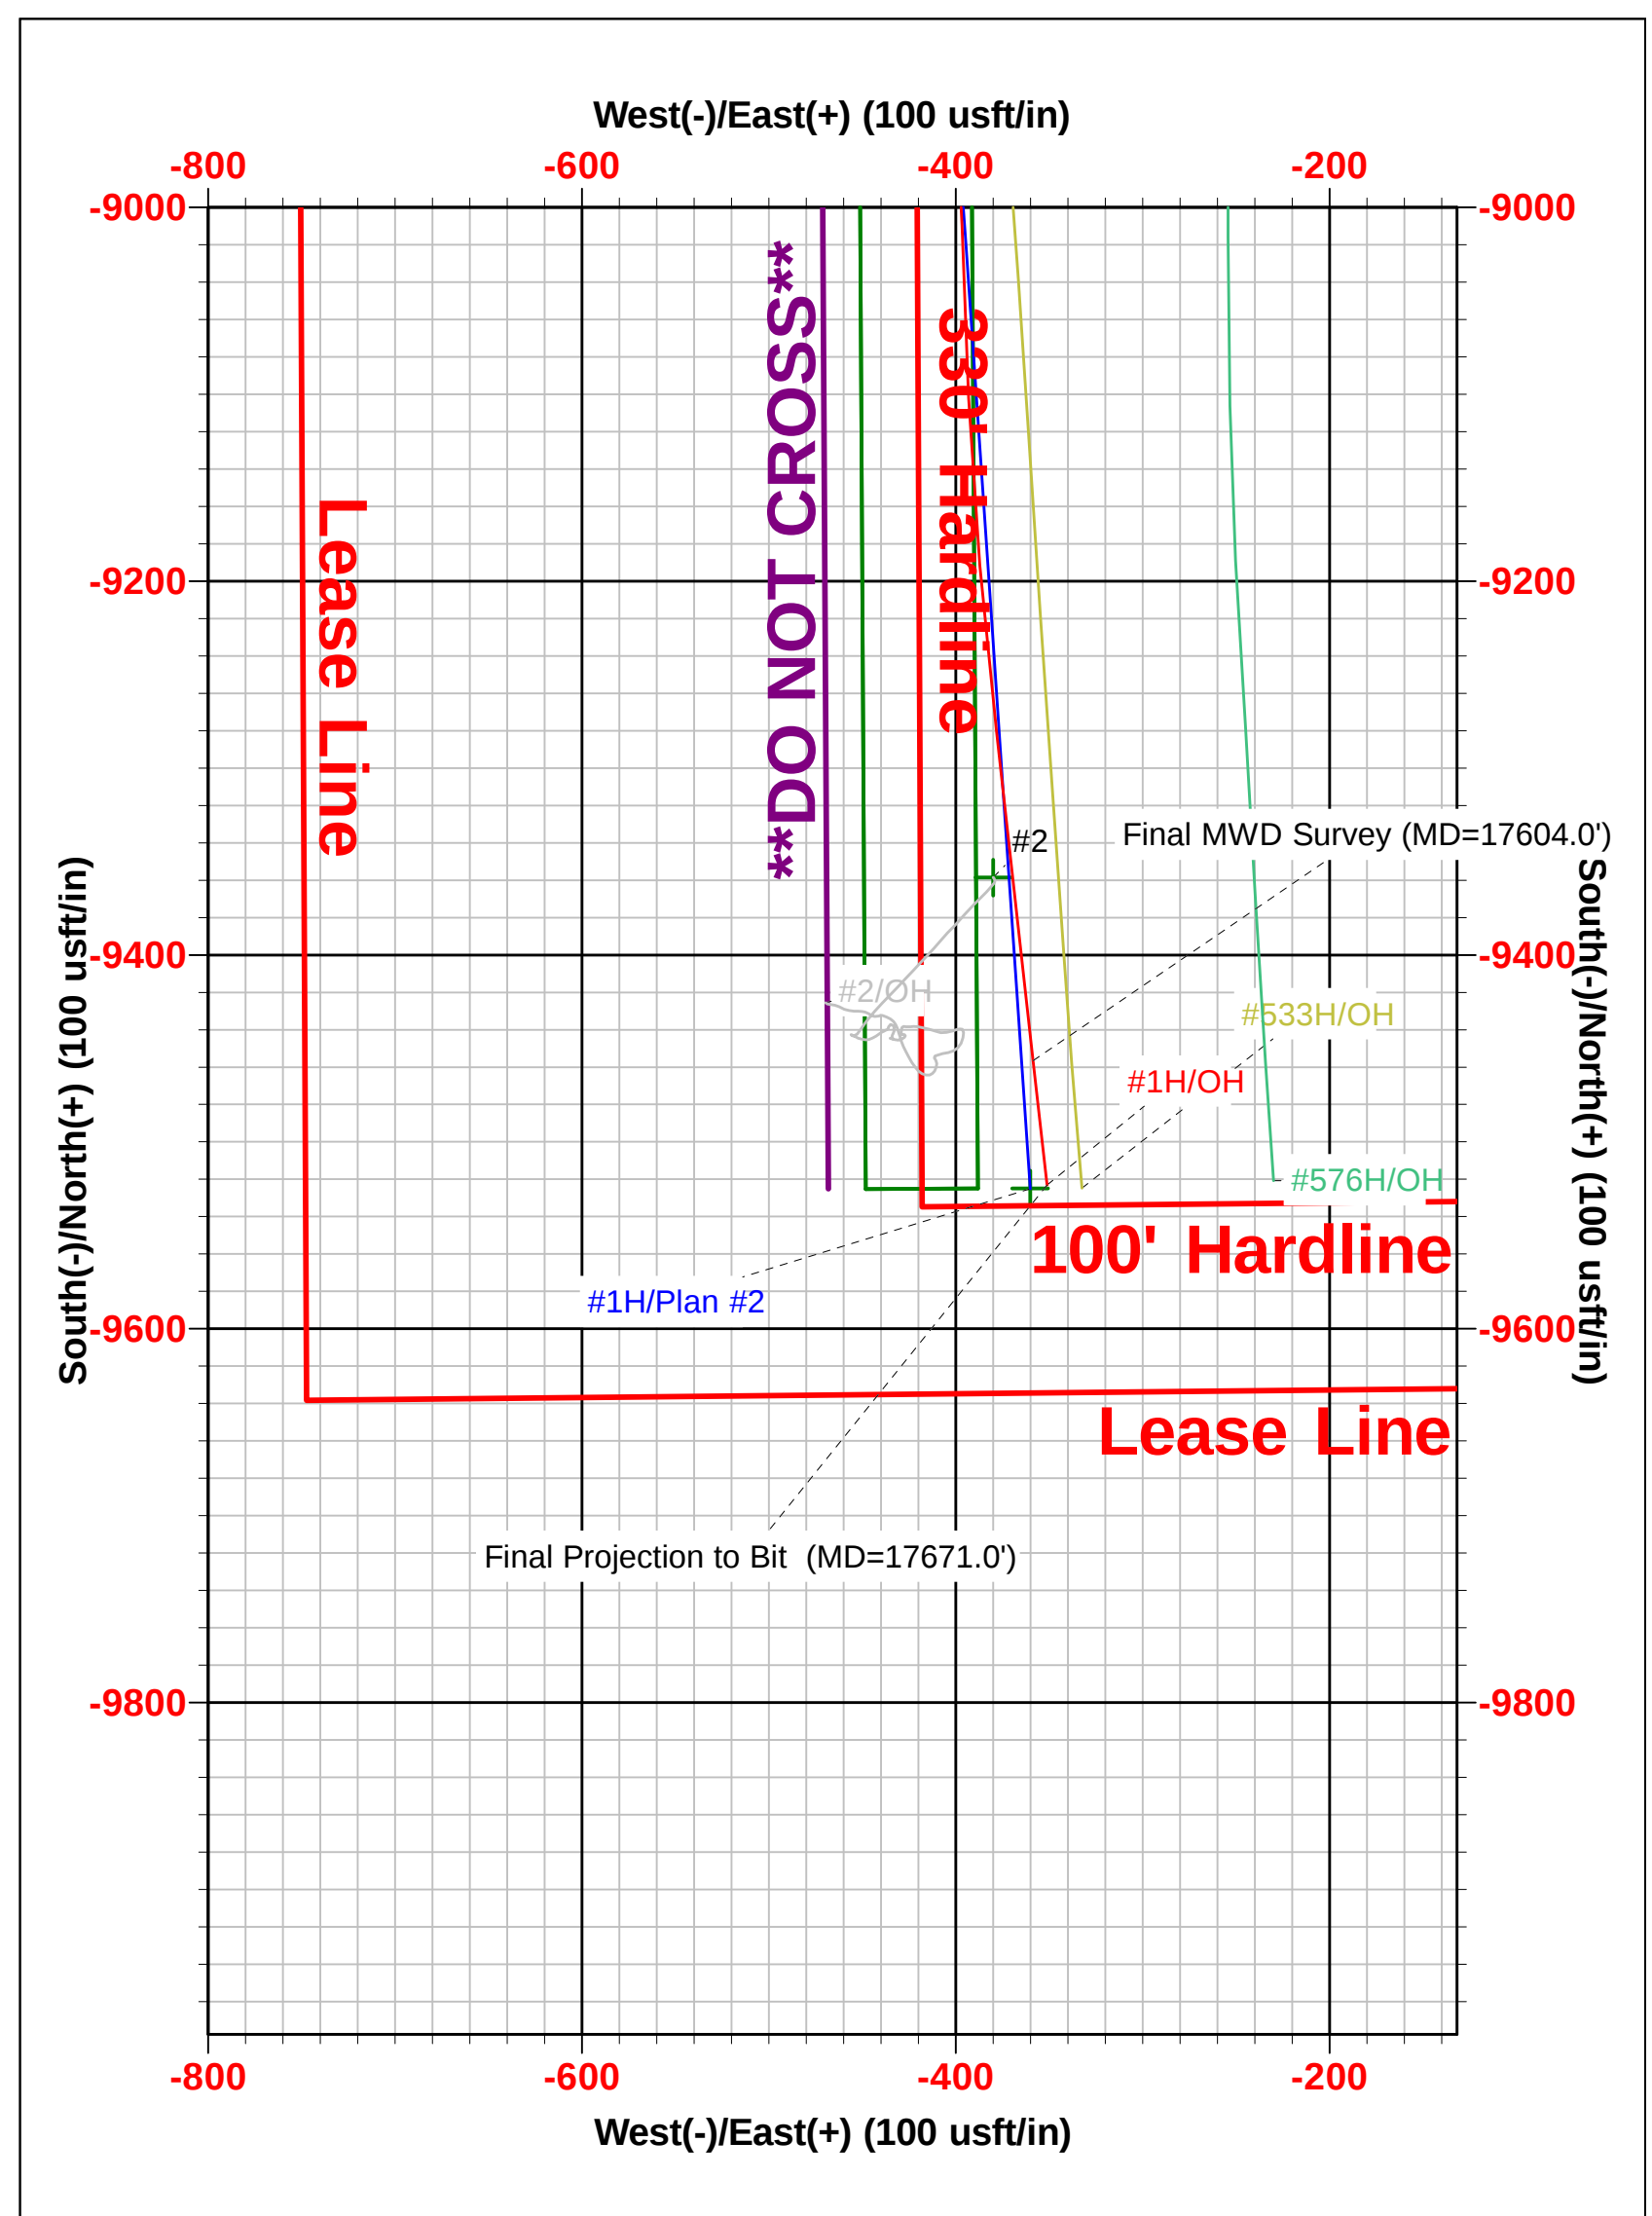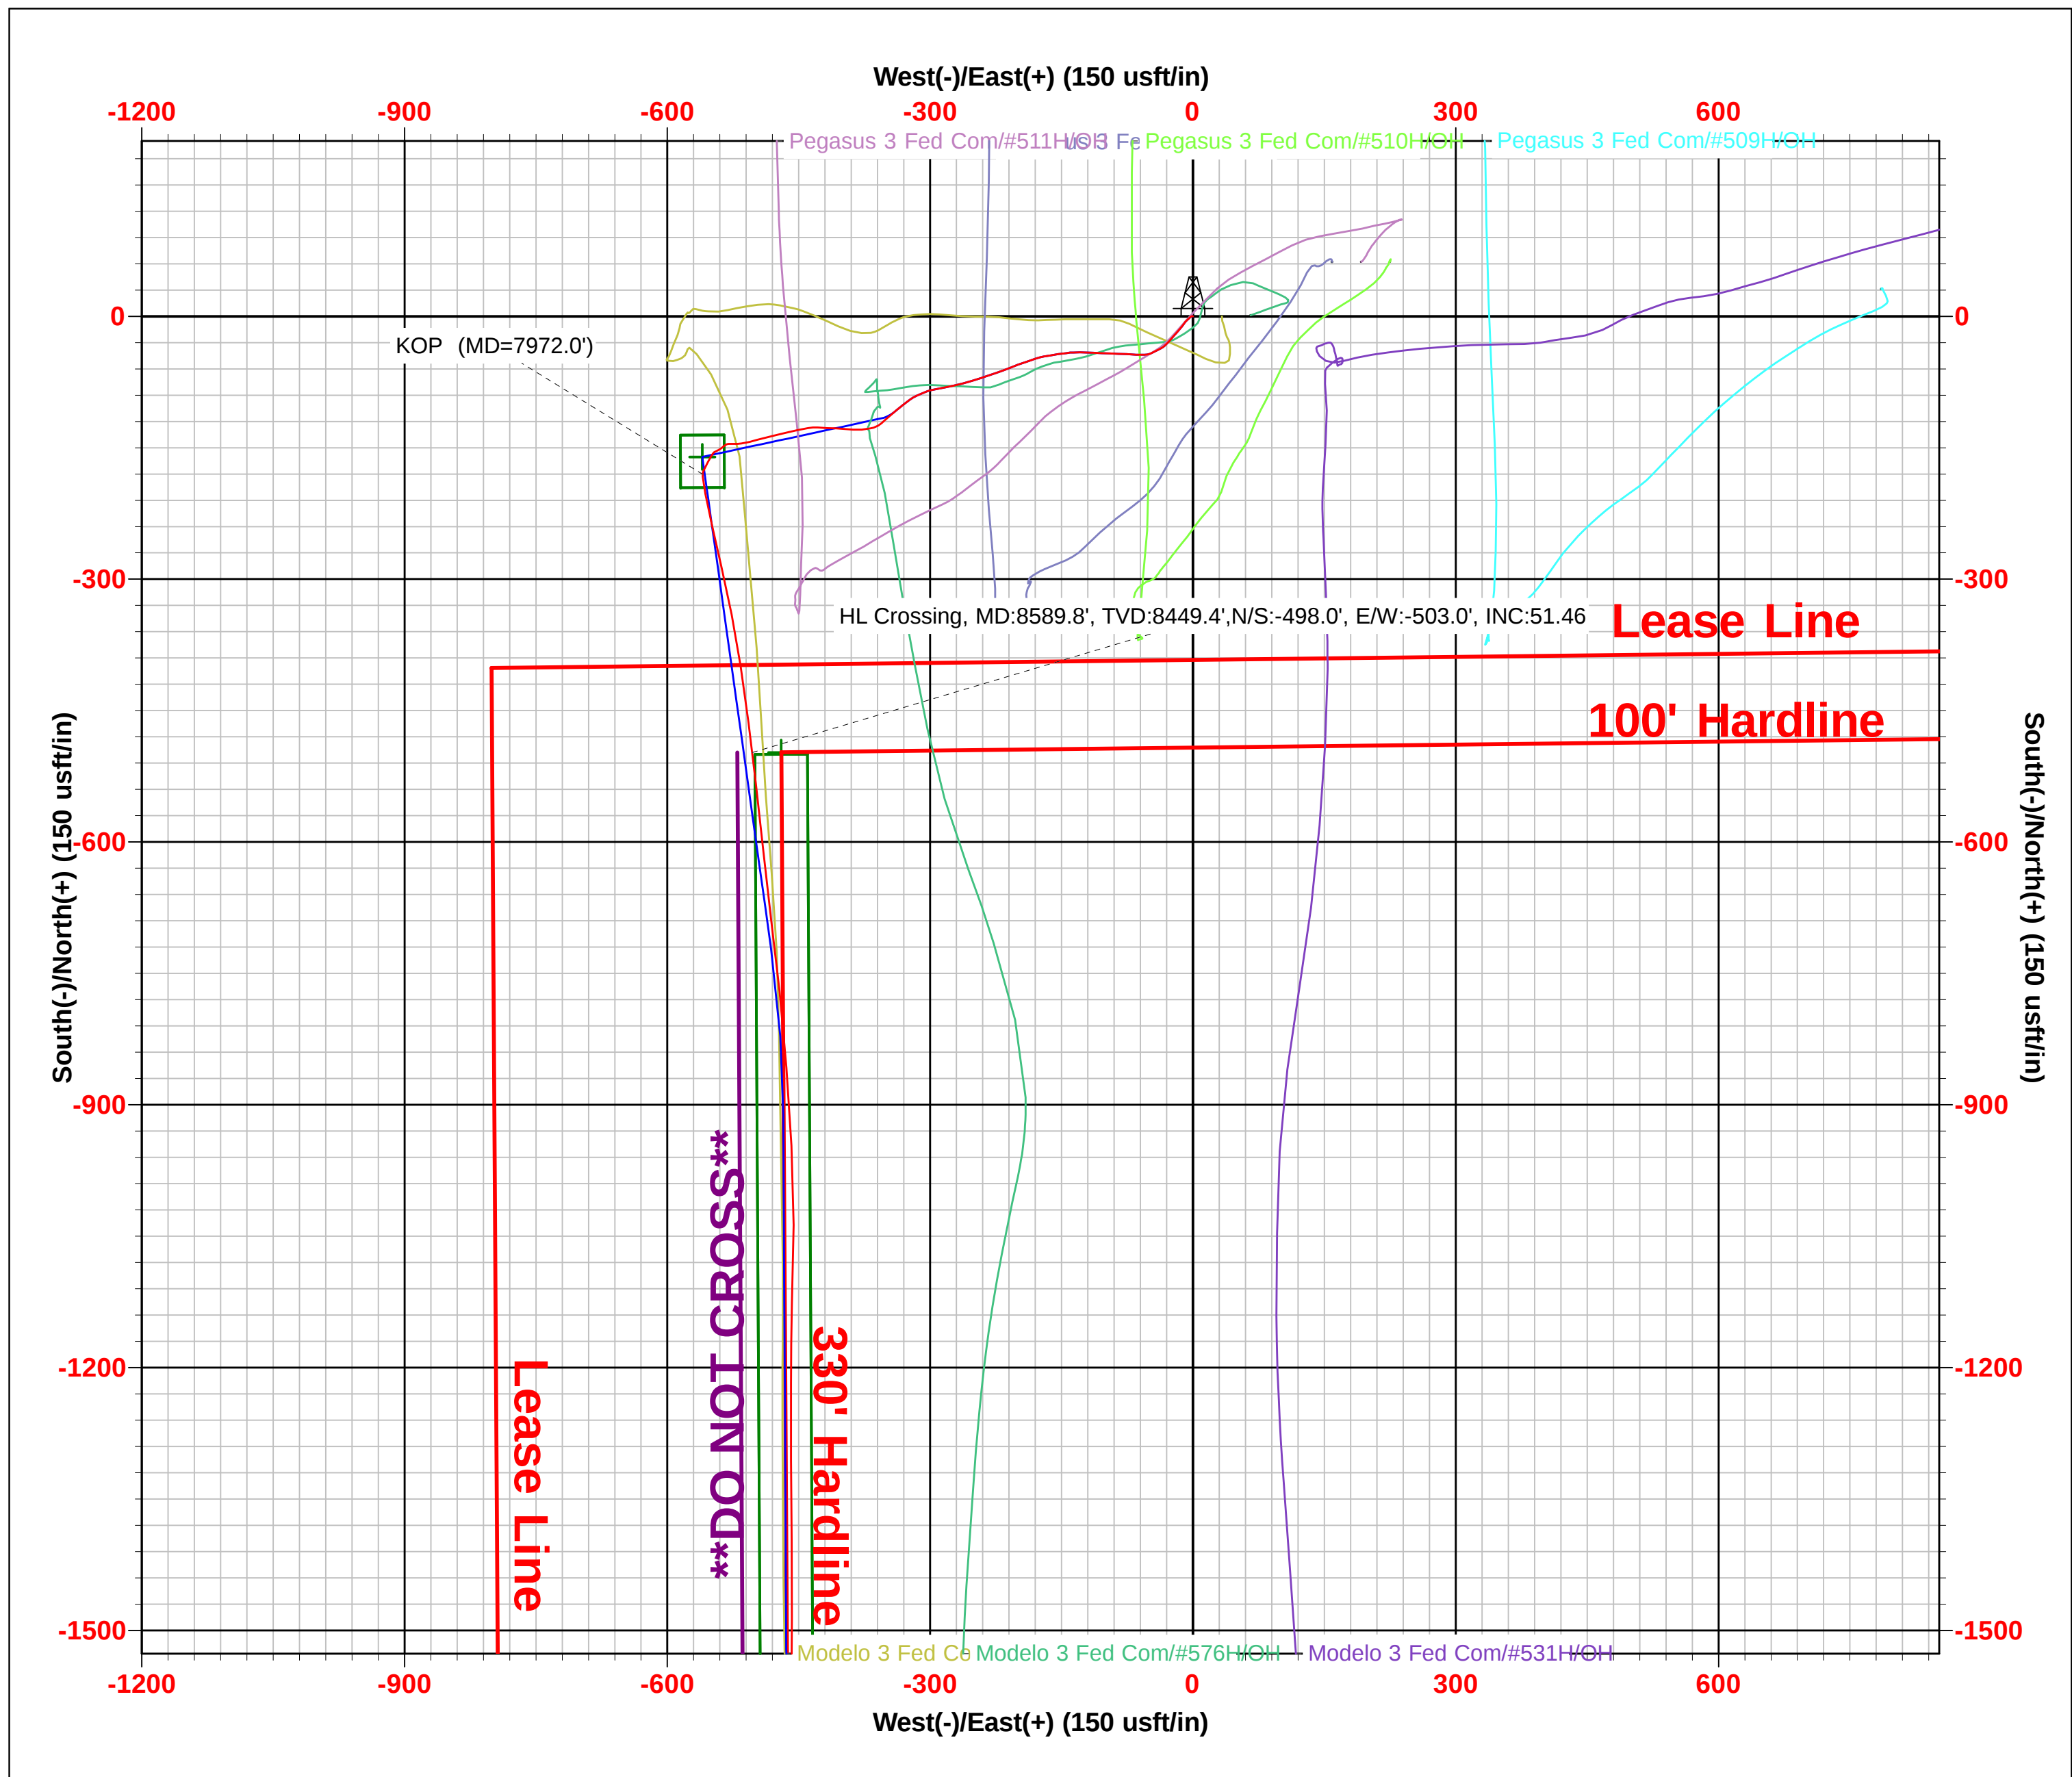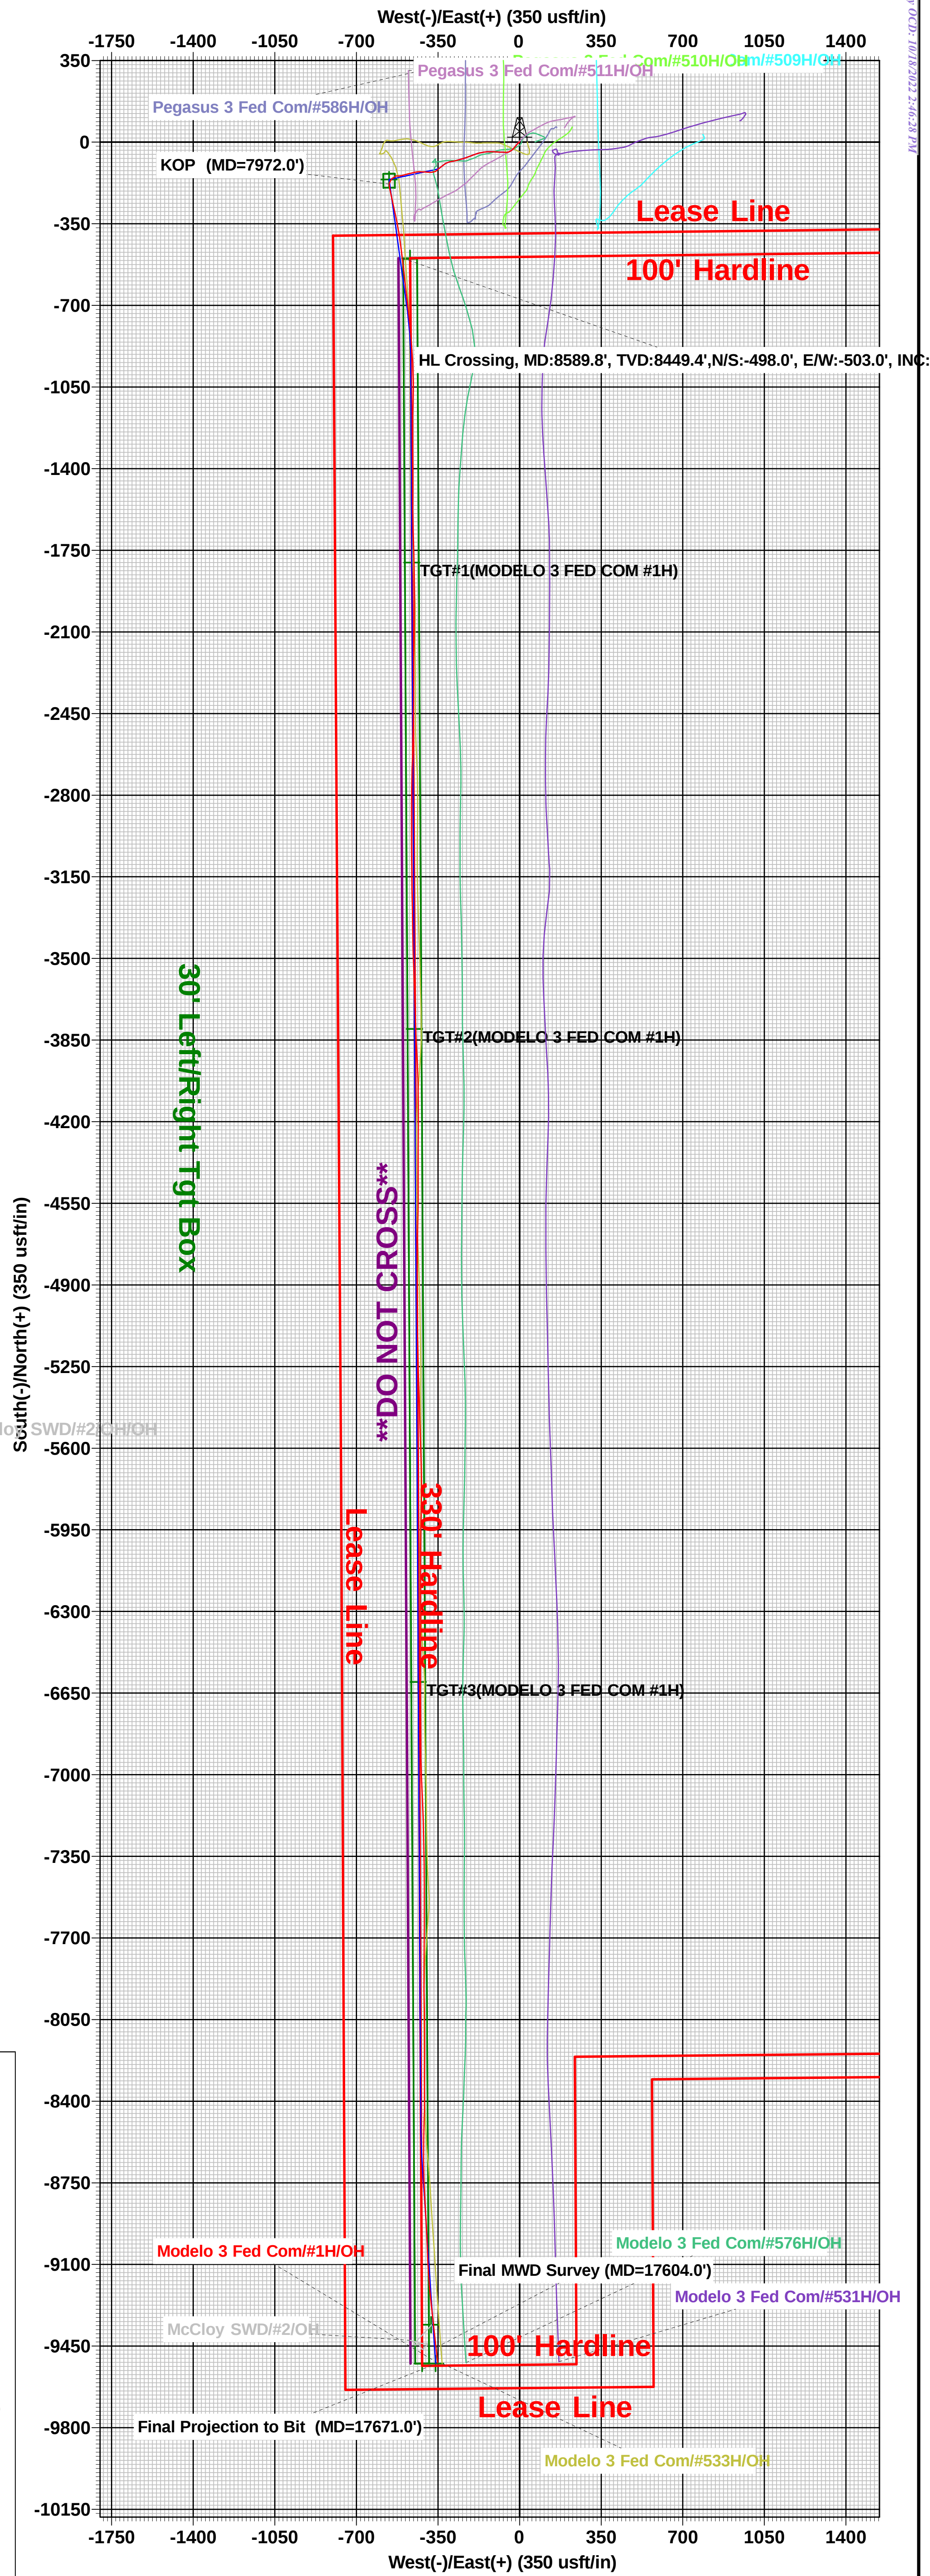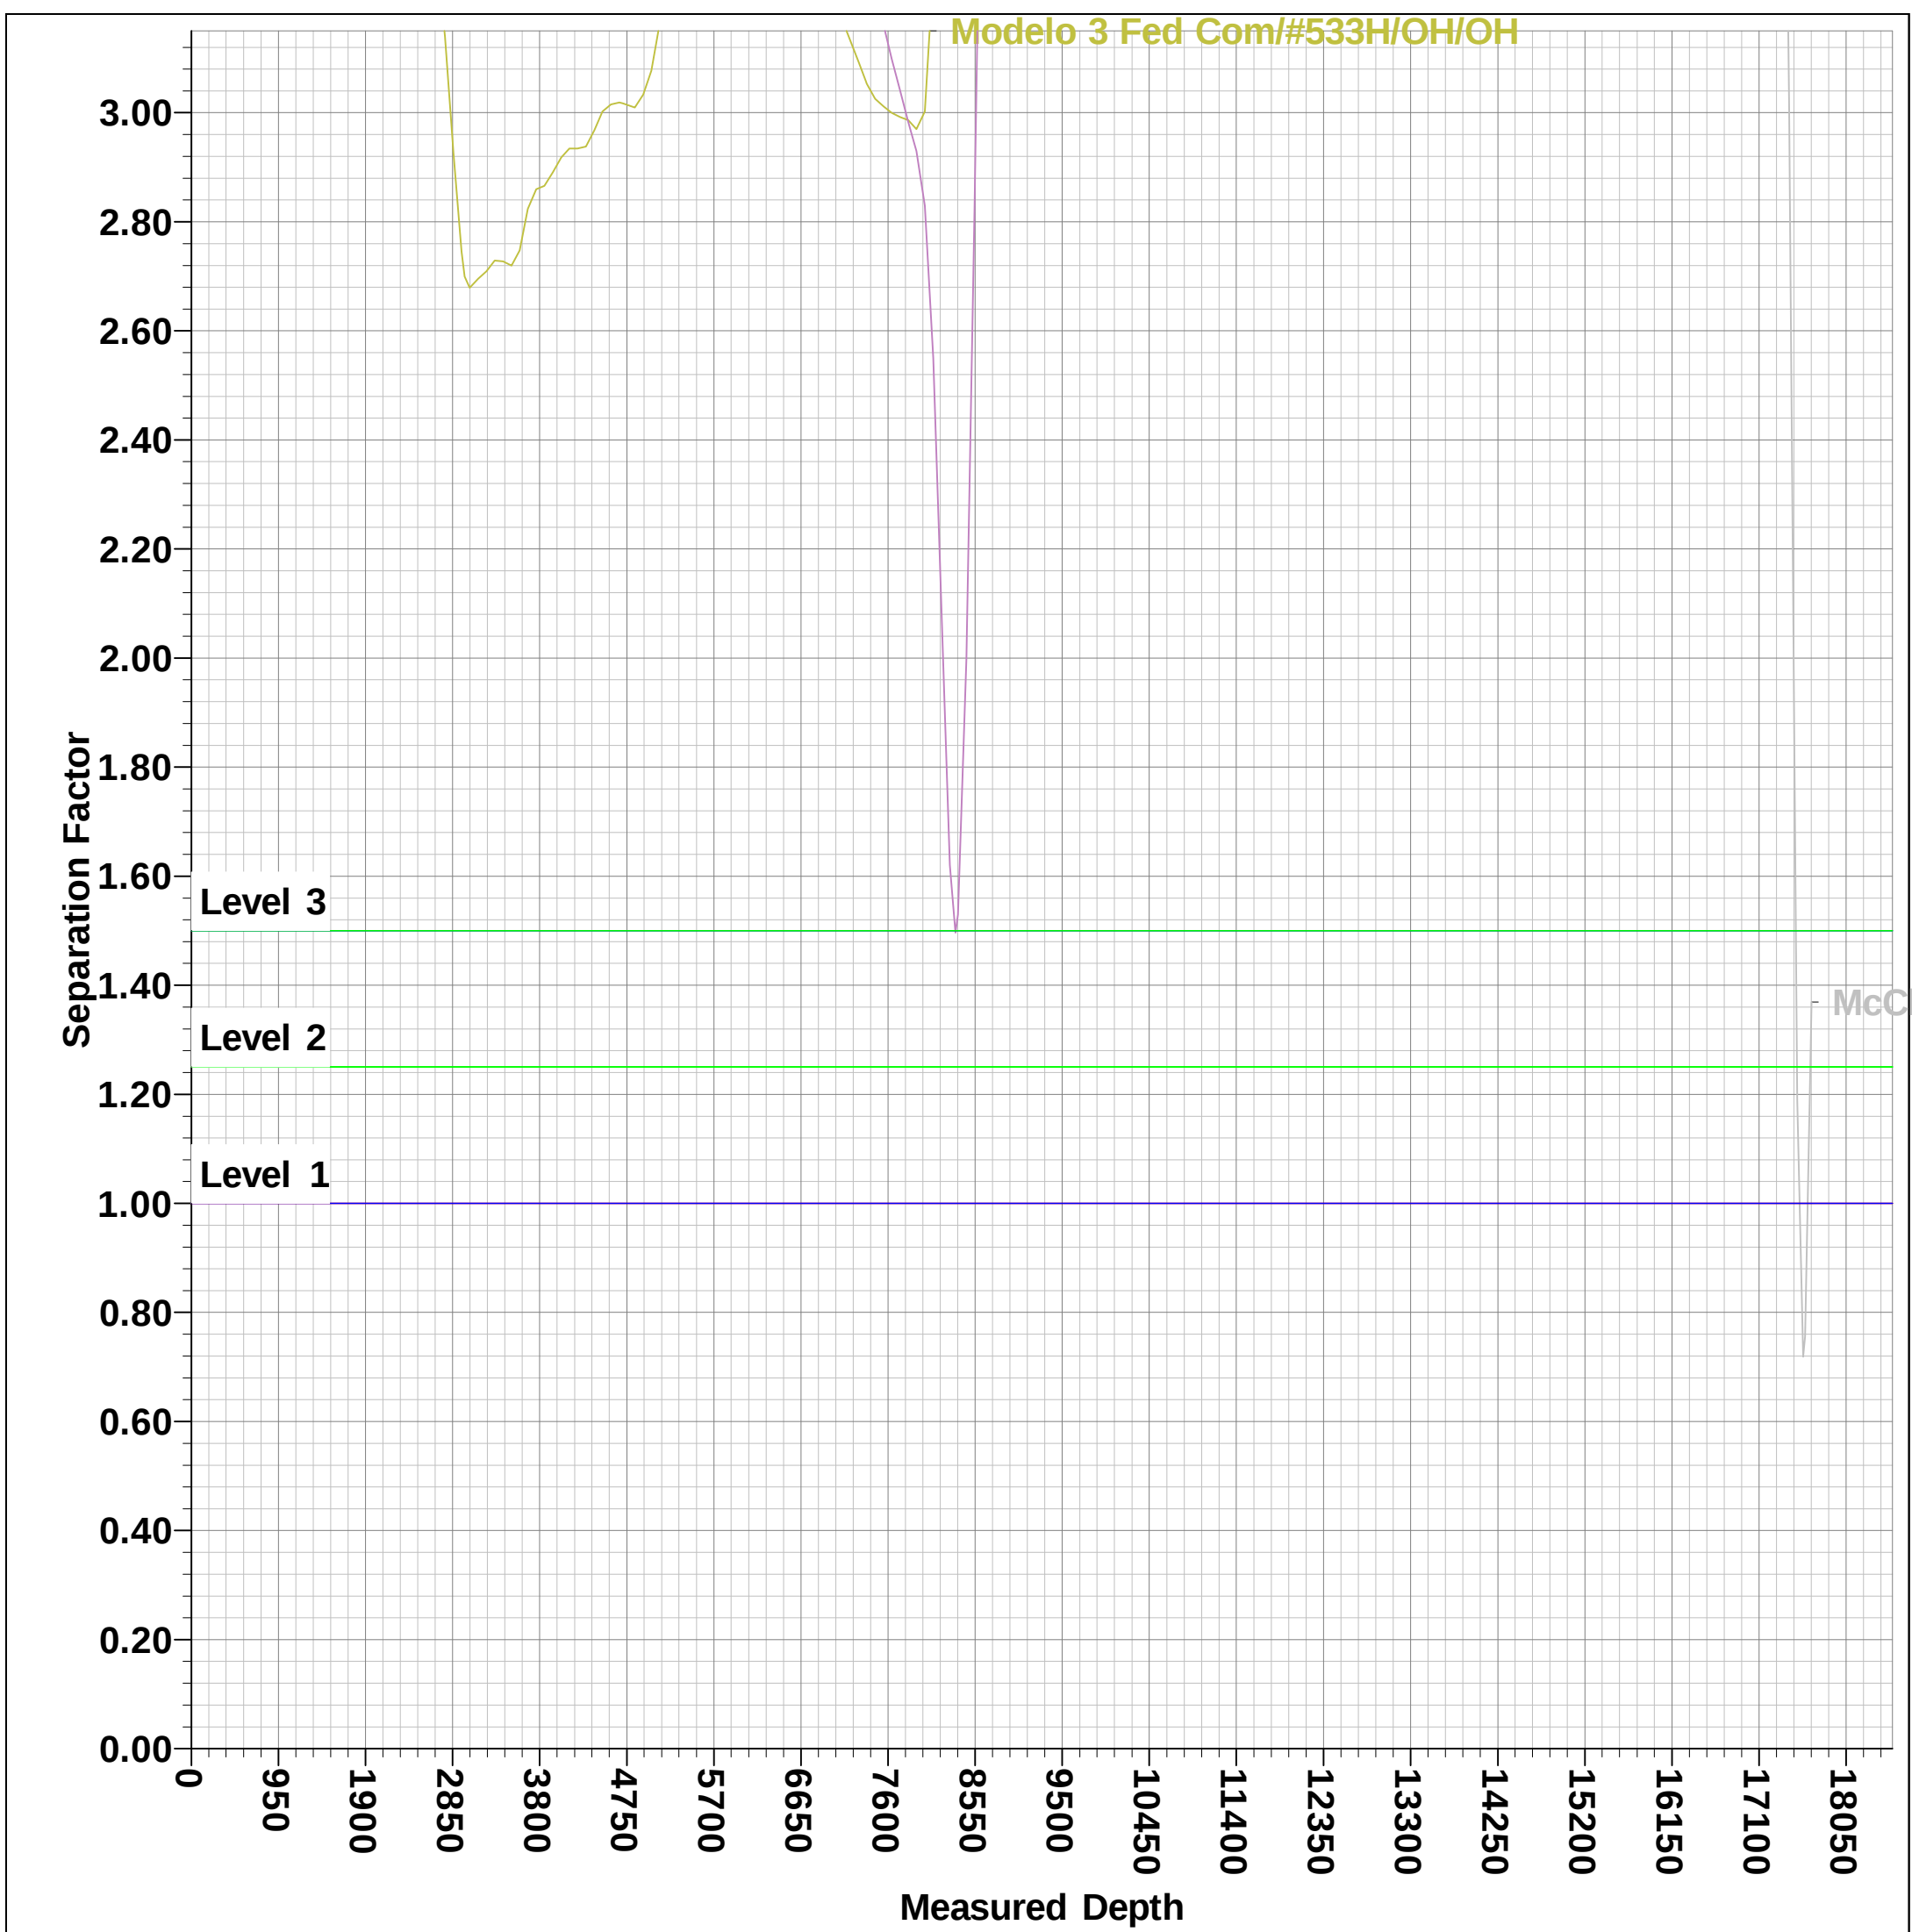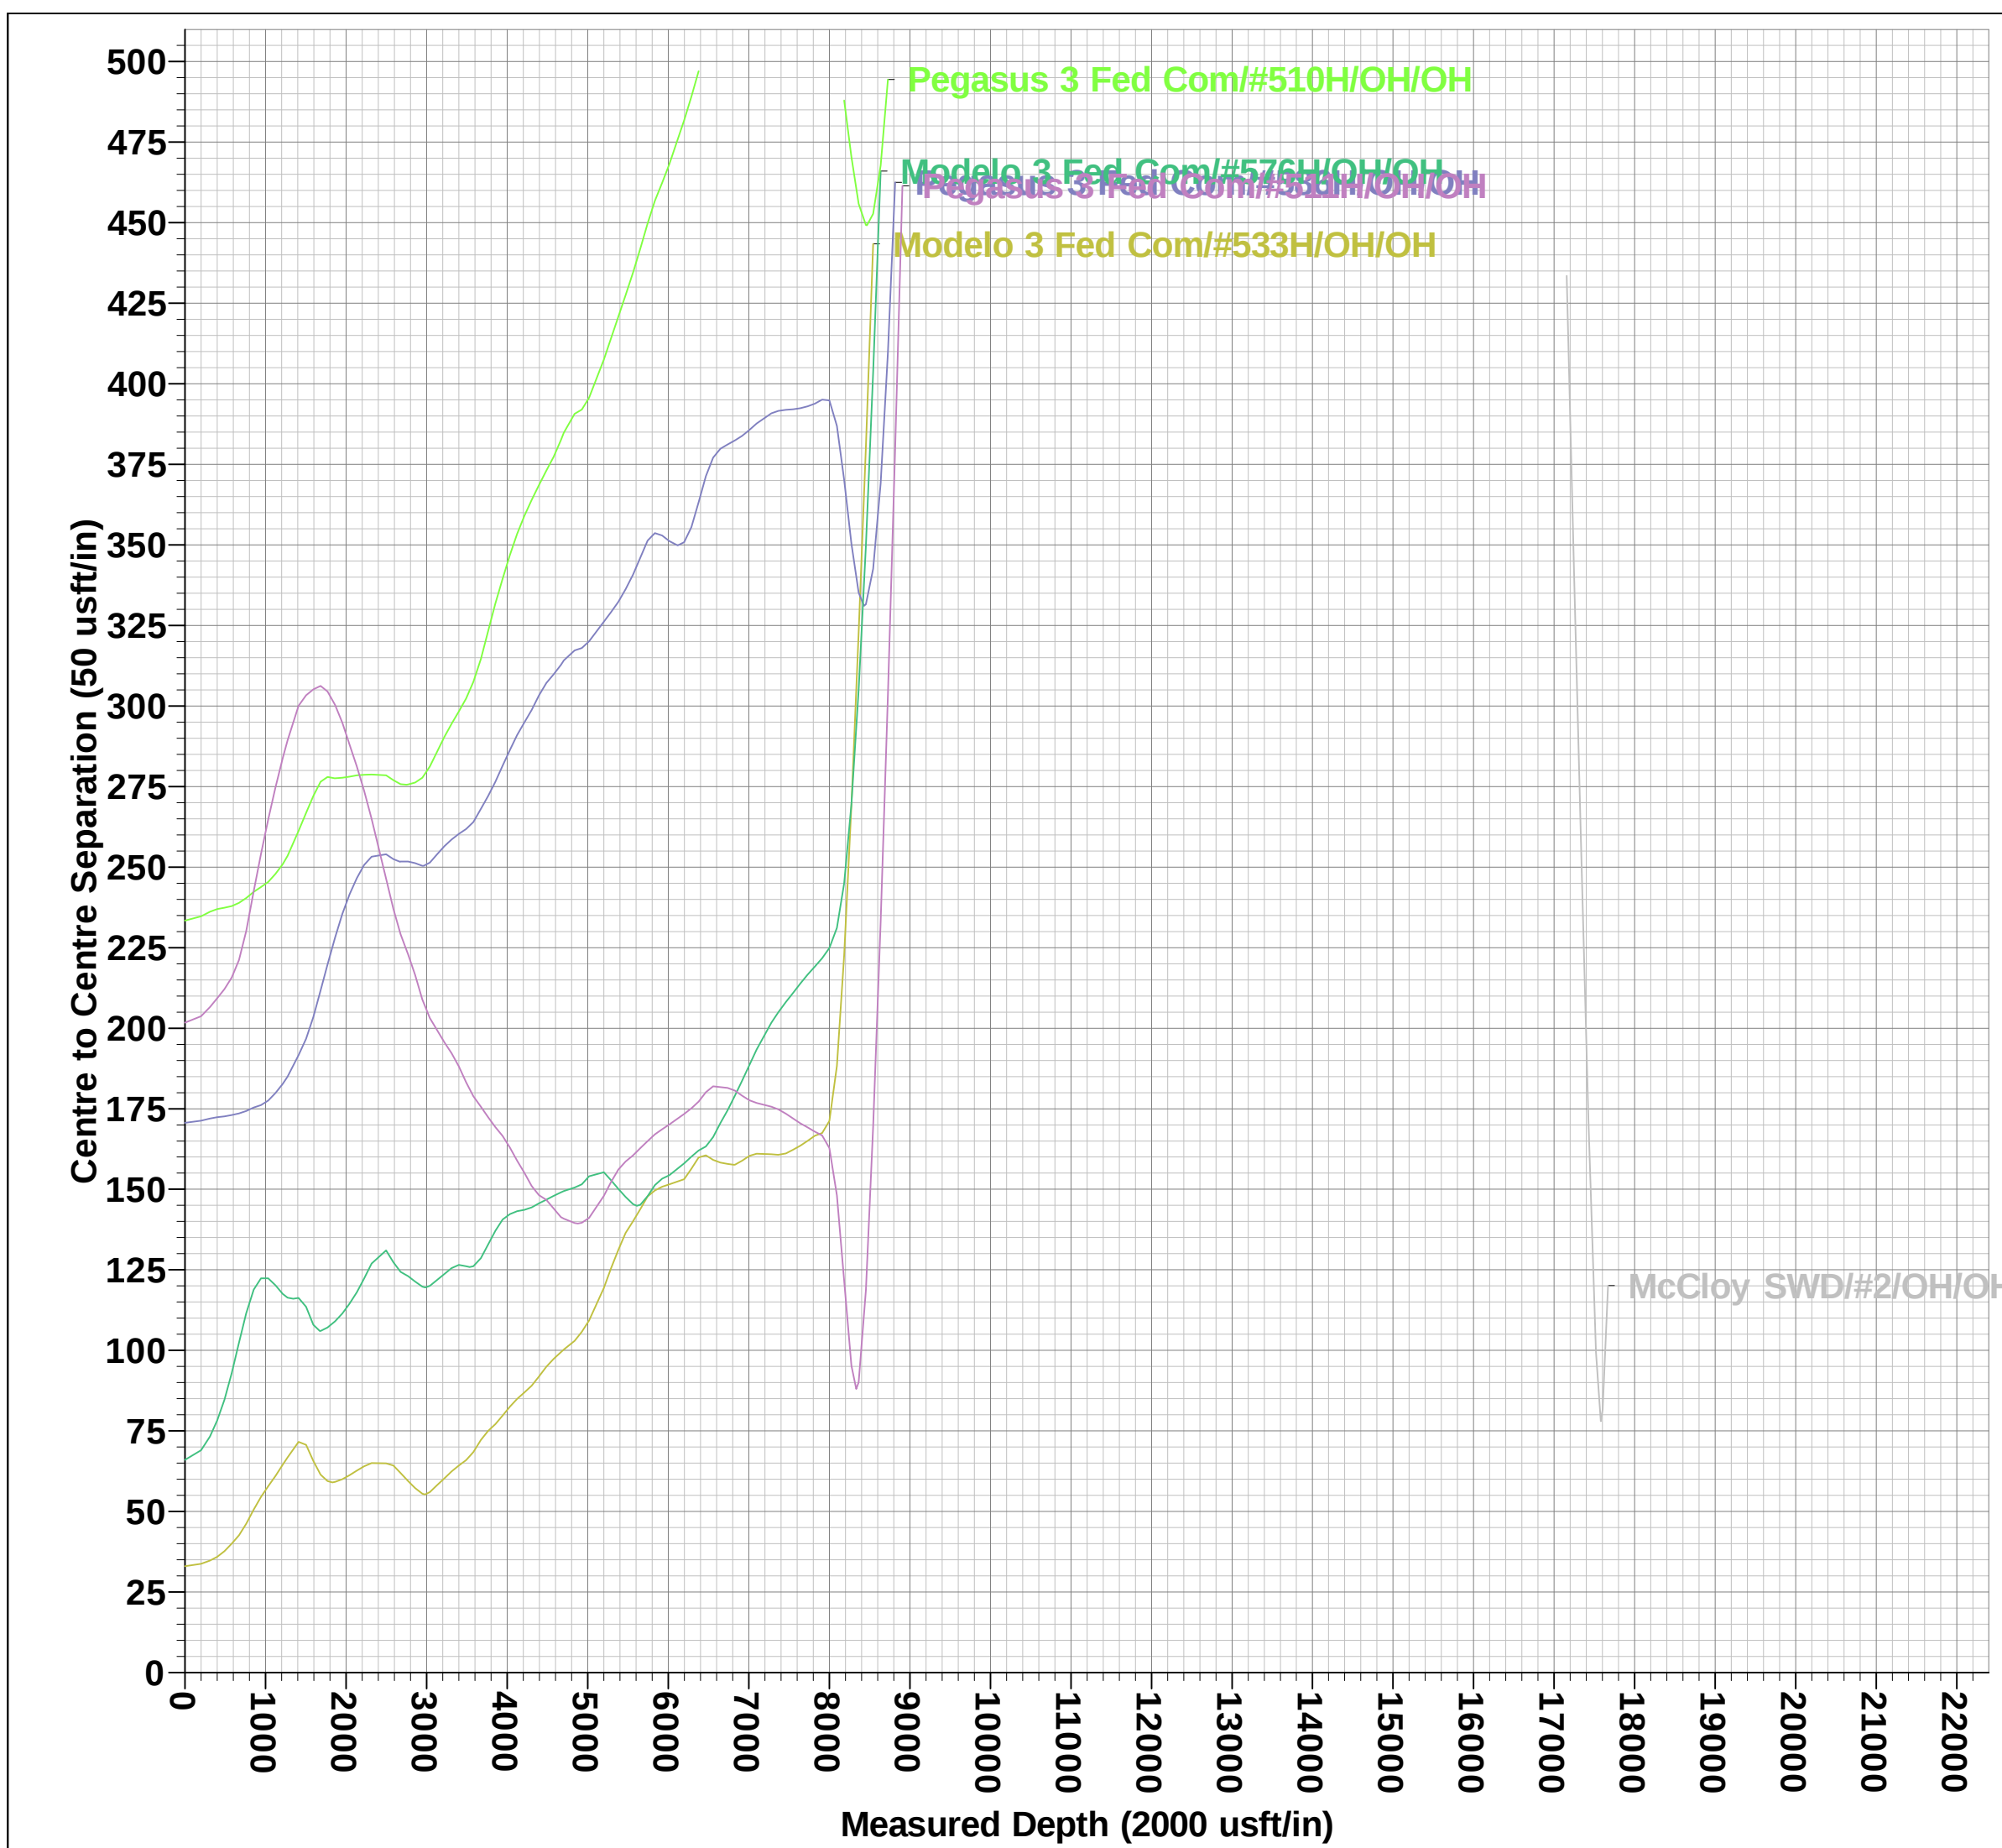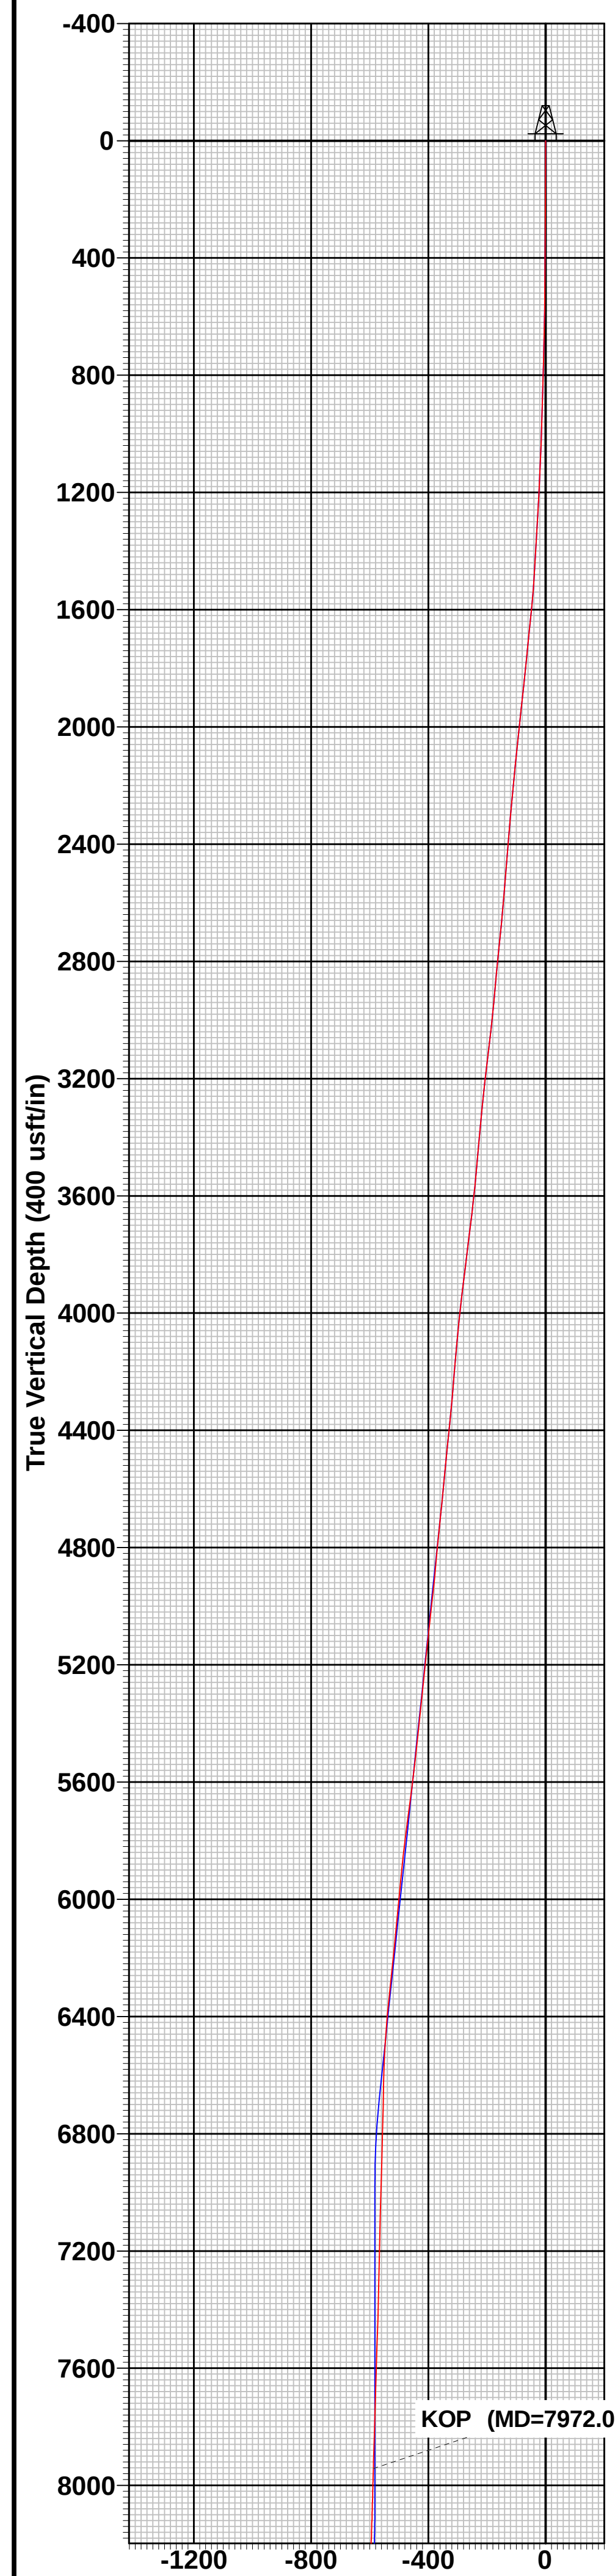



Midland

Lea County, NM (NAD 83 NME)

Modelo 3 Fed Com

#1H

OH

Design: OH

Final PVA

12 July, 2022



Final PVA

Company:	Midland	Local Co-ordinate Reference:	Well #1H
Project:	Lea County, NM (NAD 83 NME)	TVD Reference:	KB 25 @ 3677.0usft (H&P 389)
Site:	Modelo 3 Fed Com	MD Reference:	KB 25 @ 3677.0usft (H&P 389)
Well:	#1H	North Reference:	Grid
Wellbore:	OH	Survey Calculation Method:	Minimum Curvature
Design:	OH	Database:	PEDM

Project	Lea County, NM (NAD 83 NME)		
Map System:	US State Plane 1983	System Datum:	Mean Sea Level
Geo Datum:	North American Datum 1983		
Map Zone:	New Mexico Eastern Zone		

Site	Modelo 3 Fed Com		
Site Position:		Northing:	451,998.00 usft
From:	Map	Easting:	750,134.00 usft
Position Uncertainty:	0.0 usft	Slot Radius:	13-3/16 "
		Latitude:	32° 14' 26.929 N
		Longitude:	103° 39' 28.822 W
		Grid Convergence:	0.36 °

Well		#1H				
Well Position	+N/-S	0.0 usft	Northing:	451,826.00 usft	Latitude:	32° 14' 25.427 N
	+E/-W	0.0 usft	Easting:	746,907.00 usft	Longitude:	103° 40' 6.406 W
Position Uncertainty		0.0 usft	Wellhead Elevation:	usft	Ground Level:	3,652.0 usft

Wellbore	OH				
Magnetics	Model Name	Sample Date	Declination (°)	Dip Angle (°)	Field Strength (nT)
	IGRF2020	5/23/2022	6.48	59.87	47,394.65563026

Design	OH				
Audit Notes:					
Version:	1.0	Phase:	ACTUAL	Tie On Depth:	0.0
Vertical Section:	Depth From (TVD) (usft)	+N/-S (usft)	+E/-W (usft)	Direction (°)	
	0.0	0.0	0.0	182.51	

Survey Program	Date	7/12/2022			
From (usft)	To (usft)	Survey (Wellbore)	Tool Name	Description	
200.0	17,671.0	Scientific MWD #1 (OH)	EOG MWD+IFR1	MWD + IFR1	



Final PVA

Company:	Midland	Local Co-ordinate Reference:	Well #1H
Project:	Lea County, NM (NAD 83 NME)	TVD Reference:	KB 25 @ 3677.0usft (H&P 389)
Site:	Modelo 3 Fed Com	MD Reference:	KB 25 @ 3677.0usft (H&P 389)
Well:	#1H	North Reference:	Grid
Wellbore:	OH	Survey Calculation Method:	Minimum Curvature
Design:	OH	Database:	PEDM

Survey										
MD (usft)	Inc (°)	Azi (azimuth) (°)	TVD (usft)	N/S (usft)	E/W (usft)	DLeg (°/100usft)	Build (°/100usft)	Turn (°/100usft)	High to Plan (usft)	Right to Plan (usft)
0.0	0.00	0.00	0.0	0.0	0.0	0.00	0.00	0.00	0.0	0.0
200.0	0.32	290.24	200.0	0.2	-0.5	0.16	0.16	0.00	0.0	0.0
308.0	0.48	251.95	308.0	0.2	-1.2	0.28	0.15	-35.45	0.0	0.0
398.0	0.30	244.56	398.0	-0.1	-1.8	0.21	-0.20	-8.21	0.0	0.0
489.0	0.58	224.77	489.0	-0.5	-2.3	0.35	0.31	-21.75	0.0	0.0
579.0	0.80	240.21	579.0	-1.1	-3.2	0.32	0.24	17.16	0.0	0.0
670.0	1.42	220.45	670.0	-2.3	-4.5	0.79	0.68	-21.71	0.0	0.0
761.0	1.85	228.66	760.9	-4.1	-6.3	0.54	0.47	9.02	0.0	0.0
852.0	2.05	224.71	851.9	-6.3	-8.6	0.26	0.22	-4.34	0.0	0.0
942.0	2.07	208.98	941.8	-8.8	-10.5	0.63	0.02	-17.48	0.0	0.0
1,033.0	2.61	219.06	1,032.7	-11.9	-12.6	0.74	0.59	11.08	0.0	0.0
1,123.0	2.89	223.14	1,122.6	-15.1	-15.4	0.38	0.31	4.53	0.0	0.0
1,214.0	3.27	219.30	1,213.5	-18.8	-18.7	0.47	0.42	-4.22	0.0	0.0
1,274.0	3.66	221.66	1,273.4	-21.6	-21.0	0.69	0.65	3.93	0.0	0.0
1,411.0	4.17	221.03	1,410.1	-28.6	-27.2	0.37	0.37	-0.46	0.0	0.0
1,502.0	4.20	227.81	1,500.8	-33.3	-31.8	0.54	0.03	7.45	0.0	0.0
1,592.0	5.86	242.90	1,590.5	-37.6	-38.4	2.34	1.84	16.77	0.0	0.0
1,682.0	5.71	244.14	1,680.0	-41.7	-46.5	0.22	-0.17	1.38	0.0	0.0
1,771.0	5.94	264.99	1,768.6	-44.0	-55.1	2.38	0.26	23.43	0.0	0.0
1,862.0	6.69	274.94	1,859.0	-44.0	-65.0	1.46	0.82	10.93	0.0	0.0
1,953.0	6.42	272.73	1,949.4	-43.3	-75.4	0.41	-0.30	-2.43	0.0	0.0
2,043.0	6.25	271.06	2,038.9	-42.9	-85.3	0.28	-0.19	-1.86	0.0	0.0
2,133.0	6.04	273.73	2,128.4	-42.5	-94.9	0.39	-0.23	2.97	0.0	0.0
2,224.0	5.70	272.91	2,218.9	-42.0	-104.2	0.38	-0.37	-0.90	0.0	0.0
2,316.0	5.39	272.57	2,310.5	-41.6	-113.1	0.34	-0.34	-0.37	0.0	0.0
2,496.0	4.76	270.14	2,489.8	-41.2	-129.0	0.37	-0.35	-1.35	0.0	0.0
2,586.0	4.69	268.32	2,579.5	-41.3	-136.4	0.18	-0.08	-2.02	0.0	0.0



Final PVA

Company:	Midland	Local Co-ordinate Reference:	Well #1H
Project:	Lea County, NM (NAD 83 NME)	TVD Reference:	KB 25 @ 3677.0usft (H&P 389)
Site:	Modelo 3 Fed Com	MD Reference:	KB 25 @ 3677.0usft (H&P 389)
Well:	#1H	North Reference:	Grid
Wellbore:	OH	Survey Calculation Method:	Minimum Curvature
Design:	OH	Database:	PEDM

Survey											
MD (usft)	Inc (°)	Azi (azimuth) (°)	TVD (usft)	N/S (usft)	E/W (usft)	DLeg (°/100usft)	Build (°/100usft)	Turn (°/100usft)	High to Plan (usft)	Right to Plan (usft)	
2,677.0	5.89	262.62	2,670.1	-42.0	-144.8	1.44	1.32	-6.26	0.0	0.0	
2,768.0	5.72	260.95	2,760.6	-43.3	-153.9	0.26	-0.19	-1.84	0.0	0.0	
2,857.0	5.16	261.91	2,849.2	-44.5	-162.2	0.64	-0.63	1.08	0.0	0.0	
2,947.0	5.23	258.69	2,938.8	-45.9	-170.3	0.33	0.08	-3.58	0.0	0.0	
3,038.0	6.98	251.78	3,029.3	-48.5	-179.6	2.08	1.92	-7.59	0.0	0.0	
3,129.0	6.61	251.11	3,119.7	-51.9	-189.8	0.42	-0.41	-0.74	0.0	0.0	
3,220.0	6.24	249.99	3,210.1	-55.3	-199.4	0.43	-0.41	-1.23	0.0	0.0	
3,310.0	5.93	248.79	3,299.6	-58.6	-208.3	0.37	-0.34	-1.33	0.0	0.0	
3,401.0	5.49	248.81	3,390.1	-61.9	-216.8	0.48	-0.48	0.02	0.0	0.0	
3,491.0	4.87	251.75	3,479.8	-64.7	-224.4	0.75	-0.69	3.27	0.0	0.0	
3,581.0	5.41	250.60	3,569.4	-67.3	-232.0	0.61	0.60	-1.28	0.0	0.0	
3,672.0	7.18	252.26	3,659.9	-70.4	-241.5	1.96	1.95	1.82	0.0	0.0	
3,762.0	6.95	253.92	3,749.2	-73.6	-252.1	0.34	-0.26	1.84	0.0	0.0	
3,852.0	6.86	254.83	3,838.5	-76.6	-262.5	0.16	-0.10	1.01	0.0	0.0	
3,943.0	6.68	257.22	3,928.9	-79.1	-272.9	0.37	-0.20	2.63	0.0	0.0	
4,033.0	6.22	259.34	4,018.3	-81.2	-282.8	0.58	-0.51	2.36	0.0	0.0	
4,123.0	5.29	260.30	4,107.9	-82.8	-291.7	1.04	-1.03	1.07	0.0	0.0	
4,214.0	4.42	255.78	4,198.5	-84.4	-299.2	1.04	-0.96	-4.97	0.0	0.0	
4,305.0	5.33	248.17	4,289.2	-86.8	-306.6	1.22	1.00	-8.36	0.0	0.0	
4,395.0	6.19	244.37	4,378.7	-90.5	-314.8	1.04	0.96	-4.22	0.0	0.0	
4,486.0	5.66	236.04	4,469.3	-95.1	-323.0	1.11	-0.58	-9.15	0.0	0.0	
4,576.0	5.88	230.33	4,558.8	-100.5	-330.2	0.68	0.24	-6.34	0.0	0.0	
4,667.0	6.86	231.10	4,649.2	-106.9	-338.0	1.08	1.08	0.85	0.0	0.0	
4,704.0	6.45	230.77	4,686.0	-109.6	-341.3	1.11	-1.11	-0.89	0.0	0.0	
4,838.0	5.70	225.67	4,819.2	-119.0	-351.9	0.69	-0.56	-3.81	-0.6	3.5	
4,929.0	5.67	238.62	4,909.8	-124.5	-359.0	1.41	-0.03	14.23	0.3	7.6	
5,019.0	6.62	258.14	4,999.3	-127.9	-367.9	2.53	1.06	21.69	2.8	8.5	



Final PVA

Company:	Midland	Local Co-ordinate Reference:	Well #1H
Project:	Lea County, NM (NAD 83 NME)	TVD Reference:	KB 25 @ 3677.0usft (H&P 389)
Site:	Modelo 3 Fed Com	MD Reference:	KB 25 @ 3677.0usft (H&P 389)
Well:	#1H	North Reference:	Grid
Wellbore:	OH	Survey Calculation Method:	Minimum Curvature
Design:	OH	Database:	PEDM

Survey										
MD (usft)	Inc (°)	Azi (azimuth) (°)	TVD (usft)	N/S (usft)	E/W (usft)	DLeg (°/100usft)	Build (°/100usft)	Turn (°/100usft)	High to Plan (usft)	Right to Plan (usft)
5,200.0	6.37	273.77	5,179.1	-129.4	-388.1	0.98	-0.14	8.64	3.1	5.1
5,291.0	6.06	274.47	5,269.6	-128.7	-397.9	0.35	-0.34	0.77	2.4	2.4
5,381.0	6.37	273.24	5,359.1	-128.0	-407.6	0.37	0.34	-1.37	1.6	-0.1
5,471.0	6.56	272.64	5,448.5	-127.5	-417.8	0.22	0.21	-0.67	0.6	-2.6
5,562.0	6.69	273.33	5,538.9	-127.0	-428.2	0.17	0.14	0.76	-0.8	-5.1
5,652.0	7.67	260.65	5,628.2	-127.6	-439.4	2.06	1.09	-14.09	-1.4	-6.7
5,743.0	7.57	257.64	5,718.4	-129.9	-451.3	0.45	-0.11	-3.31	-3.7	-7.1
5,833.0	6.69	257.07	5,807.7	-132.3	-462.2	0.98	-0.98	-0.63	-5.4	-7.0
5,924.0	5.59	257.03	5,898.2	-134.5	-471.6	1.21	-1.21	-0.04	-5.6	-6.9
6,014.0	5.32	256.08	5,987.8	-136.5	-480.0	0.32	-0.30	-1.06	-4.7	-6.8
6,196.0	5.77	255.48	6,168.9	-140.8	-497.0	0.25	0.25	-0.33	-3.2	-6.1
6,286.0	6.10	254.54	6,258.4	-143.2	-506.0	0.38	0.37	-1.04	-3.0	-5.7
6,377.0	5.90	262.27	6,348.9	-145.2	-515.3	0.91	-0.22	8.49	-3.7	-5.3
6,467.0	4.81	272.77	6,438.5	-145.6	-523.6	1.62	-1.21	11.67	-3.9	-6.1
6,557.0	2.88	266.69	6,528.3	-145.5	-529.7	2.19	-2.14	-6.76	0.1	-8.4
6,648.0	1.23	233.33	6,619.3	-146.3	-532.7	2.17	-1.81	-36.66	10.4	-4.3
6,737.0	1.42	233.95	6,708.3	-147.5	-534.4	0.21	0.21	0.70	16.7	-0.7
6,828.0	1.54	227.94	6,799.2	-149.0	-536.2	0.22	0.13	-6.60	20.5	4.5
6,918.0	1.60	232.98	6,889.2	-150.5	-538.1	0.17	0.07	5.60	22.2	4.6
7,009.0	1.68	238.81	6,980.2	-152.0	-540.3	0.20	0.09	6.41	21.3	2.9
7,099.0	1.49	252.30	7,070.1	-153.0	-542.5	0.46	-0.21	14.99	18.9	-1.8
7,280.0	1.42	231.02	7,251.1	-155.1	-546.5	0.30	-0.04	-11.76	13.9	4.3
7,369.0	1.67	214.45	7,340.0	-156.9	-548.1	0.57	0.28	-18.62	9.7	7.8
7,460.0	2.17	209.77	7,431.0	-159.5	-549.7	0.58	0.55	-5.14	6.0	8.4
7,550.0	2.43	208.51	7,520.9	-162.7	-551.5	0.29	0.29	-1.40	2.2	8.5
7,640.0	2.57	211.68	7,610.8	-166.0	-553.4	0.22	0.16	3.52	-1.3	8.5
7,731.0	2.48	205.10	7,701.7	-169.6	-555.3	0.33	-0.10	-7.23	-6.2	8.1



Final PVA

Company: Midland
Project: Lea County, NM (NAD 83 NME)
Site: Modelo 3 Fed Com
Well: #1H
Wellbore: OH
Design: OH

Local Co-ordinate Reference: Well #1H
TVD Reference: KB 25 @ 3677.0usft (H&P 389)
MD Reference: KB 25 @ 3677.0usft (H&P 389)
North Reference: Grid
Survey Calculation Method: Minimum Curvature
Database: PEDM

Survey											
MD (usft)	Inc (°)	Azi (azimuth) (°)	TVD (usft)	N/S (usft)	E/W (usft)	DLeg (°/100usft)	Build (°/100usft)	Turn (°/100usft)	High to Plan (usft)	Right to Plan (usft)	
7,821.0	2.56	207.04	7,791.6	-173.1	-557.1	0.13	0.09	2.16	-9.9	8.4	
7,911.0	2.45	206.86	7,881.6	-176.6	-558.9	0.12	-0.12	-0.20	-13.9	8.3	
7,972.0	4.73	183.51	7,942.4	-180.3	-559.6	4.37	3.74	-38.28	-19.7	1.6	
KOP (MD=7972.0')											
8,003.0	6.01	178.79	7,973.3	-183.2	-559.6	4.37	4.13	-15.22	-22.7	-0.1	
8,094.0	18.95	168.42	8,062.0	-202.5	-556.6	14.38	14.22	-11.40	-41.8	-5.3	
8,184.0	29.02	167.53	8,144.1	-238.2	-548.9	11.20	11.19	-0.99	-73.6	-5.9	
8,274.0	36.32	167.35	8,219.8	-285.6	-538.3	8.11	8.11	-0.20	-104.3	-4.2	
8,365.0	39.75	168.51	8,291.5	-340.5	-526.6	3.85	3.77	1.27	-127.5	1.3	
8,455.0	43.50	171.57	8,358.7	-399.3	-516.3	4.74	4.17	3.40	-138.2	9.3	
8,545.0	49.23	172.46	8,420.8	-463.8	-507.3	6.41	6.37	0.99	-137.8	10.8	
8,589.8	51.46	173.06	8,449.4	-498.0	-503.0	5.08	4.97	1.34	-133.9	11.1	
HL Crossing, MD:8589.8', TVD:8449.4', N/S: -498.0', E/W: -503.0', INC:51.46											
8,636.0	53.76	173.64	8,477.5	-534.5	-498.7	5.08	4.98	1.26	-126.9	10.6	
8,726.0	59.05	173.70	8,527.2	-609.0	-490.5	5.88	5.88	0.07	-106.2	7.8	
8,817.0	63.62	173.45	8,570.9	-688.3	-481.5	5.03	5.02	-0.27	-76.5	5.1	
8,908.0	70.27	173.22	8,606.5	-771.4	-471.8	7.31	7.31	-0.25	-42.9	3.8	
8,998.0	78.99	176.47	8,630.3	-857.7	-464.1	10.29	9.69	3.61	-20.0	5.0	
9,088.0	85.38	175.95	8,642.6	-946.7	-458.2	7.12	7.10	-0.58	-8.7	9.3	
9,179.0	86.05	181.08	8,649.4	-1,037.3	-455.8	5.67	0.74	5.64	-2.8	11.1	
9,269.0	86.62	181.27	8,655.1	-1,127.1	-457.7	0.67	0.63	0.21	2.1	8.8	
9,360.0	88.08	180.12	8,659.3	-1,218.0	-458.8	2.04	1.60	-1.26	5.3	7.1	
9,448.0	88.23	179.85	8,662.2	-1,306.0	-458.8	0.35	0.17	-0.31	7.2	6.6	
9,538.0	87.92	179.24	8,665.2	-1,395.9	-458.0	0.76	-0.34	-0.68	9.4	6.8	
9,628.0	89.90	180.47	8,666.9	-1,485.9	-457.8	2.59	2.20	1.37	10.1	6.5	
9,719.0	90.97	180.07	8,666.2	-1,576.9	-458.2	1.26	1.18	-0.44	8.5	5.6	
9,810.0	91.48	178.40	8,664.3	-1,667.9	-457.0	1.92	0.56	-1.84	5.6	6.3	



Final PVA

Company: Midland
Project: Lea County, NM (NAD 83 NME)
Site: Modelo 3 Fed Com
Well: #1H
Wellbore: OH
Design: OH

Local Co-ordinate Reference: Well #1H
TVD Reference: KB 25 @ 3677.0usft (H&P 389)
MD Reference: KB 25 @ 3677.0usft (H&P 389)
North Reference: Grid
Survey Calculation Method: Minimum Curvature
Database: PEDM

Survey											
MD (usft)	Inc (°)	Azi (azimuth) (°)	TVD (usft)	N/S (usft)	E/W (usft)	DLeg (°/100usft)	Build (°/100usft)	Turn (°/100usft)	High to Plan (usft)	Right to Plan (usft)	
9,900.0	92.45	178.03	8,661.2	-1,757.8	-454.2	1.15	1.08	-0.41	1.6	8.5	
9,991.0	88.09	178.94	8,660.8	-1,848.7	-451.8	4.89	-4.79	1.00	0.6	10.4	
10,082.0	88.06	179.84	8,663.8	-1,939.7	-450.9	0.99	-0.03	0.99	3.6	10.9	
10,172.0	91.18	180.50	8,664.4	-2,029.6	-451.1	3.54	3.47	0.73	4.2	10.1	
10,263.0	91.28	181.07	8,662.5	-2,120.6	-452.4	0.64	0.11	0.63	2.2	8.3	
10,354.0	90.17	180.46	8,661.3	-2,211.6	-453.6	1.39	-1.22	-0.67	1.0	6.6	
10,444.0	90.81	179.94	8,660.5	-2,301.6	-453.9	0.92	0.71	-0.58	0.2	5.7	
10,534.0	91.34	180.60	8,658.8	-2,391.6	-454.3	0.94	0.59	0.73	-1.5	4.8	
10,625.0	91.91	181.10	8,656.3	-2,482.5	-455.7	0.83	0.63	0.55	-4.2	2.9	
10,715.0	89.30	181.03	8,655.3	-2,572.5	-457.3	2.90	-2.90	-0.08	-5.2	0.7	
10,805.0	88.93	182.53	8,656.7	-2,662.4	-460.1	1.72	-0.41	1.67	-3.8	-2.6	
10,896.0	90.54	180.85	8,657.1	-2,753.4	-462.8	2.56	1.77	-1.85	-3.4	-5.8	
10,986.0	89.97	180.19	8,656.7	-2,843.4	-463.6	0.97	-0.63	-0.73	-3.9	-7.1	
11,076.0	88.59	180.21	8,657.9	-2,933.4	-464.0	1.53	-1.53	0.02	-2.8	-8.0	
11,166.0	89.23	179.38	8,659.6	-3,023.4	-463.6	1.16	0.71	-0.92	-1.1	-8.2	
11,256.0	90.60	179.60	8,659.7	-3,113.4	-462.8	1.54	1.52	0.24	-1.0	-7.9	
11,347.0	89.06	178.87	8,660.0	-3,204.3	-461.6	1.87	-1.69	-0.80	-0.8	-7.2	
11,438.0	89.46	178.56	8,661.1	-3,295.3	-459.6	0.56	0.44	-0.34	0.4	-5.7	
11,528.0	91.58	180.10	8,660.3	-3,385.3	-458.5	2.91	2.36	1.71	-0.5	-5.1	
11,619.0	90.44	177.69	8,658.7	-3,476.3	-456.8	2.93	-1.25	-2.65	-2.1	-3.9	
11,710.0	87.72	178.25	8,660.2	-3,567.2	-453.5	3.05	-2.99	0.62	-0.7	-1.2	
11,820.0	88.05	177.99	8,664.2	-3,677.0	-449.9	0.38	0.30	-0.24	3.3	1.8	
11,910.0	87.65	178.29	8,667.6	-3,766.9	-447.0	0.56	-0.44	0.33	6.6	4.2	
12,001.0	87.72	177.13	8,671.3	-3,857.8	-443.4	1.28	0.08	-1.27	10.3	7.3	
12,091.0	89.16	176.75	8,673.7	-3,947.6	-438.6	1.65	1.60	-0.42	12.7	11.6	
12,180.0	91.07	179.09	8,673.6	-4,036.6	-435.4	3.39	2.15	2.63	12.5	14.3	
12,270.0	92.01	180.09	8,671.1	-4,126.5	-434.7	1.52	1.04	1.11	10.0	14.4	



Final PVA

Company:	Midland	Local Co-ordinate Reference:	Well #1H
Project:	Lea County, NM (NAD 83 NME)	TVD Reference:	KB 25 @ 3677.0usft (H&P 389)
Site:	Modelo 3 Fed Com	MD Reference:	KB 25 @ 3677.0usft (H&P 389)
Well:	#1H	North Reference:	Grid
Wellbore:	OH	Survey Calculation Method:	Minimum Curvature
Design:	OH	Database:	PEDM

Survey										
MD (usft)	Inc (°)	Azi (azimuth) (°)	TVD (usft)	N/S (usft)	E/W (usft)	DLeg (°/100usft)	Build (°/100usft)	Turn (°/100usft)	High to Plan (usft)	Right to Plan (usft)
12,361.0	91.78	180.21	8,668.1	-4,217.5	-435.0	0.29	-0.25	0.13	7.0	13.7
12,452.0	92.38	180.10	8,664.8	-4,308.4	-435.2	0.67	0.66	-0.12	3.6	12.9
12,542.0	89.56	180.05	8,663.3	-4,398.4	-435.3	3.13	-3.13	-0.06	2.1	12.3
12,633.0	88.62	179.82	8,664.8	-4,489.4	-435.2	1.06	-1.03	-0.25	3.5	11.8
12,724.0	89.13	180.99	8,666.5	-4,580.4	-435.9	1.40	0.56	1.29	5.2	10.7
12,815.0	89.26	180.89	8,667.8	-4,671.3	-437.3	0.18	0.14	-0.11	6.5	8.7
12,905.0	89.06	180.49	8,669.1	-4,761.3	-438.4	0.50	-0.22	-0.44	7.8	7.1
12,995.0	88.86	180.08	8,670.8	-4,851.3	-438.9	0.51	-0.22	-0.46	9.4	6.1
13,086.0	88.69	179.81	8,672.7	-4,942.3	-438.8	0.35	-0.19	-0.30	11.3	5.7
13,176.0	89.03	179.97	8,674.5	-5,032.3	-438.6	0.42	0.38	0.18	13.0	5.3
13,266.0	89.63	178.91	8,675.6	-5,122.2	-437.7	1.35	0.67	-1.18	14.0	5.7
13,356.0	89.36	178.84	8,676.4	-5,212.2	-436.0	0.31	-0.30	-0.08	14.8	6.9
13,446.0	88.76	177.98	8,677.8	-5,302.2	-433.5	1.17	-0.67	-0.96	16.2	8.9
13,537.0	91.04	178.53	8,678.0	-5,393.1	-430.7	2.58	2.51	0.60	16.4	11.1
13,628.0	91.61	178.33	8,675.9	-5,484.1	-428.2	0.66	0.63	-0.22	14.2	13.1
13,719.0	90.70	178.04	8,674.1	-5,575.0	-425.3	1.05	-1.00	-0.32	12.4	15.5
13,809.0	90.74	178.28	8,672.9	-5,665.0	-422.4	0.27	0.04	0.27	11.2	17.8
13,899.0	91.95	179.81	8,670.8	-5,754.9	-420.9	2.17	1.34	1.70	9.1	18.8
13,990.0	91.38	180.88	8,668.2	-5,845.9	-421.5	1.33	-0.63	1.18	6.4	17.8
14,080.0	90.20	181.19	8,666.9	-5,935.8	-423.1	1.36	-1.31	0.34	5.1	15.6
14,170.0	90.07	180.63	8,666.7	-6,025.8	-424.5	0.64	-0.14	-0.62	4.9	13.7
14,261.0	90.44	180.35	8,666.3	-6,116.8	-425.3	0.51	0.41	-0.31	4.5	12.4
14,351.0	88.25	179.39	8,667.3	-6,206.8	-425.1	2.66	-2.43	-1.07	5.5	12.1
14,442.0	88.36	180.13	8,670.0	-6,297.8	-424.7	0.82	0.12	0.81	8.1	11.9
14,532.0	87.89	179.98	8,673.0	-6,387.7	-424.8	0.55	-0.52	-0.17	11.0	11.3
14,623.0	89.40	180.02	8,675.1	-6,478.7	-424.8	1.66	1.66	0.04	13.2	10.8
14,713.0	91.21	180.79	8,674.6	-6,568.7	-425.5	2.19	2.01	0.86	12.7	9.6



Final PVA

Company: Midland
Project: Lea County, NM (NAD 83 NME)
Site: Modelo 3 Fed Com
Well: #1H
Wellbore: OH
Design: OH

Local Co-ordinate Reference: Well #1H
TVD Reference: KB 25 @ 3677.0usft (H&P 389)
MD Reference: KB 25 @ 3677.0usft (H&P 389)
North Reference: Grid
Survey Calculation Method: Minimum Curvature
Database: PEDM

Survey											
MD (usft)	Inc (°)	Azi (azimuth) (°)	TVD (usft)	N/S (usft)	E/W (usft)	DLeg (°/100usft)	Build (°/100usft)	Turn (°/100usft)	High to Plan (usft)	Right to Plan (usft)	
14,804.0	91.07	179.32	8,672.8	-6,659.7	-425.5	1.62	-0.15	-1.62	10.8	9.0	
14,894.0	91.14	179.44	8,671.1	-6,749.6	-424.6	0.15	0.08	0.13	9.1	9.5	
14,985.0	91.91	180.21	8,668.7	-6,840.6	-424.3	1.20	0.85	0.85	6.6	9.2	
15,076.0	89.90	178.70	8,667.2	-6,931.6	-423.4	2.76	-2.21	-1.66	5.1	9.6	
15,166.0	88.89	177.74	8,668.2	-7,021.5	-420.6	1.55	-1.12	-1.07	6.1	11.9	
15,257.0	88.72	176.85	8,670.1	-7,112.4	-416.3	1.00	-0.19	-0.98	7.9	15.6	
15,347.0	88.22	179.07	8,672.5	-7,202.3	-413.1	2.53	-0.56	2.47	10.3	18.3	
15,438.0	88.72	178.40	8,674.9	-7,293.3	-411.1	0.92	0.55	-0.74	12.7	19.8	
15,528.0	89.93	179.27	8,676.0	-7,383.2	-409.3	1.66	1.34	0.97	13.8	21.1	
15,619.0	90.20	180.22	8,675.9	-7,474.2	-408.9	1.09	0.30	1.04	13.6	21.0	
15,709.0	90.47	179.93	8,675.4	-7,564.2	-409.0	0.44	0.30	-0.32	13.1	20.4	
15,800.0	90.27	179.89	8,674.8	-7,655.2	-408.9	0.22	-0.22	-0.04	12.5	20.0	
15,890.0	90.20	180.72	8,674.4	-7,745.2	-409.3	0.93	-0.08	0.92	12.1	19.0	
15,981.0	89.16	180.16	8,674.9	-7,836.2	-410.0	1.30	-1.14	-0.62	12.6	17.8	
16,071.0	88.86	179.62	8,676.5	-7,926.2	-409.9	0.69	-0.33	-0.60	14.1	17.4	
16,161.0	88.39	178.69	8,678.6	-8,016.2	-408.5	1.16	-0.52	-1.03	16.2	18.2	
16,252.0	89.26	179.84	8,680.5	-8,107.1	-407.4	1.58	0.96	1.26	18.1	18.9	
16,343.0	88.89	180.55	8,682.0	-8,198.1	-407.7	0.88	-0.41	0.78	19.5	18.0	
16,433.0	88.29	180.27	8,684.2	-8,288.1	-408.3	0.74	-0.67	-0.31	21.7	16.9	
16,523.0	88.35	179.74	8,686.8	-8,378.1	-408.3	0.59	0.07	-0.59	24.3	16.3	
16,615.0	89.70	181.27	8,688.4	-8,470.0	-409.2	2.22	1.47	1.66	25.8	15.0	
16,705.0	89.63	180.91	8,688.9	-8,560.0	-410.9	0.41	-0.08	-0.40	26.3	12.2	
16,796.0	89.90	180.12	8,689.3	-8,651.0	-411.7	0.92	0.30	-0.87	26.3	7.6	
16,886.0	90.44	177.93	8,689.0	-8,741.0	-410.2	2.51	0.60	-2.43	25.4	3.2	
16,976.0	89.97	176.98	8,688.7	-8,830.9	-406.2	1.18	-0.52	-1.06	24.5	1.1	
17,067.0	88.49	176.54	8,689.9	-8,921.7	-401.0	1.70	-1.63	-0.48	25.1	0.0	
17,155.0	89.30	177.81	8,691.6	-9,009.6	-396.7	1.71	0.92	1.44	26.2	-1.6	



Final PVA

Company: Midland
Project: Lea County, NM (NAD 83 NME)
Site: Modelo 3 Fed Com
Well: #1H
Wellbore: OH
Design: OH

Local Co-ordinate Reference: Well #1H
TVD Reference: KB 25 @ 3677.0usft (H&P 389)
MD Reference: KB 25 @ 3677.0usft (H&P 389)
North Reference: Grid
Survey Calculation Method: Minimum Curvature
Database: PEDM

Survey											
MD (usft)	Inc (°)	Azi (azimuth) (°)	TVD (usft)	N/S (usft)	E/W (usft)	DLeg (°/100usft)	Build (°/100usft)	Turn (°/100usft)	High to Plan (usft)	Right to Plan (usft)	
17,247.0	88.76	177.72	8,693.2	-9,101.5	-393.1	0.60	-0.59	-0.10	27.1	-4.2	
17,337.0	87.48	174.69	8,696.1	-9,191.3	-387.1	3.65	-1.42	-3.37	29.4	-4.4	
17,427.0	87.05	173.71	8,700.4	-9,280.7	-378.1	1.19	-0.48	-1.09	33.1	-1.4	
17,518.0	87.75	173.81	8,704.5	-9,371.1	-368.2	0.78	0.77	0.11	36.6	2.4	
17,604.0	88.42	173.52	8,707.4	-9,456.5	-358.7	0.85	0.78	-0.34	38.9	6.1	
Final MWD Survey (MD=17604.0')											
17,671.0	88.42	173.52	8,709.3	-9,523.1	-351.1	0.00	0.00	0.00	40.3	9.1	
Final Projection to Bit (MD=17671.0')											

Design Annotations					
Measured Depth (usft)	Vertical Depth (usft)	Local Coordinates		Comment	
		+N/-S (usft)	+E/-W (usft)		
7,972.0	7,942.4	-180.3	-559.6	KOP (MD=7972.0')	
8,589.8	8,449.4	-498.0	-503.0	HL Crossing, MD:8589.8', TVD:8449.4', N/S:-498.0', E/W:-503.0', INC:51.46	
17,604.0	8,707.4	-9,456.5	-358.7	Final MWD Survey (MD=17604.0')	
17,671.0	8,709.3	-9,523.1	-351.1	Final Projection to Bit (MD=17671.0')	

Checked By: _____ Approved By: _____ Date: _____

I CERTIFY THIS SURVEY TO BE TRUE AND CORRECT TO THE BEST OF MY BELIEF AND KNOWLEDGE
 KAY MADDOX 10/18/2022

Intent ☐ As Drilled ☐

API #		
Operator Name:	Property Name:	Well Number

Kick Off Point (KOP)

UL	Section	Township	Range	Lot	Feet	From N/S	Feet	From E/W	County
Latitude					Longitude				NAD

First Take Point (FTP)

UL	Section	Township	Range	Lot	Feet	From N/S	Feet	From E/W	County
Latitude					Longitude				NAD

Last Take Point (LTP)

UL	Section	Township	Range	Lot	Feet	From N/S	Feet	From E/W	County
Latitude					Longitude				NAD

Is this well the defining well for the Horizontal Spacing Unit? ☐Is this well an infill well? ☐

If infill is yes please provide API if available, Operator Name and well number for Defining well for Horizontal Spacing Unit.

API #		
Operator Name:	Property Name:	Well Number

KZ 06/29/2018

Submit To Appropriate District Office Two Copies <u>District I</u> 1625 N. French Dr., Hobbs, NM 88240 <u>District II</u> 811 S. First St., Artesia, NM 88210 <u>District III</u> 1000 Rio Brazos Rd., Aztec, NM 87410 <u>District IV</u> 1220 S. St. Francis Dr., Santa Fe, NM 87505		State of New Mexico Energy, Minerals and Natural Resources Oil Conservation Division 1220 South St. Francis Dr. Santa Fe, NM 87505			Form C-105 Revised August 1, 2011					
WELL COMPLETION OR RECOMPLETION REPORT AND LOG										
4. Reason for filing: ☒ COMPLETION REPORT (Fill in boxes #1 through #31 for State and Fee wells only) ☐ C-144 CLOSURE ATTACHMENT (Fill in boxes #1 through #9, #15 Date Rig Released and #32 and/or #33; attach this and the plat to the C-144 closure report in accordance with 19.15.17.13.K NMAC)								5. Lease Name or Unit Agreement Name MODELO 3 FEDERAL COM		
								6. Well Number: 1H		
7. Type of Completion: ☒ NEW WELL ☐ WORKOVER ☐ DEEPENING ☐ PLUGBACK ☐ DIFFERENT RESERVOIR ☐ OTHER _____										
8. Name of Operator EOG RESOURCES INC						9. OGRID 7377				
10. Address of Operator PO BOX 2267 MIDLAND, TEXAS 79702						11. Pool name or Wildcat DOUBLE X; DELAWARE				
12. Location	Unit Ltr	Section	Township	Range	Lot	Feet from the	N/S Line	Feet from the	E/W Line	County
Surface:	M	3	24S	32E		392	SOUTH	803	WEST	LEA
BH:	L	15	24S	32E		1429	SOUTH	397	WEST	LEA
13. Date Spudded 05/23/2022	14. Date T.D. Reached 07/11/2022		15. Date Rig Released 07/12/2022			16. Date Completed (Ready to Produce) 09/12/2022		17. Elevations (DF and RKB, RT, GR, etc.) 3652' GL		
18. Total Measured Depth of Well MD 17,671' TVD 8709'			19. Plug Back Measured Depth MD 17,504' TVD 8709'			20. Was Directional Survey Made? YES		21. Type Electric and Other Logs Run None		
22. Producing Interval(s), of this completion - Top, Bottom, Name DELAWARE 8745 - 17,504'										
23. CASING RECORD (Report all strings set in well)										
CASING SIZE		WEIGHT LB./FT.		DEPTH SET		HOLE SIZE		CEMENTING RECORD		AMOUNT PULLED
13 3/8"		54.5# J-55		1322'		17 1/2"		1155 CL C/CIRC		
9 5/8"		36# J-55		4755'		12 1/4"		1190 CL C/CIRC		
5 1/2"		20# HCP-110		17,656'		8 3/4"		3130 CL H/TOC 0		
24. LINER RECORD						25. TUBING RECORD				
SIZE	TOP	BOTTOM	SACKS CEMENT	SCREEN		SIZE	DEPTH SET	PACKER SET		
26. Perforation record (interval, size, and number) 8745 - 17,504' 3 1/8", 2220 holes						27. ACID, SHOT, FRACTURE, CEMENT, SQUEEZE, ETC.				
						DEPTH INTERVAL		AMOUNT AND KIND MATERIAL USED		
						8745 - 17,504'		FRAC W/12, 645,042 lbs proppant, 245,396 bbls load fld		
28. PRODUCTION										
Date First Production 09/12/2022		Production Method (<i>Flowing, gas lift, pumping - Size and type pump</i>) Flowing				Well Status (<i>Prod. or Shut-in</i>) Producing				
Date of Test 09/28/2022	Hours Tested 24	Choke Size	Prod'n For Test Period	Oil - Bbl 1056	Gas - MCF 1412	Water - Bbl. 6490	Gas - Oil Ratio 1337			
Flow Tubing Press.	Casing Pressure 270	Calculated 24-Hour Rate	Oil - Bbl.	Gas - MCF	Water - Bbl.	Oil Gravity - API - (<i>Corr.</i>) 43				
29. Disposition of Gas (<i>Sold, used for fuel, vented, etc.</i>) SOLD								30. Test Witnessed By		
31. List Attachments C-102, C-104, Directional Survey, H spacing										
32. If a temporary pit was used at the well, attach a plat with the location of the temporary pit.										
33. If an on-site burial was used at the well, report the exact location of the on-site burial: Latitude _____ Longitude _____ NAD 1927 1983										
I hereby certify that the information shown on both sides of this form is true and complete to the best of my knowledge and belief Printed Signature Kay Maddox Name Kay Maddox Title Senior Regulatory Specialist Date 10/18/2022 E-mail Address kay_maddox@eogresources.com										

This form is to be filed with the appropriate District Office of the Division not later than 20 days after the completion of any newly-drilled or deepened well and not later than 60 days after completion of closure. When submitted as a completion report, this shall be accompanied by one copy of all electrical and radio-activity logs run on the well and a summary of all special tests conducted, including drill stem tests. All depths reported shall be measured depths. In the case of directionally drilled wells, true vertical depths shall also be reported. For multiple completions, items 11, 12 and 26-31 shall be reported for each zone.

Southeastern New Mexico			Northwestern New Mexico				
T. Anhy	Rustler	1132'	T. Canyon	Brushy	7039'	T. Ojo Alamo	T. Penn A "
T. Salt		1437'	T. Strawn			T. Kirtland	T. Penn. "B"
B. Salt		4643'	T. Atoka			T. Fruitland	T. Penn. "C"
T. Yates			T. Miss			T. Pictured Cliffs	T. Penn. "D"
T. 7 Rivers			T. Devonian			T. Cliff House	T. Leadville
T. Queen			T. Silurian			T. Menefee	T. Madison
T. Grayburg			T. Montoya			T. Point Lookout	T. Elbert
T. San Andres			T. Simpson			T. Mancos	T. McCracken
T. Glorieta			T. McKee			T. Gallup	T. Ignacio Otzte
T. Paddock			T. Ellenburger			Base Greenhorn	T. Granite
T. Blinebry			T. Gr. Wash			T. Dakota	
T. Tubb			T. Delaware Sand	8718'		T. Morrison	
T. Drinkard			T. Bone Springs			T. Todilto	
T. Abo			T.			T. Entrada	
T. Wolfcamp			T.			T. Wingate	
T. Penn			T.			T. Chinle	
T. Cisco (Bough C)			T.			T. Permian	

No. 1, from.....to.....
 No. 2, from.....to.....
 No. 3, from.....to.....
 No. 4, from.....to.....

Include data on rate of water inflow and elevation to which water rose in hole.

No. 1, from.....to.....feet.....
 No. 2, from.....to.....feet.....
 No. 3, from.....to.....feet.....

From	To	Thickness In Feet	Lithology

From	To	Thickness In Feet	Lithology

Sante Fe Main Office
Phone: (505) 476-3441

General Information
Phone: (505) 629-6116

Online Phone Directory
<https://www.emnrd.nm.gov/ocd/contact-us>

State of New Mexico
Energy, Minerals and Natural Resources
Oil Conservation Division
1220 S. St Francis Dr.
Santa Fe, NM 87505

ACKNOWLEDGMENTS

Action 151765

ACKNOWLEDGMENTS

Operator: EOG RESOURCES INC 5509 Champions Drive Midland, TX 79706	OGRID: 7377
	Action Number: 151765
	Action Type: [C-104] Completion Packet (C-104C)

ACKNOWLEDGMENTS

☒	I hereby certify that the required Water Use Report has been, or will be, submitted for this wells completion.
☒	I hereby certify that the required FracFocus disclosure has been, or will be, submitted for this wells completion.

Sante Fe Main Office
Phone: (505) 476-3441

General Information
Phone: (505) 629-6116

Online Phone Directory
<https://www.emnrd.nm.gov/ocd/contact-us>

State of New Mexico
Energy, Minerals and Natural Resources
Oil Conservation Division
1220 S. St Francis Dr.
Santa Fe, NM 87505

CONDITIONS

Action 151765

CONDITIONS

Operator: EOG RESOURCES INC 5509 Champions Drive Midland, TX 79706	OGRID: 7377
	Action Number: 151765
	Action Type: [C-104] Completion Packet (C-104C)

CONDITIONS

Created By	Condition	Condition Date
plmartinez	File 3160-4 Completion Report within 10 days of BLM approval.	1/21/2026