



NSL-1251
Rule 104-F
Wildcat Morrow
8-31-80

Cities Waiver In

Amoco Production Company


Post Office Box 68
Hobbs, New Mexico 88240

S. J. Okerson
District Superintendent

August 1, 1980

File: SJ0-986.51 x WF-988

Re: Request for Administrative Approval
Unorthodox Location
Federal "BI" Well No. 1
Lea County, New Mexico

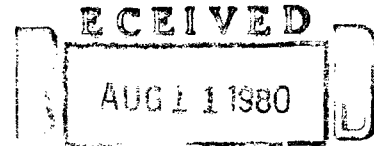

OIL CONSERVATION DIVISION
SANTA FE

The State of New Mexico
Energy and Minerals Department
Oil Conservation Division
P. O. Box 2088
Santa Fe, NM 87501

Gentlemen:

Amoco Production Company requests administrative approval of an unorthodox location due to topographical reasons on our Federal "BI" Well No. 1 located 480' FSI and 1980' FWL, Section 28, T-17-S, R-32-E, Lea County, New Mexico. The subject well location was moved to an unorthodox location due to a buried pipeline to the northwest and a water injection well to the east of the nearest orthodox location. Attached is a plat, a map and certified mail receipts from letters to the offset operators.

Yours very truly,

S. J. Okerson
HOL

Attachments

cc: E. D. Newman
Houston, TX

J. C. Allen
Houston, TX

NMOCD
Hobbs, NM

**NEW MEXICO OIL CONSERVATION COMMISSION
WELL LOCATION AND ACREAGE DEDICATION PLAT**

Form C-102
Supersedes C-108
Effective 1-1-65

All distances must be from the outer boundaries of the Section


Operator AMOCO Production Co.			Lease Federal B		Acres 1
Section N	Section 28	Township 17 South	Range 32 East	County Lea	
Field Location of Well:					
480	feet from the South	line and	1980	feet from the West	line
and Level Elev. 3241.4	Producing Formation Morrow		Pool Wildcat Morrow		Estimated Acreage 320

1. Outline the acreage dedicated to the subject well by colored pencil or hatchure marks on the plat below.
2. If more than one lease is dedicated to the well, outline each and identify the ownership thereof (both as to working interest and royalty).
3. If more than one lease of different ownership is dedicated to the well, have the interests of all owners been consolidated by communitization, unitization, force-pooling, etc?

☐ Yes ☐ No If answer is "yes," type of consolidation _____

If answer is "no," list the owners and tract descriptions which have actually been consolidated. (Use reverse side of this form if necessary.) _____

No allowable will be assigned to the well until all interests have been consolidated (by communitization, unitization, forced-pooling, or otherwise) or until a non-standard unit, eliminating such interests, has been approved by the Commission.

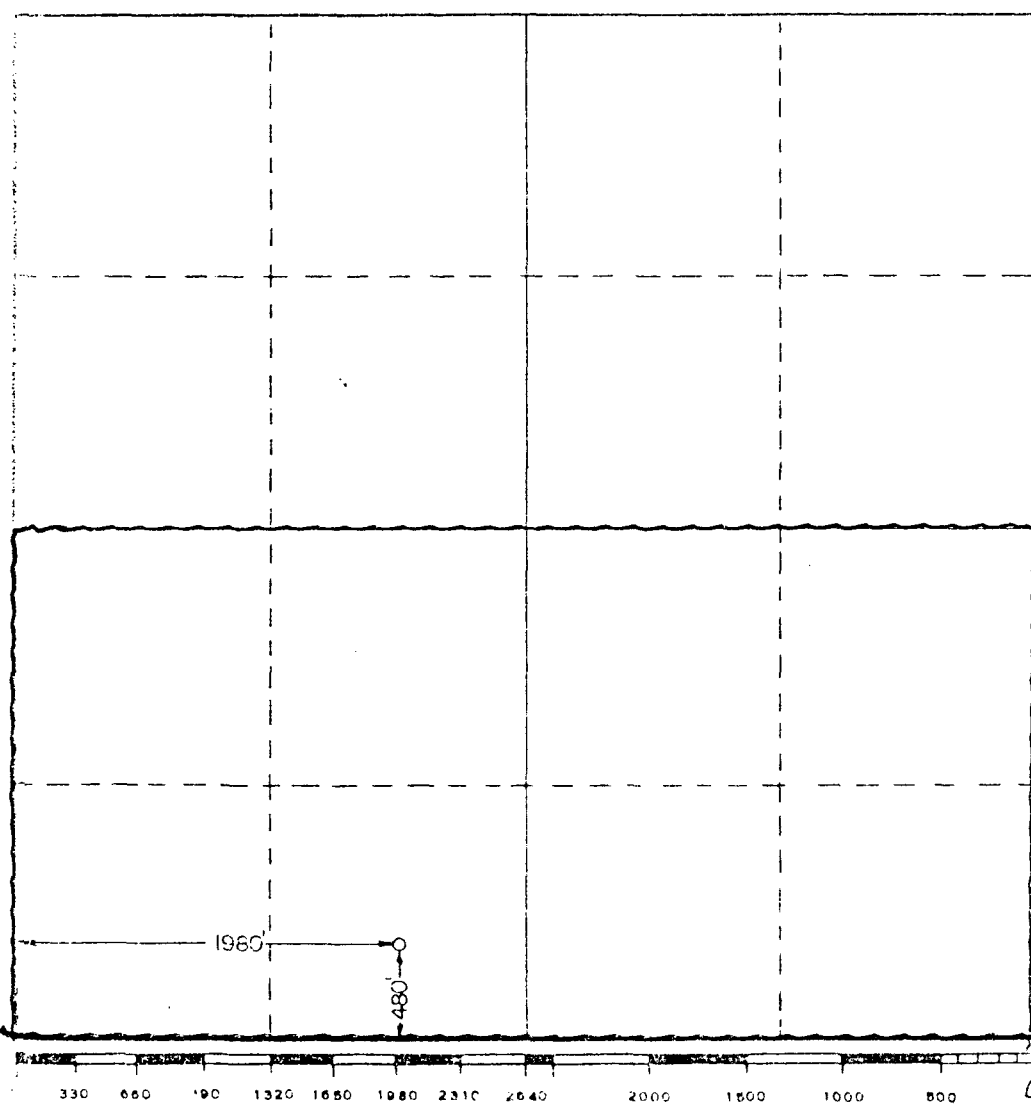

CERTIFICATION

I hereby certify that the information contained herein is true and complete to the best of my knowledge and belief.

Name: **Bob Davis**
 Position: **Admin. Analyst**
 Company: **Amoco Production Company**
 Date: **7-28-80**

I hereby certify that the well location shown on this plat was plotted from field notes of actual surveys made by me or under my supervision, and that the same is true and correct to the best of my knowledge and belief.

Date Surveyed: **July 7, 1980**
 Registered Professional Engineer and/or Land Surveyor

John W. West
 Certificate No. **JOHN W. WEST 878**
PATRICK A. ROMERO 8863
Ronald J. Eidson 3239



Amoco Production Company

ENGINEERING CHART

SHEET NO.

OF

FILE


APPN


DATE

BY

SUBJECT Federal BI Well No. 1 480' FSL & 1980' FWL

Unorthodox Location, SE/4 SW/4, Sec. 28, T-17-S R-32-E

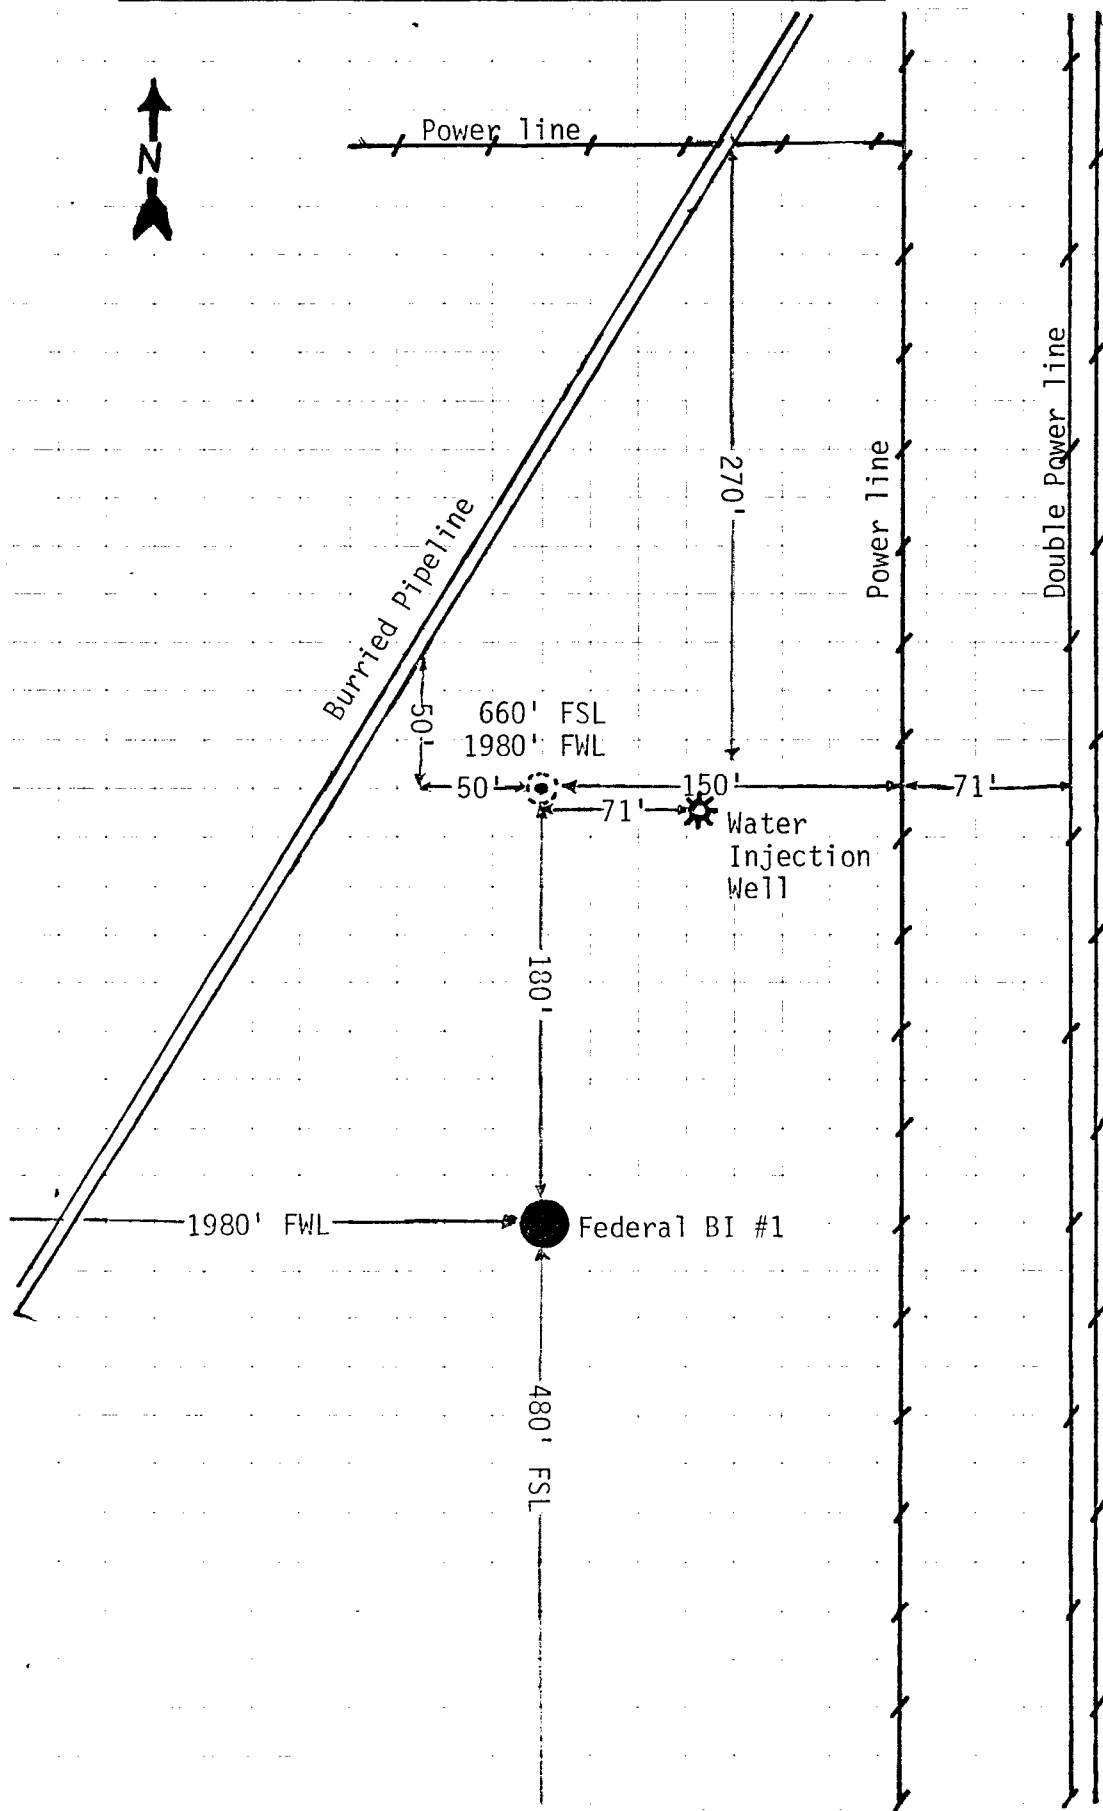

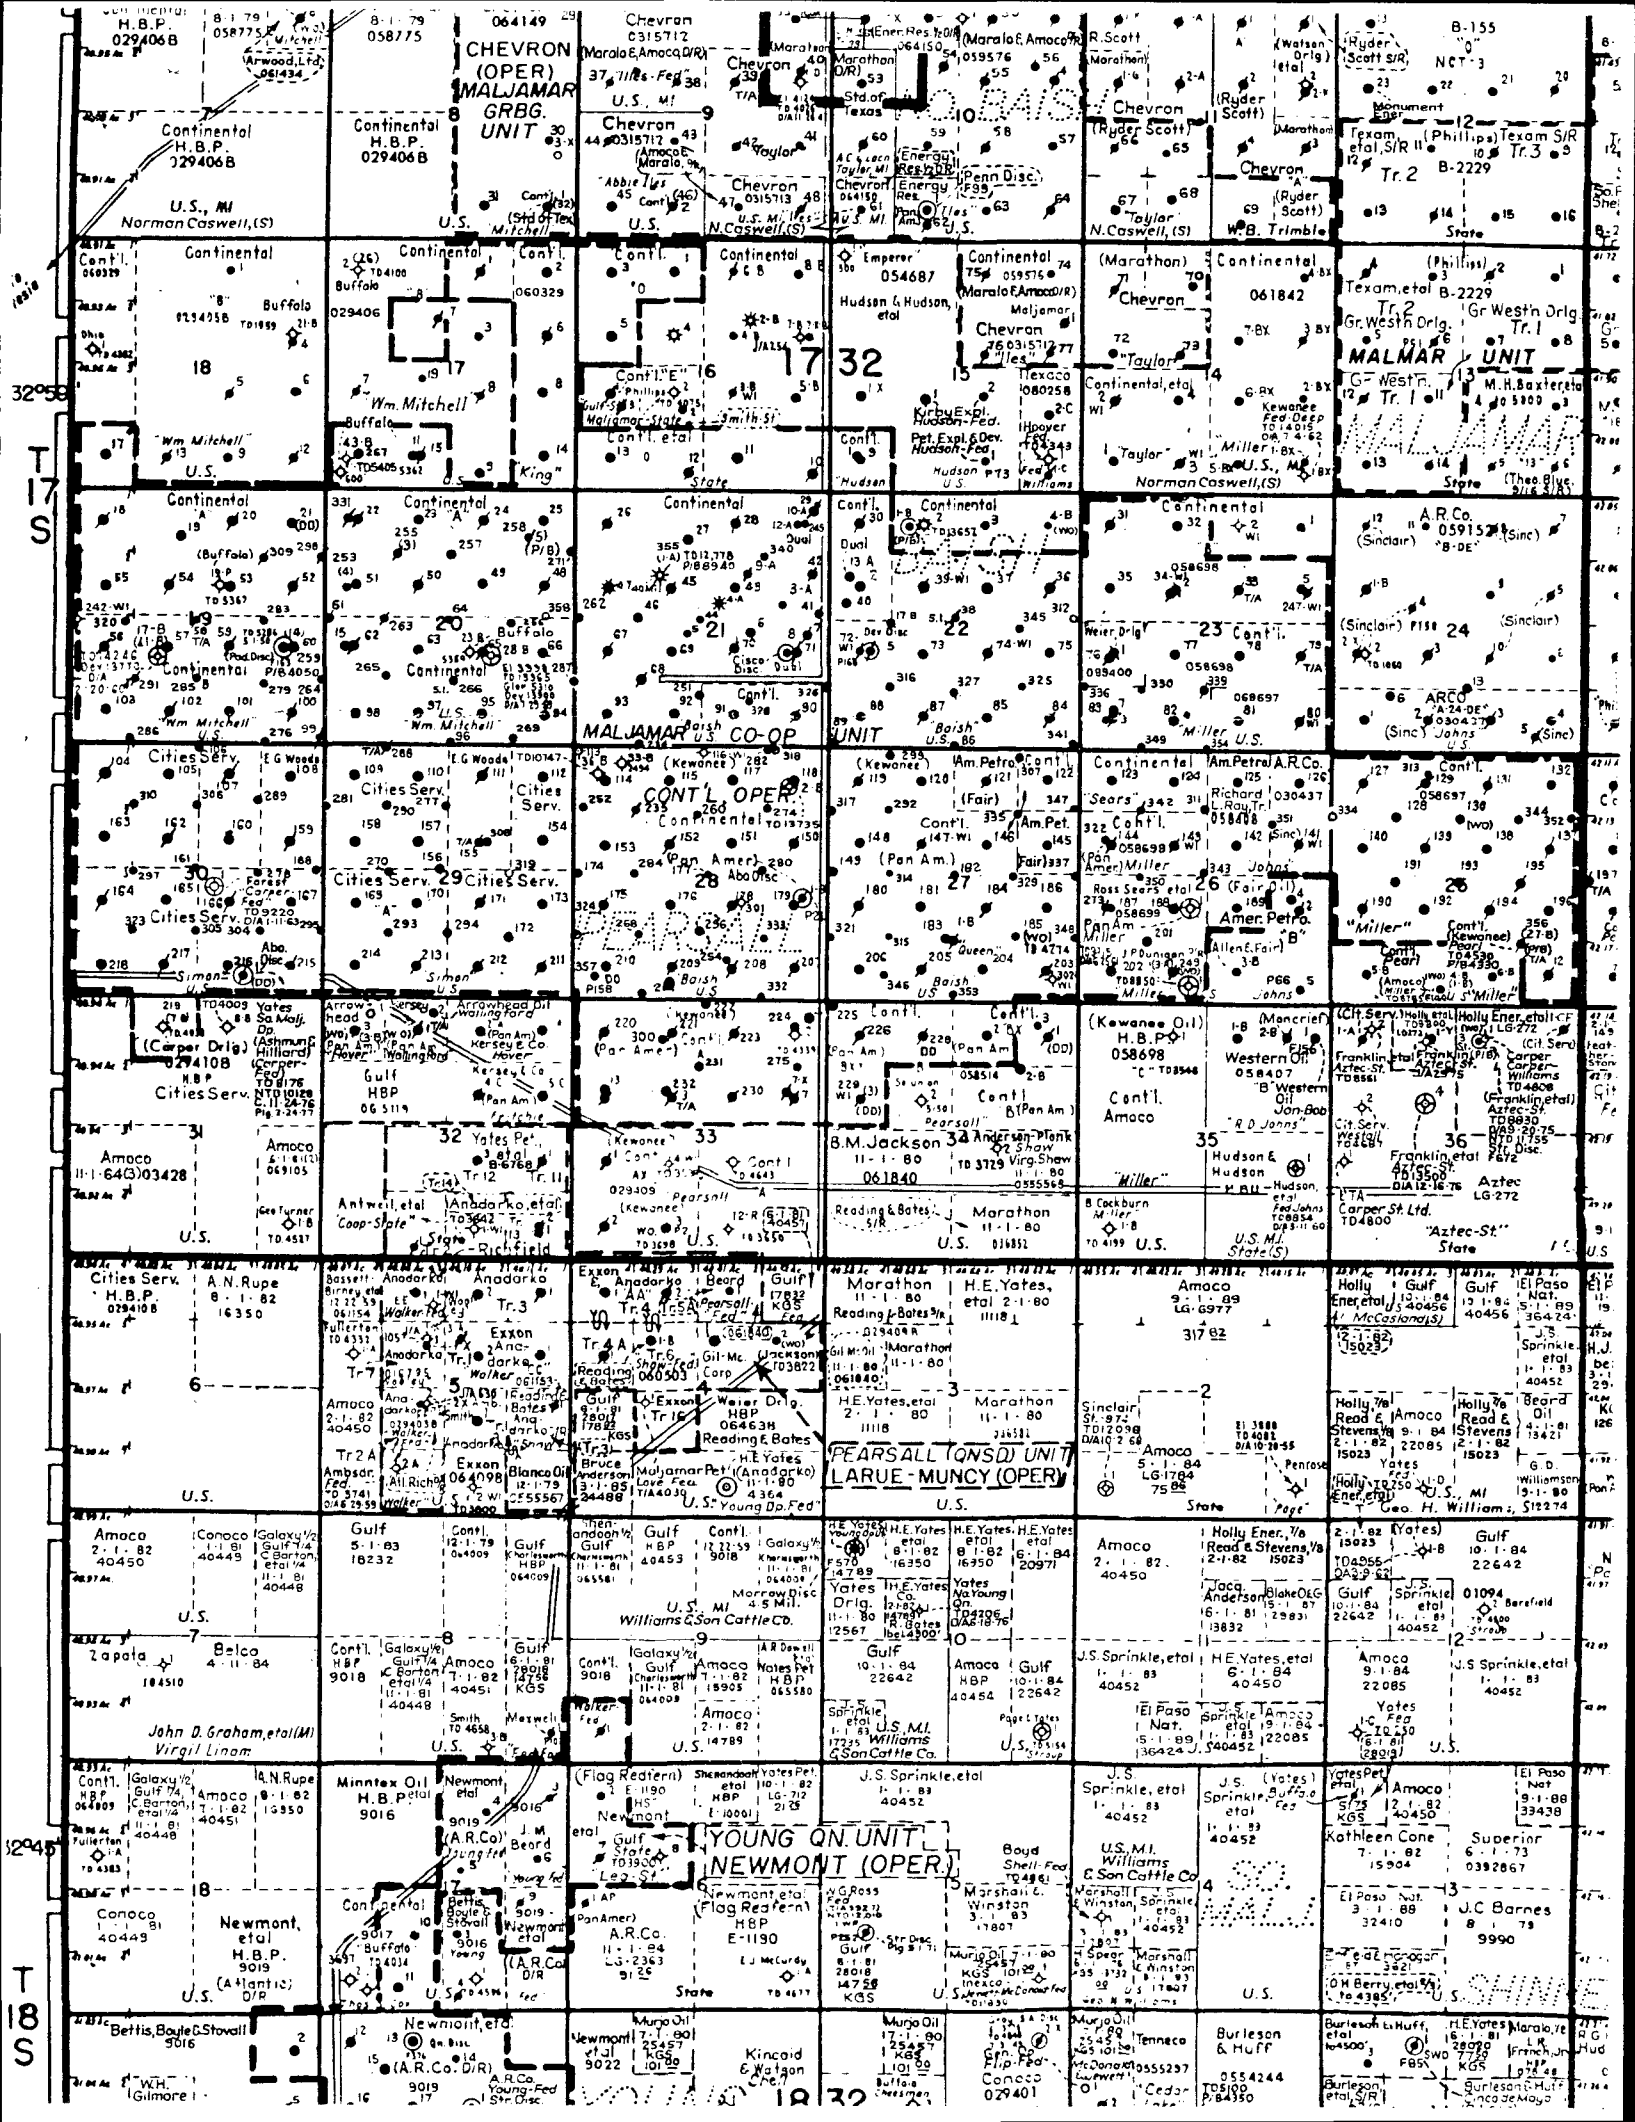

P08 3839596


RECEIPT FOR CERTIFIED MAIL

NO INSURANCE COVERAGE PROVIDED—
NOT FOR INTERNATIONAL MAIL

(See Reverse)

SENT TO		GULF OIL CORPORATION	
STREET AND NO.			
P.O. BOX 670			
P.O. STATE AND ZIP CODE			
HOBBS, NM 88240			
POSTAGE		\$.28	
CERTIFIED FEE		.80	
SPECIAL DELIVERY			
RESTRICTED DELIVERY			
SHOW TO WHOM AND DATE DELIVERED			
SHOW TO WHOM, DATE, AND ADDRESS OF DELIVERY			
SHOW TO WHOM AND DATE DELIVERED WITH RESTRICTED DELIVERY			
SHOW TO WHOM, DATE AND ADDRESS OF DELIVERY WITH RESTRICTED DELIVERY			
RETURN RECEIPT SERVICE		.45	
OPTIONAL SERVICES			
CONSULT POSTMASTER FOR FEES			
TOTAL POSTAGE AND FEES		\$ 1.53	
POSTMARK OR DATE			

PS Form 3800, Apr. 1976

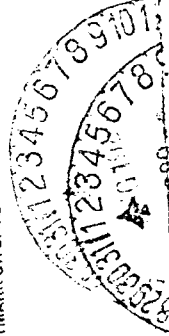

P08 3839595

RECEIPT FOR CERTIFIED MAIL

NO INSURANCE COVERAGE PROVIDED—
NOT FOR INTERNATIONAL MAIL

(See Reverse)

SENT TO		CONOCO, INC.	
STREET AND NO.			
P.O. BOX 460			
P.O. STATE AND ZIP CODE			
HOBBS, NM 88240			
POSTAGE		\$.28	
CERTIFIED FEE		.80	
SPECIAL DELIVERY			
RESTRICTED DELIVERY			
SHOW TO WHOM AND DATE DELIVERED			
SHOW TO WHOM, DATE, AND ADDRESS OF DELIVERY			
SHOW TO WHOM AND DATE DELIVERED WITH RESTRICTED DELIVERY			
SHOW TO WHOM, DATE AND ADDRESS OF DELIVERY WITH RESTRICTED DELIVERY			
RETURN RECEIPT SERVICE		.45	
OPTIONAL SERVICES			
CONSULT POSTMASTER FOR FEES			
TOTAL POSTAGE AND FEES		\$ 1.53	
POSTMARK OR DATE			

PS Form 3800, Apr. 1976



P08 3839597


RECEIPT FOR CERTIFIED MAIL

NO INSURANCE COVERAGE PROVIDED—
NOT FOR INTERNATIONAL MAIL

(See Reverse)

SENT TO		CITIES SERVICE COMPANY	
STREET AND NO.			
P.O. BOX 1919			
P.O. STATE AND ZIP CODE			
MIDLAND, TEXAS 79702			
POSTAGE		\$.28	
CERTIFIED FEE		.80	
SPECIAL DELIVERY			
RESTRICTED DELIVERY			
SHOW TO WHOM AND DATE DELIVERED			
SHOW TO WHOM, DATE, AND ADDRESS OF DELIVERY			
SHOW TO WHOM AND DATE DELIVERED WITH RESTRICTED DELIVERY			
SHOW TO WHOM, DATE AND ADDRESS OF DELIVERY WITH RESTRICTED DELIVERY			
RETURN RECEIPT SERVICE		.45	
OPTIONAL SERVICES			
CONSULT POSTMASTER FOR FEES			
TOTAL POSTAGE AND FEES		\$ 1.53	
POSTMARK OR DATE			

PS Form 3800, Apr. 1976

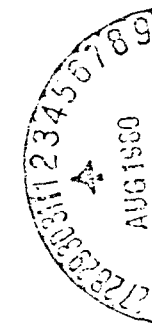



Amoco Production Company


Post Office Box 68
Hobbs, New Mexico 88240

S. J. Okerson
District Superintendent

July 30, 1980

File: SJ0-986.51 X WF-965

Re: Waivers Consent
Unorthodox Location
Federal "BI" Well No. 1
Lea County, New Mexico

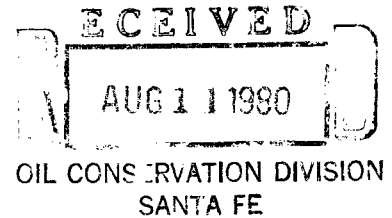

Cities Service Company
P. O. Box 1919
Midland, TX 79702

Gentlemen:

We are requesting your approval, as an offset operator, for the unorthodox location of our Federal "BI" Well No. 1. Subject well is located 480' FSL and 1980' FWL, Section 28, T-17-S, R-32-E, Lea County, New Mexico. The subject well location was moved to an unorthodox location due to a buried pipeline to the northwest and a water injection well to the east of the nearest orthodox location. We request that you approve and return a signed copy of this letter to this office and one to the NMOCD in Santa Fe. Self-addressed envelopes are enclosed.

Yours very truly,

Original Signed by:
S. J. OKERSON

Approved: **CITIES SERVICE COMPANY**
By: [Signature] MANAGER PRODUCTION
SOUTHWEST REGION
Date: 8/8/80

cc: E. D. Newman
Houston, TX

NMOCD
Hobbs, NM



Amoco Production Company
Post Office Box 68
Hobbs, New Mexico 88240

S. J. Okerson
District Superintendent

July 30, 1980

File: SJ0-986.51 X WF-966

Re: Waivers Consent
Unorthodox Location
Federal "BI" Well No. 1
Lea County, New Mexico

Gulf Oil Corporation
P. O. Box 670
Hobbs, NM 88240

Gentlemen:

We are requesting your approval, as an offset operator, for the unorthodox location of our Federal "BI" Well No. 1. Subject well is located 480' FSL and 1980' FWL, Section 28, T-17-S, R-32-E, Lea County, New Mexico. The subject well location was moved to an unorthodox location due to a buried pipeline to the northwest and a water injection well to the east of the nearest orthodox location. We request that you approve and return a signed copy of this letter to this office and one to the NMOCD in Santa Fe. Self-addressed envelopes are enclosed.

Yours very truly,

S. J. Okerson
SJO


Approved: Gulf Oil Corporation

By: *C. F. Kaltefleiter*
C. F. Kaltefleiter, Chief Probation
Engineer

Date: August 21, 1980

cc: E. D. Newman
Houston, TX

NMOCD
Hobbs, NM

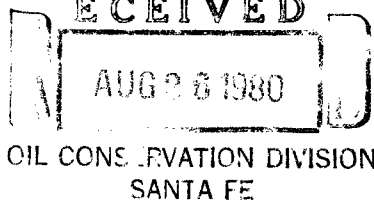

Amoco Production Company

Post Office Box 68
Hobbs, New Mexico 88240

S. J. Okerson
District Superintendent

August 1, 1980

File: SJ0-986.51 x WF-975

Re: Waivers Consent
Unorthodox Location
State "IM" Com Well No. 1
Eddy County, New Mexico

Gulf Oil Corporation
P. O. Box 670
Hobbs, NM 88240

Gentlemen:

We are requesting your approval, as an offset operator, for the unorthodox location of our State "IM" Com Well No. 1. Subject well is located 1880' FSL and 660' FEL, Section 16, T-22-S, R-26-E, Eddy County, New Mexico. The subject well location was moved 100' south to an unorthodox location due to a steep grade, of 45° or more, 50' north of the closest orthodox location. We could not move the location north to an orthodox location due to the severity of the slope. We request that you approve and return a signed copy of this letter to this office and one to the NMOCD in Santa Fe. Self-addressed envelopes are enclosed.

Yours very truly,

cc: E. D. Newman
Houston, TX

NMOCD
Santa Fe, NM

Approved: Gulf Oil Corporation

By:
C.F. Kalfeyer, Chief Proration
Engineer

Date: August 21, 1980