

NOV

VACUUM DRINKARD

APPLICATION FOR AUTHORIZATION TO INJECT

- I. Purpose: ☐ Secondary Recovery ☒ Pressure Maintenance ☐ Disposal ☐ Storage
Application qualifies for administrative approval? ☐ yes ☒ no

II. Operator: TEXACO EXPLORATION AND PRODUCTION INC.

Address: P. O. Box 3109, MIDLAND, TX 79702

Contact party: JAMES A. HEAD Phone: (915) 688-4613

III. Well data: Complete the data required on the reverse side of this form for each well proposed for injection. Additional sheets may be attached if necessary.

- IV. Is this an expansion of an existing project? ☐ yes ☒ no
If yes, give the Division order number authorizing the project _____

V. Attach a map that identifies all wells and leases within two miles of any proposed injection well with a one-half mile radius circle drawn around each proposed injection well. This circle identifies the well's area of review.

- * VI. Attach a tabulation of data on all wells of public record within the area of review which penetrate the proposed injection zone. Such data shall include a description of each well's type, construction, date drilled, location, depth, record of completion, and a schematic of any plugged well illustrating all plugging detail.

VII. Attach data on the proposed operation, including:

1. Proposed average and maximum daily rate and volume of fluids to be injected;
2. Whether the system is open or closed;
3. Proposed average and maximum injection pressure;
4. Sources and an appropriate analysis of injection fluid and compatibility with the receiving formation if other than reinjected produced water; and
5. If injection is for disposal purposes into a zone not productive of oil or gas at or within one mile of the proposed well, attach a chemical analysis of the disposal zone formation water (may be measured or inferred from existing literature, studies, nearby wells, etc.).

- *VIII. Attach appropriate geological data on the injection zone including appropriate lithologic detail, geological name, thickness, and depth. Give the geologic name, and depth to bottom of all underground sources of drinking water (aquifers containing waters with total dissolved solids concentrations of 10,000 mg/l or less) overlying the proposed injection zone as well as any such source known to be immediately underlying the injection interval.

IX. Describe the proposed stimulation program, if any.

- * X. Attach appropriate logging and test data on the well. (If well logs have been filed with the Division they need not be resubmitted.)

- * XI. Attach a chemical analysis of fresh water from two or more fresh water wells (if available and producing) within one mile of any injection or disposal well showing location of wells and dates samples were taken.

XII. Applicants for disposal wells must make an affirmative statement that they have examined available geologic and engineering data and find no evidence of open faults or any other hydrologic connection between the disposal zone and any underground source of drinking water.

XIII. Applicants must complete the "Proof of Notice" section on the reverse side of this form.

XIV. Certification

I hereby certify that the information submitted with this application is true and correct to the best of my knowledge and belief.

Name: JAMES A. HEAD Title: ASSET MANAGER

Signature: James A. Head Date: 11/1/94

- * If the information required under Sections VI, VIII, X, and XI above has been previously submitted, it need not be duplicated and resubmitted. Please show the date and circumstance of the earlier submittal.

III. WELL DATA

A. The following well data must be submitted for each injection well covered by this application. The data must be both in tabular and schematic form and shall include:

- (1) Lease name; Well No.; location by Section, Township, and Range; and footage location within the section.
- (2) Each casing string used with its size, setting depth, sacks of cement used, hole size, top of cement, and how such top was determined.
- (3) A description of the tubing to be used including its size, lining material, and setting depth.
- (4) The name, model, and setting depth of the packer used or a description of any other seal system or assembly used.

Division District offices have supplies of Well Data Sheets which may be used or which may be used as models for this purpose. Applicants for several identical wells may submit a "typical data sheet" rather than submitting the data for each well.

B. The following must be submitted for each injection well covered by this application. All items must be addressed for the initial well. Responses for additional wells need be shown only when different. Information shown on schematics need not be repeated.

- (1) The name of the injection formation and, if applicable, the field or pool name.
- (2) The injection interval and whether it is perforated or open-hole.
- (3) State if the well was drilled for injection or, if not, the original purpose of the well.
- (4) Give the depths of any other perforated intervals and detail on the sacks of cement or bridge plugs used to seal off such perforations.
- (5) Give the depth to and name of the next higher and next lower oil or gas zone in the area of the well, if any.

XIV. PROOF OF NOTICE

All applicants must furnish proof that a copy of the application has been furnished, by certified or registered mail, to the owner of the surface of the land on which the well is to be located and to each leasehold operator within one-half mile of the well location.

Where an application is subject to administrative approval, a proof of publication must be submitted. Such proof shall consist of a copy of the legal advertisement which was published in the county in which the well is located. The contents of such advertisement must include:

- (1) The name, address, phone number, and contact party for the applicant;
- (2) the intended purpose of the injection well; with the exact location of single wells or the section, township, and range location of multiple wells;
- (3) the formation name and depth with expected maximum injection rates and pressures; and
- (4) a notation that interested parties must file objections or requests for hearing with the Oil Conservation Division, P. O. Box 2088, Santa Fe, New Mexico 87501 within 15 days.

NO ACTION WILL BE TAKEN ON THE APPLICATION UNTIL PROPER PROOF OF NOTICE HAS BEEN SUBMITTED.

NOTICE: Surface owners or offset operators must file any objections or requests for hearing of administrative applications within 15 days from the date this application was mailed to them.

**VACUUM DRINKARD FIELD
PRESSURE MAINTENANCE PROJECT
APPLICATION FOR AUTHORIZATION TO INJECT WATER**

ATTACHMENT III TO FORM C-108

Attached is a description of the eight wells proposed for injection for this project. Six wells are to be drilled for injection while two are existing producers to be converted. Also attached are the completion records of the two wells to be converted as well as their wellbore schematics. For the new wells a typical wellbore schematic is included.

ATTACHMENT V TO FORM C-108

Attached are two maps of the project area. The first shows all wells drilled in the project area within two miles of the proposed injectors which are shown in yellow triangles. The second map shows all wells drilled through to the injection interval. The red circles are one-half mile radius around each proposed injector to identify the area of review.

ATTACHMENT VI TO FORM C-108

Attached is a listing of all wells that have penetrated the injection interval in the area of review of the proposed injectors. Also included are wellbore schematics of the wells.

**ATTACHMENT VII TO FORM C-108
DATA ON PROPOSED OPERATION**

Proposed average and maximum daily rate for the project:

Average Daily Rate:	5000 BWPD (625 BWPD/well)
Maximum Daily Rate:	8000 BWPD (1000 BWPD/well)

The injection system is closed.

The proposed average and maximum* surface injection pressures are:

Average injection pressure	1400 PSIG
Maximum injection pressure	1500 PSIG

* Until a fracture gradient is determined, maximum injection pressure will be based on a 0.2 psi/ft gradient.

The source of injection water will be produced water from the Glorieta and Grayburg-San Andres Formations. This will be supplied from the Vacuum Glorieta West Unit and the Vacuum Grayburg San Andres Unit waterfloods. As shown on the attached water analysis of Drinkard produced water and the above mentioned sources, the waters are compatible.

ATTACHMENT VIII TO FORM C-108

FORMATION DESCRIPTION

The Drinkard formation is a microcrystalline dolomite deposited in a patch reef environment. The structure is a southeasterly dipping stratigraphic trap with permeability pinchouts in all directions.

The Drinkard is in the Paleozoic era, Permian System, Leonard Age and Yeso group.

The top of the Drinkard is found at approximately 7450' to 7600' and is approximately 500 feet thick.

No known faults cut through the Drinkard that may act as conduits for gas, oil, or injection fluids to seep into fresh water aquifers above the injection zone within the proposed injection project. There are water injection projects above the Drinkard in the Paddock (Vacuum Glorieta West Unit) and the Grayburg-San Andres (Vacuum Grayburg-San Andres Unit and Central Vacuum Unit). The productive formation below the Drinkard is the Abo Reef. No contamination of the Ogallala through faults cutting these shallower zones has been observed.

Listed below are the formations and depths of oil productive zones in this area.

Grayburg-San Andres	4300'
Glorieta-Paddock	5900'
Blinbery	6500'
Drinkard	7450'
Abo	8300'
Wolfcamp	9400'
Penn Reef	10000'
Devonian	12000'

ATTACHMENT IX TO FORM C-108

PROPOSED STIMULATION PLAN FOR A TYPICAL INJECTION WELL

All injection wells will be cased hole completions selectively perforated. The stimulation program initially will be medium sized acid jobs using 15% HCL. As the project matures restimulation with larger acid treatments may be required.

ATTACHMENT X TO FORM C-108

WELL LOGS

As the new wells are drilled, logs will be filed with the Division.

Logs on New Mexico "O" NCT-1 No. 36 and New Mexico "R" NCT-3 No. 26 have previously been sent to the Division.

ATTACHMENT XI TO FORM C-108

CHEMICAL ANALYSIS OF FRESH WATER WITHIN ONE MILE OF INJECTION WELLS

The attached map shows the location of two fresh water wells in the vicinity of the proposed pressure maintenance project which have chemical analysis. Attached are the attendant water analyses.

ATTACHMENT XII TO FORM C-108

Texaco has examined available geological and engineering data and finds no evidence of open faults or any other hydrologic connection between the injection zone and any underground source of drinking water.

ATTACHMENT XIII TO FORM C-108

NOTIFICATION OF SURFACE OWNERS AND OPERATORS

Texaco has notified by certified letter the surface owner and offset operators of the intent to inject as well as the drilling of nonstandard locations.

See the attached list of Offset Operators and surface owner.

Attached is a copy of the legal notice and affidavit of publication in the Hobbs Daily News-Sun.

VACUUM DRINKARD
PRESSURE MAINTENANCE PROJECT
ATTACHMENT III TO FORM C-108
APPLICATION FOR AUTHORIZATION TO INJECT
PROPOSED INJECTION WELLS

<u>OPERATOR</u>	<u>LEASE</u>	<u>WELL NO.</u>	<u>API NUMBER</u>	<u>UNIT</u>	<u>SEC</u>	<u>TWN</u>	<u>RANGE</u>	<u>FOOTAGE</u>	<u>LOCATION</u>	<u>STATUS</u>
TEXACO E&P INC.	N. M. "R" ST. NCT-3	28	N/A	P	1	18S	34E	1310 FSL	110 FEL	NEW LOCATION
TEXACO E&P INC.	N. M. "R" ST. NCT-1	17	N/A	G	6	18S	35E	2530 FNL	2530 FEL	NEW LOCATION
TEXACO E&P INC.	N. M. "R" ST. NCT-1	16	N/A	G	6	18S	35E	1410 FNL	2630 FEL	NEW LOCATION
TEXACO E&P INC.	N. M. "L" ST.	17	N/A	H	1	18S	34E	2560 FNL	10 FEL	NEW LOCATION
TEXACO E&P INC.	N. M. "L" ST.	16	N/A	A	1	18S	34E	1310 FNL	10 FEL	NEW LOCATION
MARATHON OIL	WARN ST. A/C 2	25	N/A	C	6	18S	35E	113 FNL	1429 FWL	NEW LOCATION
TEXACO E&P INC.	N. M. "R" ST. NCT-3	26	3002531993	J	1	18S	34E	1980 FSL	1755 FEL	PRODUCING
TEXACO E&P INC.	N. M. "O" ST. NCT-1	36	3002532339	N	36	17S	34E	330 FSL	2210 FWL	PRODUCING

C108 ATTACHMENT III
WELLS TO BE CONVERTED TO WATER INJECTION

OPERATOR	WELL NAME API NO.	LOCATION	COMPLETION DATE	TD	PBTD	CASING SIZE	CASING DEPTH	CEMENT SACKS	TOP	METHOD	PRODUCING INTERVAL	STIMULATION	CURRENT STATUS	REMARKS
Texasco E&P Inc.	N. M. "R" ST. NCT-3 No. 28 3002531983	19807 FS / 1755' FE SEC 1, T18S R34E (J)	8/13/93	8000	7950	8-5/8 5-1/2	1470 8000	650 1750	0 0	CIRC CIRC	7585-7829	FRAC40000	PROD	Dryland
Texasco E&P Inc.	N. M. "O" ST. NCT-1 No. 38 3002532339	330 FSL 2210 FWL SEC 38 T17S R34E (N)	3/20/94	8100	8100	8-5/8 5-1/2	1470 8100	650 1376	1000 0	TS CIRC	7498-7762'	A25000	PROD	Dryland

Submit to Appropriate
District Office
State Lease - 6 copies
Fee Lease - 5 copies
DISTRICT I
P.O. Box 1980, Hobbs, NM 88240

DISTRICT II
P.O. Drawer DD, Artesia, NM 88210

DISTRICT III
1000 Rio Brazos Rd., Aztec, NM 87410

State of New Mexico
Energy, Minerals and Natural Resources Department

Form C-105
Revised 1-1-89

OIL CONSERVATION DIVISION

P.O. Box 2088
Santa Fe, New Mexico 87504-2088

WELL API NO.

30-025-31993

5. Indicate Type of Lease

STATE ☒

FEE ☐

6. State Oil & Gas Lease No.

B-1306

7. Lease Name or Unit Agreement Name

NEW MEXICO 'R' STATE NCT-3

8. Well No.

26

9. Pool name or Wildcat

VACUUM DRINKARD

WELL COMPLETION OR RECOMPLETION REPORT AND LOG

1a. Type of Well:

OIL WELL ☒ GAS WELL ☐ DRY ☐ OTHER ☐

b. Type of Completion:

NEW WELL ☒ WORK OVER ☐ DEEPEN ☐ PLUG BACK ☐ DEEP RESER. ☐ OTHER ☐

2. Name of Operator

TEXACO EXPLORATION AND PRODUCTION INC.

3. Address of Operator

P. O. Box 3109, Midland, Texas 79702

4. Well Location

Unit Letter J: 1980 Feet From The SOUTH Line and 1755 Feet From The EAST Line

Section 1

Township 18-SOUTH

Range 34-EAST

NMPM LEA

County

10. Date Spudded

06-11-93

11. Date T.D. Reached

07-03-93

12. Date Compl. (Ready to Prod.)

09-07-93

13. Elevations (DF & RKB, RT, GR, etc.)

GR-3987', KB-4001'

14. Elev. Casinghead

3987'

15. Total Depth

8000'

16. Plug Back T.D.

7950'

17. If Multiple Compl. How Many Zones?

18. Intervals Drilled By

Rotary Tools
0 - 8000'

Cable Tools

19. Producing Interval(s), of this completion - Top, Bottom, Name

7585' - 7829'; DRINKARD

20. Was Directional Survey Made

YES

21. Type Electric and Other Logs Run

GR-DLL-MSFL-LSS, GR-CNL-LDT, GR-FMI

22. Was Well Cored

YES

23.

CASING RECORD (Report all strings set in well)

CASING SIZE	WEIGHT LB/FT.	DEPTH SET	HOLE SIZE	CEMENTING RECORD	AMOUNT PULLED
8 5/8	24#	1470'	11	CL-C 650 SX CIRC. 148 SX	
5 1/2	15.5# & 17#	8000'	7 7/8	CL-H 1750 SX, CIRC. 127 SX	
				DV @ 5003'	

24.

LINER RECORD

SIZE	TOP	BOTTOM	SACKS CEMENT	SCREEN	SIZE	DEPTH SET	PACKER SET
					2 7/8	7852'	

26. Perforation record (interval, size, and number)

7585' - 7829'; 2 JSPF, 284 HOLES.

27. ACID, SHOT, FRACTURE, CEMENT, SQUEEZE, ETC.

DEPTH INTERVAL	AMOUNT AND KIND MATERIAL USED
7585' - 7829'	ACID: 25000 GAL 20% HCL
	ACID/FRACT'D: 40000 GAL 65 QUALITY
	CO2 FOAMED 20% HCL

28.

PRODUCTION

Date First Production 07-16-93		Production Method (Flowing, gas lift, pumping - Size and type pump) PUMPING - 2.5 X 1.5 X 24				Well Status (Prod. or Shut-in) PRODUCING	
Date of Test 09-13-93	Hours Tested 24	Choke Size	Prod'n For Test Period	Oil - Bbl. 79	Gas - MCF 129	Water - Bbl. 17	Gas - Oil Ratio 1633
Flow Tubing Press.	Casing Pressure	Calculated 24-Hour Rate	Oil - Bbl.	Gas - MCF	Water - Bbl.	Oil Gravity - API - (Corr.) 40.80	

29. Disposition of Gas (Sold, used for fuel, vented, etc.)

SOLD

Test Witnessed By

EDDIE WELBORN

30. List Attachments

DEVIATION SURVEY

31. I hereby certify that the information shown on both sides of this form is true and complete to the best of my knowledge and belief

Signature

C.P. Basham / SDH

Printed

Name C.P. BASHAM

Title DRLG. SUPT.

Date 09-16-93

This form is to be filed with the appropriate District Office of the Division not later than 20 days after the completion of any newly-drilled or deepened well. It shall be accompanied by one copy of all electrical and radio-activity logs run on the well and a summary of all special tests conducted, including drill stem tests. All depths reported shall be measured depths. In the case of directionally drilled wells, true vertical depths shall also be reported. For multiple completions, Items 25 through 29 shall be reported for each zone. The form is to be filed in quintuplicate except on state land, where six copies are required. See Rule 1105.

INDICATE FORMATION TOPS IN CONFORMANCE WITH GEOGRAPHICAL SECTION OF STATE

Southeastern New Mexico

T. Anhy	1484'	T. Canyon
T. Salt		T. Strawn
B. Salt		T. Atoka
T. Yates		T. Miss
T. 7 Rivers		T. Devonian
T. Queen	3847'	T. Silurian
T. Grayburg		T. Montoya
T. San Andres	4255'	T. Simpson
T. Glorieta	5773'	T. McKee
T. Paddock	5879'	T. Ellenburger
T. Blinberry	6156'	T. Gr. Wash
T. Tubb		T. Delaware Sand
T. Drinkard	7547'	T. Bone Springs
T. Abo		T.
T. Wolfcamp		T.
T. Penn		T.
T. Cisco (Bough C)		T.

Northwestern New Mexico

T. Ojo Alamo _____	T. Penn. "B" _____
T. Kirtland-Fruitland _____	T. Penn. "C" _____
T. Pictured Cliffs _____	T. Penn. "D" _____
T. Cliff House _____	T. Leadville _____
T. Menefee _____	T. Madison _____
T. Point Lookout _____	T. Elbert _____
T. Mancos _____	T. McCracken _____
T. Gallup _____	T. Ignacio Otzte _____
Base Greenhorn _____	T. Granite _____
T. Dakota _____	T. _____
T. Morrison _____	T. _____
T. Todilto _____	T. _____
T. Entrada _____	T. _____
T. Wingate _____	T. _____
T. Chinle _____	T. _____
T. Permian _____	T. _____
T. Penn. "A" _____	T. _____

OIL OR GAS SANDS OR ZONES

No. 1, from 7585' to 7829' No. 3, from to
No. 2, from to No. 4, from to

IMPORTANT WATER SANDS

Include data on rate of water inflow and elevation to which water rose in hole.

No. 1, from.....to.....feet.....
 No. 2, from.....to.....feet.....
 No. 3, from.....to.....feet.....

LITHOLOGY RECORD (Attach additional sheet if necessary)

From	To	Thickness in Feet	Lithology
7547'	8000'	453'	DOLOMITE W/ TRACE OF ANHYDRITE

RECEIVED

SEP 17 1993

OCD HUBBS
OFFICE

RECEIVED

SEP 17 1998

OCD HUBBS
OFFICE

Submit to Appropriate
District Office
State Lease - 6 copies
Fee Lease - 5 copies
DISTRICT I

P.O. Box 1980, Hobbs, NM 88240

DISTRICT II

P.O. Drawer DD, Artesia, NM 88210

DISTRICT III

1000 Rio Brazos Rd., Aztec, NM 87410

State of New Mexico
Energy, Minerals and Natural Resources Department

Form C-105
Revised 1-1-89

OIL CONSERVATION DIVISION

P.O. Box 2088
Santa Fe, New Mexico 87504-2088

WELL API NO. 30-025-32339
5. Indicate Type of Lease STATE ☒ FEE ☐
6. State Oil & Gas Lease No. 548570

WELL COMPLETION OR RECOMPLETION REPORT AND LOG

1a. Type of Well: OIL WELL ☒ GAS WELL ☐ DRY ☐ OTHER ☐	7. Lease Name or Unit Agreement Name NEW MEXICO 'O' STATE NCT-1
b. Type of Completion: NEW WELL ☒ WORK OVER ☐ DUMPEN ☐ PLUG BACK ☐ DEEP RESVR ☐ OTHER ☐	
2. Name of Operator TEXACO EXPLORATION AND PRODUCTION INC.	8. Well No. 36
3. Address of Operator P. O. Box 3109, Midland, Texas 79702	9. Pool name or Wildcat VACUUM DRINKARD

4. Well Location Unit Letter <u>N</u> : <u>330</u> Feet From The <u>SOUTH</u> Line and <u>2210</u> Feet From The <u>WEST</u> Line Section <u>36</u> Township <u>17-SOUTH</u> Range <u>34-EAST</u> NMPM LEA County

10. Date Spudded 02-09-94	11. Date T.D. Reached 02-26-94	12. Date Compl. (Ready to Prod.) 03-11-94	13. Elevations (DF & RKB, RT, GR, etc.) GR-3995', KB-4009'	14. Elev. Casinghead 3995'
15. Total Depth 8100'	16. Plug Back T.D. 8050'	17. If Multiple Compl. How Many Zones?	18. Intervals Drilled By Rotary Tools 0 - 8100'	Cable Tools
19. Producing Interval(s), of this completion - Top, Bottom, Name 7498' - 7762'; DRINKARD				20. Was Directional Survey Made YES
21. Type Electric and Other Logs Run GR-DLL-MSFL, GR-SDL-DSN-CSNG, GR-CCL				22. Was Well Cored NO

23. CASING RECORD (Report all strings set in well)					
CASING SIZE	WEIGHT LB/FT.	DEPTH SET	HOLE SIZE	CEMENTING RECORD	AMOUNT PULLED
8 5/8	24#	1470'	11	CL-C 650 SX, CIRC. 145 SX	
5 1/2	15.5# & 17#	8100'	7 7/8	CL-H 1375 SX, CIRC. 92 SX,	
				TOC BY T.S @ 1000',	
				DV TOOL @ 5013'.	

24. LINER RECORD					25. TUBING RECORD		
SIZE	TOP	BOTTOM	SACKS CEMENT	SCREEN	SIZE	DEPTH SET	PACKER SET
					2 7/8	7779'	

26. Perforation record (interval, size, and number) 7498' - 7762'; 2 JSPF, 200 HOLES.	27. ACID, SHOT, FRACTURE, CEMENT, SQUEEZE, ETC.	
	DEPTH INTERVAL	AMOUNT AND KIND MATERIAL USED
	7198' - 7762'	ACID 25000 GAL 15% HCL

28. PRODUCTION							
Date First Production 03-06-94		Production Method (Flowing, gas lift, pumping - Size and type pump) PUMPING				Well Status (Prod. or Shut-in) PRODUCING	
Date of Test 03-20-94	Hours Tested 24	Choke Size	Prod'n For Test Period	Oil - Bbl. 64	Gas - MCF 54	Water - Bbl. 2	Gas - Oil Ratio 844
Flow Tubing Press.	Casing Pressure	Calculated 24-Hour Rate	Oil - Bbl.	Gas - MCF	Water - Bbl.	Oil Gravity - API - (Corr.) 39.40	

29. Disposition of Gas (Sold, used for fuel, vented, etc.) SOLD	Test Witnessed By GLEN BOLAND
--	----------------------------------

30. List Attachments
DEVIATION SURVEY

31. I hereby certify that the information shown on both sides of this form is true and complete to the best of my knowledge and belief

Signature <u>C.P. Basham / SDH</u>	Printed Name <u>C.P. BASHAM</u>	Title <u>DRLG. SUPT.</u>	Date <u>03-22-94</u>
------------------------------------	---------------------------------	--------------------------	----------------------

INSTRUCTIONS

This form is to be filed with the appropriate District Office of the Division not later than 20 days after the completion of any newly-drilled or deepened well. It shall be accompanied by one copy of all electrical and radio-activity logs run on the well and a summary of all special tests conducted, including drill stem tests. All depths reported shall be measured depths. In the case of directionally drilled wells, true vertical depths shall also be reported. For multiple completions, Items 25 through 29 shall be reported for each zone. The form is to be filed in quintuplicate except on state land, where six copies are required. See Rule 1105.

INDICATE FORMATION TOPS IN CONFORMANCE WITH GEOGRAPHICAL SECTION OF STATE

Southeastern New Mexico

Northwestern New Mexico

T. Anhy	1466'	T. Canyon	T. Ojo Alamo	T. Penn. "B"
T. Salt		T. Strawn	T. Kirtland-Fruitland	T. Penn. "C"
B. Salt		T. Atoka	T. Pictured Cliffs	T. Penn. "D"
T. Yates		T. Miss	T. Cliff House	T. Leadville
T. 7 Rivers		T. Devonian	T. Menefee	T. Madison
T. Queen	3660'	T. Silurian	T. Point Lookout	T. Elbert
T. Grayburg		T. Montoya	T. Mancos	T. McCracken
T. San Andres	4245'	T. Simpson	T. Gallup	T. Ignacio Otzte
T. Glorieta	5837'	T. McKee	Base Greenhorn	T. Granite
T. Paddock	5910'	T. Ellenburger	T. Dakota	T.
T. Blinberry	6325'	T. Gr. Wash	T. Morrison	T.
T. Tubb	7328'	T. Delaware Sand	T. Todilto	T.
T. Drinkard	7495'	T. Bone Springs	T. Entrada	T.
T. Abo	7903'	T.	T. Wingate	T.
T. Wolfcamp		T.	T. Chinle	T.
T. Penn		T.	T. Permian	T.
T. Cisco (Bough C)		T.	T. Penn "A"	T.

OIL OR GAS SANDS OR ZONES

No. 1, from 7498' to 7762' No. 3, from to
No. 2, from to No. 4, from to

IMPORTANT WATER SANDS

Include data on rate of water inflow and elevation to which water rose in hole.

No. 1, from.....to.....feet.....
 No. 2, from.....to.....feet.....
 No. 3, from.....to.....feet.....

LITHOLOGY RECORD (Attach additional sheet if necessary)

[illegible]

RECEIVED


MAR 28 1994

OCD HUBBS
OFFICE

PRODUCING
DRINKARD

TEXACO EXPL & PROD
NEW MEXICO "O" ST. NO. 36
API# 3002532339

PROPOSED INJECTION WELL

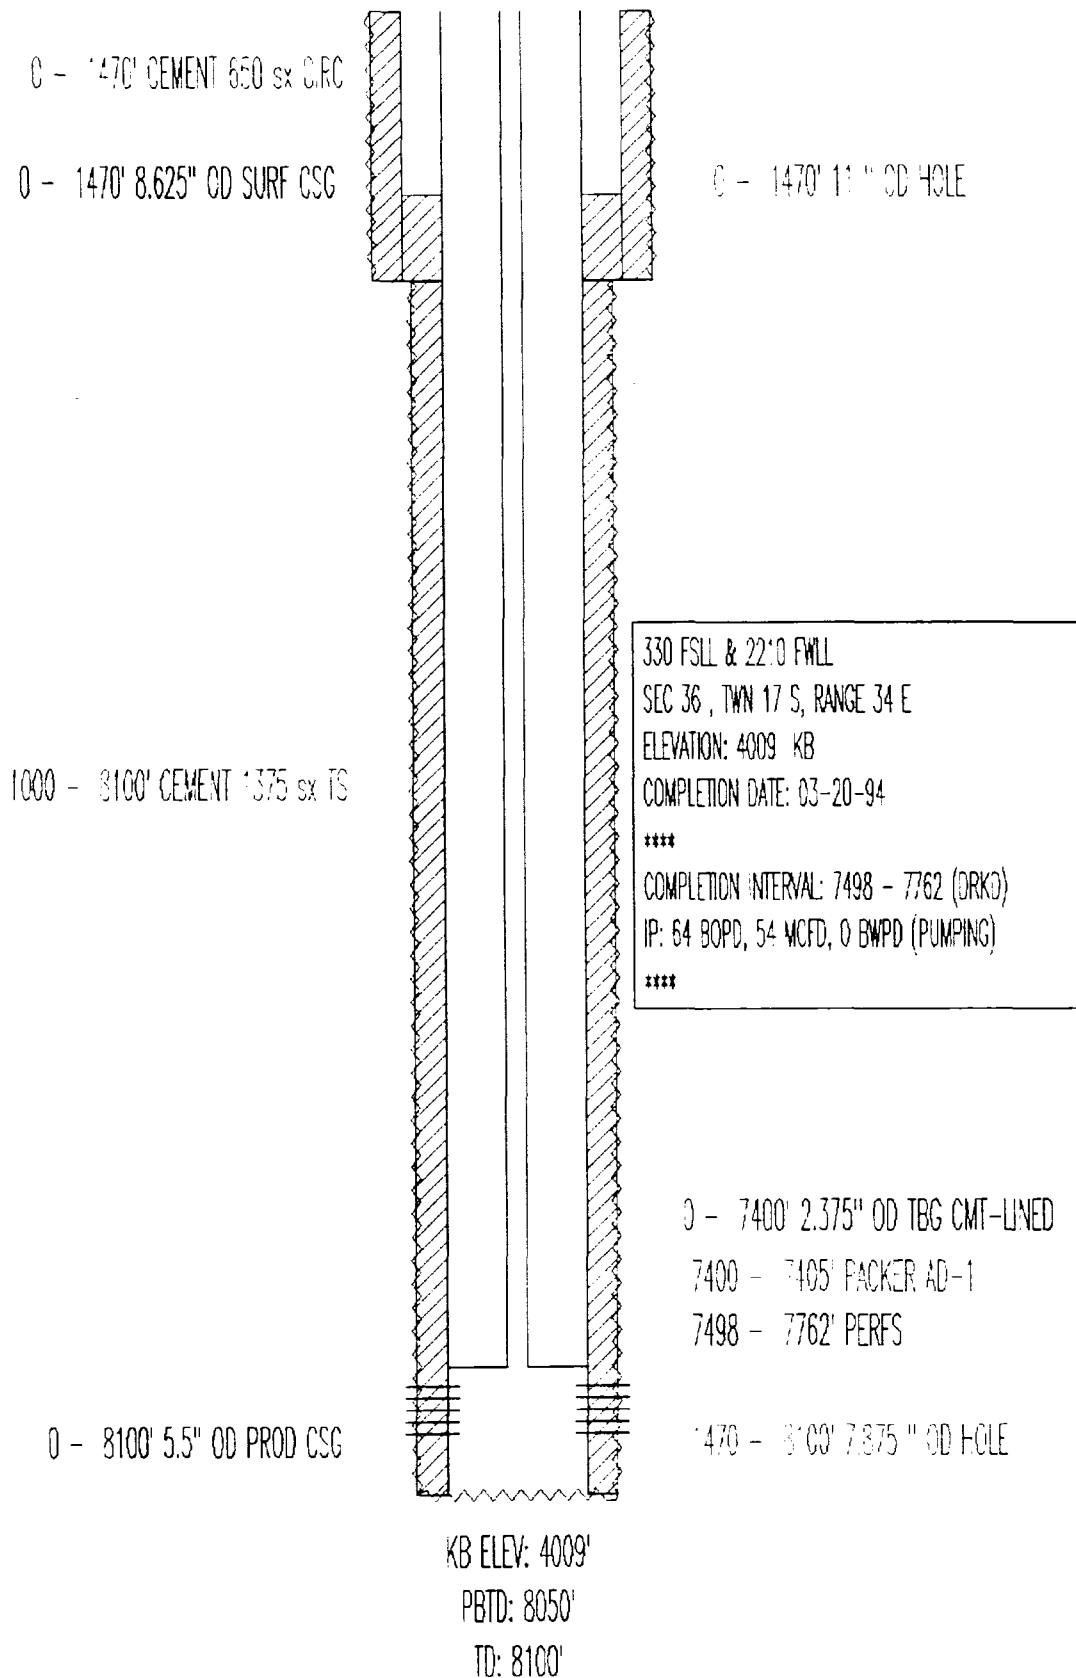

PRODUCING
DRINKARD

TEXACO EXPL & PROD
NEW MEXICO "R" ST. NCT-3 NO. 26
API# 3002531993

PROPOSED INJECTION WELL

0 - 1470' CEMENT 650 sx CRC

0 - 1470' 8 5/8" OD SURF CSC

0 - 1470' 11" OD HOLE

0 - 3000' CEMENT 1750 sx CRC

0 - 7500' 2.375" OD TBG CMT LINED

1980 FSL & 1755 FEL
SEC 1, TWN 18 S, RANGE 34 E
ELEVATION: 4001 KB
COMPLETION DATE: 09-13-93

COMPLETION INTERVAL: 7585 - 7829 (DRKD)
IP: 79 BOPD, 129 MCFD, 17 BHPD (PUMPING)

0 - 8000' 5 1/2" OD PROD CSC

7495 - 7500' PACKER AD-1

7585 - 7829' PERFS DRINKARD


1470 - 3000' 7.375" OD HOLE


KB ELEV: 4001'

PBTD: 7950'

TD: 8000'

TYPICAL VACUUM DRINKARD NEW INJECTION WELL

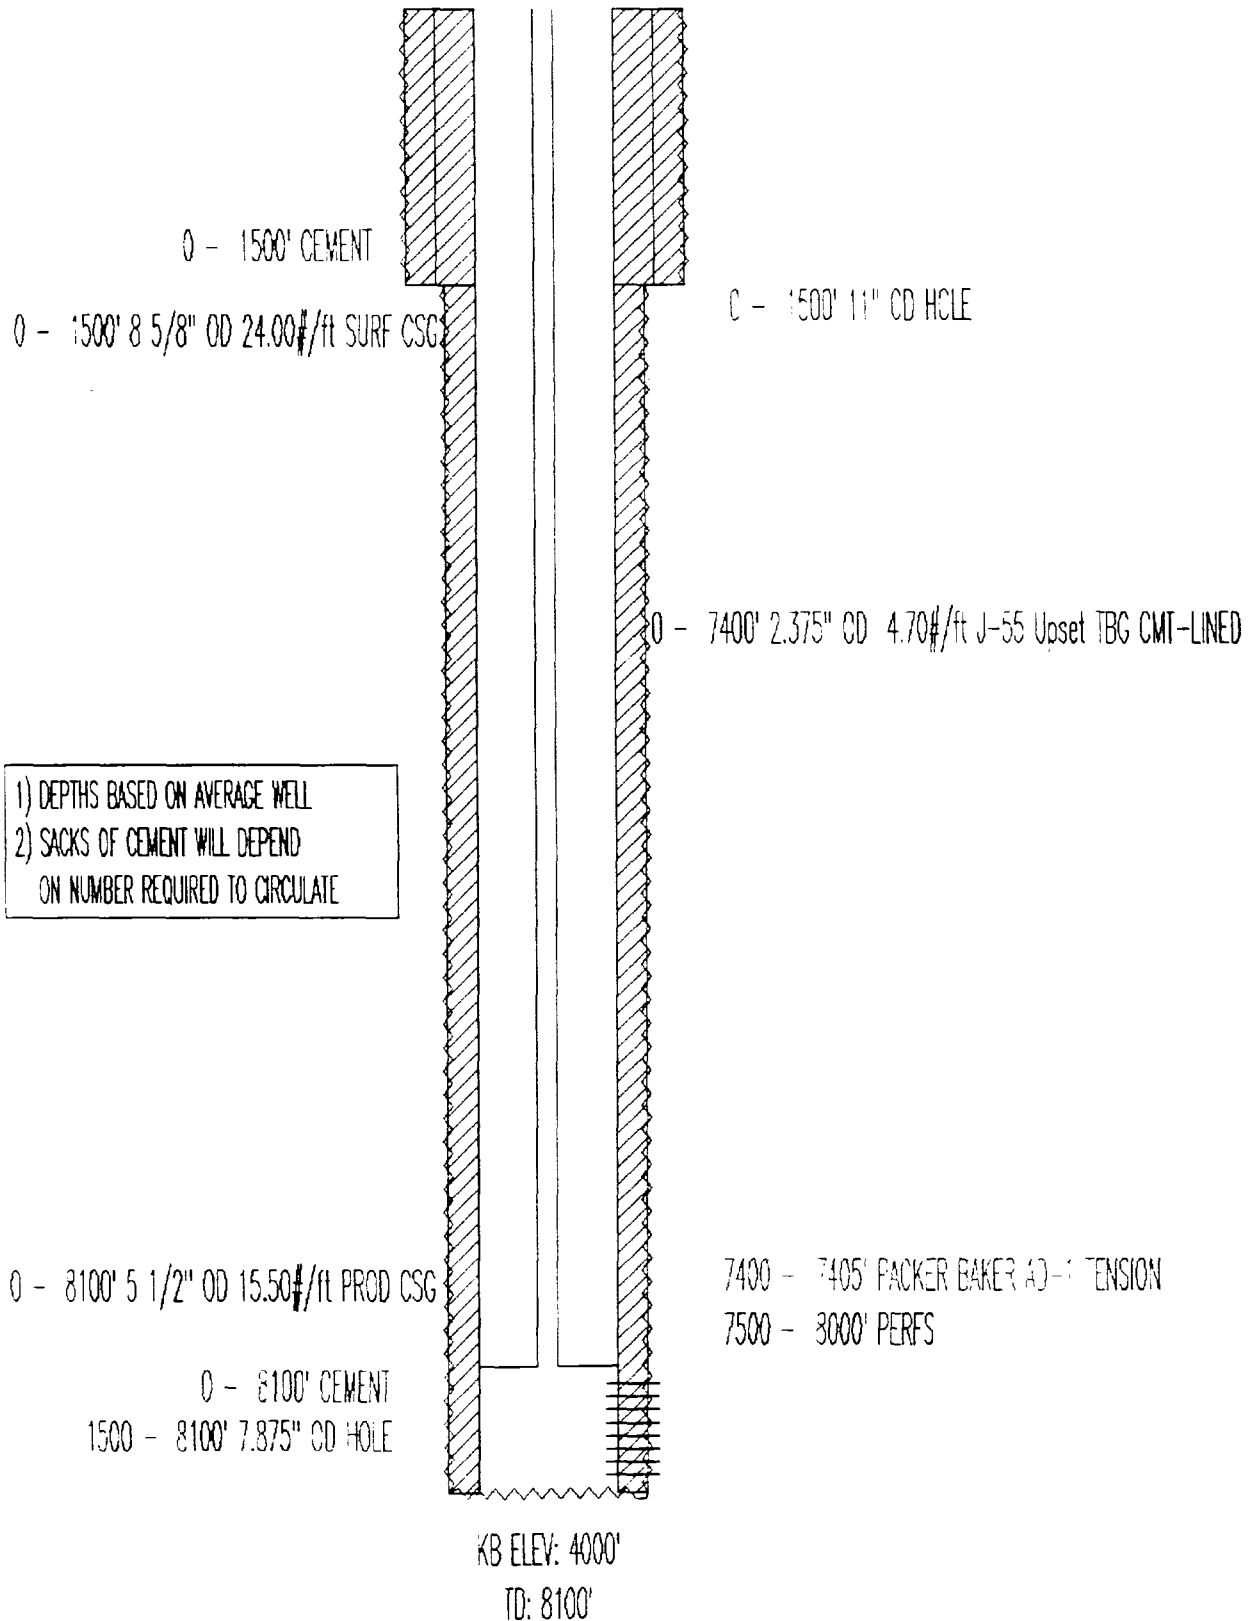

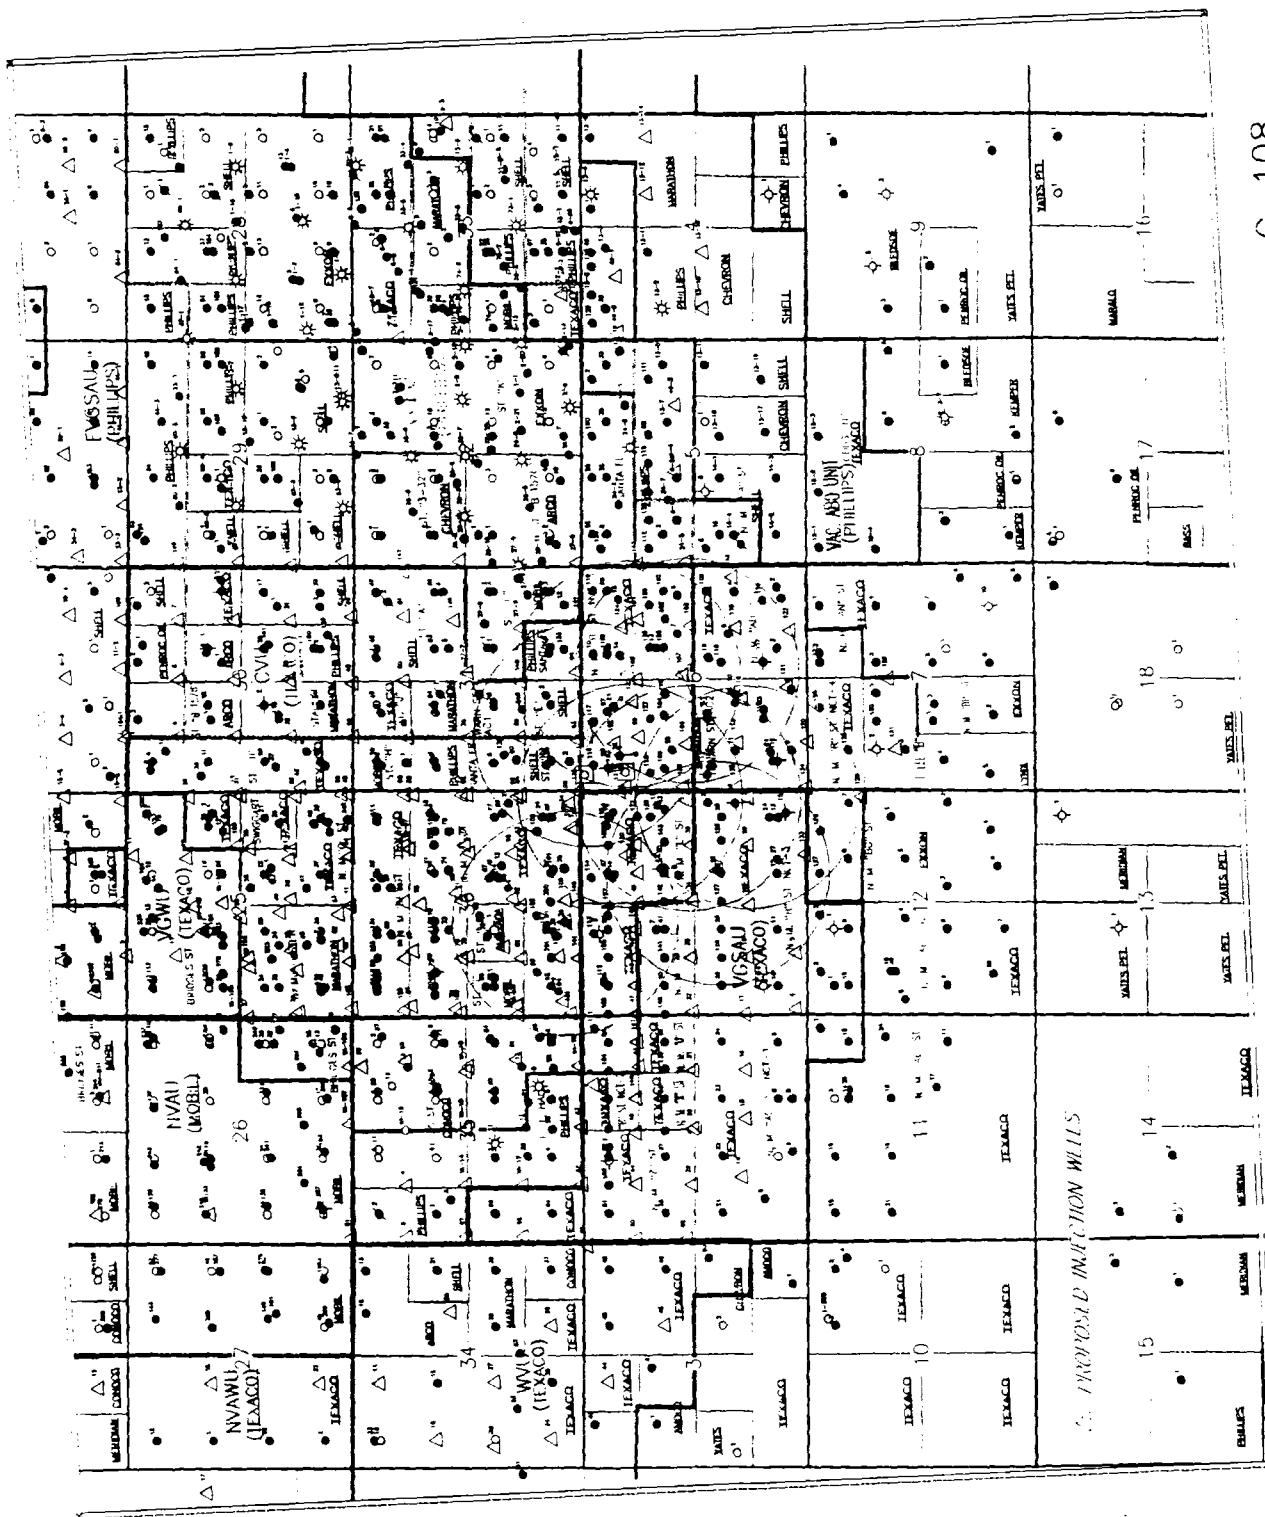


C-108

ATTACHMENT V

Scale 1:54000.



Texaco Exploration & Prod. Inc.	
LEASELINE INJECTION WELLS VACUUM DRINKARD FIELD LEA COUNTY NEW MEXICO	
Map, Date	11/7/74
Scale	1:54000

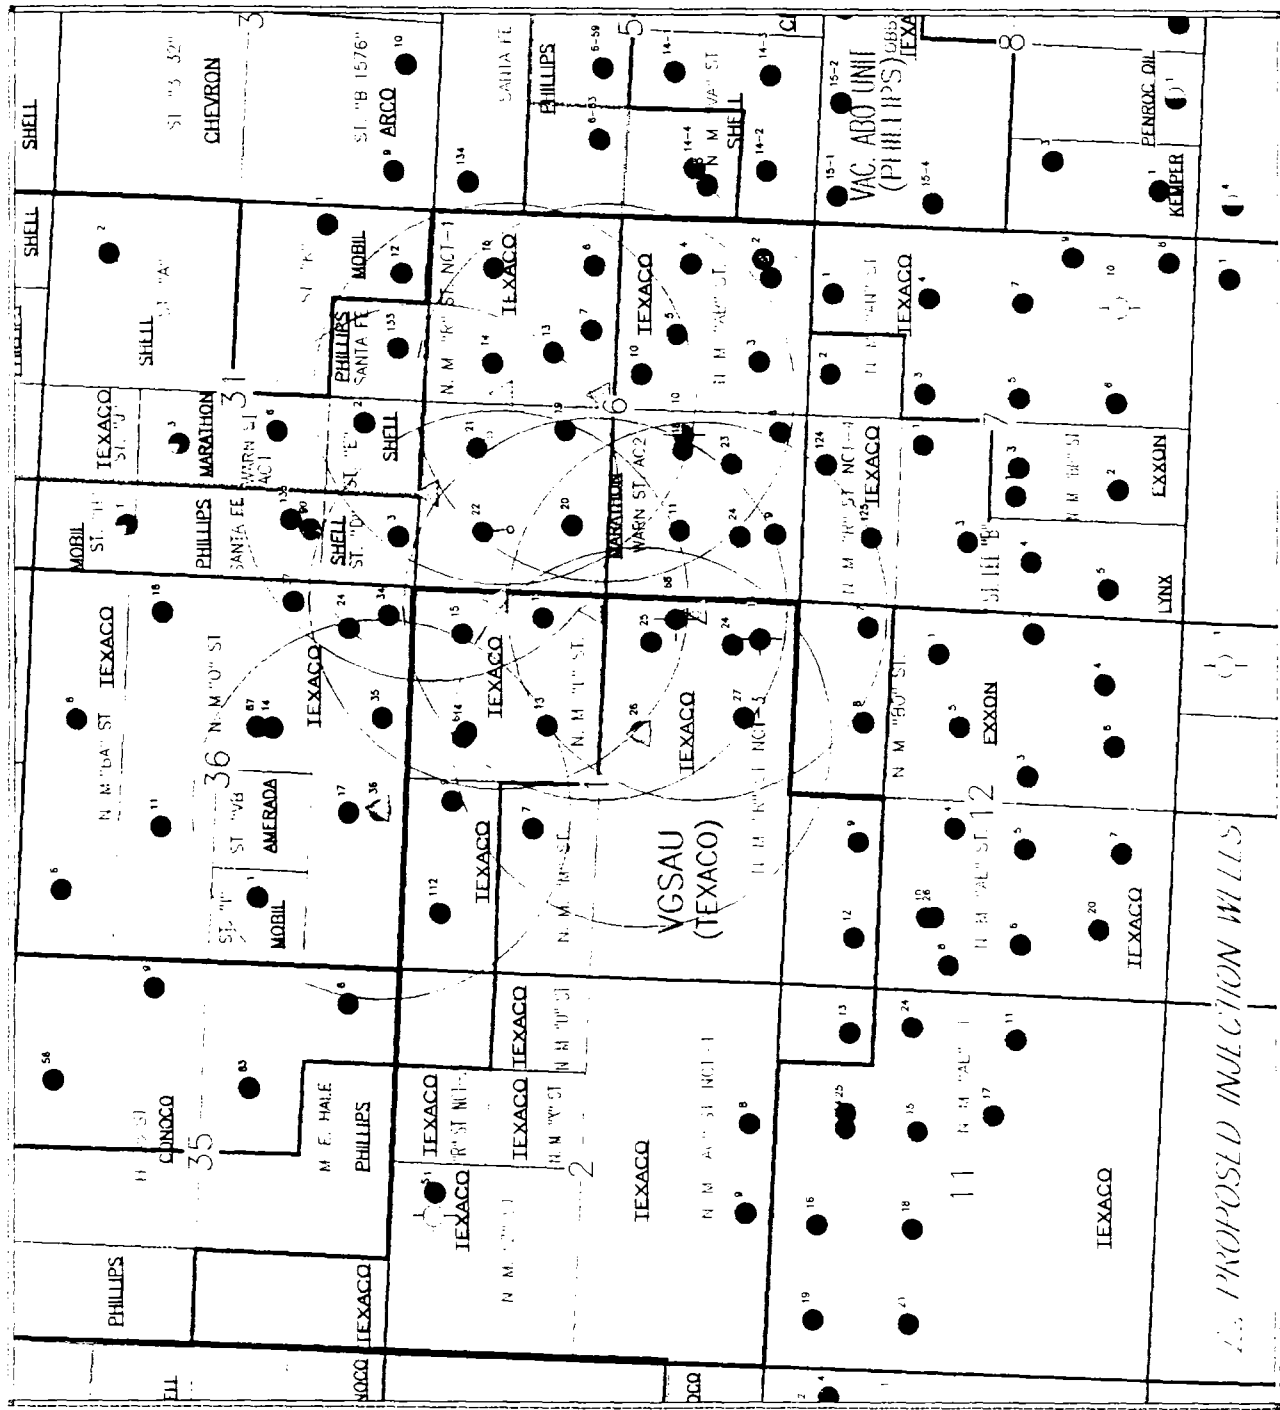


PROPOSED INJECTION WELLS

WELLS THAT PENETRATED INJECTION INTERVAL

Texaco Exploration & Prod. Inc.	
LEASELINE INJECTION WELLS VACUUM DRINKARD FIELD LEA COUNTY NEW MEXICO	
Map Date	11/7/84
Scale	1:32000

Scale 1:32000.

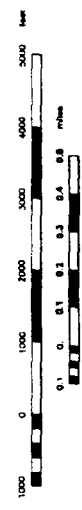

C108 ATTACHMENT VI
WELLS WITHIN 1/2 MILE RADIUS OF REVIEW

OPERATOR	WELL NAME API NO.	LOCATION	COMPLETION DATE	TD	PSTD	CASING SIZE	CASING DEPTH	CEMENT BACKLOG	TOP	METHOD	PRODUCING INTERVAL	CURRENT STATUS	REMARKS	
Marathon Oil Co	Wm St a/c 2 No. 8 3002500082	330' FSL, 2333' FWL SEC 6, T16S R35E (N)	3/13/62	6667	8818	13-3/8 8-5/8 5-1/2	357 3199 8686	350 1440 900	0 0 377'0"	CIRC CIRC CBL	7939 - 8169' 8456 - 8730'	SI	Abo and Drinkard are downhole coning	
Marathon Oil Co	Wm St a/c 2 No. 8 3002500083	330' FSL, 913' FWL SEC 6, T16S R35E (M)	9/16/71	8771	8737	13-3/8 8-5/8 5-1/2	356 3158 8788	350 1200 850	0 0 2815'	CIRC CIRC CBL	7600 - 8063' 8423 - 8702'	SI	Abo and Drinkard are downhole coning	
Marathon Oil Co	Wm St a/c 2 No. 10 3002500020	1650' FSL, 2232' FWL SEC 6, T16S R35E (K)	5/29/63	8670	8623	13-3/8 8-5/8 5-1/2	371 3307 8666	315 1540 560	0 0 225'	CIRC CIRC CBL	8644 - 8791'	PLA	Pumped 60 ac cmt plug w/TOC @ 4486' PUH to 3337' pumped 25 ac cmt w/CaCl plug TOC @ 3115' PUH to 1519' pumped 20 ac cmt w/TOC @ 1329' PUH to 424' pumped 20 ac cmt w/TOC @ 234' POOH w/ 2-7/8" log, ND BOPB Pumped 8 ac cmt plug to surface	
Marathon Oil Co	Wm St a/c 2 No. 11 3002500031	1650' FSL, 810' FWL SEC 6, T16S R35E (L)	11/1/62	8766	7605	13-3/8 8-5/8 5-1/2	360 3400 8797	350 1550 1200	0 0 745'	CIRC CIRC CBL	7630-8042' 8485-8659'	PROD Abnd	Drinkard Recompleted from Abo 1092	
Marathon Oil Co	Wm St a/c 2 No. 18 3002531687	1650' FSL, 2035' FWL SEC 6, T16S R35E (K)	4/5/63	8250	8163	11-3/4 8-5/8 5-1/2	1460 2893 8248	850 850 1485	0 0 0	CIRC CIRC CIRC	7654 - 8034'	PROD	Drinkard	
Marathon Oil Co	Wm St a/c 2 No. 19 3002531927	2010' FNL, 2230' FWL SEC 6, T16S R35E (F)	5/10/63	8160	8080	11-3/4 8-5/8 5-1/2	1460 2832 8180	850 850 1350	0 0 6840'	CIRC CIRC CBL	7632 - 8044'	PROD	Drinkard	
Marathon Oil Co	Wm St a/c 2 No. 20 3002531834	2160' FNL, 910' FWL SEC 6, T16S R35E (E)	6/13/63	8186	8056	11-3/4 8-5/8 5-1/2	1453 2865 8186	1000 850 1865	0 0 0	CIRC CIRC CIRC	7615 - 7977'	PROD	Drinkard	
Marathon Oil Co	Wm St a/c 2 No. 21 3002531996	1100' FNL, 1993' FWL SEC 6, T16S R35E (C)	7/17/63	8200	8089	11-3/4 8-5/8 5-1/2	1485 2823 8156	750 900 1590	0 0 1060'	CIRC CIRC CBL	7623 - 7989' 8000 - 8300'	PROD	Drinkard Directionally drilled BHL 839' FNL, 2168' FNL	
Marathon Oil Co	Wm St a/c 2 No. 22 3002532034	1219' FNL, 690' FWL SEC 6, T16S R35E (D)	8/21/63	8136	8046	11-3/4 8-5/8 5-1/2	1444 2787 8136	900 1100 1780	0 0 0	CIRC CIRC CIRC	7586 - 7863'	PROD	Drinkard Directionally drilled BHL 832' FNL, 843' FNL	
Marathon Oil Co	Wm St a/c 2 No. 23 3002532187	990' FSL, 1920' FWL SEC 6, T16S R35E (N)	12/4/63	8300	8205	11-3/4 8-5/8 5-1/2	1477 2836 8300	800 800 1550	0 0 2820'	CIRC CIRC CBL	7640 - 8030'	PROD	Drinkard	
Marathon Oil Co	Wm St a/c 2 No. 24 3002532189	990' FSL, 400' FWL SEC 6, T16S R35E (M)	10/25/63	8170	8060	11-3/4 8-5/8 5-1/2	1460 2830 8170	850 1048 1860	0 0 2490'	CIRC CIRC CBL	7606 - 8041'	PROD	Drinkard	
Texasco E&P Inc.	Vacuum Golieta West Unit No. 90 3002502070	2130' FSL, 660' FEL SEC 31, T17S R35E (L)	2/16/64	10500	10239	13-3/8 8-5/8 7	337 4774 10500	350 782 1110	0 2400 4700	0 0 0	CIRC CALC CBL	8030-8136' 9162-9300' 10006-10016'	PROD SI SI	Recompleted the Golieta 3/16/77 Wolfcamp & Abo parts packed off 3/16/77 Formerly Phillips Petroleum Corporation Santa Fe No. 87
Phillips Petroleum Corporation	Santa Fe No. 133 3002532333	435' FSL, 1930' FEL SEC 31, T17S R35E (O)	2/23/64	8100	8100	13-3/8 8-5/8 5-1/2	1539 5145 8100	1750 2400 825	0 0 5000	0 0 0	CIRC CIRC CALC	7540-7508'	PROD	Drinkard
Phillips Petroleum Corporation	Santa Fe No. 135 3002532438	1743' FSL, 808' FWL SEC 31, T17S R35E (L)	5/19/64	8052	7954	8-5/8 5-1/2	1500 8052	850 2494	0 0	0 0	CIRC CIRC	7537-7684' 7764-7859'	PROD	Drinkard
Texasco E&P Inc.	N. M. "O" St. NCT-1 No. 37 3002532450	1650' FSL, 330' FEL SEC 36, T17S R34E (I)	5/3/64	8184	8029	8-5/8 5-1/2	1476 8148	575 1700	0 0	0 0	CIRC CIRC	7503-7918'	PROD	Drinkard
Texasco E&P Inc.	N. M. "O" St. NCT-1 No. 35 3002532338	355' FSL, 1875' FEL SEC 36, T17S R34E (O)	3/26/64	8100	7980	8-5/8 5-1/2	1460 8100	650 2025	0 0	0 0	CIRC CIRC	7516-7751' 7486-7482'	PROD	Drinkard
Texasco E&P Inc.	N. M. "O" St. NCT-1 No. 34 3002532271	360' FSL, 330' FEL SEC 36, T17S R34E (P)	1/7/64	8000	7980	8-5/8 5-1/2	1460 8000	650 3285	0 0	0 0	CIRC CIRC	7551-7872'	PROD	Drinkard

C108 ATTACHMENT VI
WELLS WITHIN 1/2 MILE RADIUS OF REVIEW

OPERATOR	WELL NAME API NO.	LOCATION	COMPLETION DATE	TD	PSTD	CASING SIZE	CASING DEPTH	CEMENT BACKS	TOP	METHOD	PRODUCING INTERVAL	CURRENT STATUS	REMARKS
Texasco E&P Inc.	N. M. "O" ST. NCT-1 No. 24 3002530946	860 FSL 860 FEL SEC 36, T11S R34E (P)	7/4/64	10300	10300	13-3/8 8-5/8 2-7/8 2-7/8	1534 4418 10300 10286 10228	1334 4418 10300 10286 10228	1200 0 2400 2900	CIRC CIRC CALC	5942-6200 10206-10212 10042-10062 9133-9283	SI SI SI	Glorieta perfs abandoned by CIBP at 5155 Abo tested dry plugged back to Gloria Wolfcamp perfs tested w/ 40 ex Abo perfs abandoned by CIBP at 6595
Texasco E&P Inc.	N. M. "L" ST. No. 6 3002530514	770 FNL 2090 FEL SEC 1, T11S R34E (B)	2/6/71	12255	12155	13-3/8 8-5/8 2-7/8 2-7/8	1510 4800 10587 11300 11316	1200 0 1700 1800 670	1200 0 1700 1800 670	CIRC CIRC BRDHD SOZ SOZ	9639-9664 5694-6152 8684-8697 10872-11234 8246-10220	SI SI SOZD SOZD SOZD	Wolfcamp Glorieta Sep w/ 28 ex Sep w/ 10 ex Sep w/ 150 ex thru retainer @ 9200
Texasco E&P Inc.	NEW MEXICO "L" ST. No. 12 3002531992	1860 FNL 660 FEL SEC 1, T11S R34E (H)	8/24/63	8000	7986	8-5/8 5-1/2	1478 6000	1478 6000	650 1825	CIRC TS	7540-7831	PROD	Drifted
Texasco E&P Inc.	NEW MEXICO "L" ST. No. 13 3002532007	1760 FNL 1890 FEL SEC 1, T11S R34E (G)	10/28/63	7960	7970	8-5/8 5-1/2	1470 7960	1470 7960	650 1785	CIRC CIRC	7568-7877	PROD	Drifted
Texasco E&P Inc.	NEW MEXICO "L" ST. No. 14 3002532008	810 FNL 1900 FEL SEC 1, T11S R34E (B)	11/5/63	7850	7928	8-5/8 5-1/2	1470 7950	1470 7950	650 2105	CIRC CIRC	7546-7827	PROD	Drifted
Texasco E&P Inc.	NEW MEXICO "L" ST. No. 15 3002532009	660 FNL 510 FEL SEC 1, T11S R34E (A)	10/2/63	7850	7930	8-5/8 5-1/2	1470 7950	1470 7950	760 3175	CIRC CIRC	7464-7806	PROD	Drifted
Texasco E&P Inc.	Central Vacuum Unit No. 124 3002503066	330 FNL 1904 FNL SEC 7, T11S R35E (C)	2/16/69	8640	4708	10-3/4 8-5/8 2-7/8 2-7/8	338 3128 8638 8632	338 3128 8638 8632	300 790 1180 3128	CIRC CIRC CALC	8143-8160 7997-8014 4646-4697	ABDN ABDN SI	Abo perfs plugged back to San Andres Drifted perfs plugged back to San Andres Formerly N. M. "R" ST. NCT-4 No. 1
Texasco E&P Inc.	Central Vacuum Unit No. 125 3002503100	960 FNL 913 FNL SEC 7, T11S R35E (D)	1/20/66	8000	7799	11-3/4 8-5/8 2-7/8 2-7/8	338 3313 8700 8793	338 3313 8700 8793	300 465 1400 500	CIRC CALC TS	8512-8656 7840-7907 4554-4735	SOZD ABDN SI	Abo perfs abandoned; Lost tbg in hole Drifted perfs plugged back to San Andres Formerly N. M. "R" ST. NCT-4 No. 2
Texasco E&P Inc.	N. M. "R" ST. NCT-1 No. 6 3002530653	2310 FNL 760 FEL SEC 6, T11S R35E (H)	5/6/63	8650	8440	11-3/4 8-5/8 2-7/8	357 3060 8648	350 1600 1300	350 0 2731	CIRC CIRC TS	8275-8718	SI	Abo Reef Perf and seg w/ 960 ex @ 3100'
Texasco E&P Inc.	N. M. "R" ST. NCT-1 No. 7 3002530603	2310 FNL 1650 FEL SEC 6, T11S R35E (G)	7/26/71	8650	8525	11-3/4 8-5/8 2-7/8	360 3032 8647	400 1850 3000	400 0 3000	CIRC CIRC CALC	8245-8510 8533-8686	SI SOZD	Abo Reef seg perfs thru retainer w/ 250 ex Perf and seg w/ 50 ex @ 3050'
Texasco E&P Inc.	N. M. "R" ST. NCT-1 No. 13 3002531990	1905 FNL 2130 FEL SEC 6, T11S R35E (G)	6/9/63	8150	8112	11-3/4 5-1/2	1460 8150	1460 8150	860 2100	CIRC TS	7608-8070	PROD	Drifted
Texasco E&P Inc.	N. M. "R" ST. NCT-1 No. 14 3002532016	860 FNL 2000 FEL SEC 6, T11S R35E (B)	9/10/63	8150	8130	8-5/8 5-1/2	1455 8150	1455 8150	850 2800	CIRC TS	7572-8101	PROD	Drifted
Texasco E&P Inc.	N. M. "R" ST. NCT-1 No. 15 3002532019	510 FNL 640 FEL SEC 6, T11S R35E (A)	12/14/63	8150	8140	8-5/8 5-1/2	1487 8150	1487 8150	850 2235	CIRC CIRC	7701-8098	PROD	Drifted
Texasco E&P Inc.	NEW MEXICO "AB" ST. No. 10 3002531981	2310 FSL 2110 FEL SEC 6, T11S R35E (J)	12/24/63	8200	8155	8-5/8 5-1/2	1495 8200	1495 8200	650 2195	CIRC CIRC	7757-7908	PROD	Drifted
Texasco E&P Inc.	NEW MEXICO "AB" ST. No. 3 3002503068	860 FSL 1960 FEL SEC 6, T11S R35E (O)	12/24/61	8656	8115	10-3/4 7-5/8 4-1/2	343 5404 5324 8656	250 900 550	250 0 5324	CIRC CIRC CIRC	7600-7981 8253-8646	PROD ABDN	Drifted Abo Reef isolated by CIBP @ 8115' Cmt 117-56 0-1600 w/ 450 ex
Texasco E&P Inc.	NEW MEXICO "AB" ST. No. 4 3002503067	1650 FSL 660 FEL SEC 6, T11S R35E (I)	12/22/61	9080	9066	10-3/4 7-5/8 4-1/2	327 5228 5106 9087	327 900 550	350 650 5106	CIRC CALC CIRC	8208-8626	SI	Abo Reef
Texasco E&P Inc.	NEW MEXICO "AB" ST. No. 5 3002503063	1800 FSL 1650 FEL SEC 6, T11S R35E (J)	3/14/63	8451	2765	11-3/4 6-5/8	340 3070	340 3070	300 1400	CIRC CIRC	8172-8794 6300-6568	P&A	Abo and Paddock 2-7/8 TBG CUT AT 1660'

C100 ATTACHMENT VI
WELLS WITHIN 1/2 MILE RADIUS OF REVIEW


OPERATOR	WELL NAME API NO.	LOCATION	COMPLETION DATE	TD	PSTD	CASING SIZE	CASING DEPTH	CEMENT BACKLOG	TOP	METHOD	PRODUCING INTERVAL	CURRENT STATUS	REMARKS
						2-7/8	8650	1500	6200	TS			400 SX PLG 1750-1900' 100 SX PLUG 1454-1750' 100 SX PLUG 0-1454'
Texasco E&P Inc.	N. M. "R" ST. NCT-3 No. 27 3002532004	660 FSL / 1650 FEL SEC 1, T188 R34E (O)	5/6/64	8100	7500 8-5/8 5-1/2		1470 8100	600 2400	0	CIRC	7656-7902	SI	Drinhard Failed to Produce
Texasco E&P Inc.	N. M. "R" ST. NCT-3 No. 15 3002520650	487 FSL 560 FEL SEC 1, T188 R34E (O)	8/5/64	10200	10200 13-3/8 8-5/8 2-7/8		355 4800 10200	400 1700 2400	0	CIRC	8495-8708 8652-8862 8956-8978	P & A	Also Reef & Wolfcamp Set CIBPs in both strings @ 8600', 8440', 8400' Cut log @ 4820' Set plug @ 4820', 2820', 1660' Perf & set 400 sz 455' to surf
Texasco E&P Inc.	Vacuum Gravity BA Unit No. 68 3002521110	1655 FSL 330 FEL SEC 1, T188 R34E (I)	10/6/64	8000	0 11-3/4 8-5/8 2-7/8		402 3250 8000	350 1650 1800	0	CIRC	8472-8572 5998-8129 4336-4686	P & A	CIBP W/25' CAPS @ 6235', 5950', & 4755' 802 PERFS @ 3280' & 400' CIRC CMT. Formerly N. M. "R" ST. NCT-3 No. 16
Texasco E&P Inc.	N. M. "R" ST. NCT-3 No. 24 3002528625	860 FSL 660 FEL SEC 1, T188 R34E (O)	11/4/61	11994	7982 40 28 20 8-5/8 7 5		40 407 1585 5000 11100 10778- 11678	REDIMIX 1000 2150 3700 2050 175	0	CIRC	10192-10283 11192-11258 7838-7900	ABDN ABDN PROD	Upper Perm Lower Miss. Drinhard
Texasco E&P Inc.	N. M. "R" ST. NCT-3 No. 25 3002531830	1940 FSL 660 FEL SEC 1, T188 R34E (I)	4/30/63	8000	7950 11-3/4 5-1/2		1470 8000	1090 1990	0	CIRC	7566-7908	PROD	Drinhard
Shell Oil	STATE "E" No. 2 3002520623	660 FSL 1700 FWL SEC 31, T178 R35E (N)	5/1/64	10406	8085 13-3/8 8-5/8 7		332 3284' 8605'	300 574 1800	0	CIRC	7818-7904 5998-8223 8218-8418	PROD 802D ABDN	Abandoned Wolfcamp Perfs w/ CIBP @ 8095' Squeezed Paddock perfs with 150 Perf & set @ 3320' circ cnt to surface
Shell Oil	STATE "D" No. 3 3002532298	330 FSL 660 FWL SEC 31, T178 R35E (M)	2/15/64	8049	8049 13-3/8 8-5/8 5-1/2		1463 3200 8049	1255 1015 1010	0	CIRC	7525-7844	PROD	Drinhard
EXXON	N. M. "BO" ST. NCT-3 No. 7 3002520176	965 FSL 330 FEL SEC 12, T188 R34E (A)	4/21/63	8000	8000 13-3/8 8-5/8 4-1/2		302 3403 8998	325 650 1200	0	CIRC	8343-8655 8914-8957 8620-8748	PROD ABDN ABDN	Tested Wolfcamp and plugged back to Also Reef Perf and set @ 1800' w 1050 sz
Mobil	STATE "K" No. 12 3002532413	330 FSL 990 FEL SEC 31 T178 R35E (P)	3/17/64	8083	8083 8-5/8 5-1/2		1480 6063	450 800	0	CIRC	7828-7962	PROD	Drinhard
Marathon Oil Co	Wain SI AC 1 No. 6 3002532311	1840 FSL 2030 FWL SEC 31 T178 R35E (K)	1/24/64	10335	10088 11-3/4 8-5/8 5-1/2		1492 3000 10355	800 800 2025	0	CIRC	9438-10058 10102-10186	PROD	Initial completion in Upper Perm, tested wet. Set CIBP at 10088' isolate Upper Perm Recompleted to Wolfcamp
Texasco E&P Inc.	N. M. "O" ST. NCT-1 No. 14 3002520008	1874 FSL 2068 FEL SEC 36 T178 R34E (N)	7/26/63	12154	12154 13-3/8 8-5/8 2-7/8		1593 4625 12152	1200 1700 1250	0	CIRC	12114-12122 11202-11270 6649-6862	802D ABDN ABDN	Producing from the Wolfcamp 8-5/8 string Braided sept w/600 sz cnt
Texasco E&P Inc.	Vacuum Gloria West Unit No. 87 3002521637	2090 FSL 2068 FEL SEC 36 T178 R34E (J)	1/23/68	10200	8185 11-3/4 8-5/8 4-1/2		1498 4825 10200	1300 1100 1050	0	CIRC	10085-10184 5930-6180	ABDN PROD	Plugged back from Perm Reef to the Gloria Formerly N. M. "O" ST. No. 25
Texasco E&P Inc.	Vacuum Gloria West Unit No. 112 3002520515	560 FSL 760 FWL SEC 1, T188 R34E (D)	11/16/63	12215	6100 13-3/8 8-5/8 2-7/8		1492 478 9473	1150 1700 2250	0	CIRC	6078-6094 9068-9310 8337-8960	802D 802D SI	Formerly N. M. "M" ST. No. 5 Braided sept 8-5/8' csg w 650 sz 0-2100' Gloria perfs abandoned due to leak Also string plugged back to Gloria
Texasco E&P Inc.	N. M. "M" ST. No. 7 3002520494	1800 FSL 1840 FWL SEC 1, T188 R34E (I)	10/11/63	12200	7865 13-3/8 8-5/8		1513 4805	1100 1700	0	CIRC	9967-10047 8018-8028	ABDN ABDN	Wolfcamp and Gloria perfs Abdn Producing from Drinhard

C108 ATTACHMENT VI
WELLS WITHIN 1/2 MILE RADIUS OF REVIEW

OPERATOR	WELL NAME API NO.	LOCATION	COMPLETION DATE	TD	PSID	CASING SIZE	CASING DEPTH	CEMENT BACKS	TOP	METHOD	PRODUCING INTERVAL	CURRENT STATUS	REMARKS
Tessco E&P Inc.	N. M. "M" ST. No. 8 3002520494	660 FNL 2310 FNL SEC 1, T16S R34E (C)	2/21/84	8100	8053	8-5/8 5-1/2	10222	187	1720	TS	7530-7666	PROD	
							2-7/8	10198					
							2-7/8	9737					
Mobil	State CC Com Unit No. 1 3002520872	1940 FSL 660 FNL SEC 38 T17S R34E (L)	8/12/84	12040	10222	16 10-3/4 2-7/8 2-7/8 4-1/2	360	350	0	CIRC	9115-9185	ABDN	Crt plugs set in 2-7/8" string Also end Wolfcamp Commingled in 4-1/2" csg
							4867	2025	0	CIRC	11972-12028	ABDN	
							12040	4460	0	CIRC	9115-9185	PROD	
Tessco E&P Inc.	N. M. "O" ST. NCT-1 No. 17 3002520125	780 FSL 2040 FNL SEC 38 T17S R34E (N)	8/22/83	12082	10070	13-3/8 8-5/8 2-7/8 3-1/2 2-7/8	10222	1200	0	CIRC	9097-9224	SOZD	Crt plug set in 2-7/8" string Perm Refr string casing collapsed @ 9156' Tested Also recompleted in Wolfcamp Plugged back Devonian to Wolfcamp Wolfcamp Shul in
							1812	1700	2700	CALC	9692-10004	SOZD	
							4750	1325	2160	CBL	10130-10140	SOZD/ABN	
							10864				11934-11990	ABDN	
							10232				9682-10028	SI	
							10875						


PRODUCING
WOLFCAMP

MARATHON OIL
WARN STATE A/C-1 NO. 6
API# 3002532311

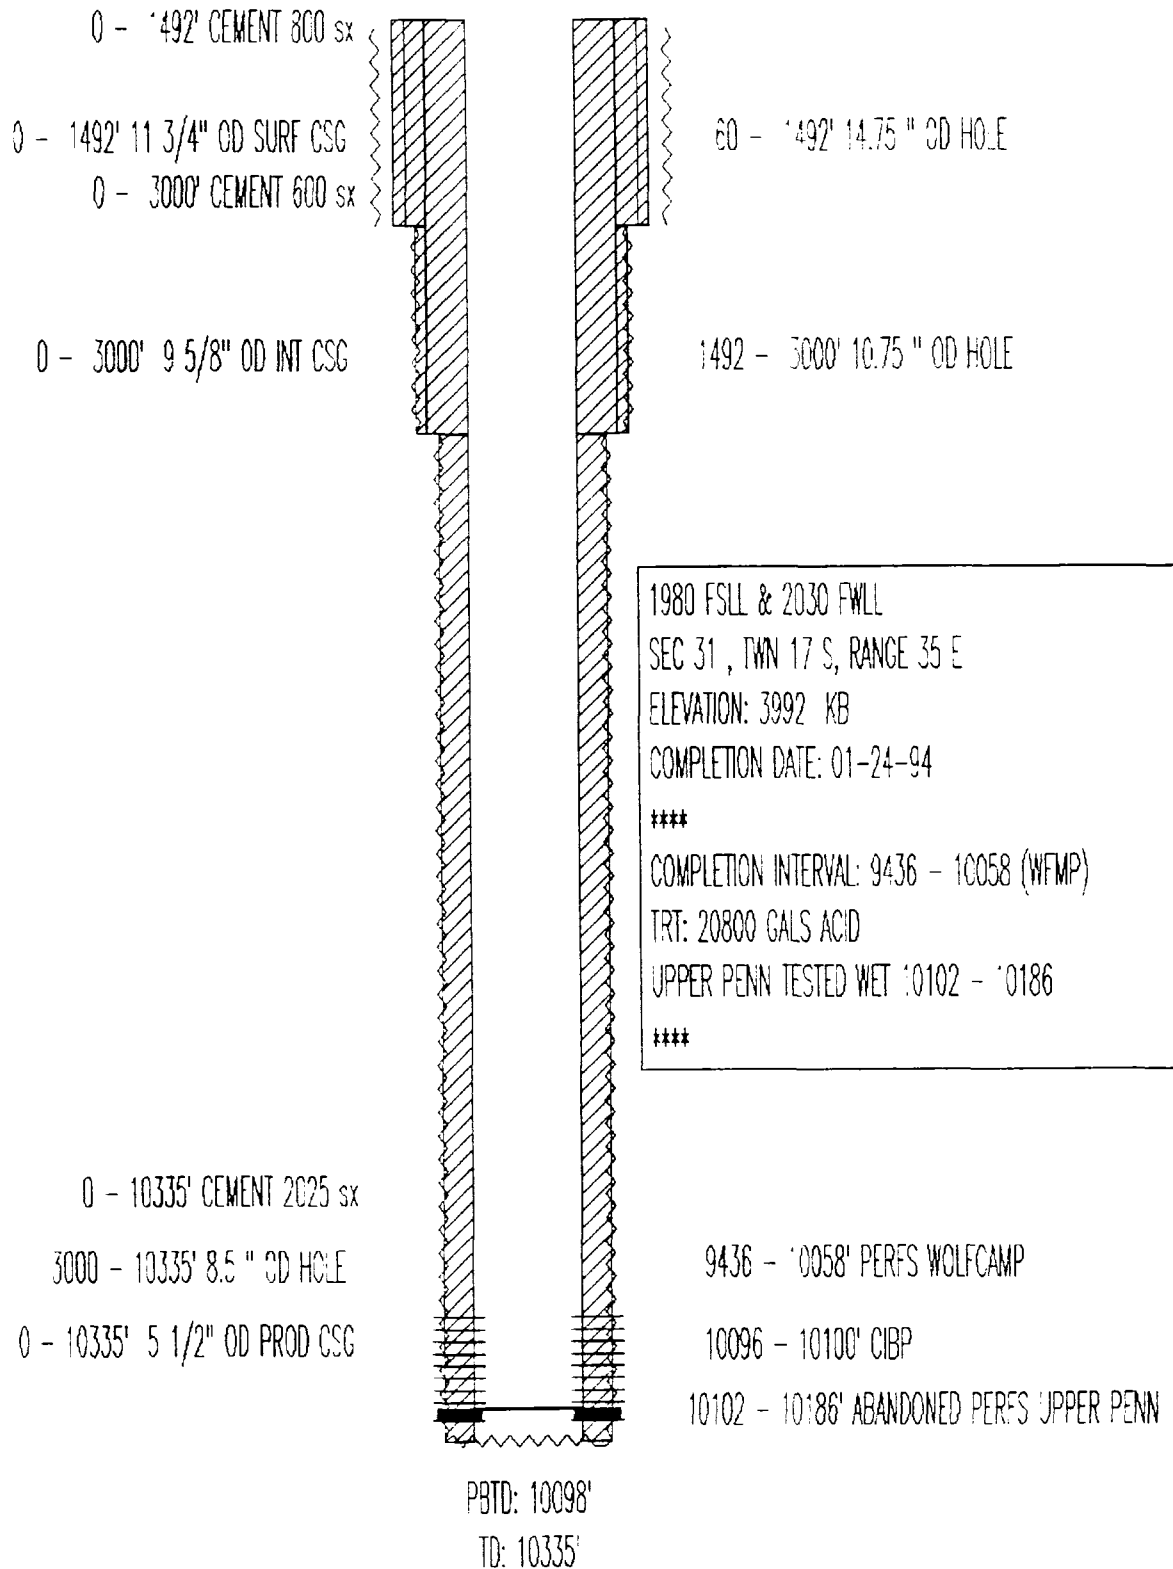

CURRENT STATUS - SHUT IN
ABO & DRINKARD COMMINGLED

MARATHON OIL
WARN-STATE A/C-2 NO. 8
API# 3002503082

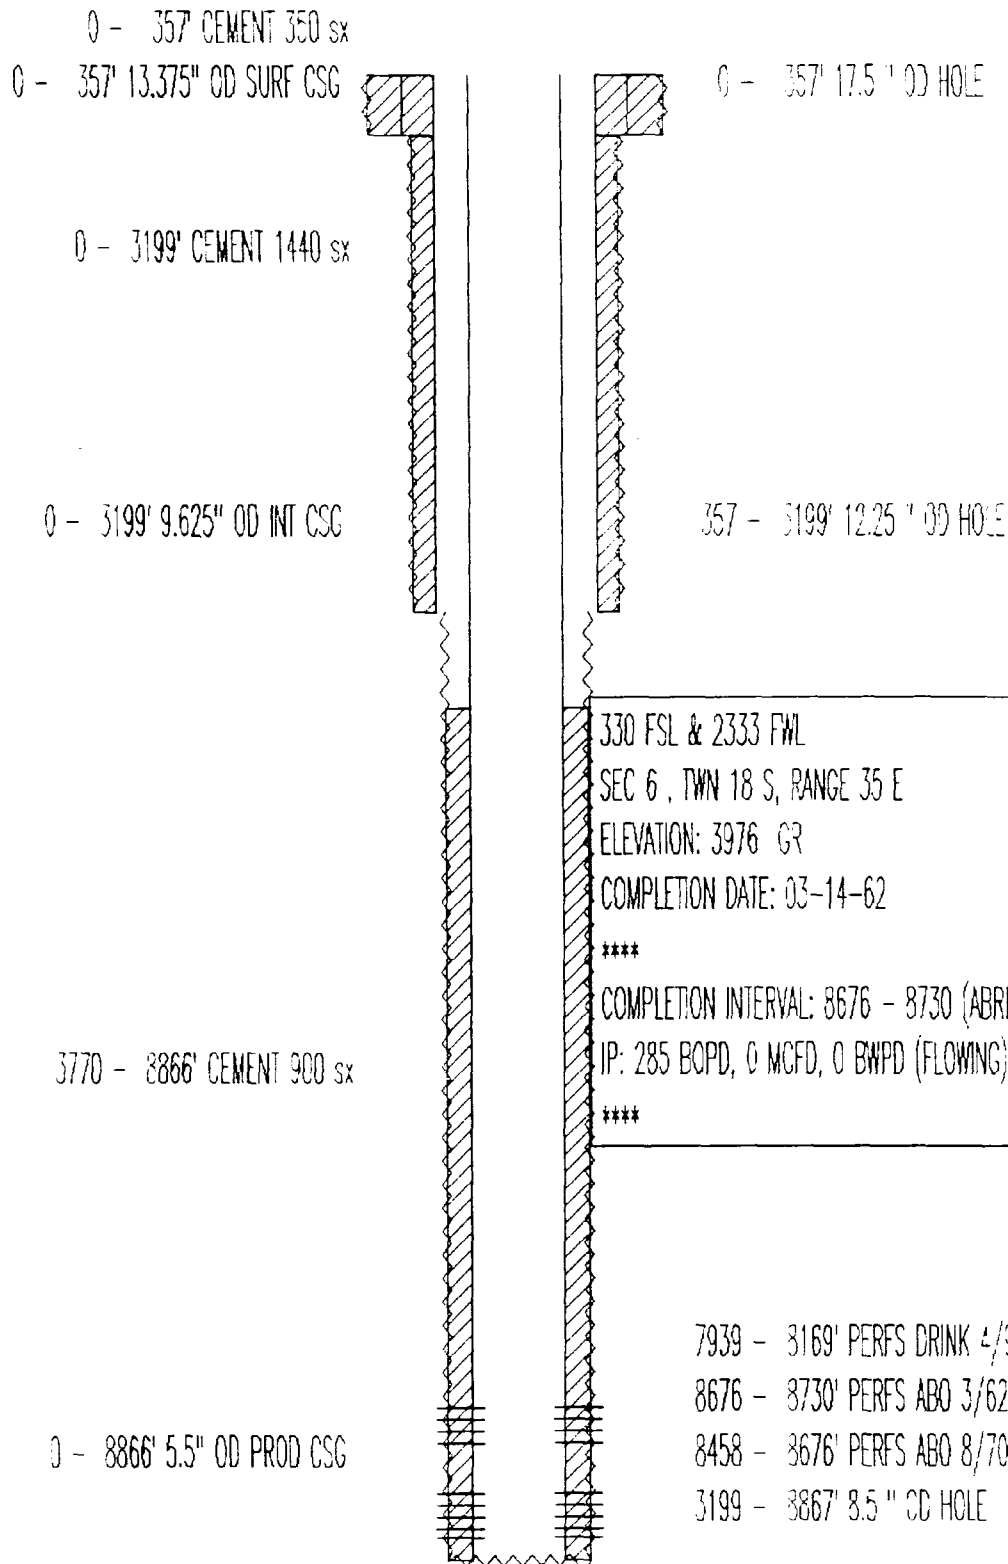

KB ELEV: 3976'
PBTD: 8818'
TD: 8867'

SHUT IN
ABO AND DRINKARD COMMINGLED

MARATHON OIL
WARN-STATE A/C-2 NO. 9
API# 30025030830000

0 - 356' CEMENT 350 sx
0 - 356' 13.375" OD SURF CSG

0 - 356' 17.5 " OD HOLE

0 - 3159' CEMENT 1400 sx

0 - 3159' 9.625" OD INT CSG

356 - 3159' 12.25 " OD HOLE

2915 - 8769' CEMENT 850 sx

330 FSL & 913 FWL

SEC 6 , TWN 18 S, RANGE 35 E

ELEVATION: 3889 DF

COMPLETION DATE: 06-01-62

COMPLETION INTERVAL: 8541 - 8608 (ABRF)

IP: 337 BOPD, 0 MCFD, 0 BWPD (FLOWING)

0 - 8769' 5.5" OD PROD CSG

7800 - 8068' PERFS DRINK 1/93

8541 - 8608' PERFS ABO 6/62

8423 - 8541' PERFS ABO 8/71

3159 - 3771' 8.5 " OD HOLE

KB ELEV: 3979'

PBTD: 8737'

TD: 8771'

PLUGGED & ABANDONED

MARATHON OIL
WARN-STATE A/C-2 NO. 10
API# 3002520020

0 - 10' CEMENT PLUG 6 SX
0 - 371' CEMENT 3.5 SX
0 - 371' 13.375" OD SURF CSG
234 - 424' CEMENT PLUG 20 SX
1329 - 1519' CEMENT PLUG 20 SX
0 - 3307' CEMENT 1540 SX

3113 - 3357' CEMENT PLUG 25 SX
0 - 3307' 9.625" OD INT CSG

225 - 8868' CEMENT 560 SX
4486 - 5070' CEMENT PLUG 60 SX

0 - 8868' 5.5" OD PROD CSG

0 - 371' 17.5" OD HOLE

371 - 3307' 12.25" OD HOLE

1650 FSL & 2232 FWL
SEC 6 , TWN 18 S, RANGE 35 E
ELEVATION: 3989 OF
COMPLETION DATE: 05-29-63

COMPLETION INTERVAL: 8644 - 8791 (ABO)
IP: 190 BOPD, 0 MCFD, 0 BHPD (FLOWING)

8644 - 8791' PERFS

3307 - 3870' 8.5" OD HOLE

PBTD: 8823'

TD: 8870'

PRODUCING
DRINKARD

MARATHON OIL
WARN STATE A/C-2 NO. 11
API# 3002520031

0 - 360' 13.375" OD SURF CSG

0 - 360' 17.5" OD HOLE

0 - 360' CEMENT 250 sk

0 - 3400' CEMENT 1550 sk

0 - 3400' 8.625" OD INT CSG

360 - 3400' 12.25" OD HOLE

745 - 3797' CEMENT 1255 sk

1650 FSL & 910 FWL

SEC 6, TWN 18 S, RANGE 35 E

ELEVATION: 3992' OF

COMPLETION DATE: 08-07-63

COMPLETION INTERVAL: 8485 - 8655 (ABO)

TRT: 2000 GALS ACID (8485 - 8655)

IP: 169 BOPD, 0 MCFD, 0 BWPD (FLOWING)

7805 - 7810' CIBP

7630 - 7790' PERFS DRINKARD 11/92

0 - 8797' 5.5" OD PROD CSG

3400 - 3799' 7.875" OD HOLE

8485 - 8655' PERFS ABO 8/63


KB ELEV: 3992'

PBTD: 7805'

TD: 8799'


PRODUCING
DRINKARD

MARATHON OIL
WARN STATE A/C-2 NO. 18
API# 3002531887

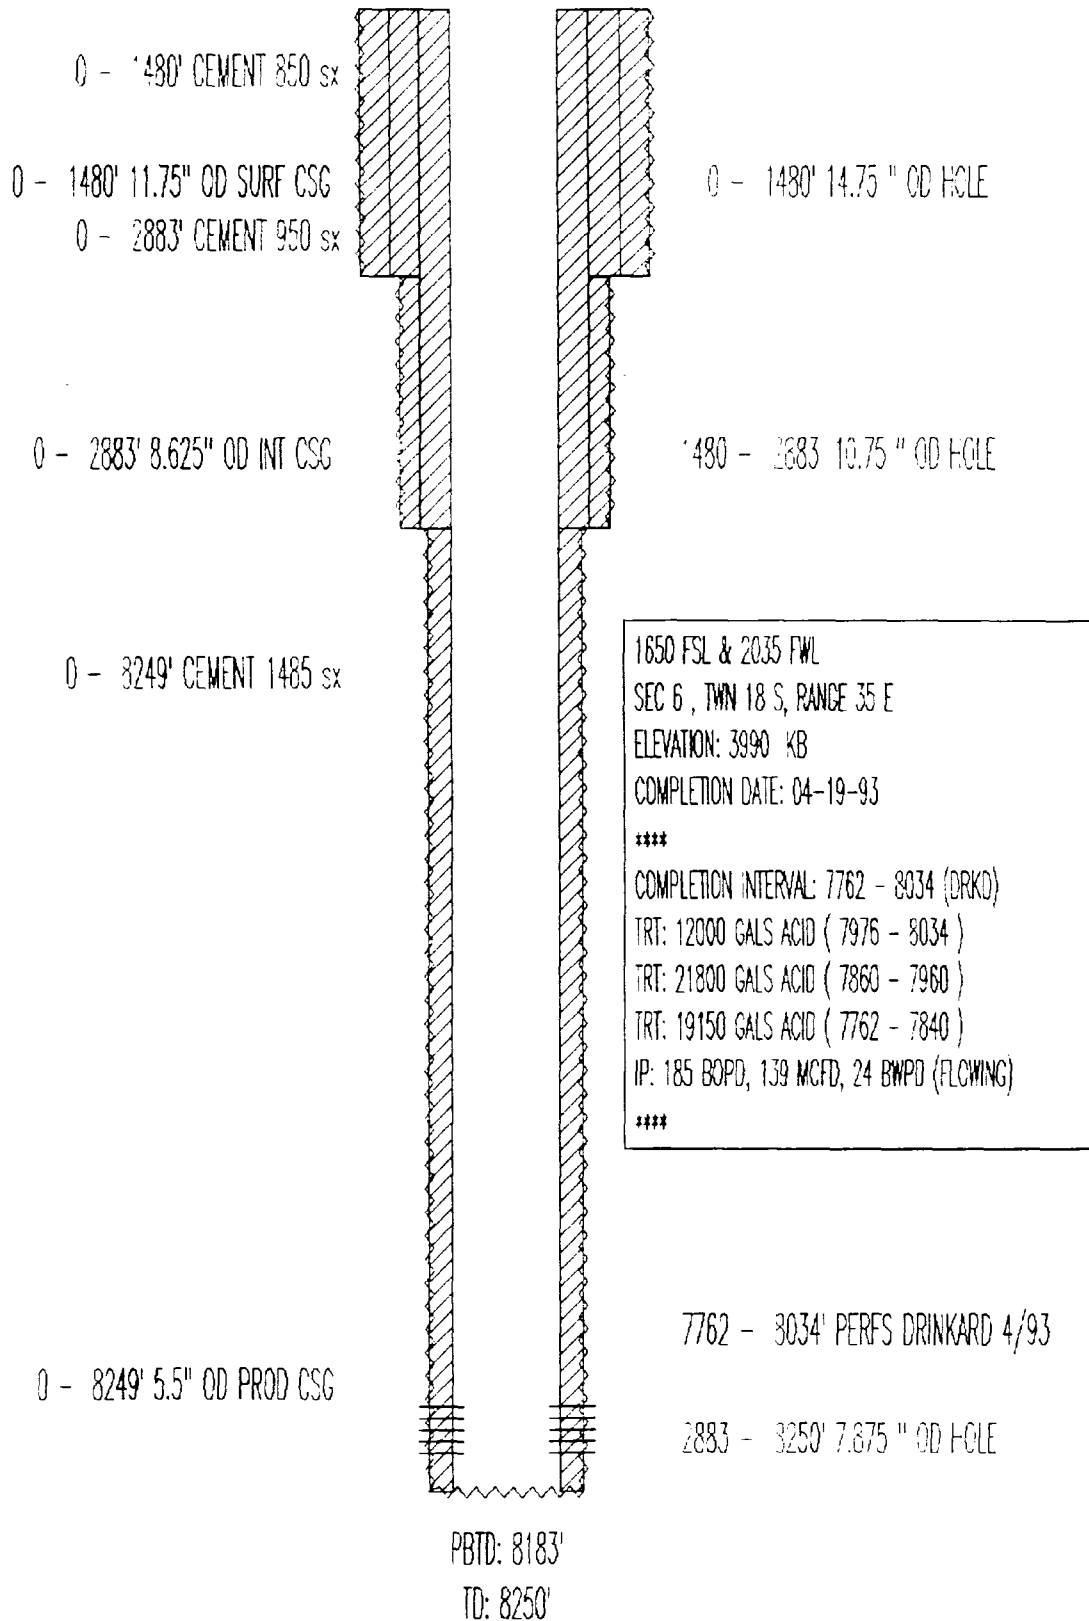


PRODUCING
DRINKARD

MARATHON OIL
WARN STATE A/C-2 NO. 19
API# 3002531927

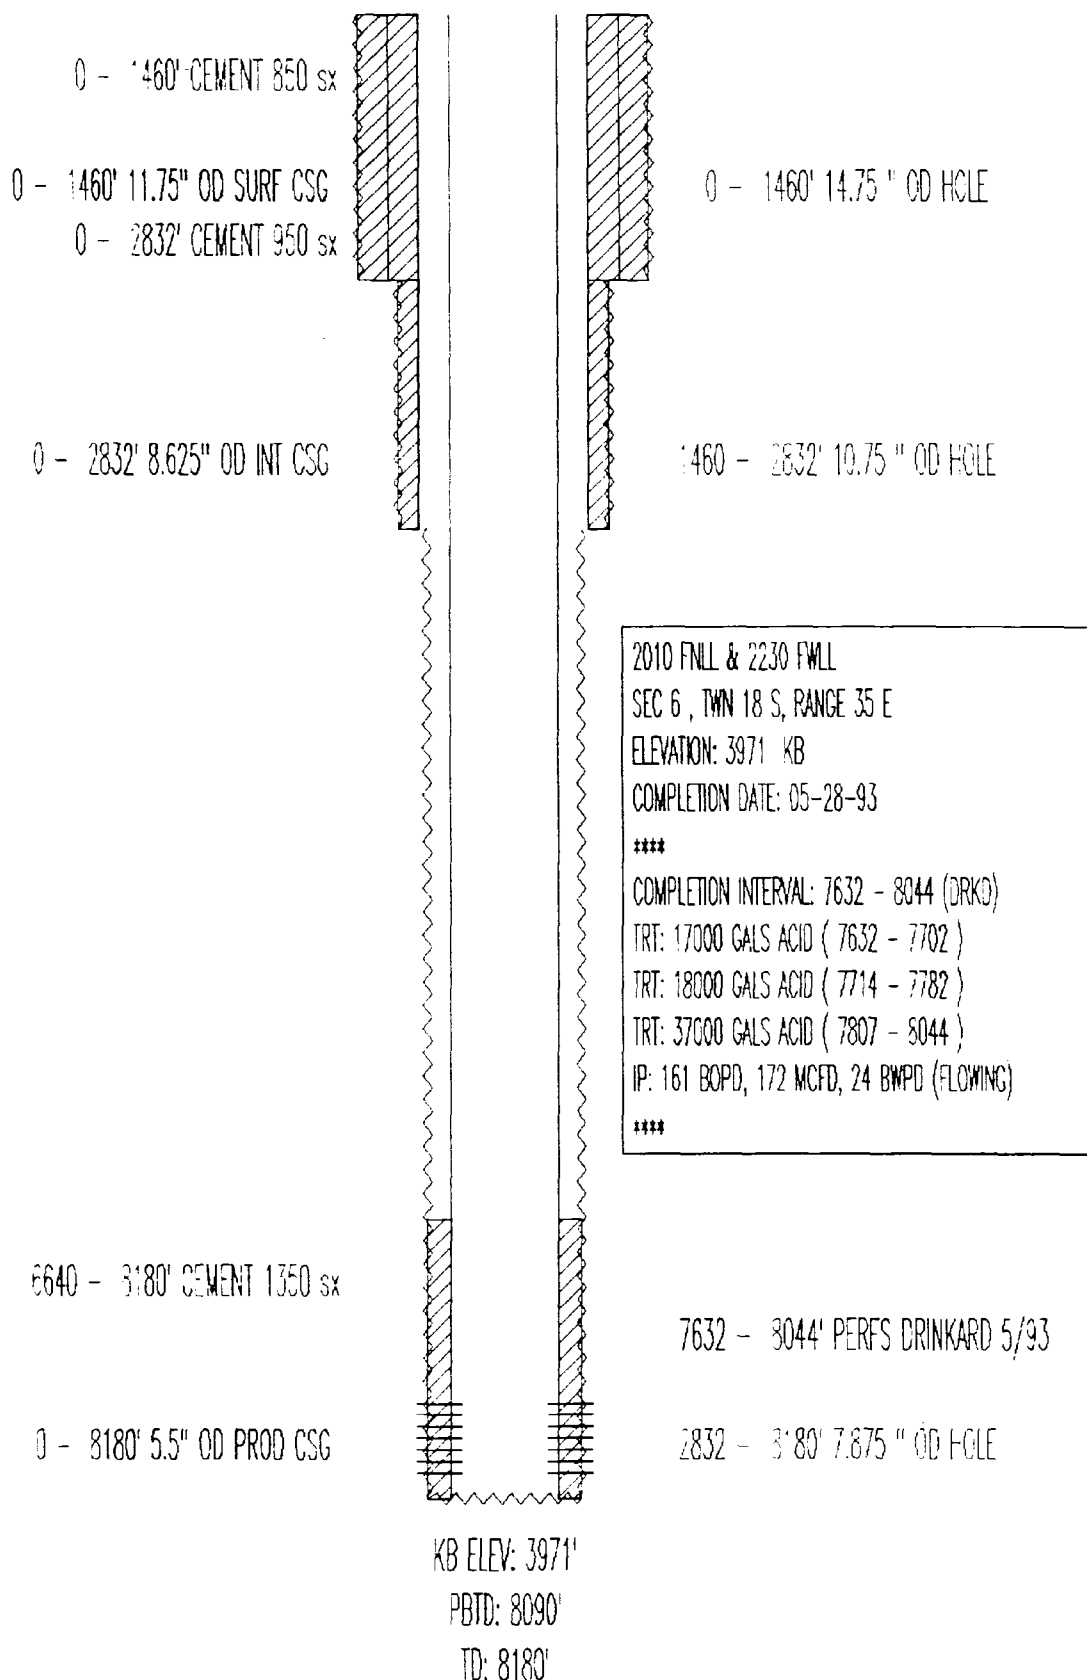

PRODUCING
DRINKARD

MARATHON OIL
WARN STATE A/C-2 NO. 20
API# 3002531934

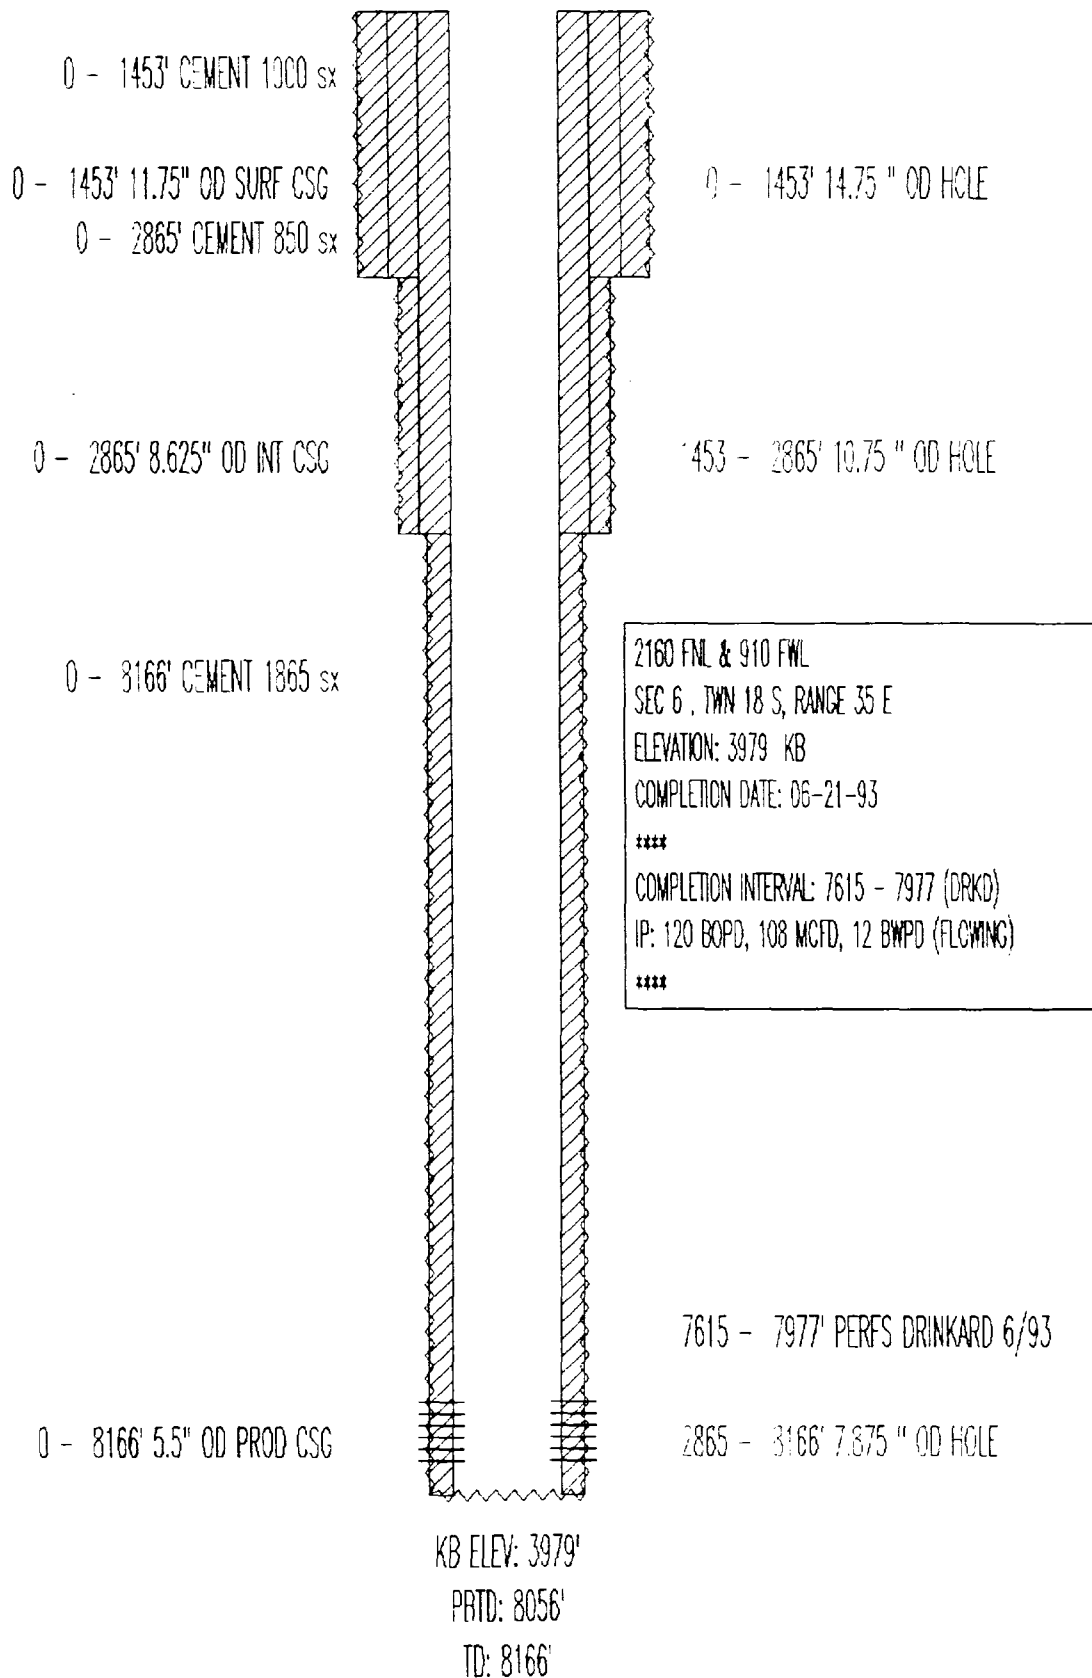

PRODUCING
DRINKARD

MARATHON OIL
WARN STATE A/C-2 NO. 21
API# 3002531969

0 - 53' 16" OD SURF CSG

0 - 53' CEMENT 0 sx

0 - 1465' CEMENT 750 sx

0 - 1465' 11.75" OD INT CSG

0 - 2823' CEMENT 900 sx

0 - 2823' 8.625" OD INT CSG

1050 - 3158' CEMENT 1560 sx

0 - 8158' 5.5" OD PROD CSG

0 - 53' 20" OD HOLE

53 - 1465' 14.75" OD HOLE

1465 - 2823' 10.75" OD HOLE

1109 FNL & 1993 FWL

SEC 6, TWN 18 S, RANGE 35 E

ELEVATION: 3988 KB

COMPLETION DATE: 07-28-93

COMPLETION INTERVAL: 7623 - 7989 (DRKD)

TRT: 29500 GALS ACID (7800 - 7989)

TRT: 19200 GALS ACID (7712 - 7771)

TRT: 15834 GALS ACID (7623 - 7693)

IP: 375 BOPD, 301 MCFD, 62 BWPD (FLOWING)

7623 - 7989' PERFS DRINKARD 7/93

2823 - 8200' 7.875" OD HOLE


KB ELEV: 3988'

PBTD: 8069'

TD: 8200'

PRODUCING
DRINKARD

MARATHON OIL
WARN STATE A/C-2 NO. 22
API# 30025320340000

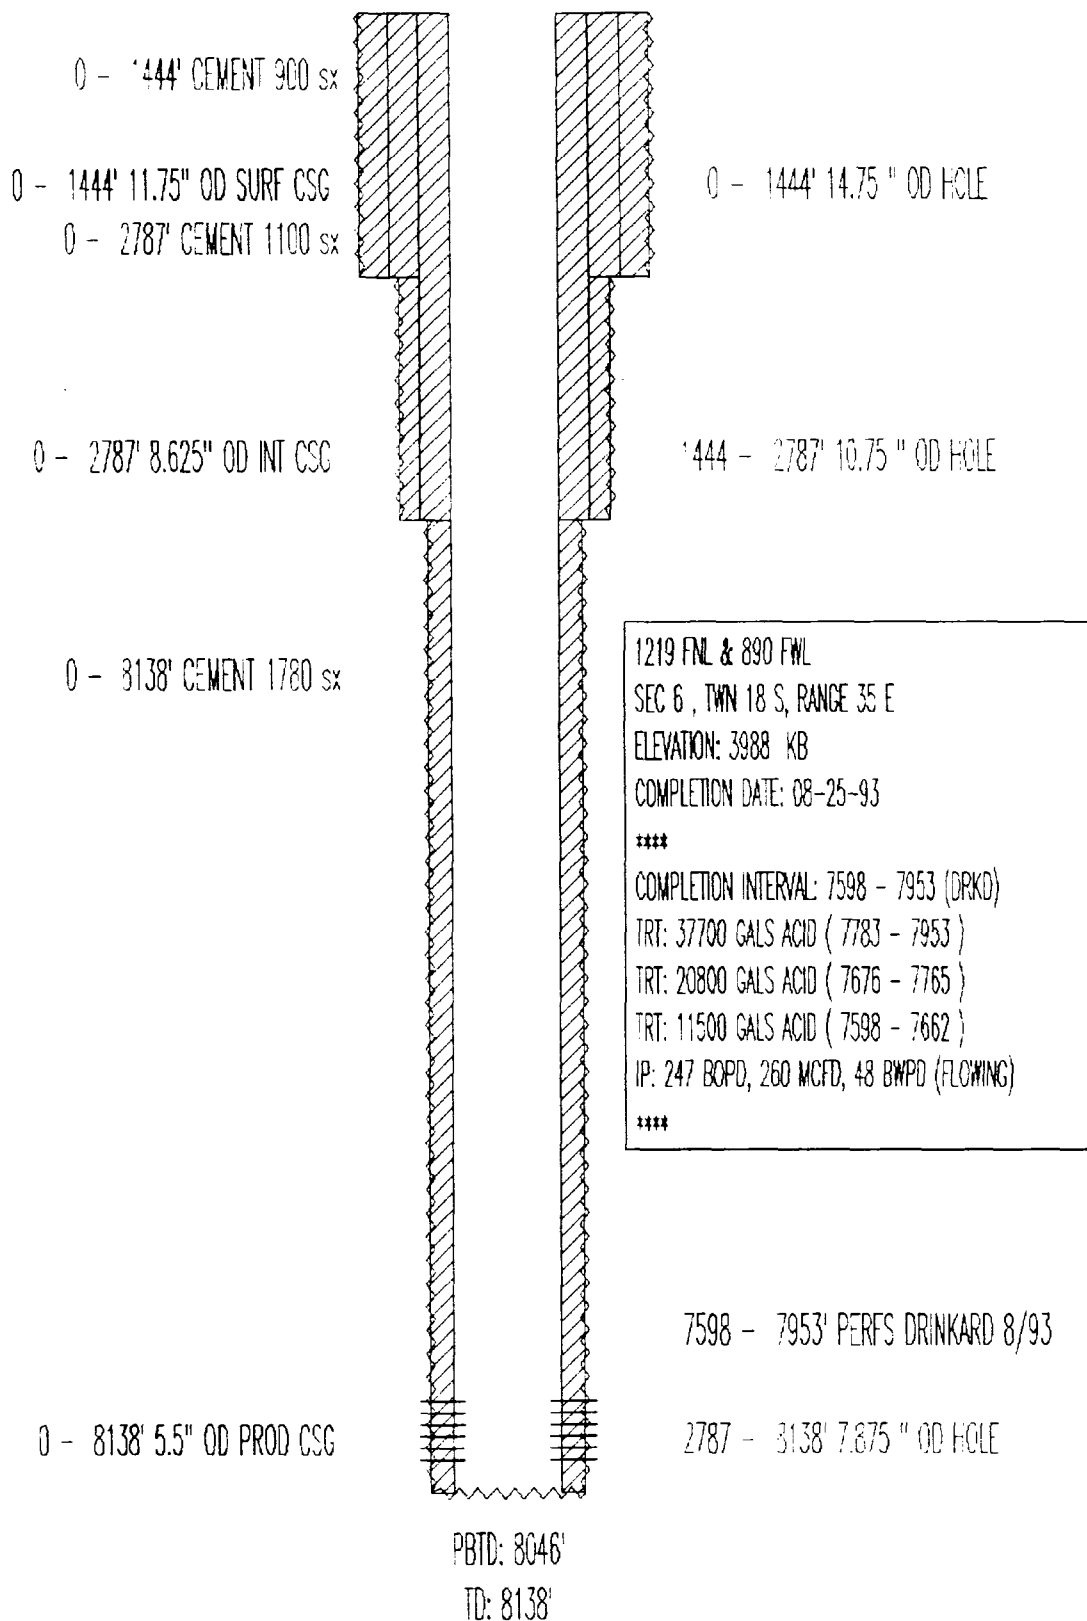

PRODUCING
DRINKARD

MARATHON OIL
WARN STATE A/C-2 NO. 23
API# 3002532187

0 - 40' CEMENT 0 sx
0 - 40' 16" OD SURF CSG

0 - 40' 20" OD HOLE

0 - 1477' CEMENT 800 sx
0 - 1477' 11.75" OD INT CSG
0 - 2836' CEMENT 800 sx

40 - 1477' 14.75" OD HOLE

0 - 2836' 8.625" OD INT CSG

1477 - 2836' 10.75" OD HOLE

2920 - 3300' CEMENT 1550 sx

990 FSL & 1920 FWL
SEC 6 , TWN 18 S, RANGE 35 E
ELEVATION: 3993 KB
COMPLETION DATE: 12-15-93

COMPLETION INTERVAL: 7747 - 8030 (DRKO)
TRT: 40000 GALS ACID (7870 - 8030)
TRT: 17500 GALS ACID (7747 - 7844)
IP: 235 BOPD, 239 MCFD, 177 BHPD (PUMPING)

0 - 8300' 5.5" OD PROD CSG


7747 - 8030' PERFS DRINKARD 12/93

2836 - 3300' 7.875" OD HOLE

KB ELEV: 3993'
PBTD: 8205'
TD: 8300'

PRODUCING
DRINKARD


MARATHON OIL
WARN STATE A/C-2 NO. 24
API# 3002532189

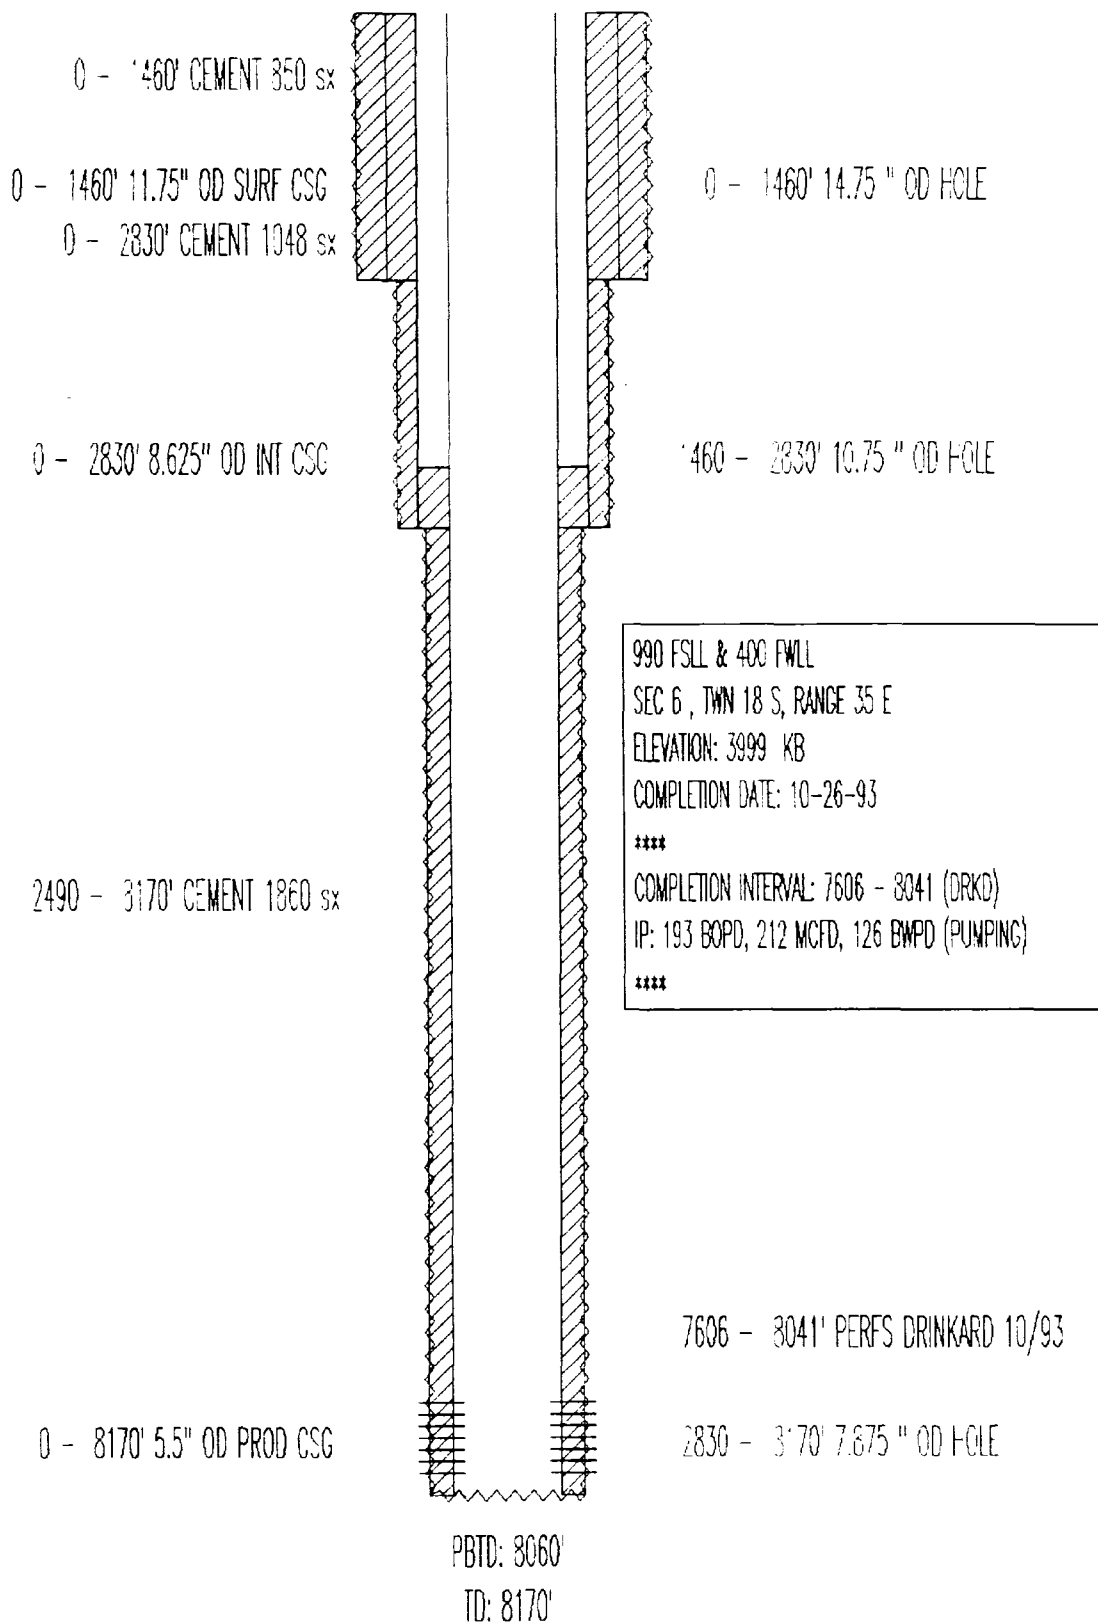

SHUT IN
SAN ANDRES

TEXACO INC
CENTRAL VACUUM UNIT NO. 124
API# 3002503099


FORMERLY
N. M. "R" ST. NCT-4 NO. 1

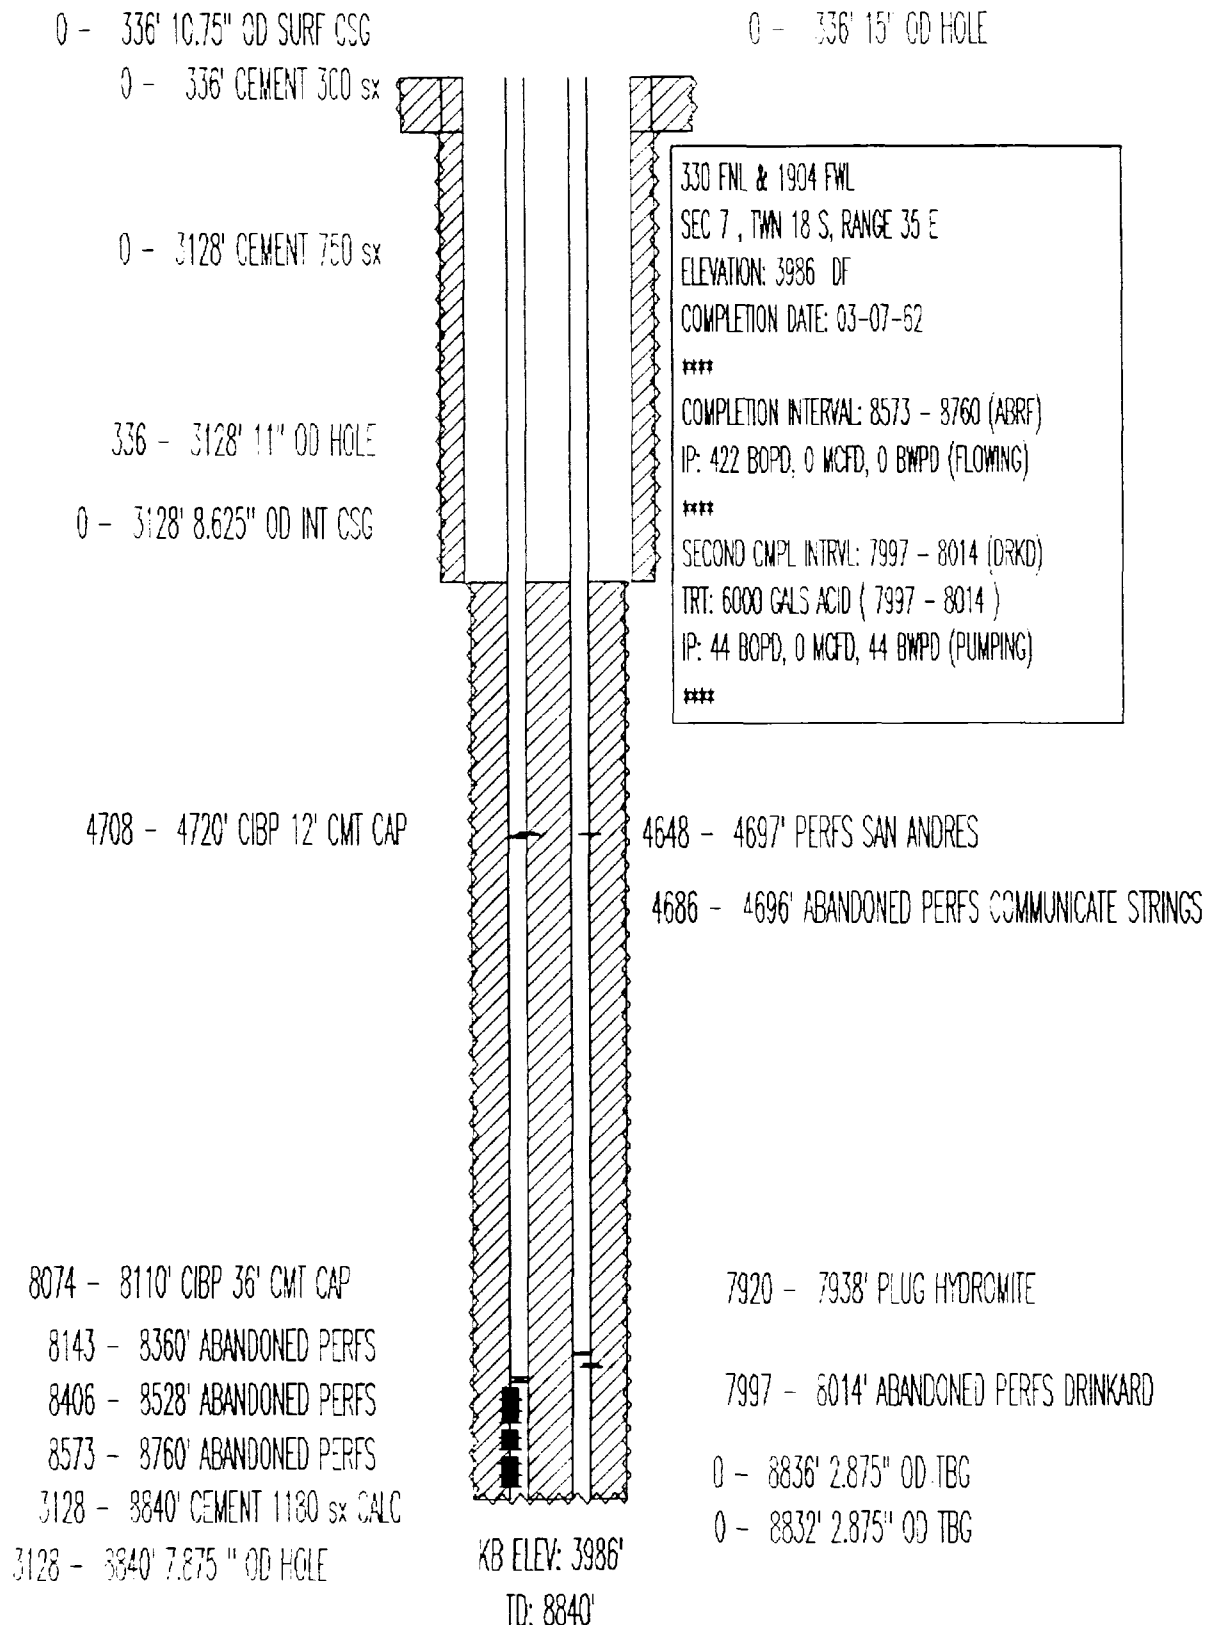

SHUT IN
SAN ANDRES

TEXACO INC
CENTRAL VACUUM UNIT NO. 125
API# 3002503100

FORMERLY
N. M. "R" NCT-4 NO. 2

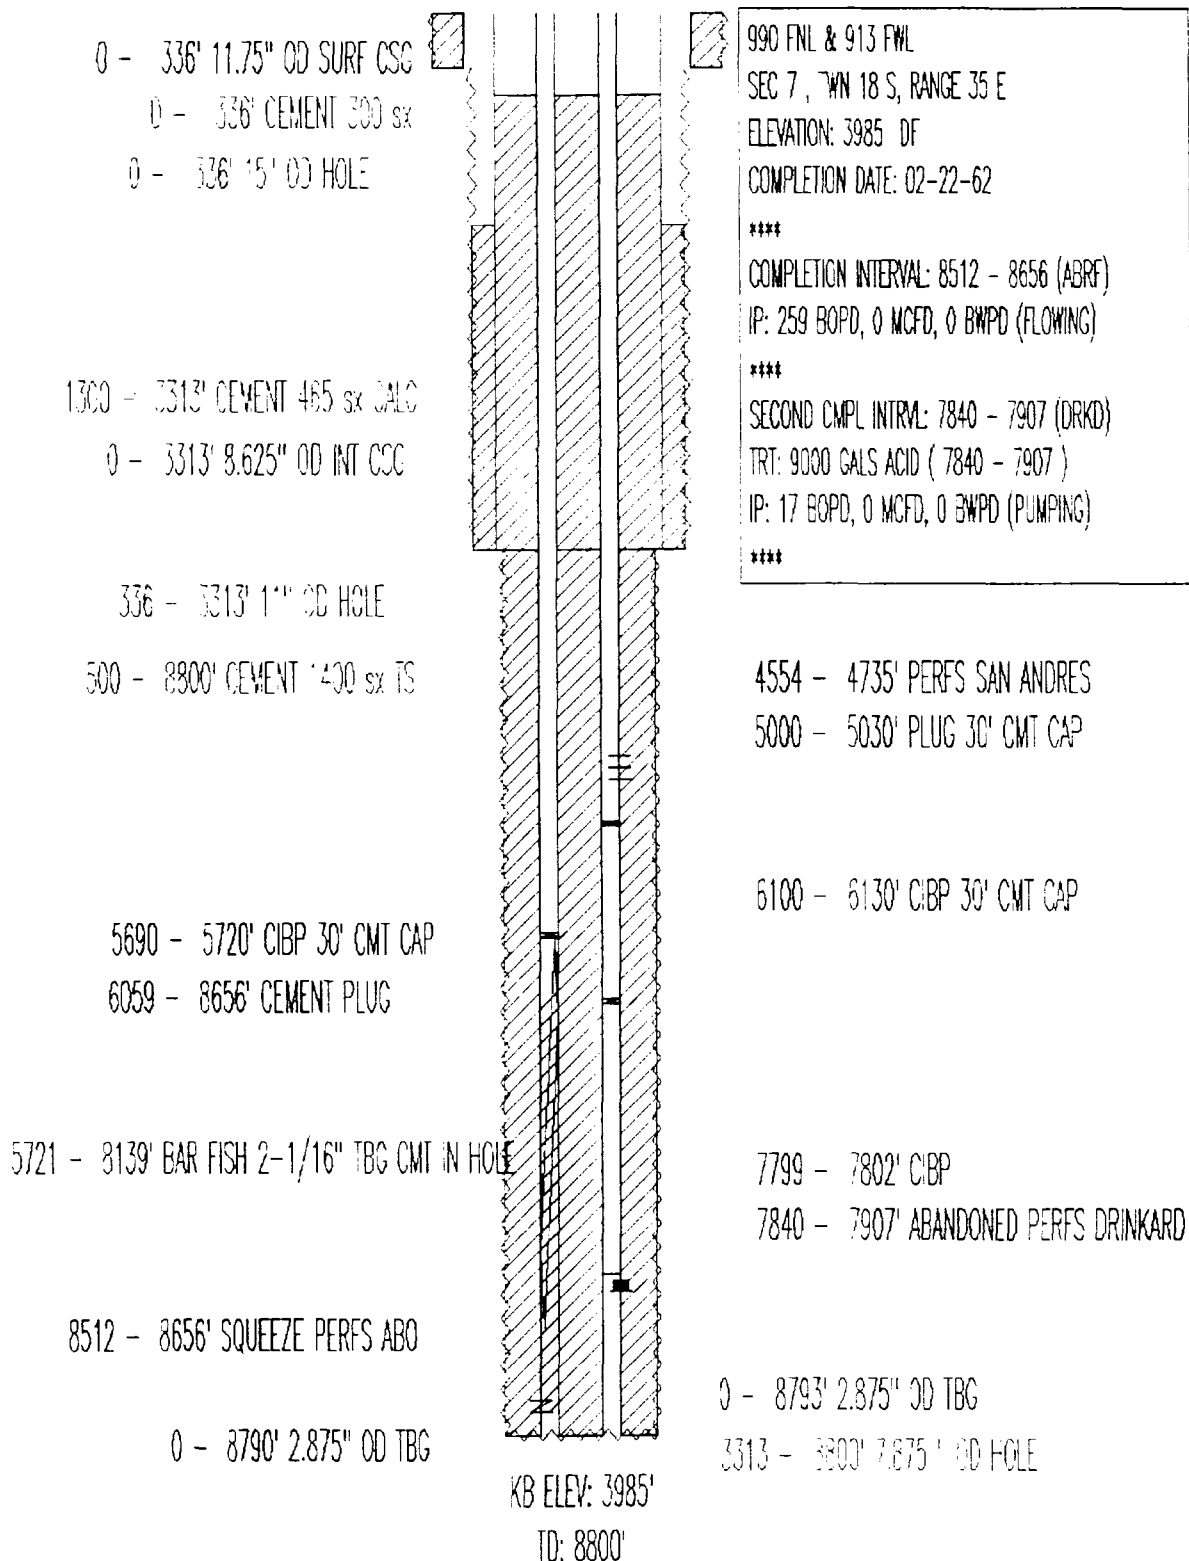

FORMERLY N. M. "O" ST. NO. 25

TEXACO INC
VGWU NO. 87
API# 3002521637

PRODUCING
GLORIETA

0 - 1499' CEMENT 1300 sx
0 - 1800' CEMENT BRDHD SGZ W/600 SX -TS
0 - 1499' 11.75" OD SURF CSG

0 - 1499' 15" CD HOLE

2090 FSL & 2086 FELL
SEC 36 , TWN 17 S, RANGE 34 E
ELEVATION: 4001 DF
COMPLETION DATE: 01-23-66

COMPLETION INTERVAL: 10088 - 10164 (PSLV)
TRT: 12000 GALS ACID (10088 - 10164)
IP: 75 BOPD, 0 MCFD, 75 BWPD (S)

2400 - 4825' CEMENT 1100 sx CALC

0 - 4825' 8.625" OD INT CSG

1499 - 4825' 10.625" OD HOLE

6185 - 6205' CIBP 15' CMT CAP

5930 - 6160' PERFS GLORIETA 3/71, 10/72, 7/87

4100 - 10200' CEMENT 1050 sx CALC

0 - 10200' 4.5" OD PROD CSG

4825 - 10200' 7.875 " CD HOLE


10088 - 10164' ABANDONED PERFS

TD: 10200'

PRODUCING
GLORIETA

TEXACO
VACUUM GLORIETA WEST UNIT #90
API# 3002520270


FORMERLY
SANTA FE BATTERY 2 NO. 87
PHILLIPS PETROLEUM

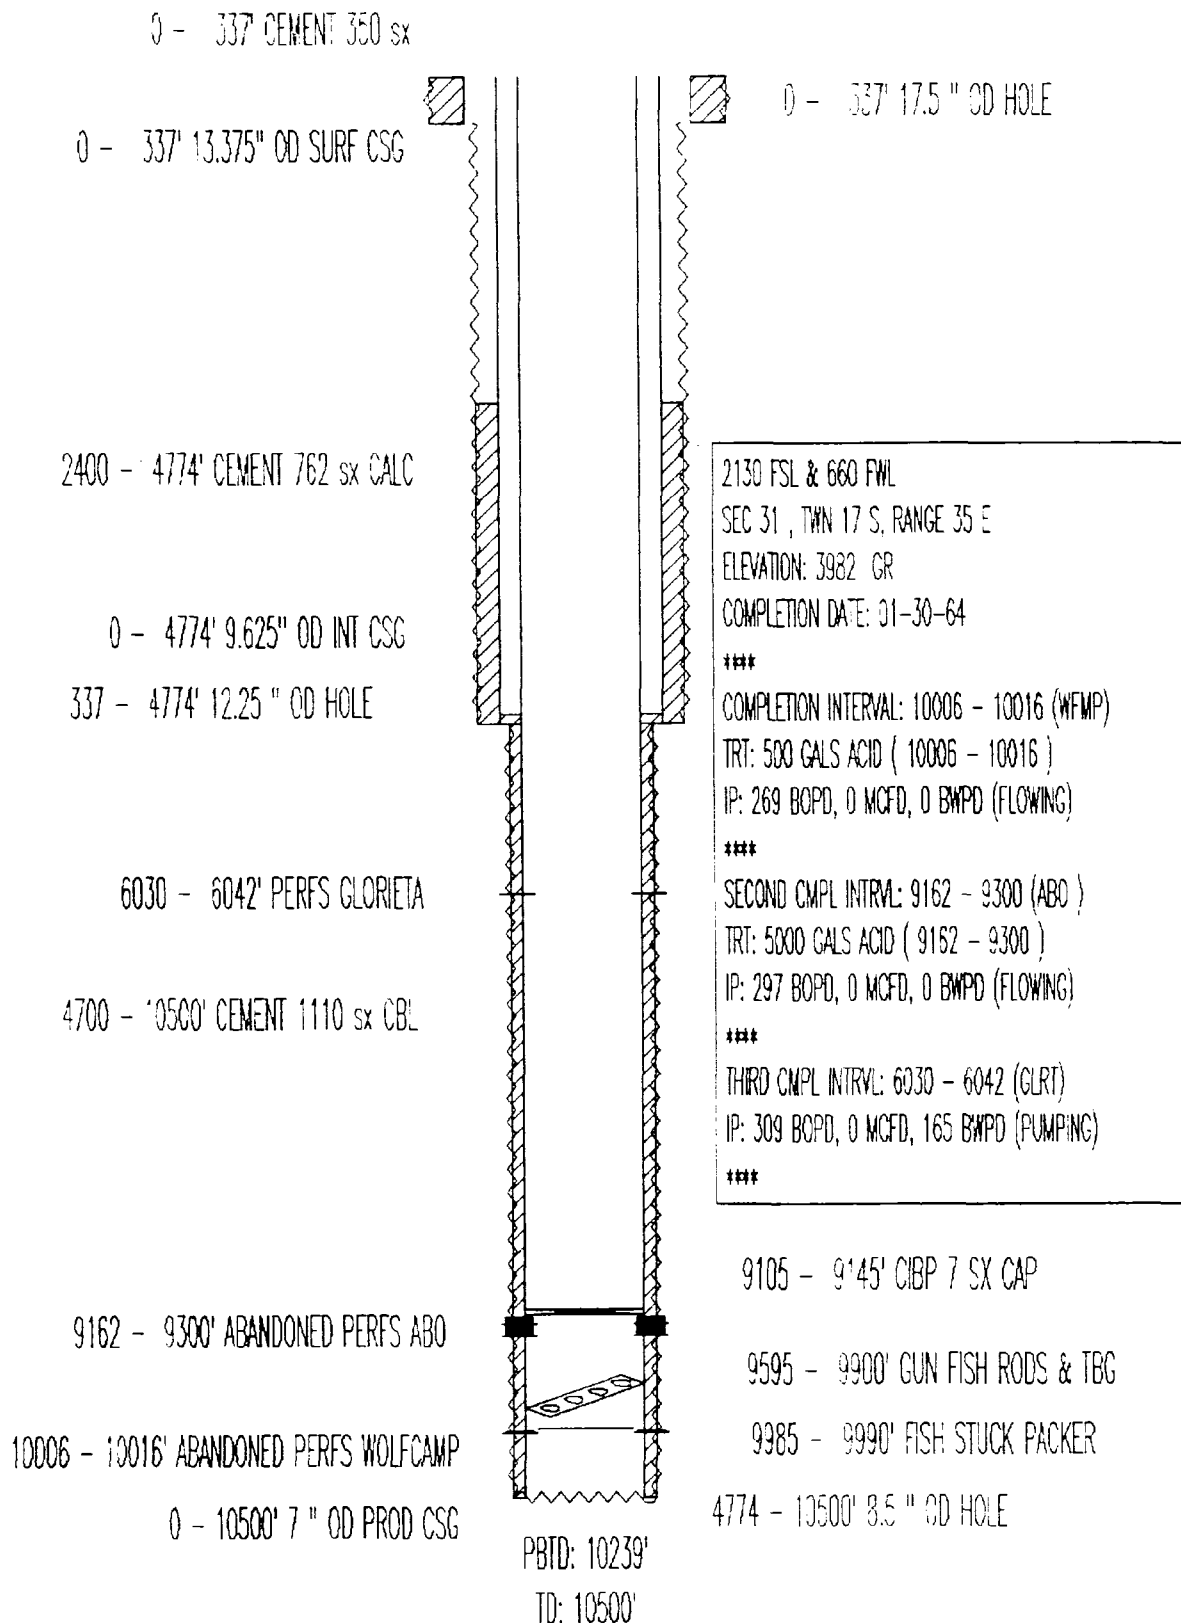

FORMERLY N. M. "M" ST. NO. 5

TEXACO INC
VGWU NO. 112
API# 3002520515

PRODUCING
GLORIETA

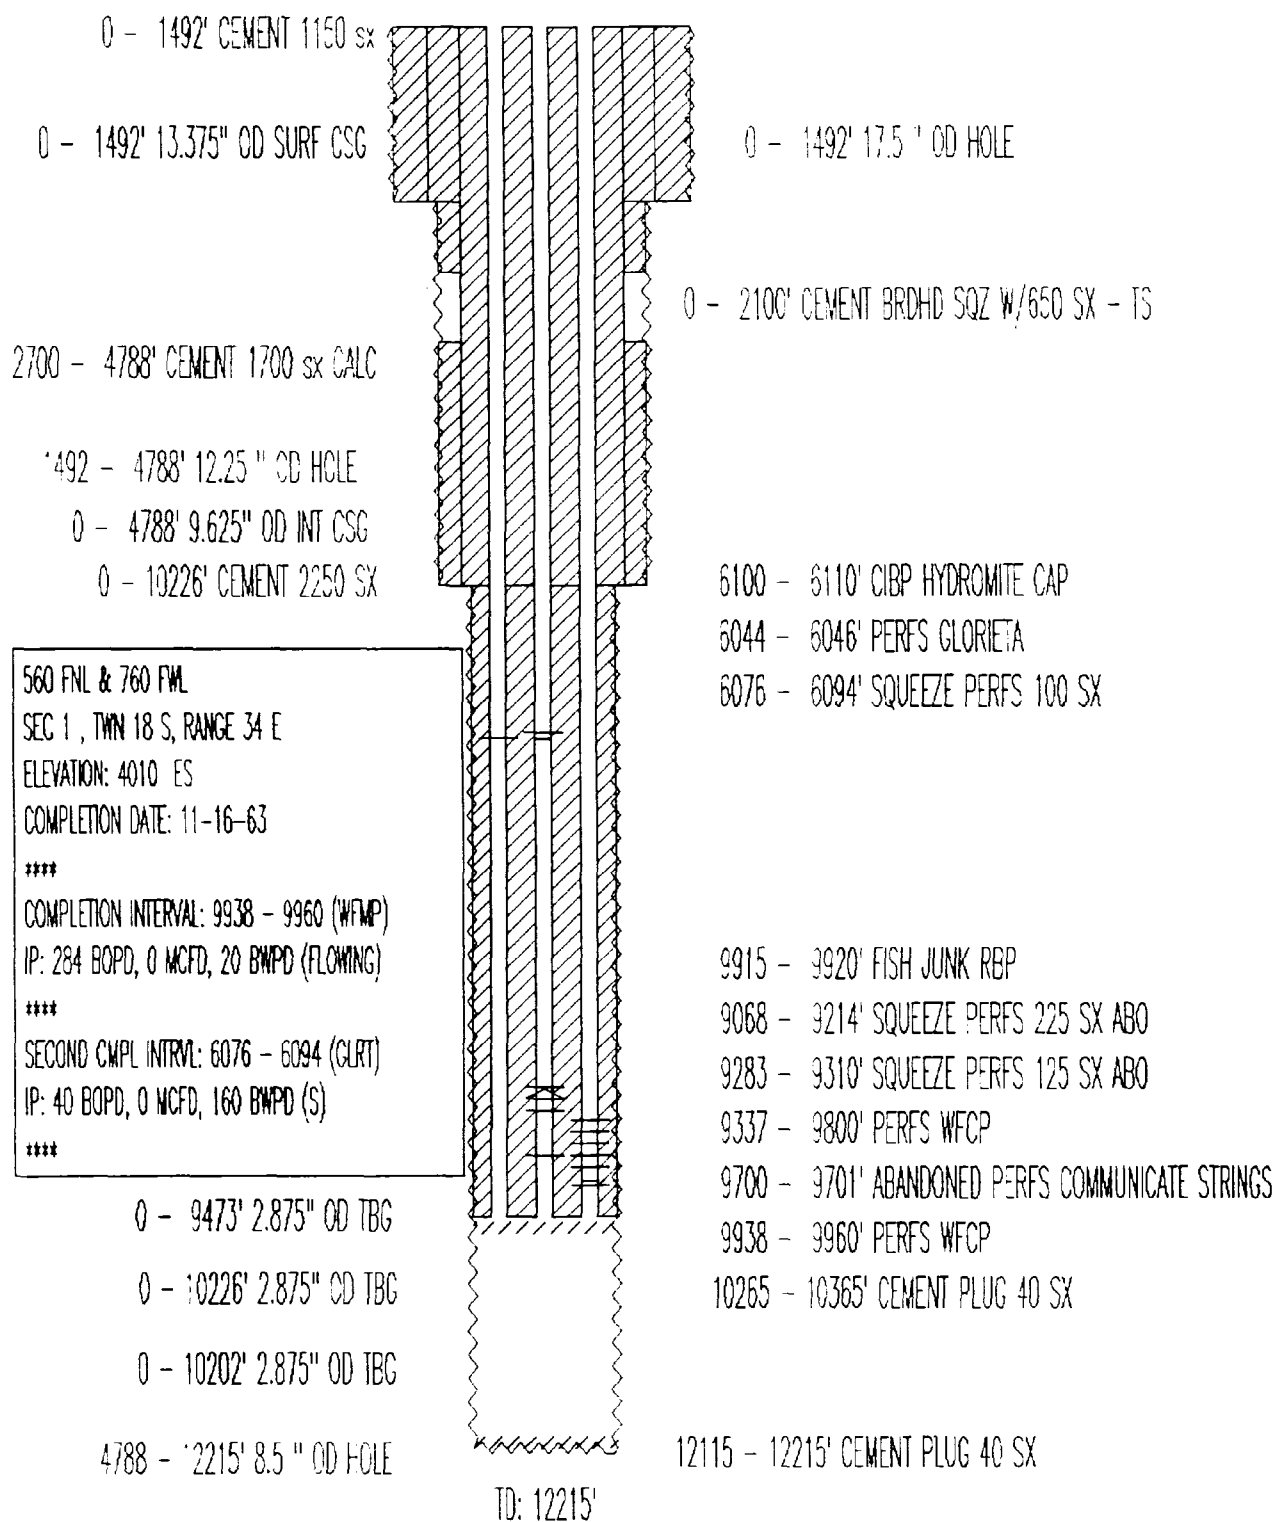

P & A

TEXACO INC
VGS AU NO. 68
API# 3002521110

FORMERLY
N. M. "R" NCT-3 NO. 16

- 0 - 402' 11.75" OD SURF CSG
- 0 - 402' CEMENT 350 SX
- 0 - 400' CEMENT
- 0 - 3250' CEMENT 1650 SX
- 400 - 3260' CEMENT SQZ 900 SX

- 0 - 3250' 8.625" OD INT CSG


1655 FSL & 330 FEL
SEC 1, T11N 18 S, RANGE 34 E
ELEVATION: 3996 ES
COMPLETION DATE: 10-09-64

COMPLETION INTERVAL: 8472 - 8572 (ABO)
TRT: FRAC 15000 GALS 0 LBS (8472 - 8572)
IP: 29 BOPD, 0 MCFD, 0 BWPD (S)

- 3235 - 8800' CEMENT 1600 SX CBL

- 0 - 8800' 2.875" OD TBG
- 3250 - 8800' 7.875" OD HOLE

TD: 8800'

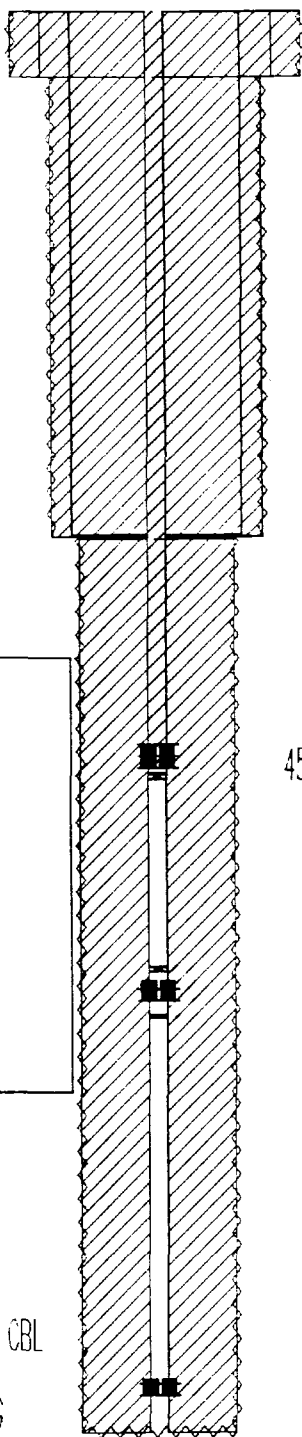

- 0 - 402' 14.75" OD HOLE
- 400 - 400' SQUEEZE PERFS CIRC W/120 SX
- 0 - 4686' CEMENT PLUG

- 402 - 3250' 10.75" OD HOLE
- 3260 - 3260' SQUEEZE PERFS

- 4720 - 4755' CIBP 35' CMT CAP


- 4536 - 4686' ABANDONED PERFS SQZD W/ 170 SX

- 5999 - 6125' ABANDONED PERFS
- 5915 - 5950' CIBP 35' CMT CAP
- 6215 - 6235' CIBP 35' CMT CAP

- 8472 - 8572' ABANDONED PERFS


SHUT IN
WOLFCAMP & GLORIETA

TEXACO INC
NEW MEXICO "L" STATE NO. 6
API# 3002520514

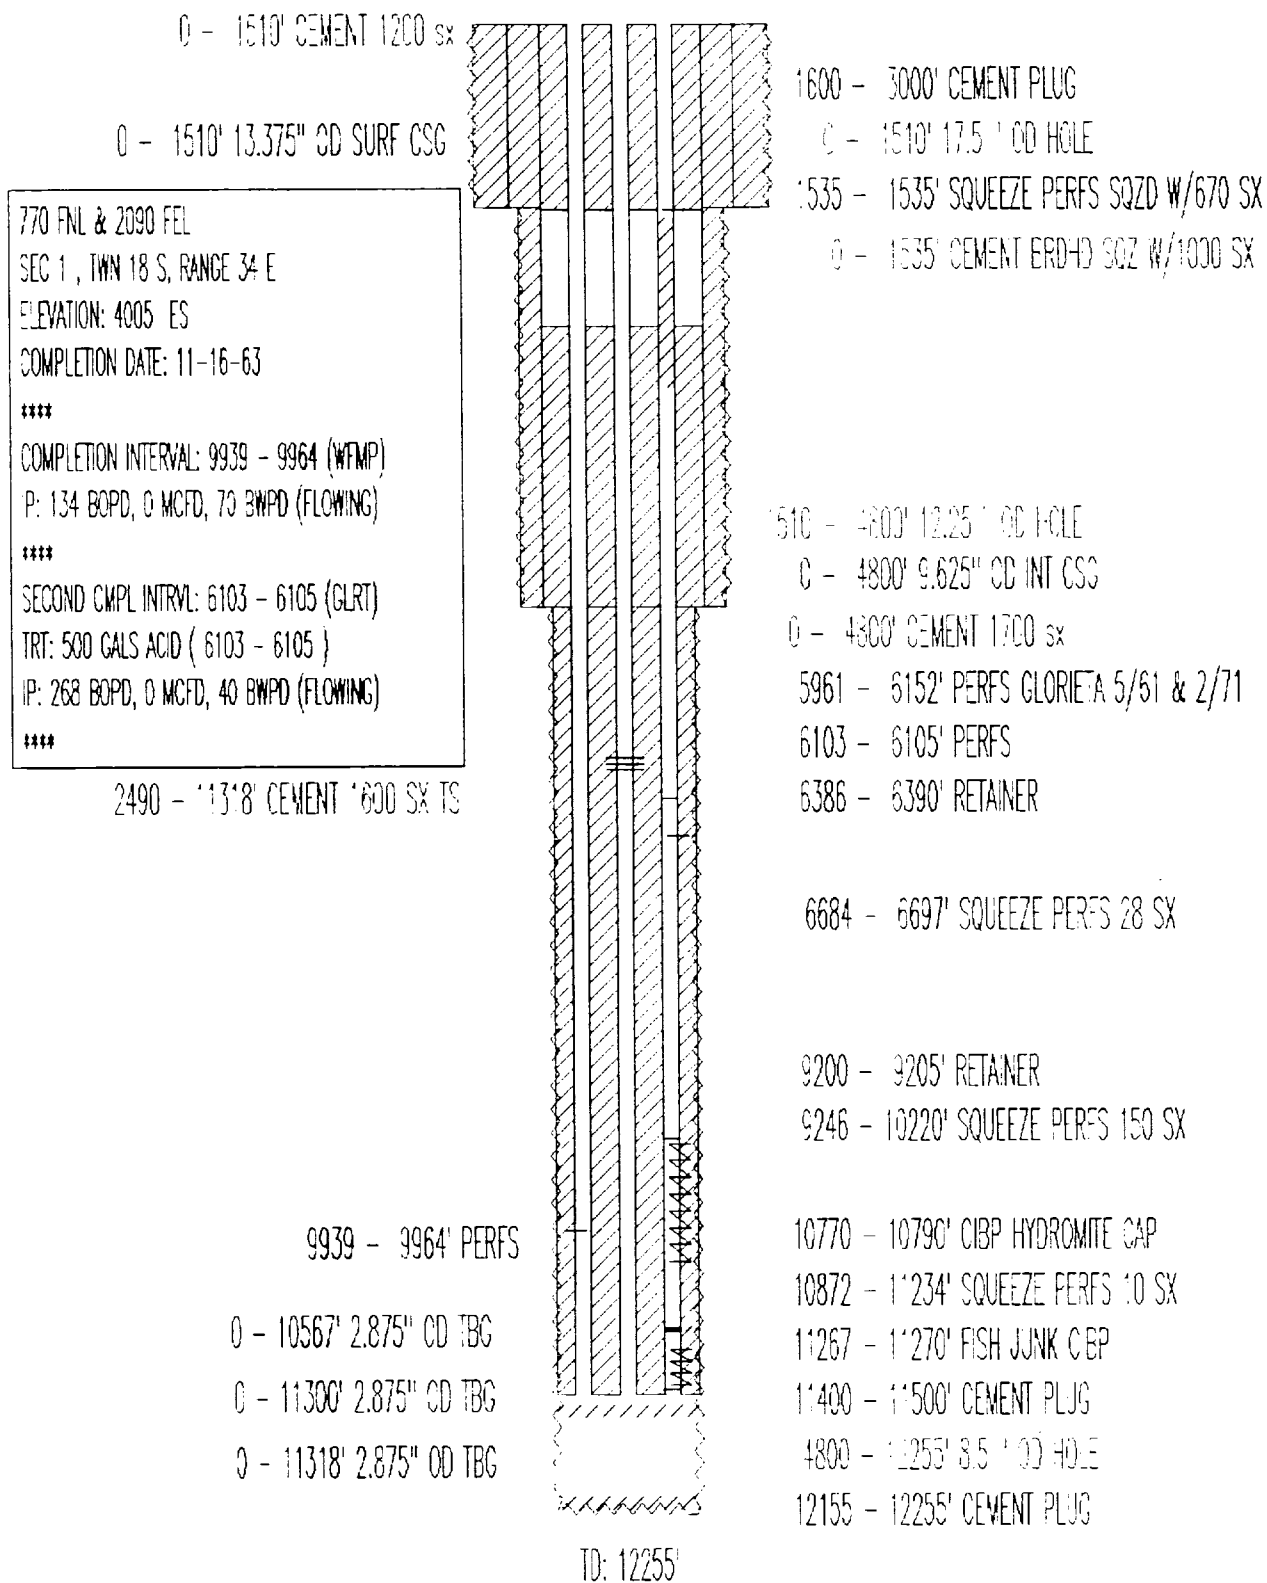


PRODUCING
DRINKARD

TEXACO EXPL & PROD
NEW MEXICO "L" STATE NO. 12
API# 3002531992

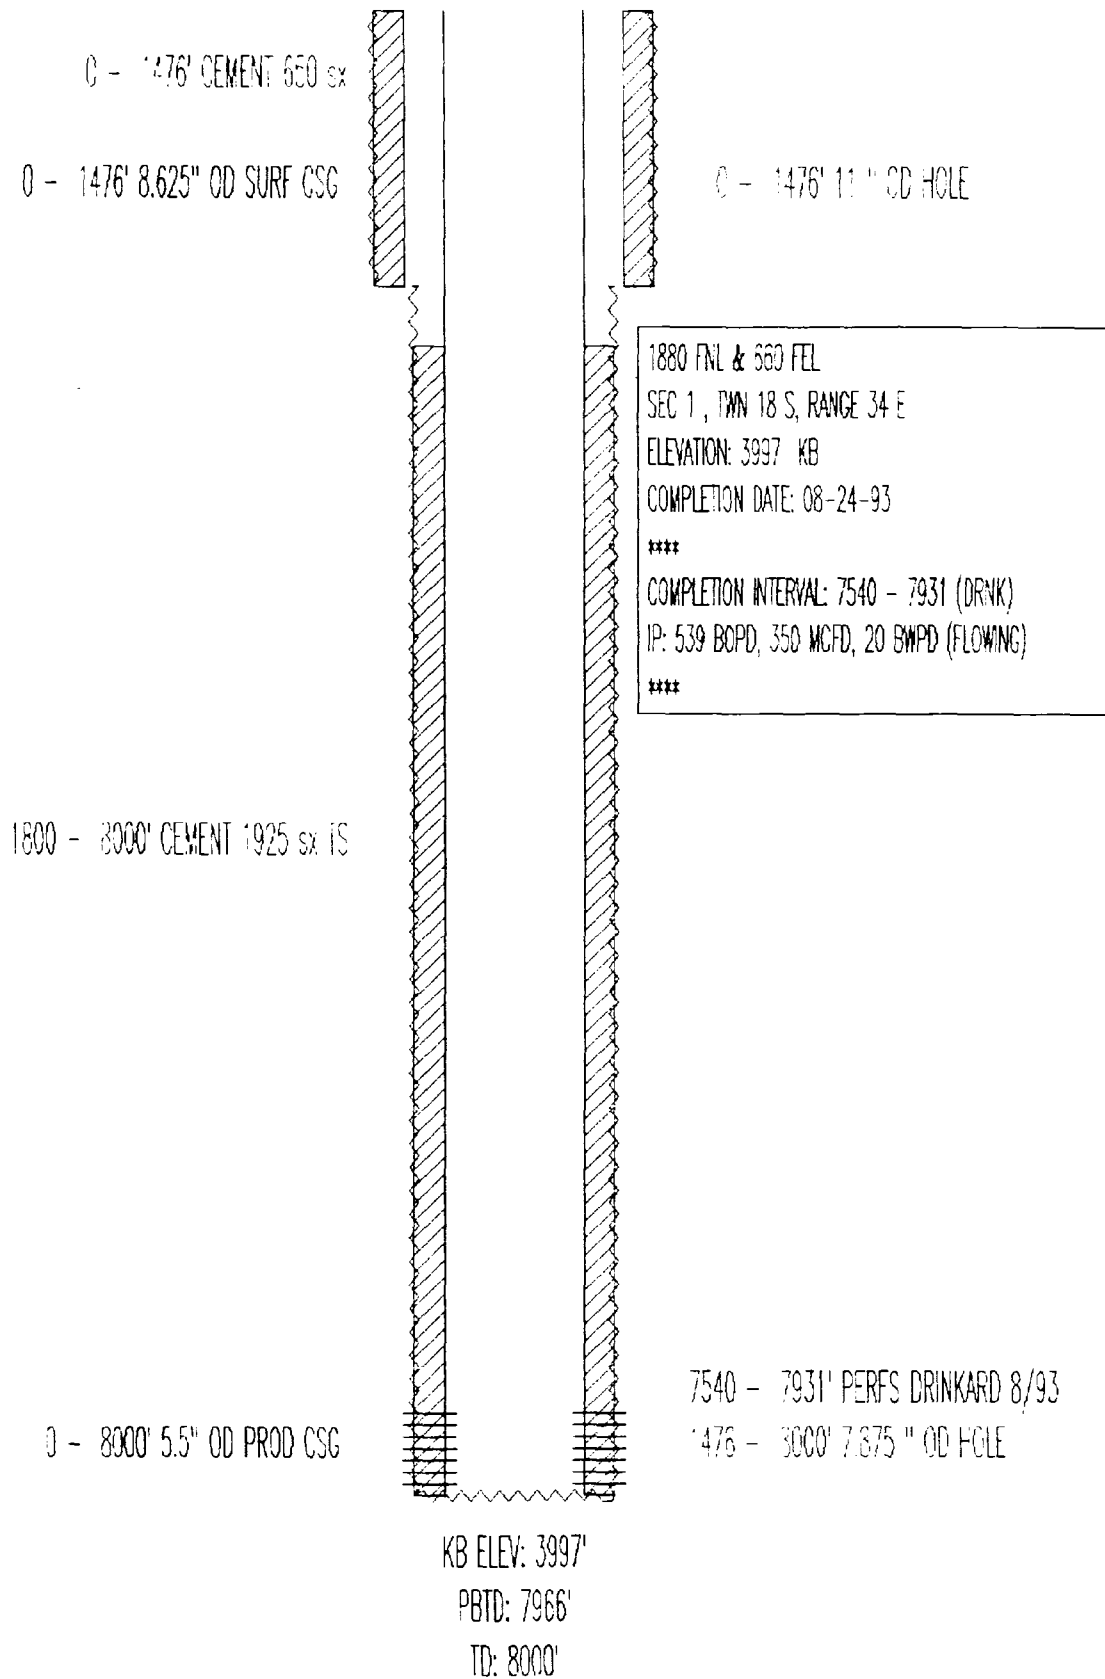


PRODUCING
DRINKARD

TEXACO EXPL & PROD
NEW MEXICO "L" STATE NO. 13
API# 3002532007

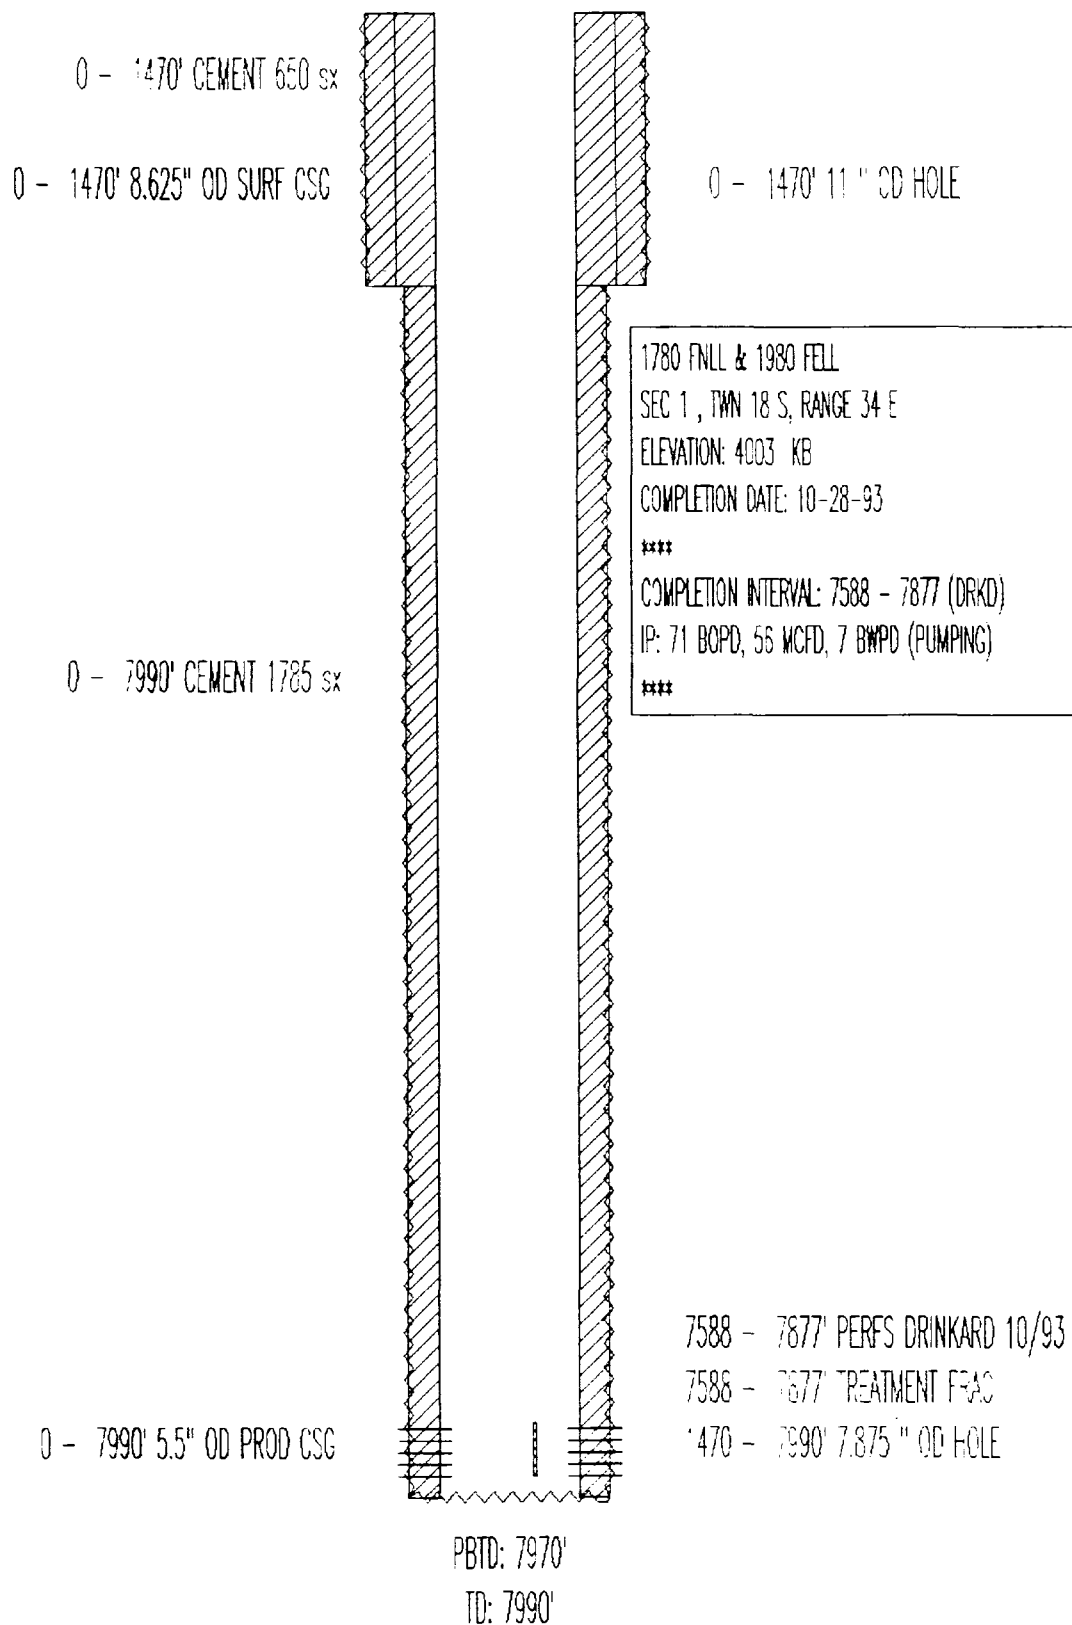


PRODUCING
DRINKARD

TEXACO EXPL & PROD
NEW MEXICO "L" STATE NO. 14
API# 3002532008

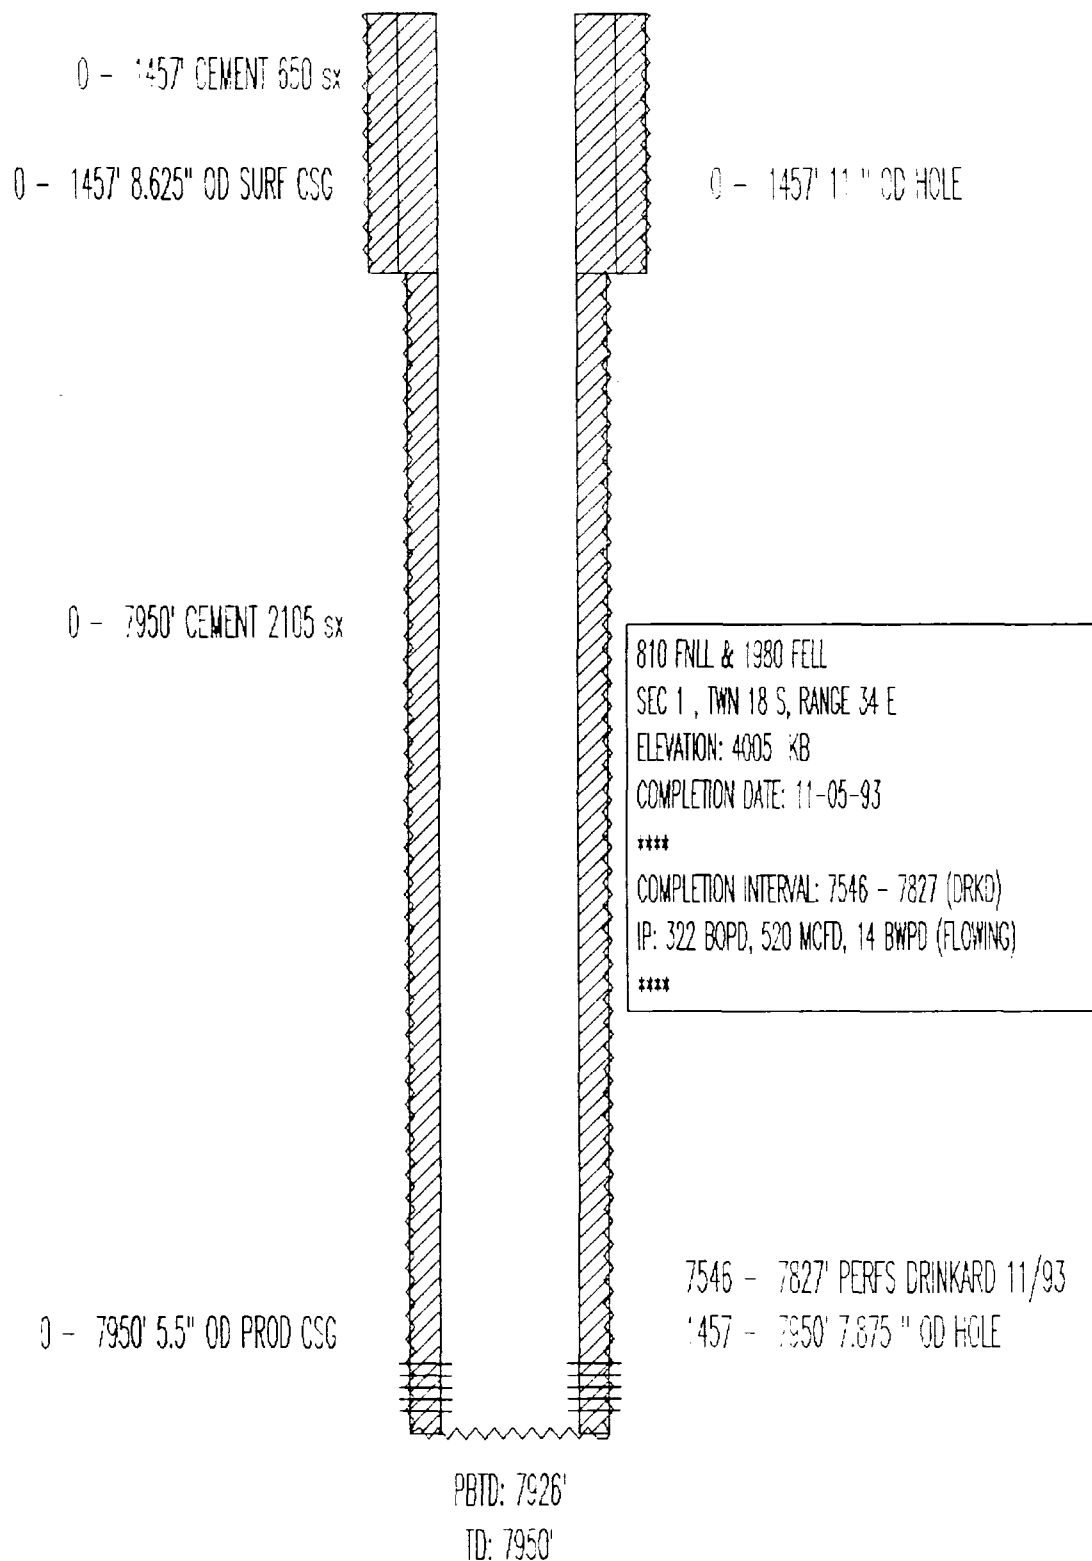


PRODUCING
DRINKARD

TEXACO EXPL & PROD
NEW MEXICO "L" STATE NO. 15
API# 3002532009

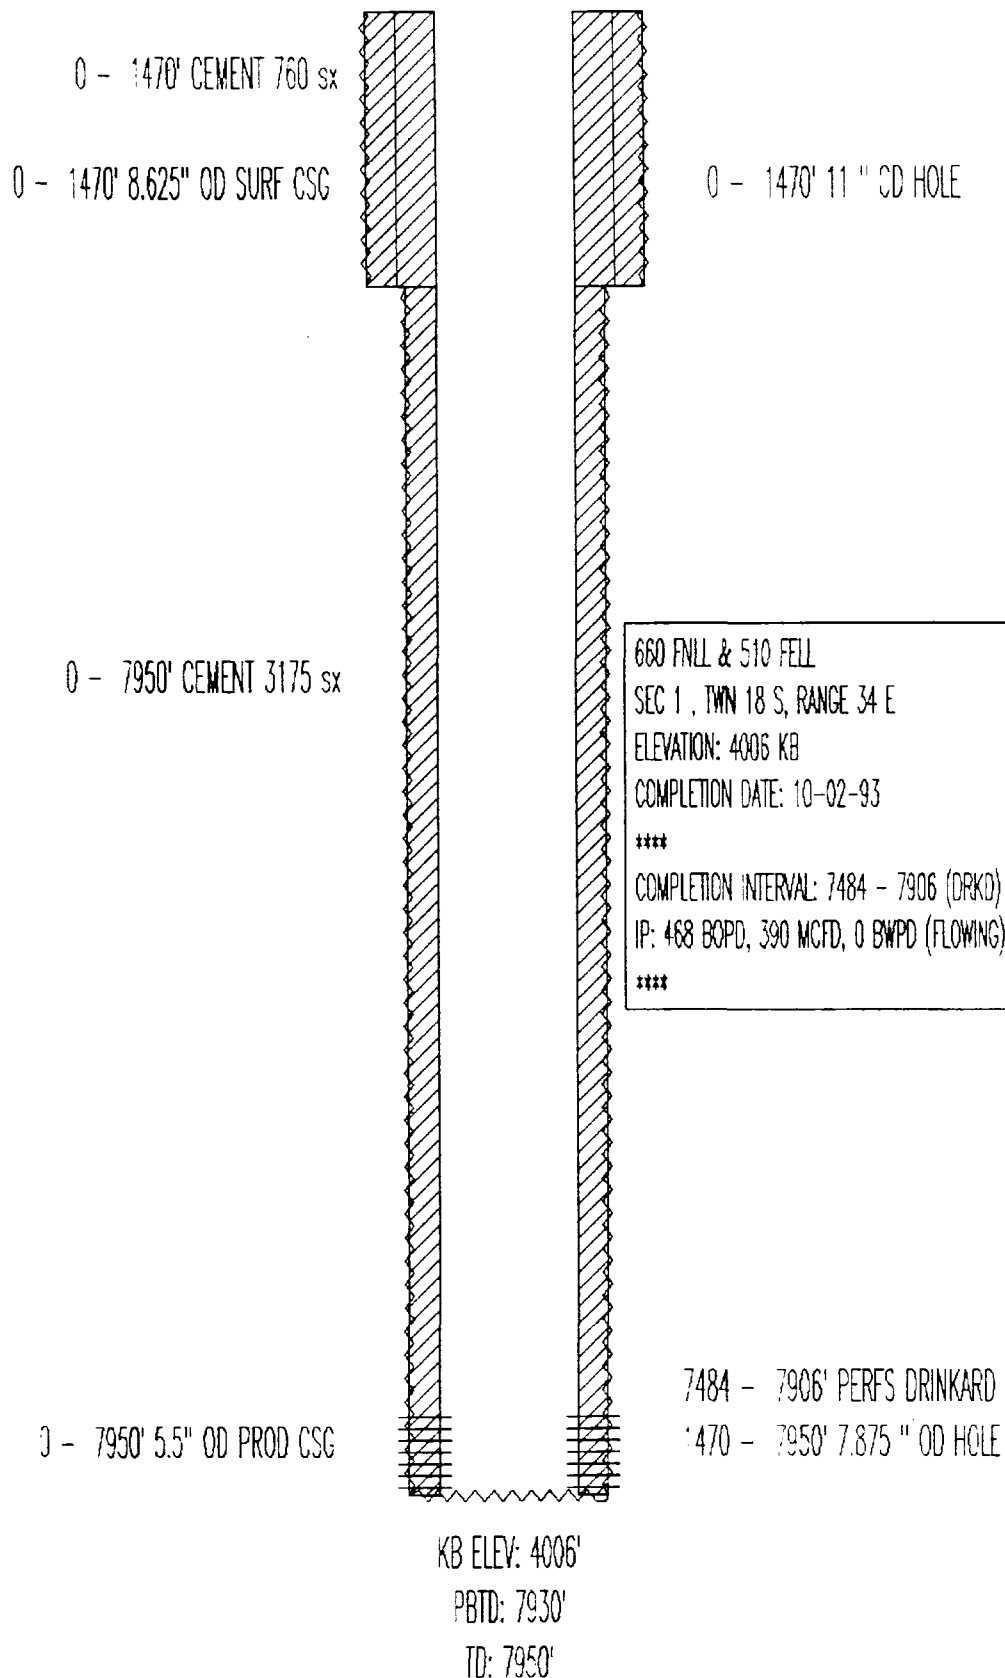


PRODUCING
DRINKARD

TEXACO INC
NEW MEXICO "M" ST. NO. 7
API# 3002520494

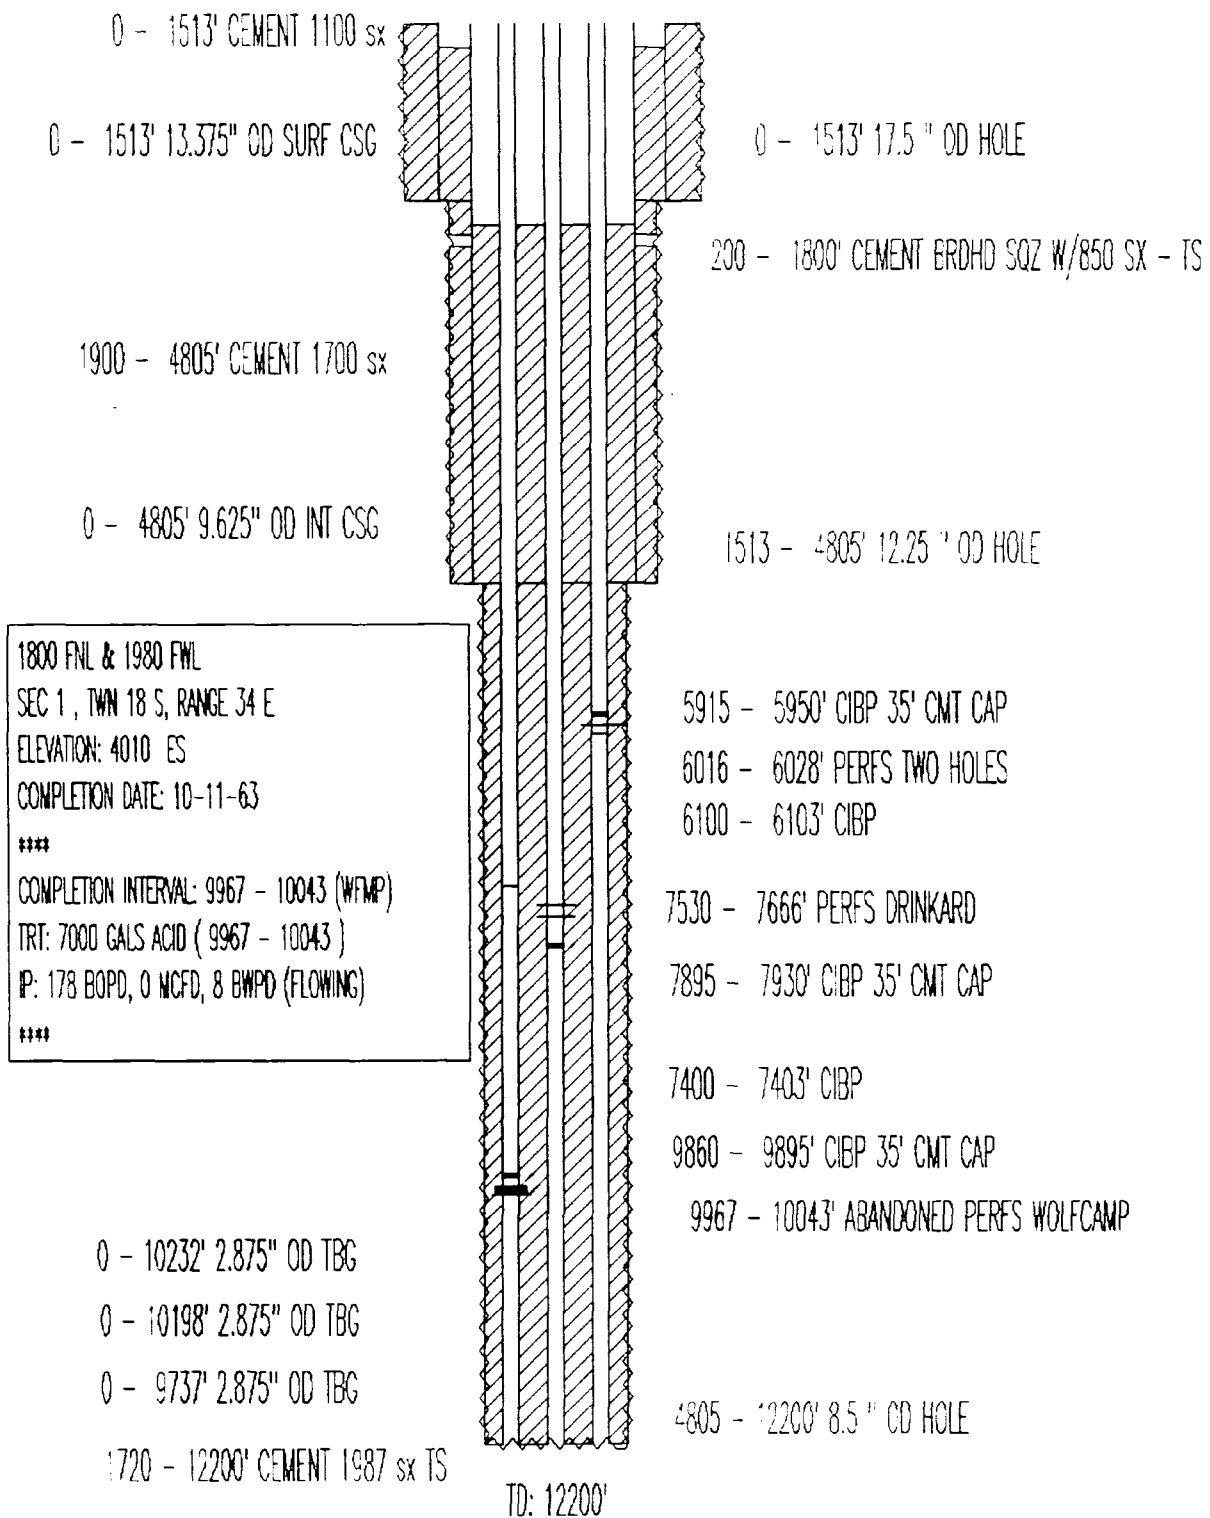

TEXACO EXPL & PROD
NEW MEXICO "M" STATE NO. 9
API# 3002532016

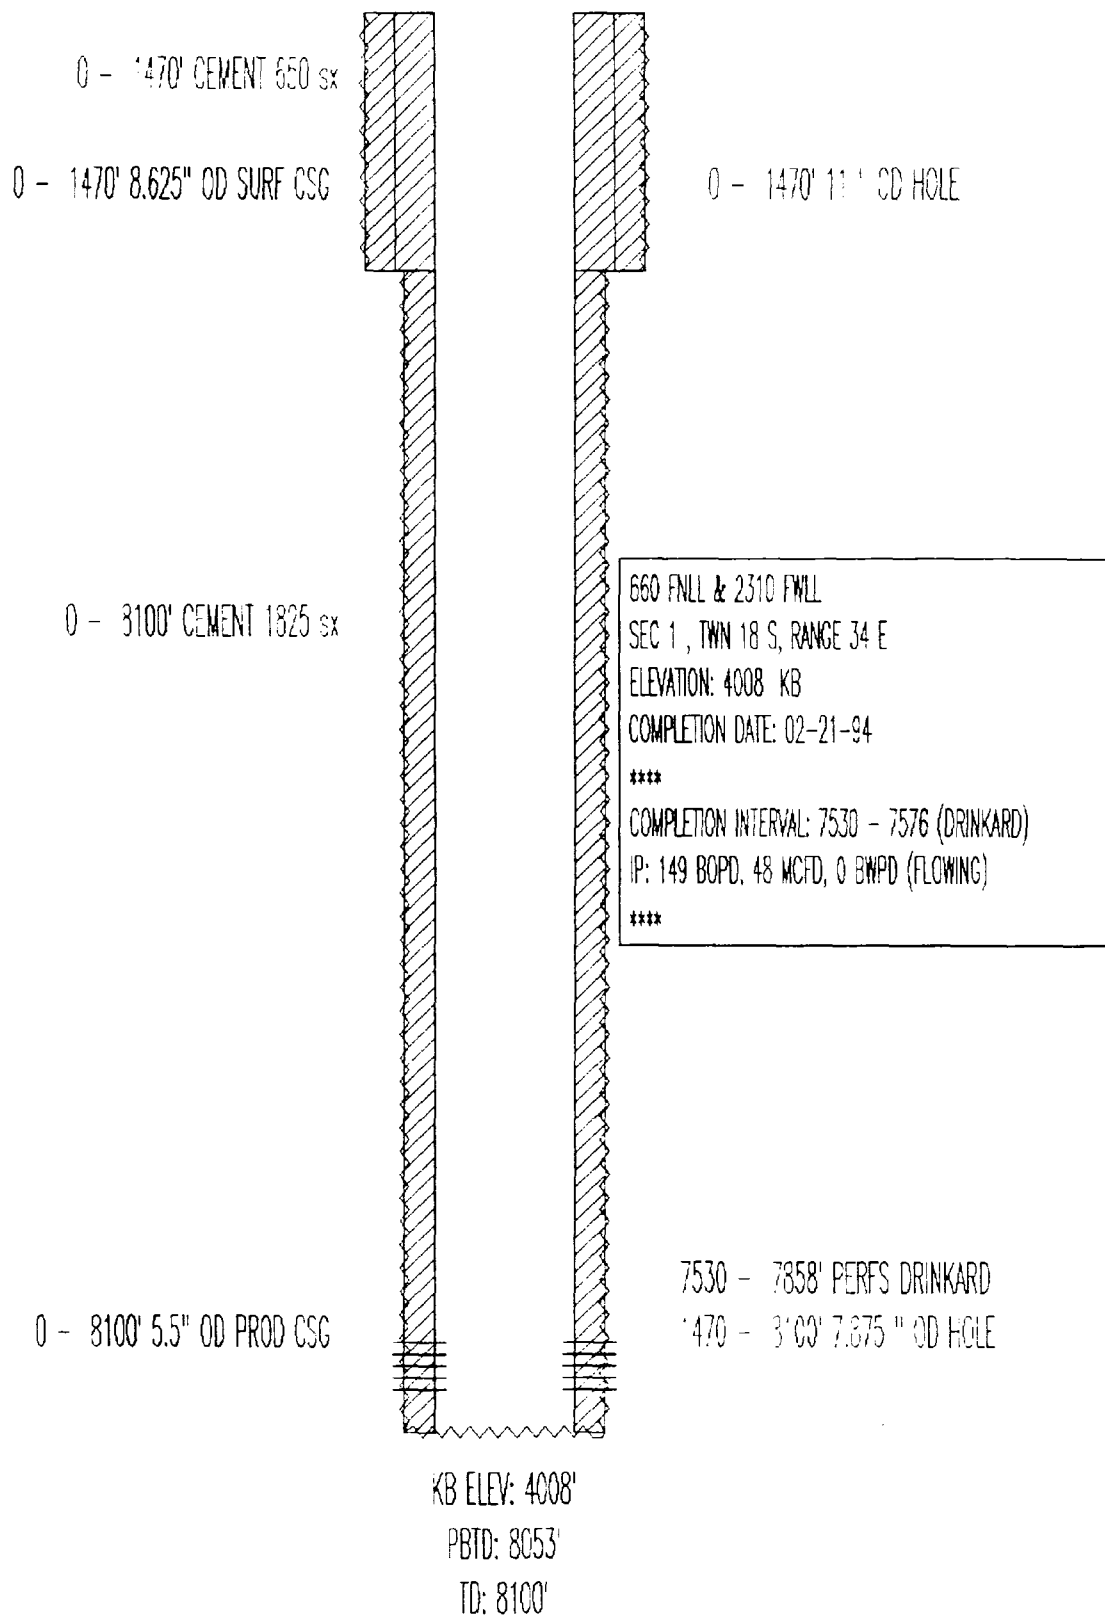

TEXACO INC
NEW MEXICO "O" ST. NCT-1 NO. 14
API# 3002520008

0 - 1593' CEMENT 1200 sx
0 - 2000' CEMENT ERDHD SQZ W/800SX -TS
0 - 1593' 13.375" OD SURF CSG
0 - 1593' 17.5" OD HOLE

2545 - 4825' CEMENT 1700 sx CALC

0 - 4825' 9.625" OD INT CSG

1593 - 4825' 12.25" OD HOLE

1874 FSL & 2086 FEL
SEC 36, TWN 17 S, RANGE 34 E
ELEVATION: 3992 GR
COMPLETION DATE: 07-26-63

COMPLETION INTERVAL: 9954 - 10036 (WFMP)
IP: 402 BOPD, 0 MCFD, 21 BWPD (FLOWING)

SECOND CMPL INTRVL: 9170 - 9254 (ABO)
TRT: 1000 GALS ACID (9170 - 9254)
IP: 238 BOPD, 0 MCFD, 0 BWPD (FLOWING)

6649 - 6682' ABANDONED PERFS

9170 - 9254' PERFS

9954 - 10036' PERFS

10344 - 10462' ABANDONED PERFS

9254 - 9260' PERFS COMMUNICATE STRINGS

10331 - 10336' PERFS COMMUNICATE STRINGS

11202 - 11270' ABANDONED PERFS

12114 - 12122' SQUEEZE PERFS 50 SX

5270 - 12154' CEMENT 1250 sx CBL

0 - 12152' 3.5" OD TBG


0 - 10818' 2.875" OD TBG

4825 - 12154' 8.75" OD HOLE

0 - 10816' 2.875" OD TBG


TD: 12154'

TEXACO E & P INC.
N.M. "O" ST. NCT-1 NO. 17
API# 3002520125

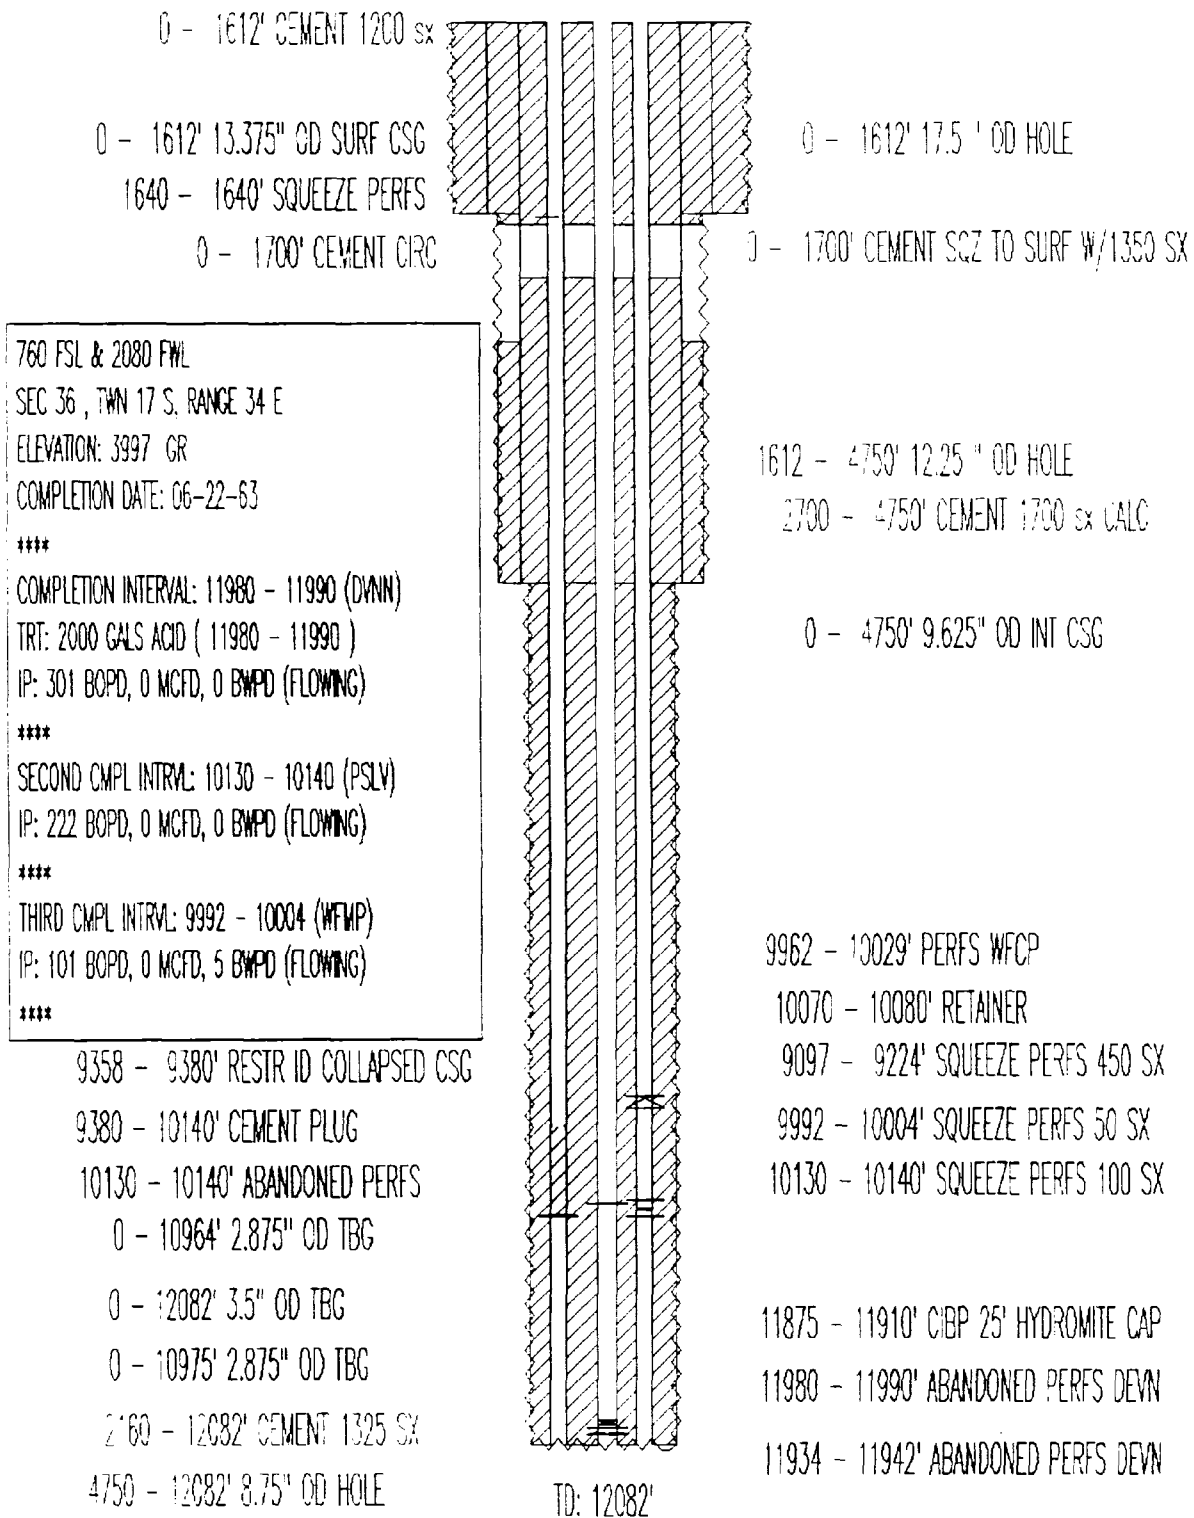

SHUT IN
GLORIETA

TEXACO INC
NEW MEXICO "O" STATE NO. 24
API# 3002520946

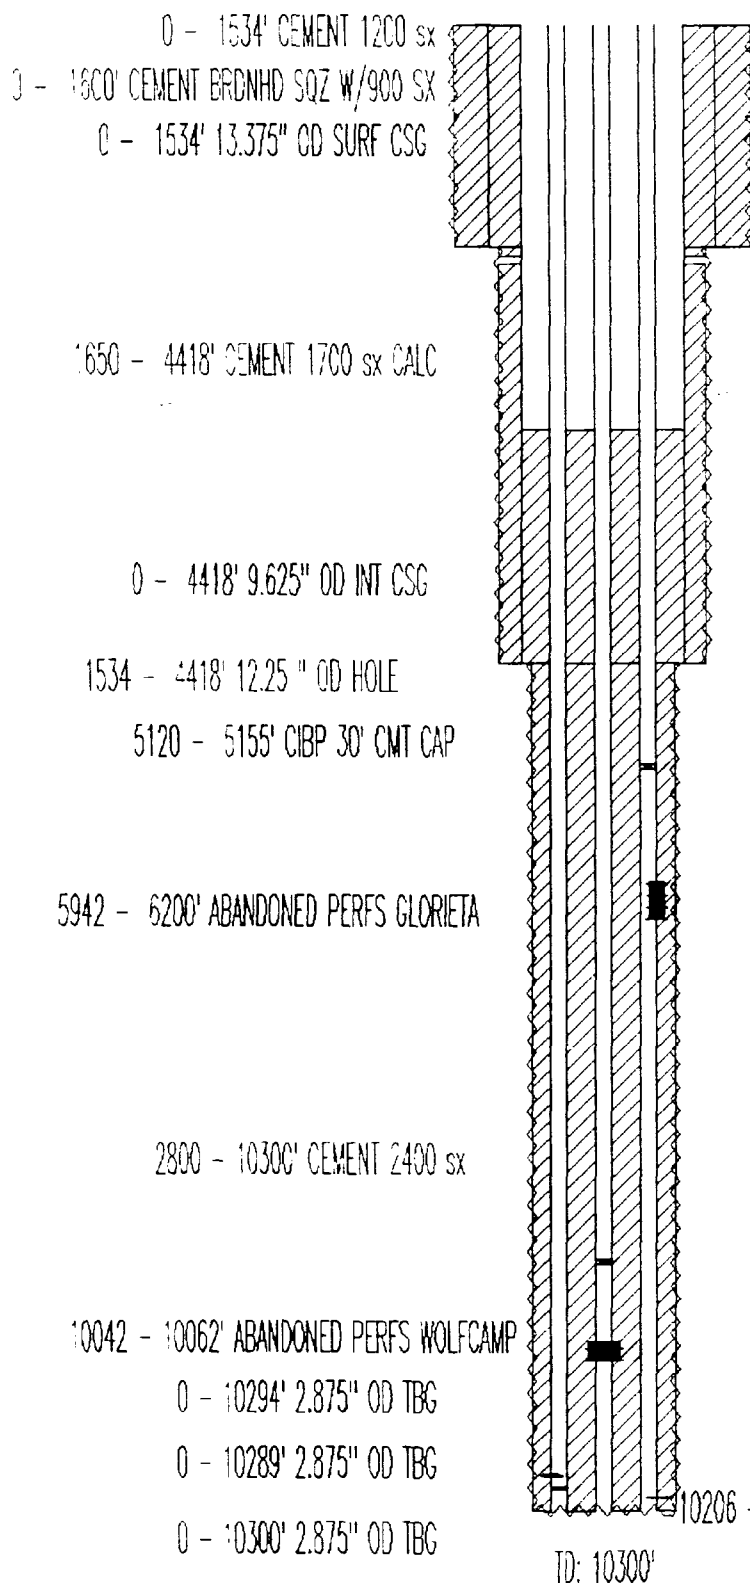

0 - 1534' 17.5" OD HOLE

860 FSL & 660 FEL
SEC 36 , T1N 17 S, RANGE 34 E
ELEVATION: 3995 KB
COMPLETION DATE: 07-04-64

COMPLETION INTERVAL: 10042 - 10062 (WFMP)
TRF: 2000 GALS ACID (10042 - 10062)
IP: 89 BOPD, 0 MCFD, 22 BWPD (S)

SECOND CMPL INTRVL: 9133 - 9263 (ABO)
TRF: 4500 GALS ACID (9133 - 9263)
IP: 94 BOPD, 0 MCFD, 0 BWPD (S)

THIRD CMPL INTRVL: 5942 - 5954 (GLRT)
TRF: 500 GALS ACID (5942 - 5954)
IP: 653 BOPD, 0 MCFD, 0 BWPD (FLOWING)

8560 - 8595' CIBP 30' CMT CAP

9133 - 9263' ABANDONED PERFS ABO


10134 - 10155' CIBP 16' HYDROMITE CAP

4418 - 10300' 8.5" OD HOLE

10206 - 10212' SQUEEZE PERFS PENN REEF 40 SX


PRODUCING
DRINKARD

TEXACO EXPL & PROD
NEW MEXICO "O" STATE NO. 34
API# 3002532271

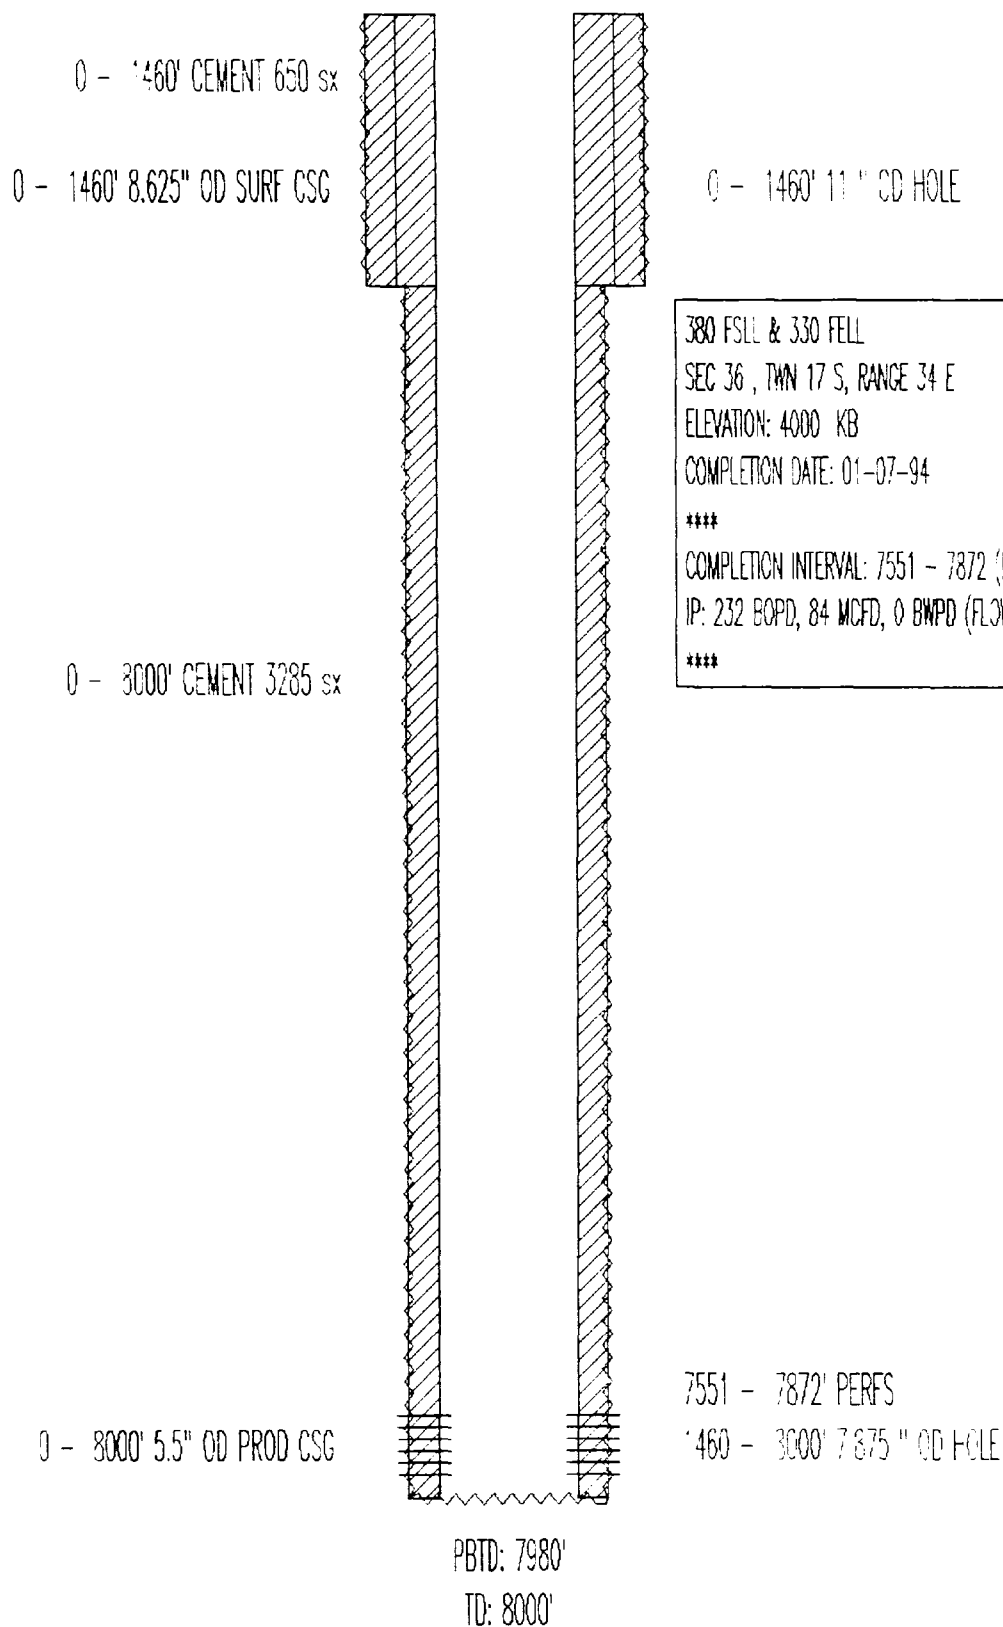


PRODUCING
DRINKARD

TEXACO EXPL & PROD
NEW MEXICO "O" STATE NO. 35
API# 3002532338

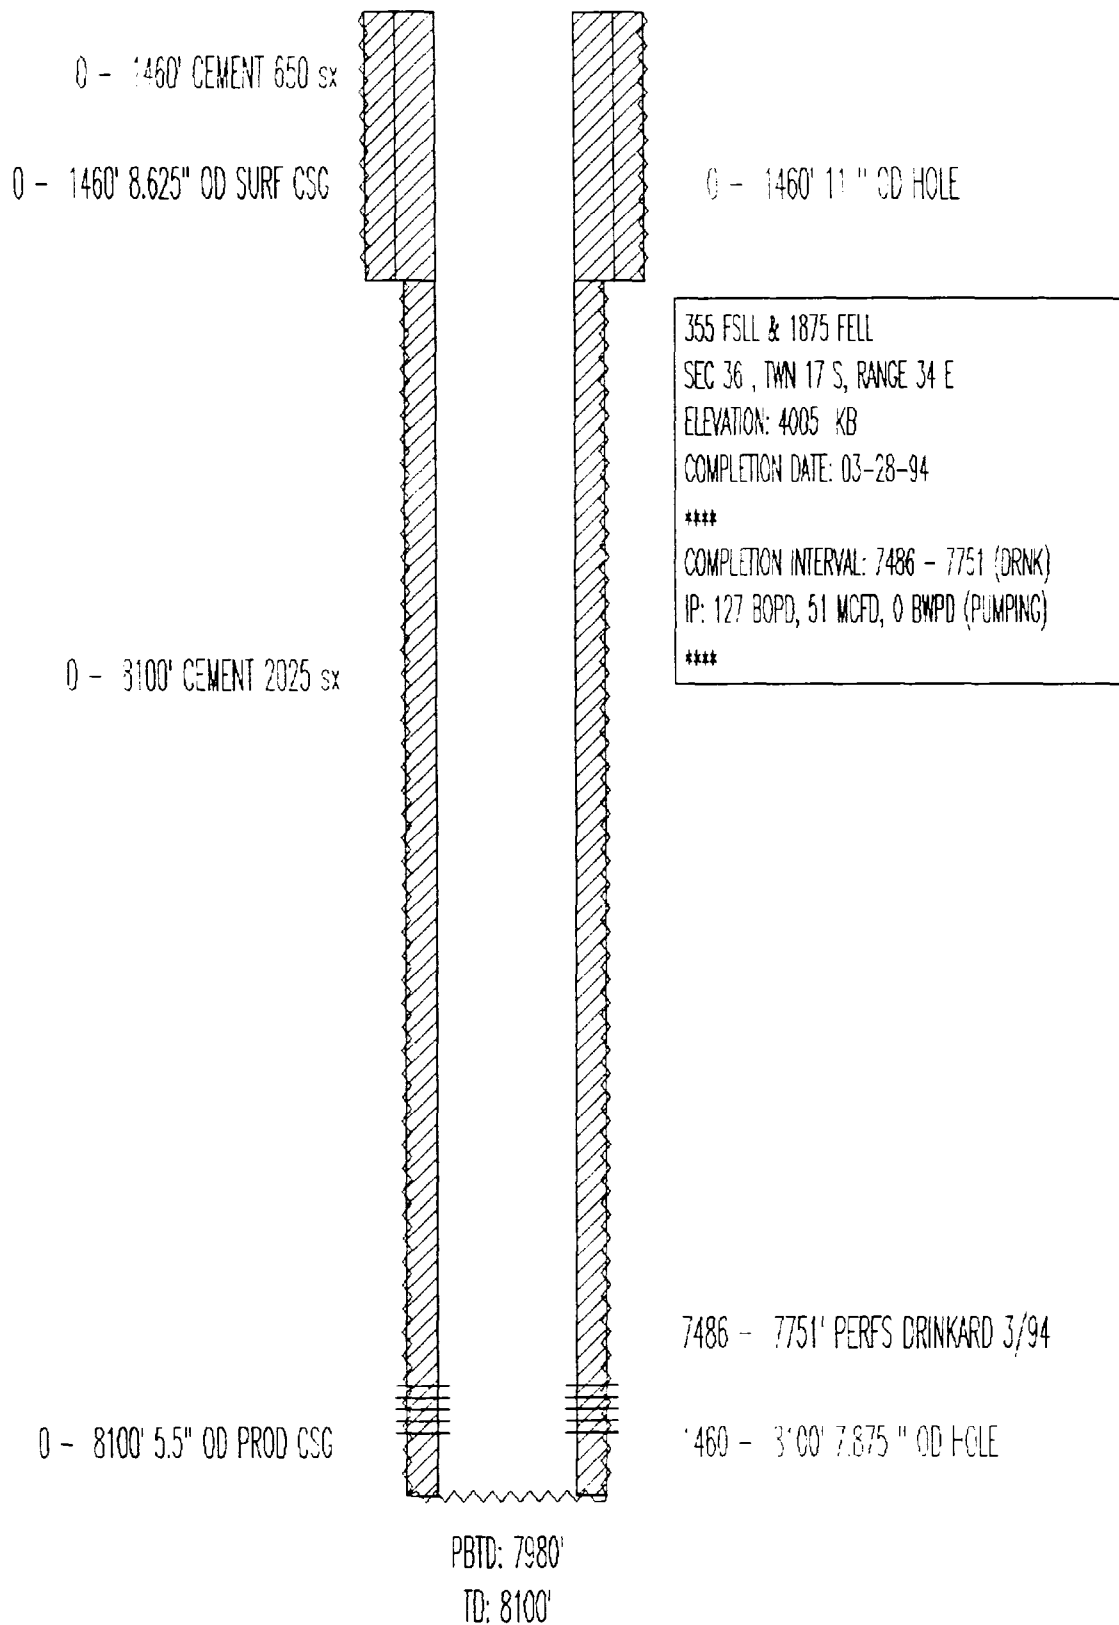


TEXACO EXPL & PROD
NEW MEXICO "O" STATE NO. 37
API# 3002532450

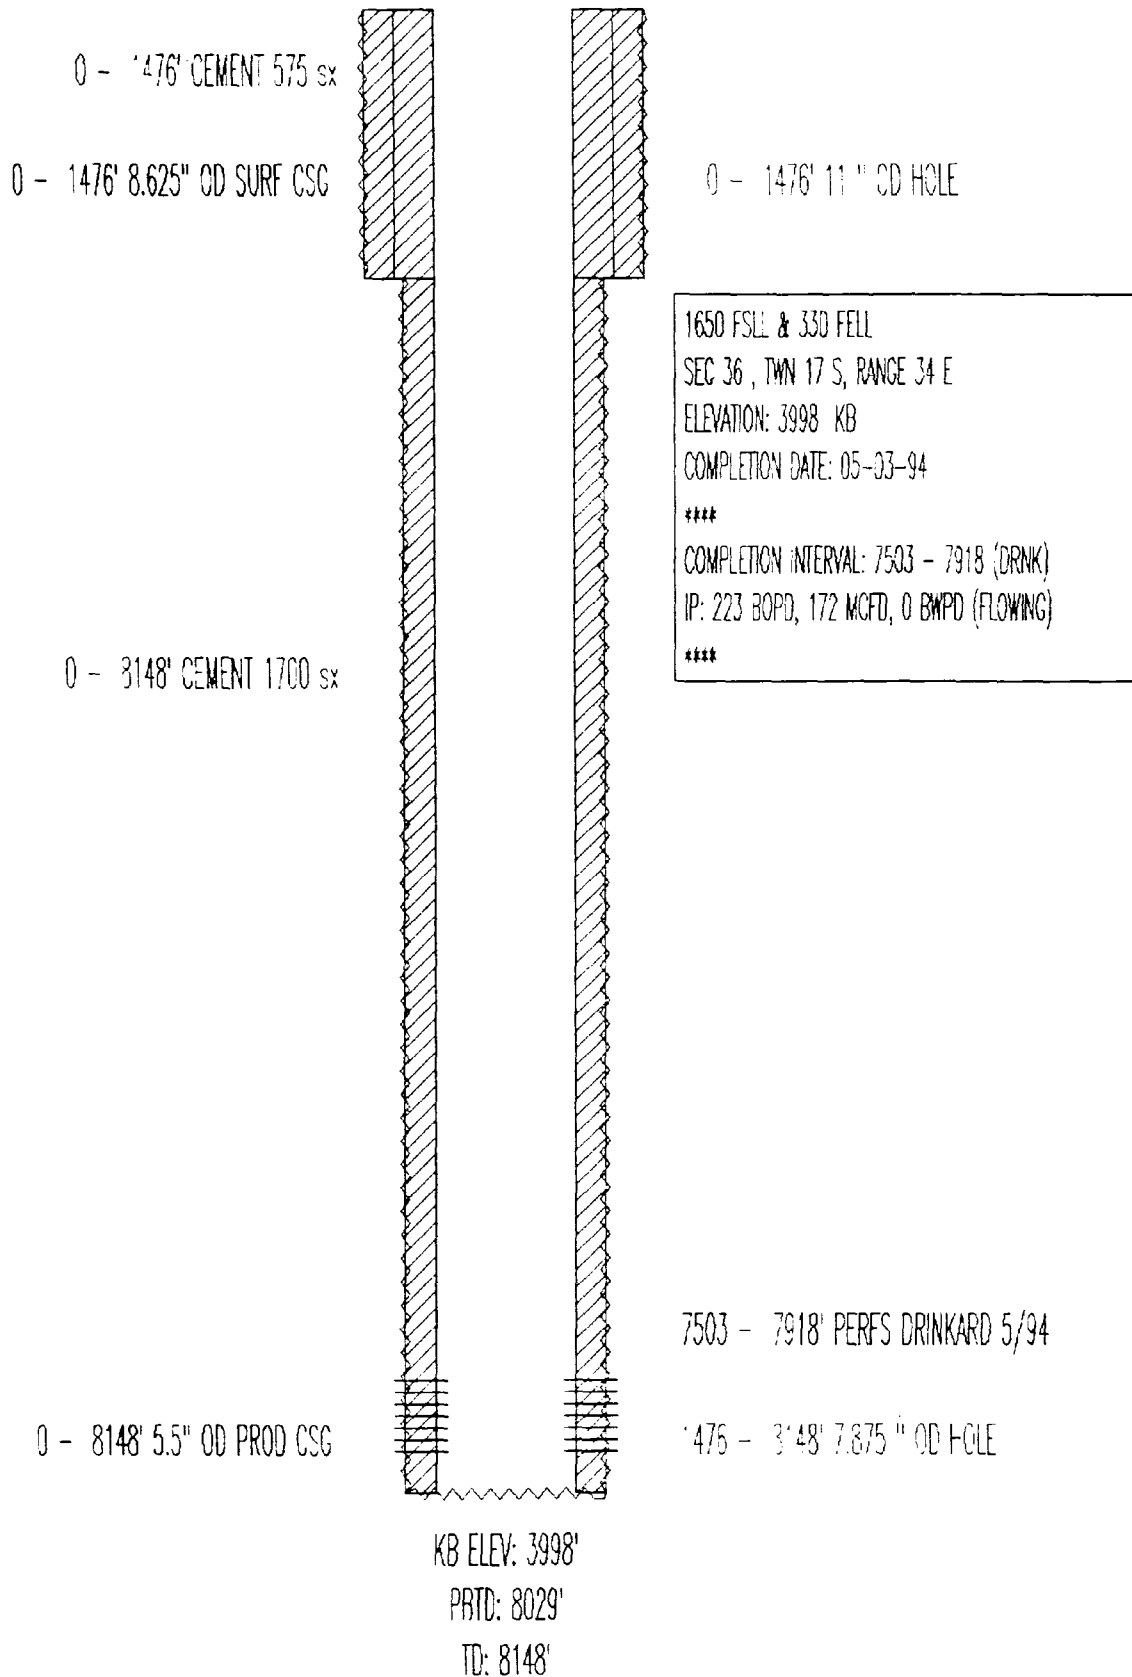

SHUT IN
ABO REEF


TEXACO INC
NEW MEXICO "R"ST. NCT-1 NO. 6
API# 3002520053

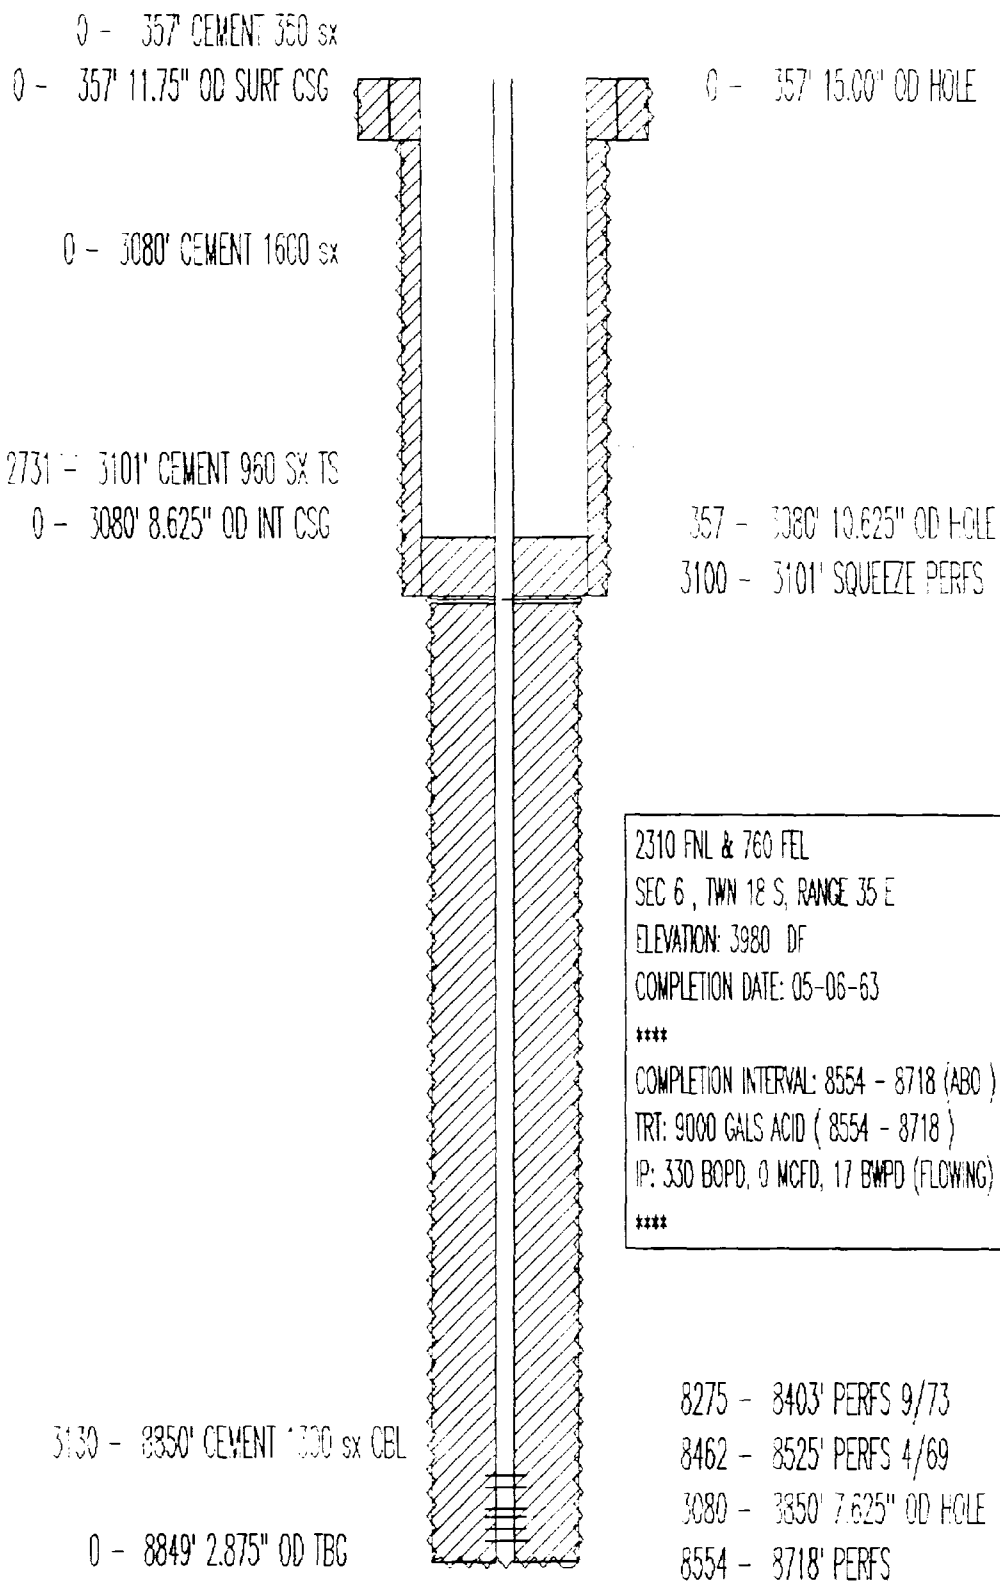

TD: 8850'


SHUT IN
ABO REEF

TEXACO INC
NEW MEXICO "R" ST. NCT-1 NO. 7
API# 3002520503

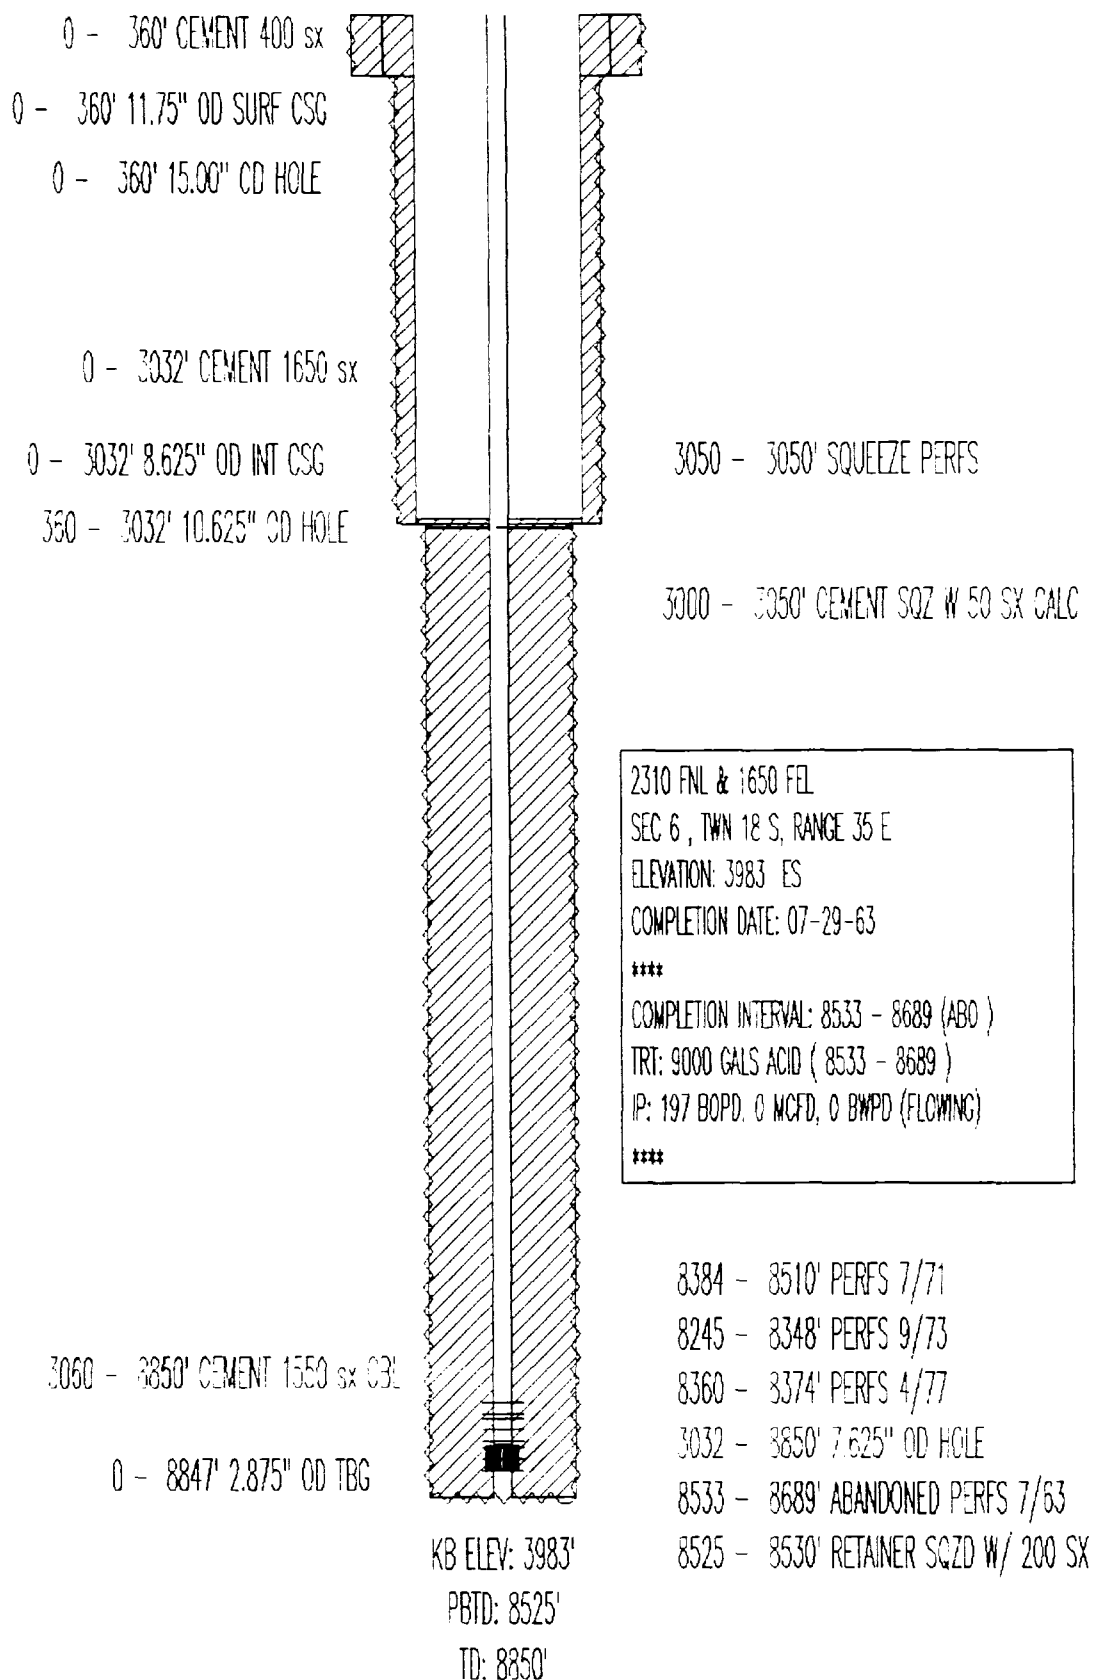

PRODUCER
DRINKARD

TEXACO EXPL & PROD
NEW MEXICO "R" ST. NCT-1 NO. 13
API# 3002531990

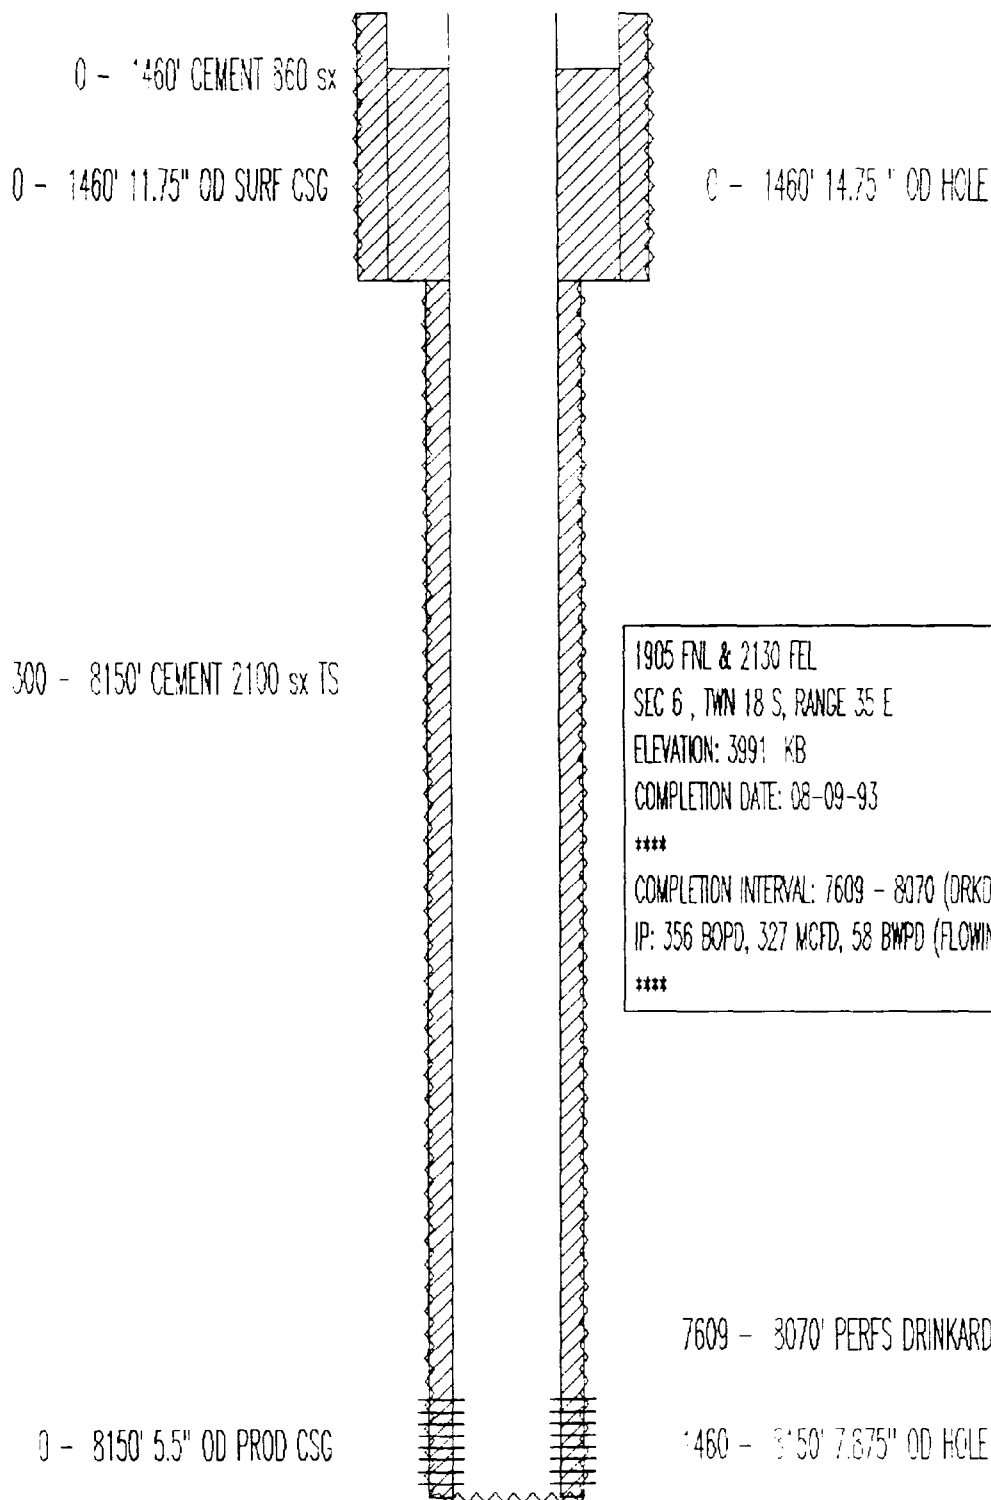


1905 FNL & 2130 FEL
SEC 6 , TWN 18 S, RANGE 35 E
ELEVATION: 3991' KB
COMPLETION DATE: 08-09-93

COMPLETION INTERVAL: 7609 - 8070 (DRKD)
IP: 356 BOPD, 327 MCFD, 58 BWPD (FLOWING)


KB ELEV: 3991'
PBTD: 8112'
TD: 8150'

TEXACO EXPL & PROD
NEW MEXICO "R" ST. NCT-1 NO.14
API# 3002532018

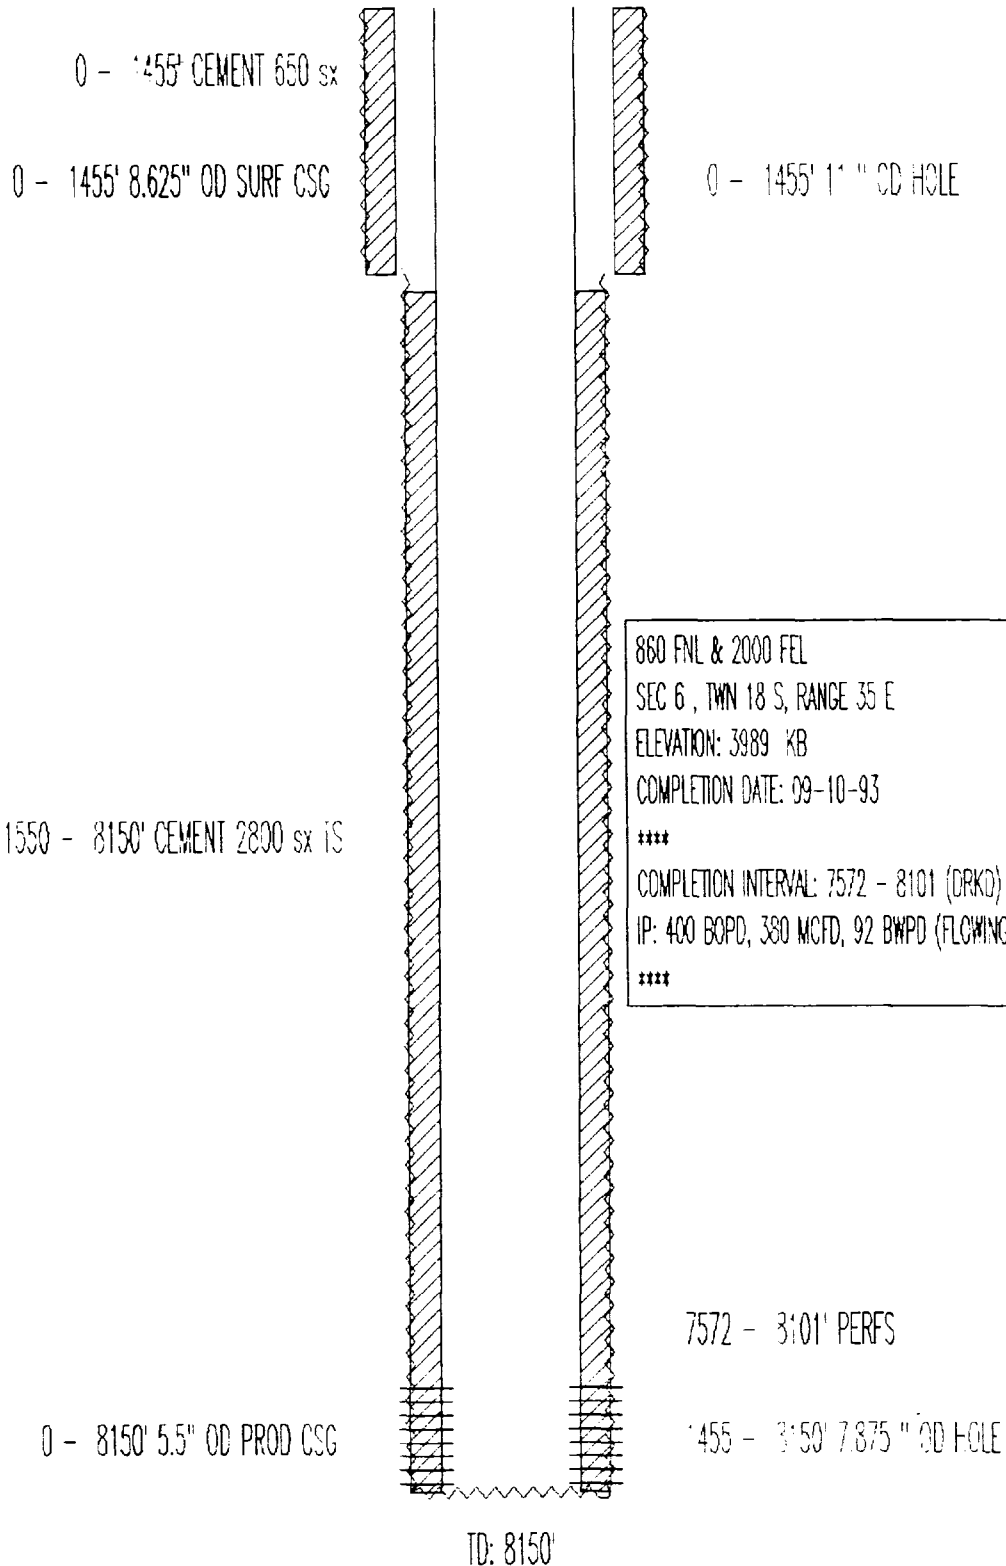

PRODUCING
DRINKARD

TEXACO EXPL & PROD
NEW MEXICO "R" ST. NCT-1 NO. 15
API# 3002532019

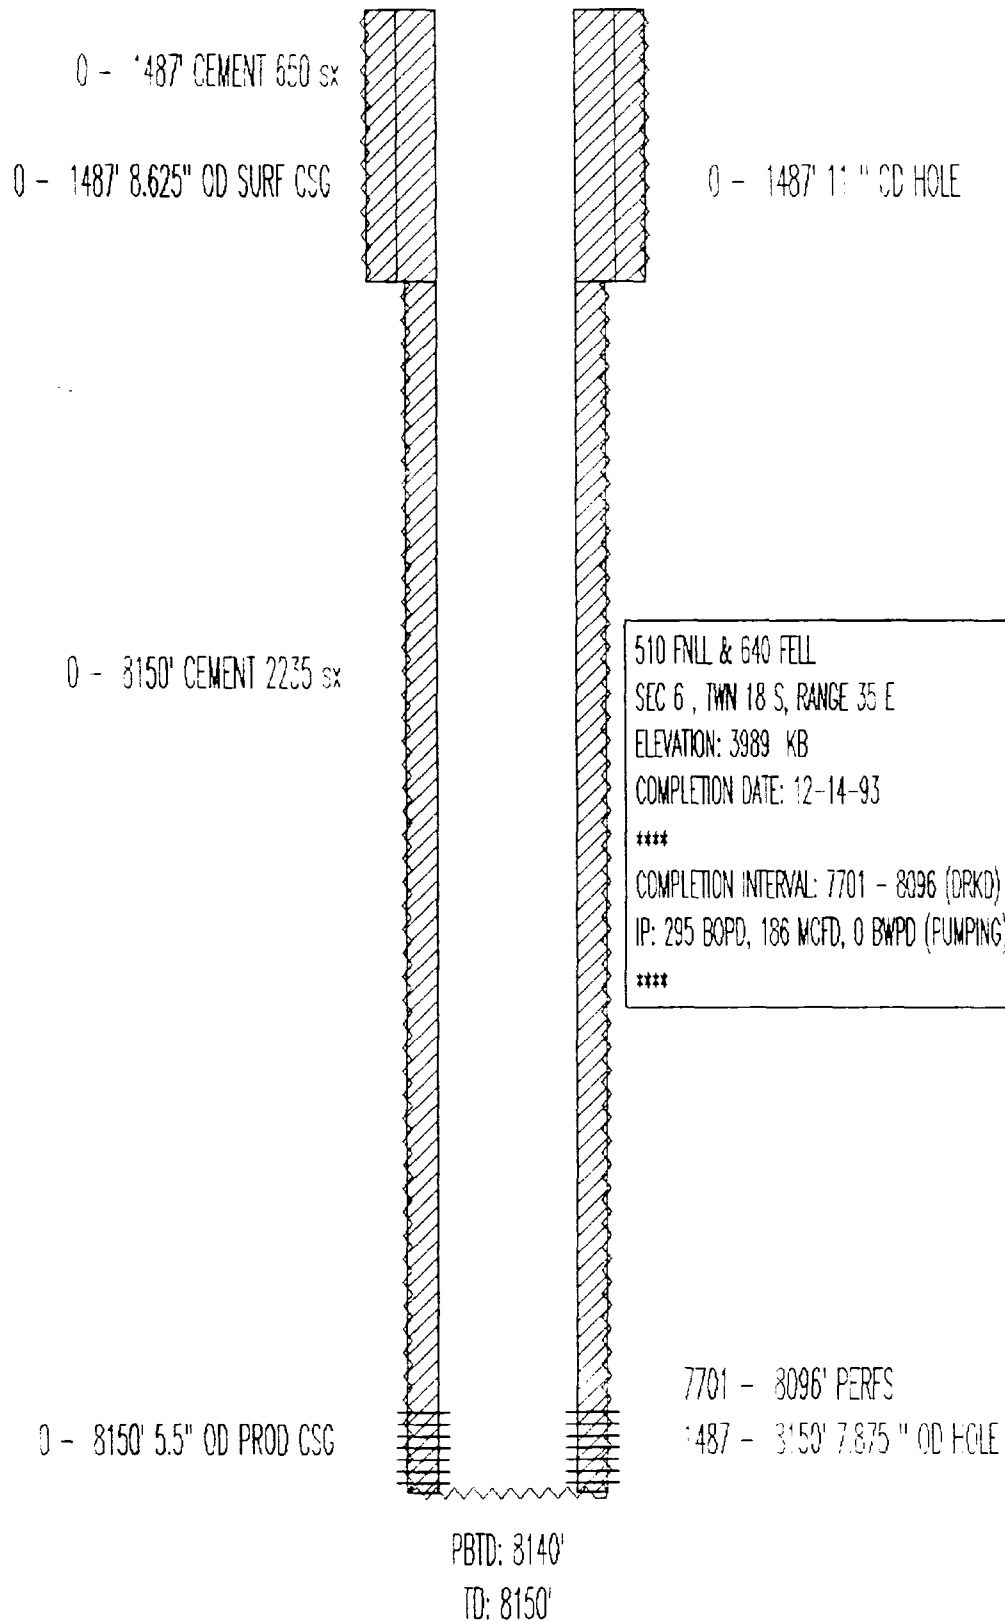

P & A

TEXACO INC
NEW MEXICO "R" ST. NCT-3 NO. 15
API# 3002520950

0 - 355' 13.375" OD SURF CSG

0 - 355' CEMENT PLUG

435 - 435' SQUEEZE PERFS

1560 - 1660' CEMENT PLUG

500 - 4800' CEMENT 1700 sx

2720 - 2820' CEMENT PLUG

0 - 4800' 9.625" OD INT CSG

4700 - 4820' CEMENT PLUG

355 - 4800' 12.25 " OD HOLE

5965 - 6000' CIBP 35' CMT CAP

4820 - 10200' CEMENT 2400 sx

8405 - 8440' CIBP 35' CMT CAP

8495 - 8706' ABANDONED PERFS ABO

9765 - 9800' CIBP 35' CMT CAP

4820 - 10200' 2.875" OD TBG

4820 - 10200' 2.875" OD TBG

4800 - 10200' 8.5 " OD HOLE

0 - 455' CEMENT PLUG

0 - 355' 7.5 " OD HOLE

487 FSL & 560 FEL

SEC 1 , TWN 18 S, RANGE 34 E

ELEVATION: 3996 ES

COMPLETION DATE: 06-05-54

COMPLETION INTERVAL: 8495 - 8706 (ABO)

TRT: 11500 GALS ACID (8495 - 8706)

IP: 142 BOPD, 0 MCFD, 120 BWPD (S)

5965 - 6000' CIBP 35' CMT CAP

8405 - 8440' CIBP 35' CMT CAP

9765 - 9800' CIBP 35' CMT CAP

9852 - 9862' ABANDONED PERFS WOLFCAMP

9923 - 9925' CIBP

9958 - 9959' ABANDONED PERFS WOLFCAMP

9968 - 9978' SQUEEZE PERFS WOLFCAMP

TD: 10200'

PRODUCING
DRINKARD

TEXACO PROD
NEW MEXICO "R" ST. NCT-3 NO. 24
API# 3002529925

0 - 40' CEMENT REDIMIX

0 - 407' CEMENT 1000 SX

0 - 40' 40" OD SURF CSG

0 - 407' 26" OD SURF CSG

0 - 1565' 20" OD INT CSG

0 - 1565' CEMENT 2150 SX

0 - 5000' 9 5/8" OD INT CSG

0 - 5000' CEMENT 3700 SX

1565 - 5000' 12.25" OD HOLE

7982 - 8000' CIBP 18' CMT CAP

5000 - 11100' 8.75" OD HOLE

0 - 11100' CEMENT 2050 SX

0 - 11100' 7" OD PROD CSG

10115 - 10150' CIBP 35' CMT CAP

11060 - 11100' CIBP 40' CMT CAP

10710 - 10750' CIBP 40' CMT CAP

10799 - 11676' 5" OD LINER

10799 - 11676' CEMENT 175 SX

11100 - 11994' 6.25" OD HOLE

0 - 40' 48" OD HOLE

40 - 407' 30" OD HOLE

407 - 1565' 24" OD HOLE

860 FSL & 660 FEL

SEC 1, TWN 18 S, RANGE 34 E

ELEVATION: 4011 KB

COMPLETION DATE: 11-18-87

TESTED DEVONIAN, LOWER MISS, AND UPPER PENN

NOT PRODUCED

PLUGGED BACK TO VACUUM DRINKARD 12-4-92

7638 - 7900' PERFS DRINKARD

10192 - 10263' ABANDONED PERFS UPPER PENN

11612 - 11652' CIBP 40' CMT CAP

11192 - 11238' ABANDONED PERFS LOWER MISS

11812 - 11912' CEMENT PLUG

11915 - 11994' TREATMENT DEVONIAN-ACID 100% H2O


KB ELEV: 4011'

PBTD: 7982'

TD: 11994'


PRODUCING
DRINKARD

TEXACO EXPL & PROD
NEW MEXICO "R" ST. NCT-3 NO. 25
API# 3002531930

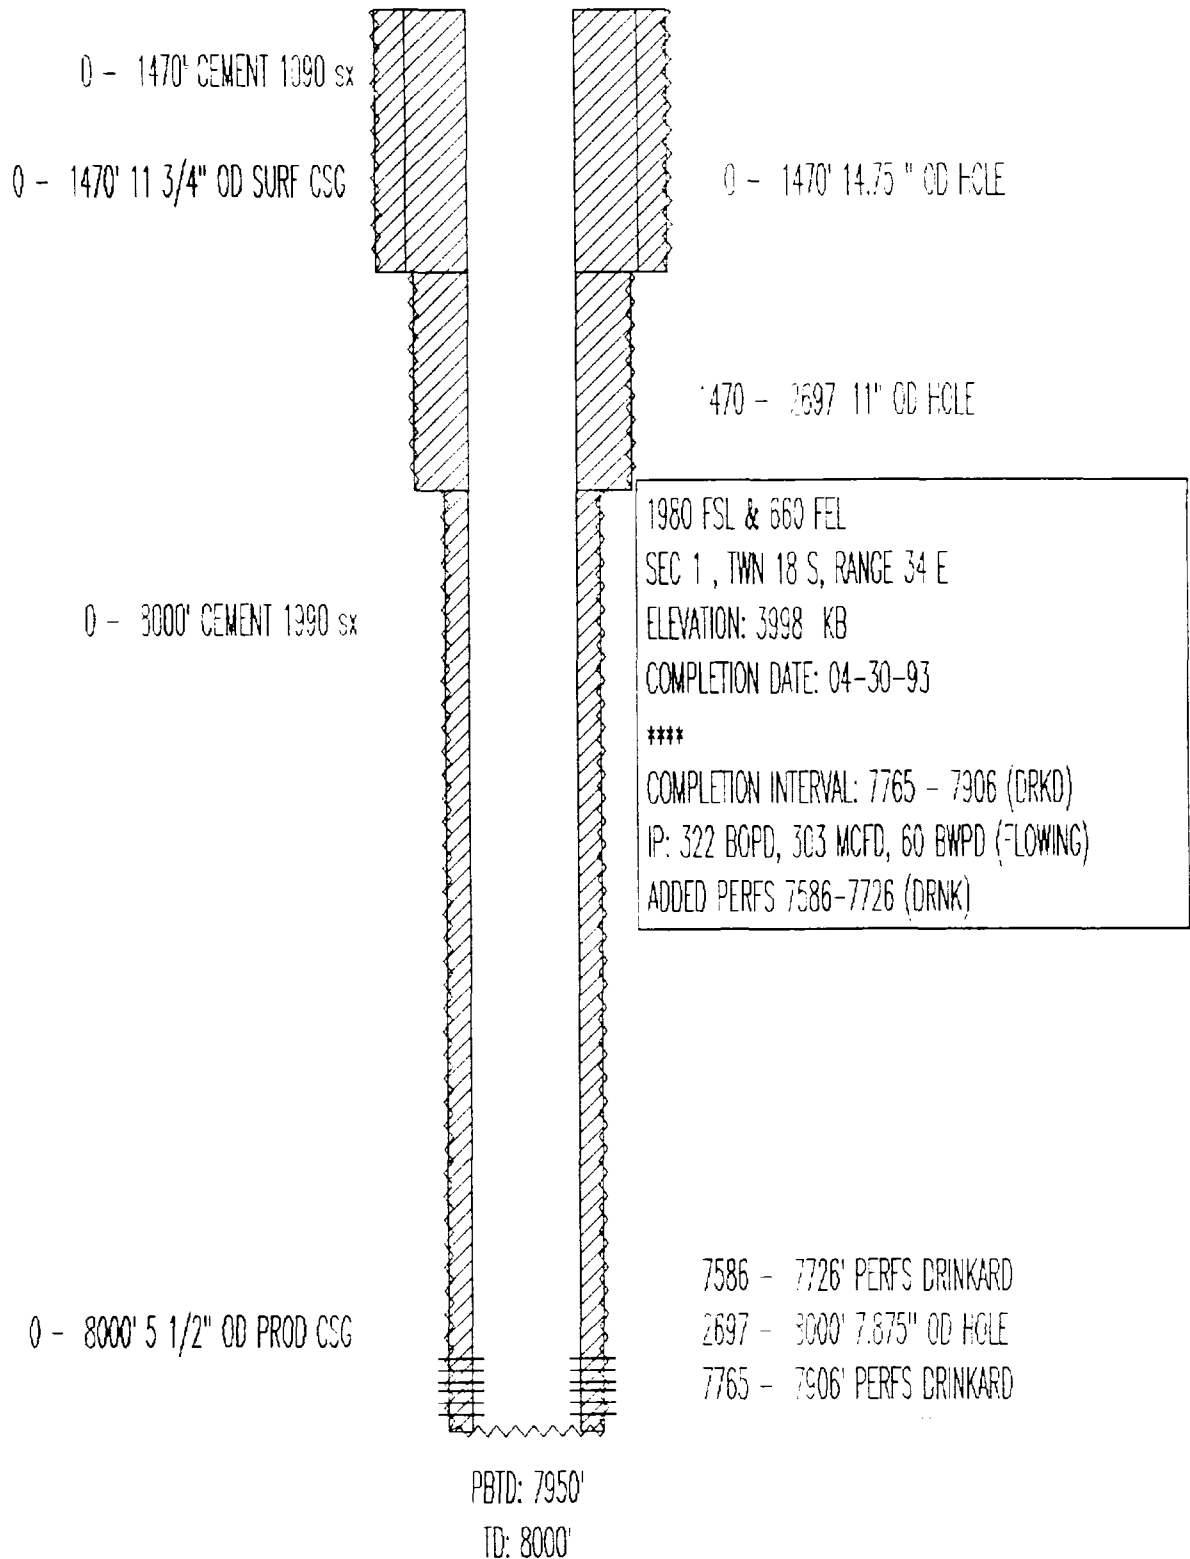

SHUT IN
DRINKARD

TEXACO EXPL & PROD
NEW MEXICO "R" ST. NCT-3 NO. 27
API# 3002532004

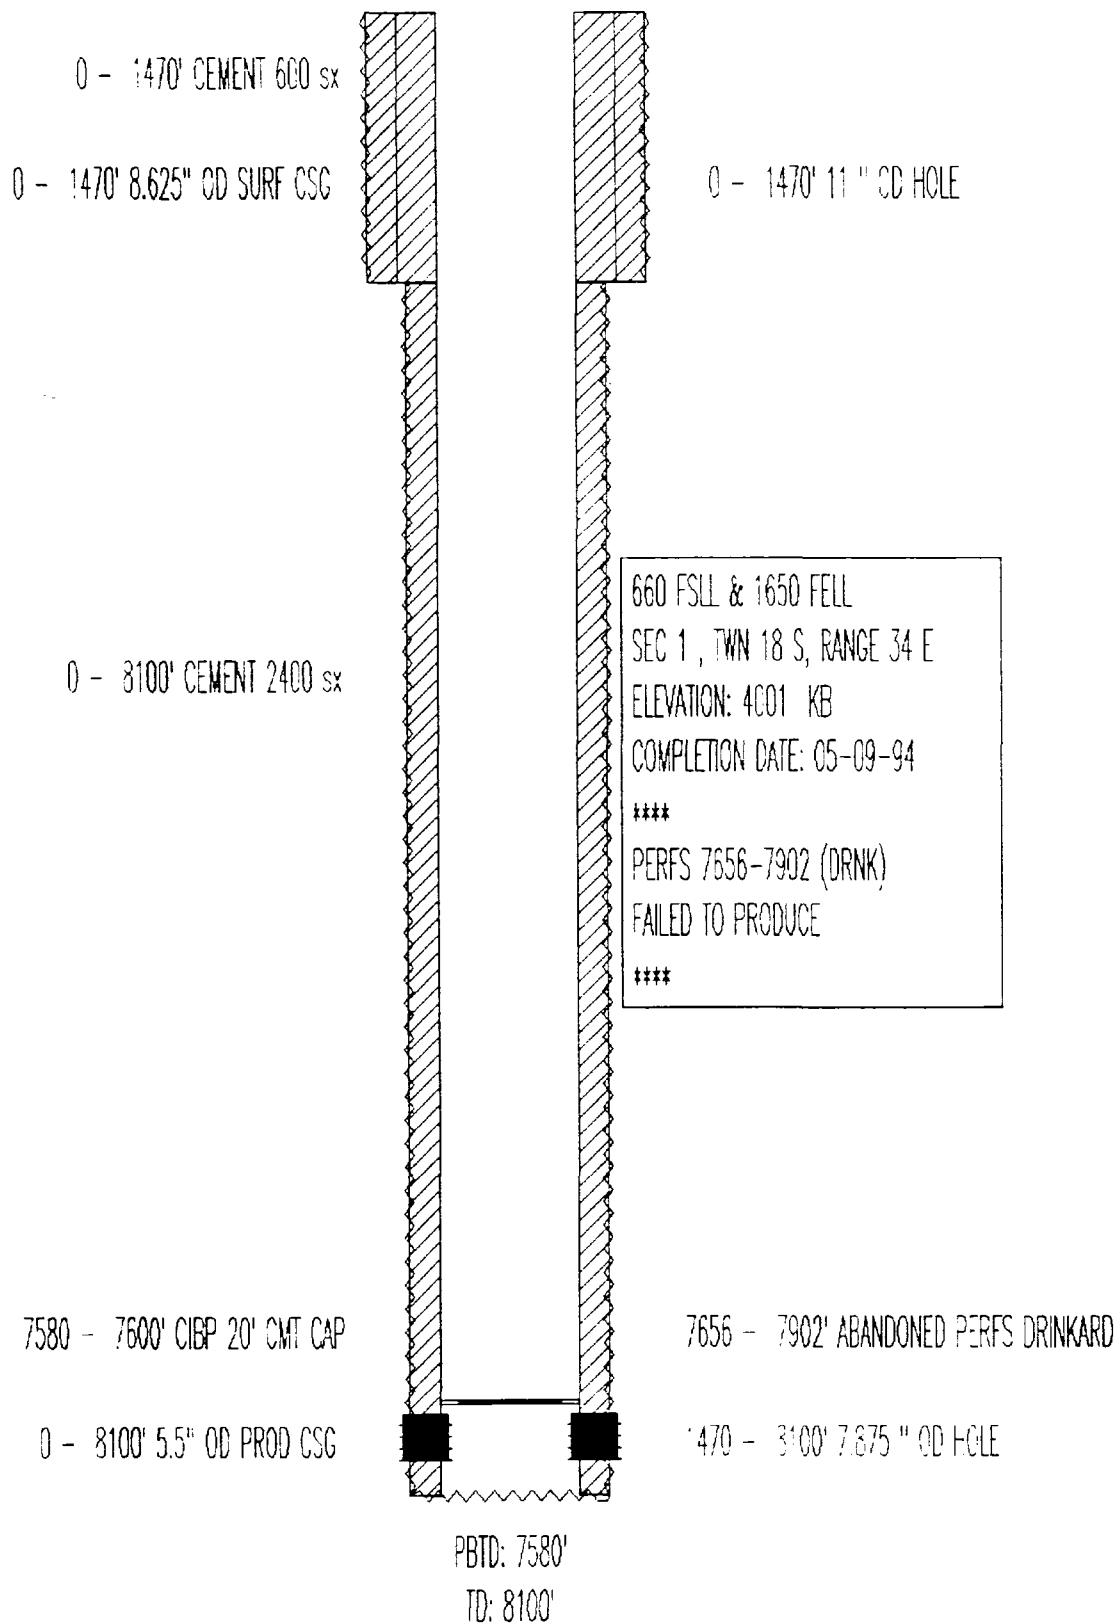

PRODUCING
DRINKARD

TEXACO INC
NEW MEXICO "AB" ST. NO. 3
API# 3002503086

0 - 343' 10.75" OD SURF CSG

0 - 343' CEMENT 250 SX

0 - 1600' CEMENT

0 - 343' 13.5" OD HOLE

1600 - 1600' SQUEEZE PERFS 450 SX

2500 - 5404' CEMENT 300 SX

0 - 5404' 7.625" OD INT CSG

660 FSLL & 1980 FELL

SEC 6, TWN 18 S, RANGE 35 E

ELEVATION: 3966 GR

COMPLETION DATE: 12-28-61

COMPLETION INTERVAL: 8672 - 8846 (ABRF)

IP: 353 BOPD, 0 MCFD, 0 BWPD (FLOWING)

5324 - 8856' CEMENT 550 SX

343 - 5404' 9.75" OD HOLE

7600 - 7981' PERFS DRINKARD 4/93

8115 - 8150' CIBP 35' CMT CAP

8400 - 8856' BAR FISH TUBING, ANCHOR, WL TOOLS

8253 - 8458' ABANDONED PERFS ABO 5/73

8492 - 8648' ABANDONED PERFS ABO 2/68

5324 - 8856' 4 1/2" OD LINER

5404 - 8856' 6.75" OD HOLE

8672 - 8846' ABANDONED PERFS ABO 12/61

TD: 8856'

SHUT IN
ABO REEF

TEXACO INC
NEW MEXICO "AB" STATE NO. 4
API# 3002503087

0 - 327' 10 3/4" OD SURF CSG

0 - 327' 15.0" OD HOLE

0 - 327' CEMENT 350 sx

650 - 5228' CEMENT 900 sx

0 - 5228' 7 5/8" OD INT CSG

5108 - 9097' CEMENT 550 sx

1650 FSL & 660 FEL

SEC 6, TWN 18 S, RANGE 35 E

ELEVATION: 3984 DF

COMPLETION DATE: 12-22-61

COMPLETION INTERVAL: 8674 - 8826 (ABRF)

IP: 341 BOPD, 0 MCFD, 0 BWPD (FLOWING)

327 - 5228' 9.875" OD HOLE

8208 - 8439' PERFS ABO 7/73

8483 - 8640' PERFS ABO 1/68

8674 - 8826' PERFS ABO 12/51

5228 - 9080' 6.75" OD HOLE

PBTD: 9066'

TD: 9080'

P & A

TEXACO INC
NEW MEXICO "AB" STATE NO. 5
API# 3002520163

0 - 1454' CEMENT PLUG 100 SX

0 - 340' 11.75" OD SURF CSG

0 - 340' CEMENT 300 SX

C - 340' 15.00" OD HOLE

0 - 3070' CEMENT 1400 SX

1454 - 1750' CEMENT PLUG 100 SX

1750 - 1900' CEMENT PLUG 400 SX

0 - 3070' 8.625" OD INT CSG

1800 FSLL & 1650 FELL
SEC 6, TWN 18 S, RANGE 35 E
ELEVATION: 3982 GR
COMPLETION DATE: 03-14-63

COMPLETION INTERVAL: 8694 - 8794 (ABO)
TRT: 6000 GALS ACID (8694 - 8794)
IP: 208 BOPD, 0 MCFD, 0 BWPD (FLOWING)

6200 - 8851' CEMENT 1500 SX TS

8172 - 8794' ABANDONED PERFS

2765 - 2805' CIBP 35' CMT CAP

2765 - 2805' CIBP 35' CMT CAP

340 - 3070' 11.00" OD HOLE

3965 - 4005' CIBP 35' CMT CAP

3965 - 4005' CIBP 35' CMT CAP

1860 - 3850' 2.875" OD TEG

1860 - 3849' 2.875" OD TEG


6300 - 6588' ABANDONED PERFS SQZD W/190 SX

3070 - 3851' 2.875" OD HOLE

TD: 8851'

PRODUCING
DRINKARD

TEXACO EXPL & PROD
NEW MEXICO "AB" STATE NO. 10
API# 3002531991

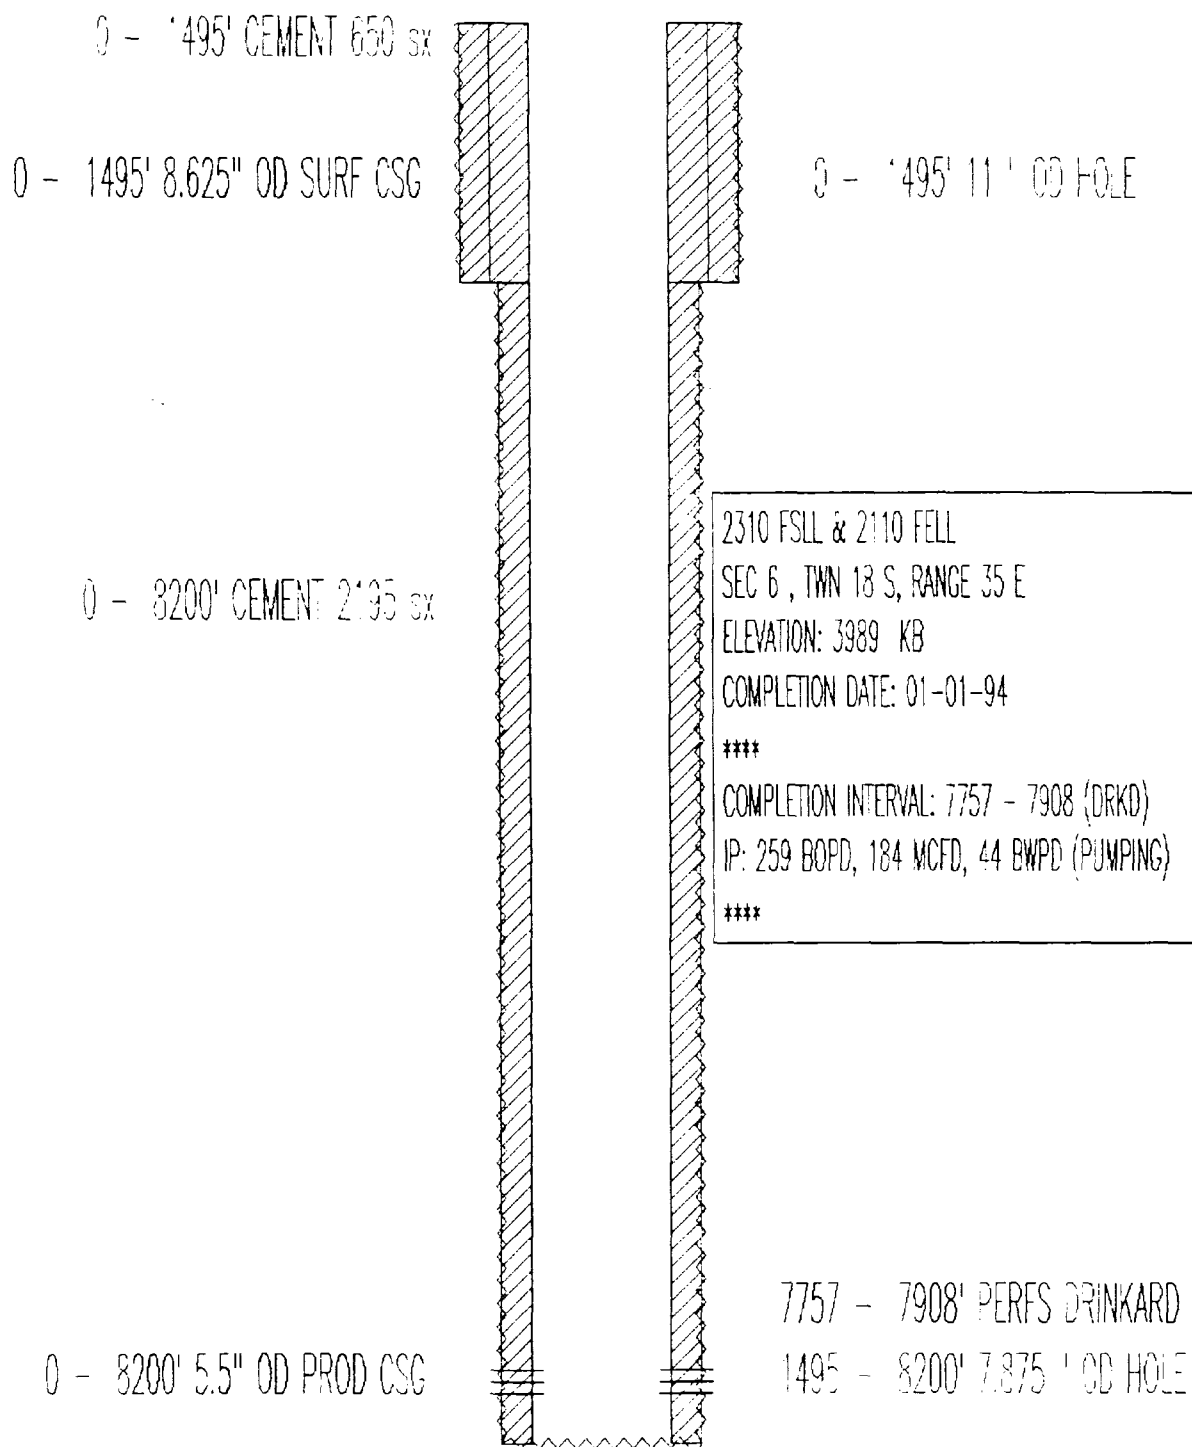

2310 FSL & 2110 FELL
SEC 6 , TWN 18 S, RANGE 35 E
ELEVATION: 3989 KB
COMPLETION DATE: 01-01-94

COMPLETION INTERVAL: 7757 - 7908 (DRKD)
IP: 259 BOPD, 184 MCFD, 44 BWPD (PUMPING)

KB ELEV: 3989'

PBTD: 8155'

TD: 8200'

PRODUCING
ABO REEF

EXXON
NEW MEXICO "BO" ST. NO. 7
API# 3002520176

0 - 302' 13.375" OD SURF CSG

0 - 302' CEMENT 325 sx

0 - 1900' CEMENT

0 - 1900' CEMENT 1350 sx

0 - 302' 17.5" OD HOLE

1900 - 1900' SQUEEZE PERFS

2200 - 3403' CEMENT 650 sx TS

0 - 3403' 8.625" OD INT CSG

302 - 3403' 12.25" OD HOLE

2100 - 8996' CEMENT 1200 sx TS

995 FNL & 330 FEL

SEC 12, TWN 18 S, RANGE 34 E

ELEVATION: 3982 DF

COMPLETION DATE: 04-21-63

COMPLETION INTERVAL: 8343 - 8544 (ABO)

TRT: 12000 GALS ACID (8343 - 8544)

IP: 144 BOPD, 0 MCFD, 8 BWPD (FLOWING)

8595 - 8600' CIBP 1 SK CMT

0 - 8996' 4.5" OD PROD CSG

8870 - 8875' CIBP 1 SK CMT

8914 - 8953' ABANDONED PERFS

8343 - 8544' PERFS

8544 - 8578' PERFS

3403 - 3000' 7.675" OD HOLE

8620 - 8749' ABANDONED PERFS

TD: 9000'

PRODUCING
ABO-WFMP


MOBIL OIL
STATE CC COM NO. 1
API# 3002520872

0 - 360' 16" OD SURF CSG
0 - 360' CEMENT 350 SX
0 - 715' CEMENT PLUG 15 SX
0 - 715' CEMENT PLUG 15 SX
0 - 4967' CEMENT 2175 SX

0 - 4967' 10.75" OD INT CSG
360 - 4967' 14.75" OD HOLE

9115 - 9185' ABANDONED PERFS

0 - 12080' CEMENT 4460 SX
0 - 12080' 2.875" OD TBG
0 - 12080' 2.875" OD TBG
4967 - 12080' 9.5" OD HOLE

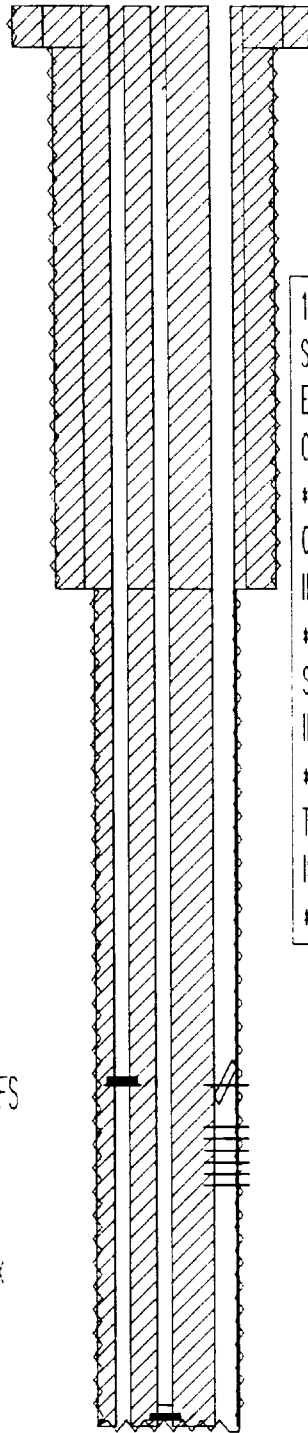

0 - 360' 20" OD HOLE

1980 FSL & 860 FWL
SEC 36, TWN 17 S, RANGE 34 E
ELEVATION: 4001 ES
COMPLETION DATE: 08-12-64

COMPLETION INTERVAL: 9115 - 9185 (ABO)
IP: 179 BOPD, 0 MCFD, 0 BWPD (FLOWING)

SECOND CMPL INTRVL: 11972 - 12028 (CVNN)
IP: 104 BOPD, 0 MCFD, 21 BWPD (FLOWING)

THIRD CMPL INTRVL: 9962 - 10032 (WFMP)
IP: 211 BOPD, 0 MCFD, 4 BWPD (FLOWING)

9115 - 9185' PERFS ABO
8962 - 9350' BAR FISH TBG & PMP
9442 - 10032' PERFS WFMP


11895 - 11896' CIBP CMT CAP
11972 - 12028' ABANDONED PERFS

0 - 10222' 4.5" OD TBG

KB ELEV: 4001'
PBTD: 11895'
TD: 12080'


PRODUCING
DRINKARD

MOBIL PRODUCING TX & NM
STATE "K" NO. 12
API# 3002532413

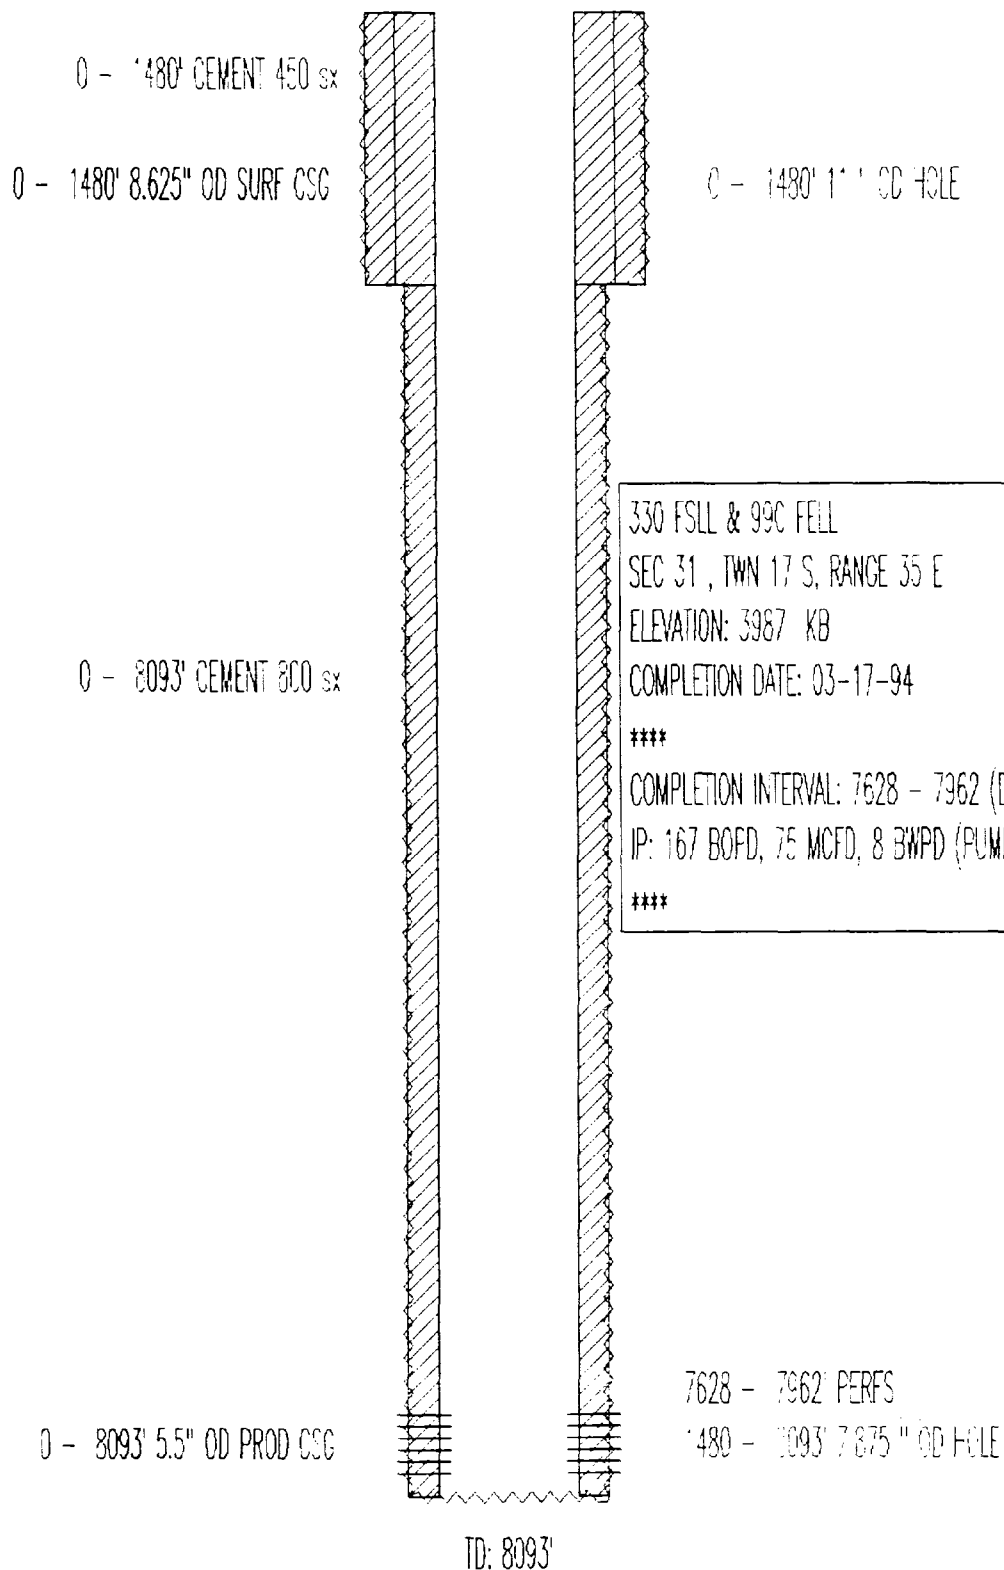

PRODUCING
DRINKARD

SHELL WESTERN EXPL & PROD
STATE "D" NO. 3
API# 3002532298

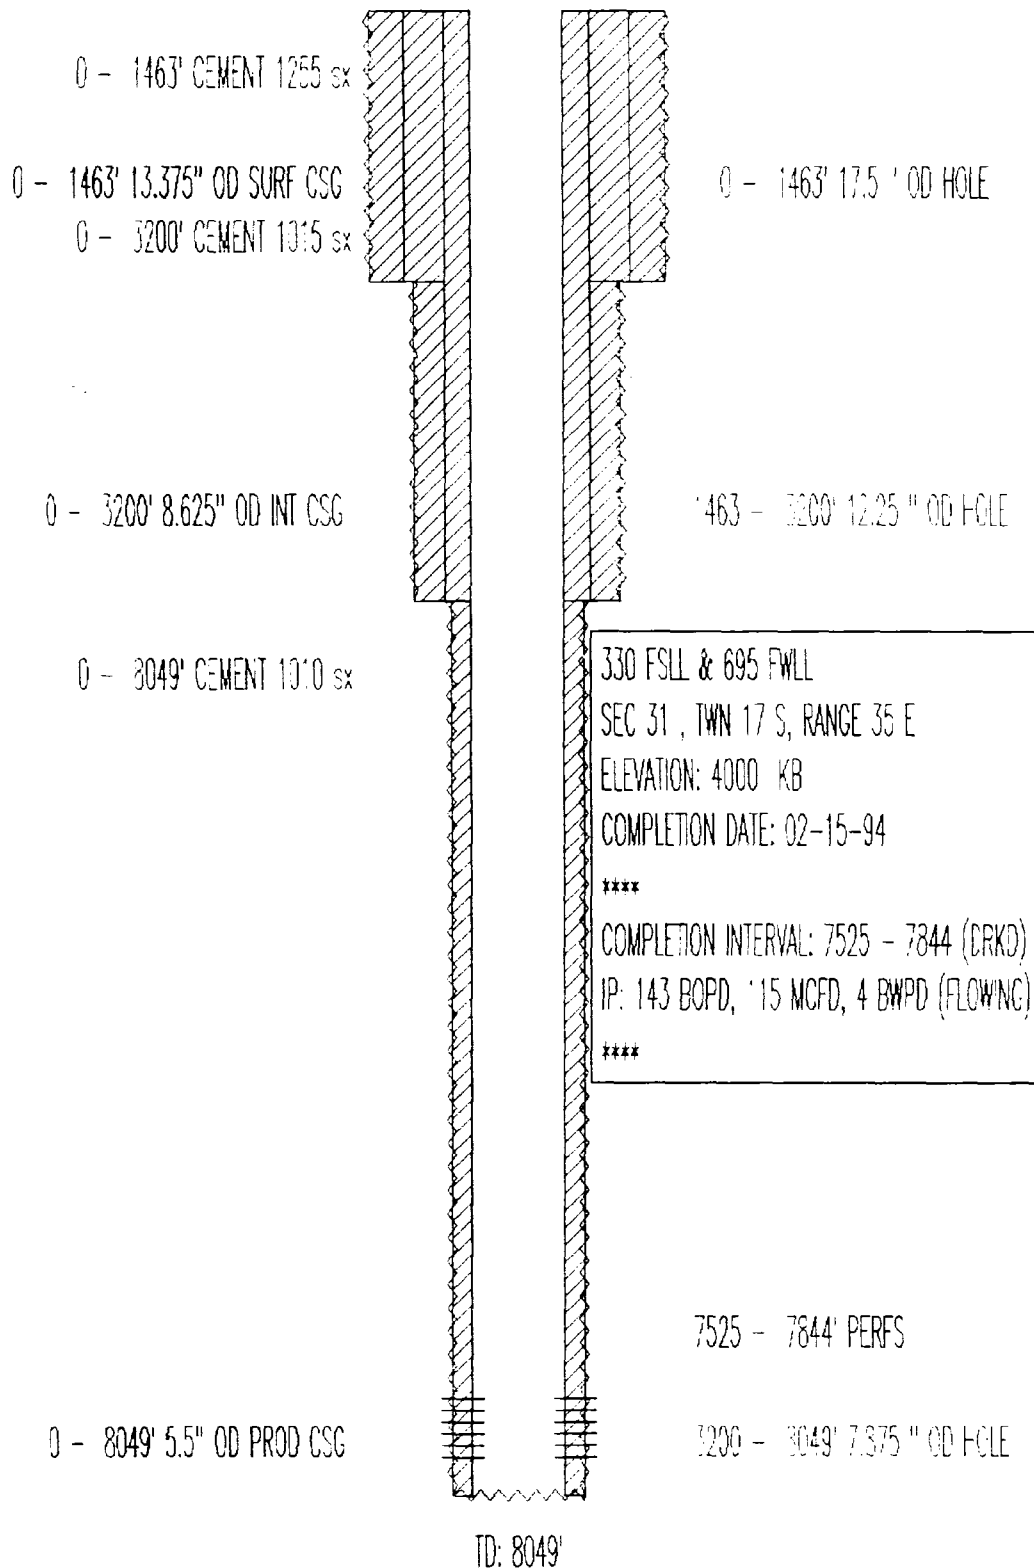

PRODUCING
DRINKARD

SHELL OIL
STATE "E" NO. 2
API# 3002520823

0 - 332' 13.375" OD SURF CSG

0 - 332' CEMENT 300 sx

0 - 332' 17.5 " OD HOLE

332 - 3284' 12.25 " OD HOLE

0 - 3284' 9.625" OD INT CSG

0 - 3284' CEMENT 574 sx

660 FSL & 1700 FWL

SEC 31 , T1N 17 S, RANGE 35 E

ELEVATION: 3984 GR

COMPLETION DATE: 05-11-64

COMPLETION INTERVAL: 5999 - 6101 (PDC)

TRT: 1500 GALS ACID (5999 - 6101)

IP: 120 BOPD, 0 MCFD, 7 BWPD (FLOWING)

3320 - 3320' SQUEEZE PERFS

0 - 3320' CEMENT SQZ TO SURF W/ 1260 SX

5999 - 6223' SQUEEZE PERFS SQZD W/150 SX (PDK)

7618 - 7904' PERFS DRINKARD

8095 - 8098' CIBP

9218 - 9418' ABANDONED PERFS WOLF CAMP

9096 - 9100' CIBP 1 SK CMT CAP

0 - 9505' 7 " OD PROD CSG

3400 - 9505' CEMENT 1800 sx

3284 - 10406' 8.5 " OD HOLE


KB ELEV: 3996'

PBTD: 8095'

TD: 10406'


PRODUCING
DRINKARD

PHILLIPS PET
SANTA FE NO. 133
API# 3002532333

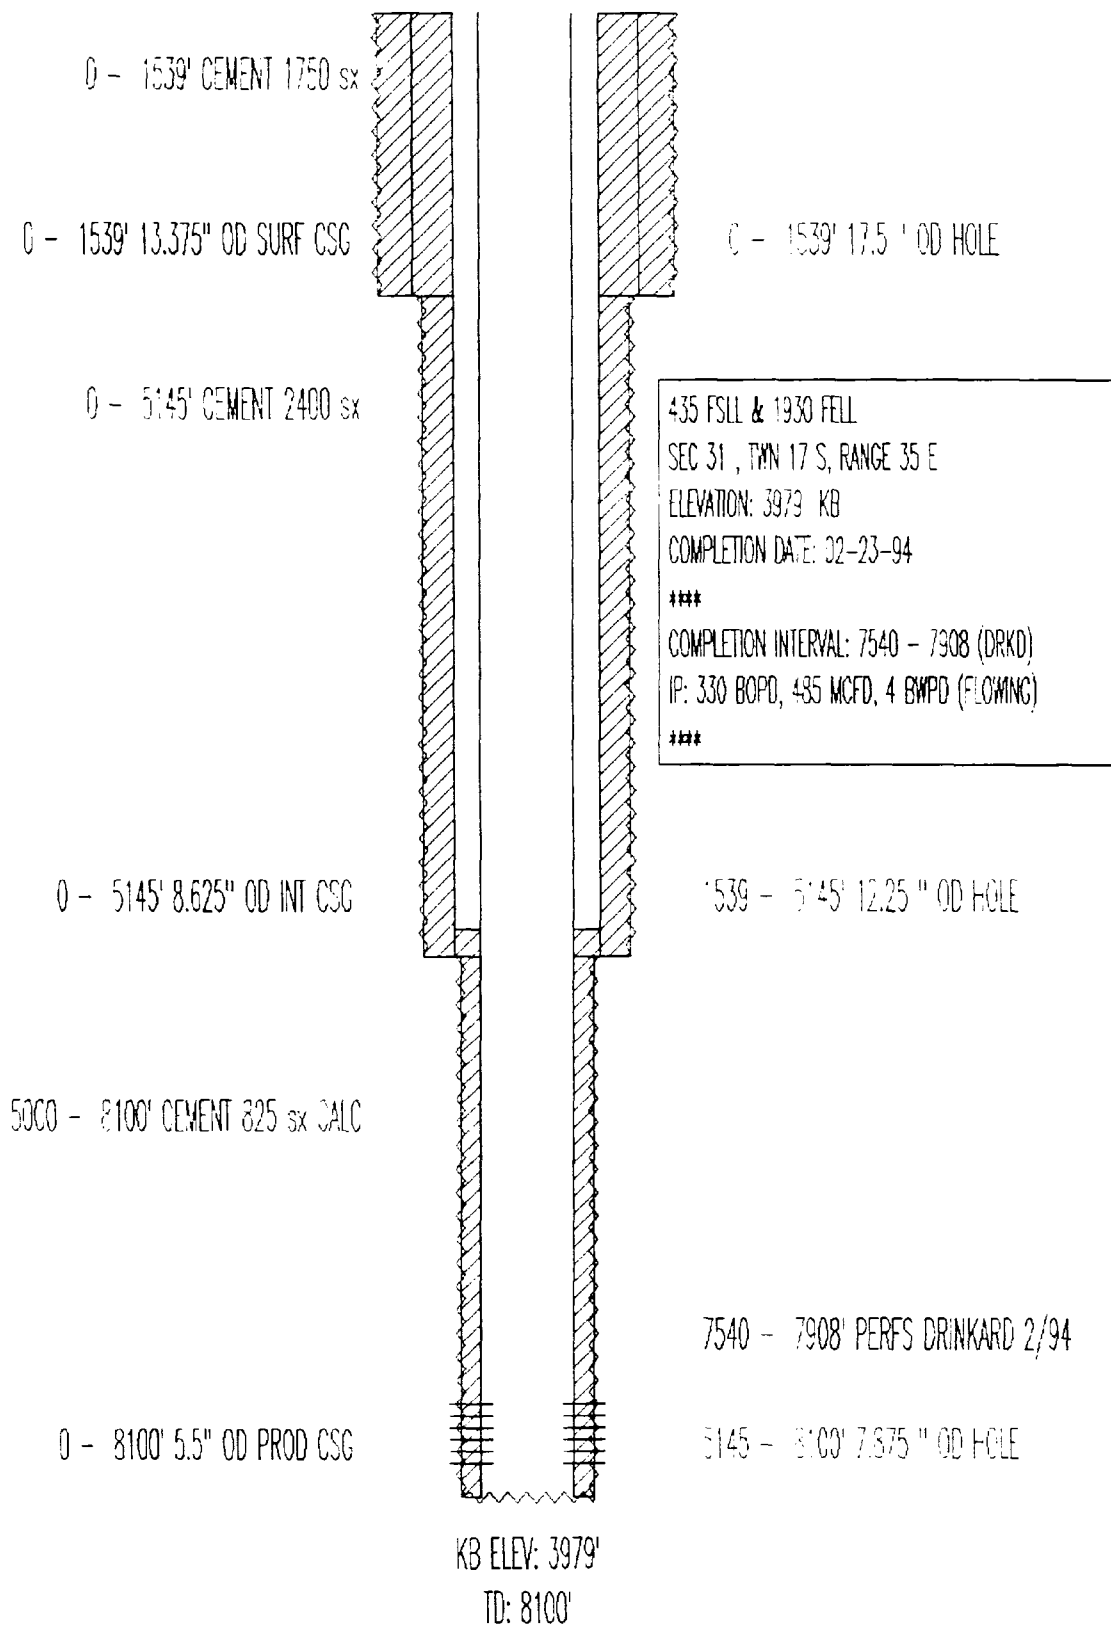

PRODUCING
DRINKARD

PHILLIPS PET
SANTA FE NO. 135
API# 3002532438

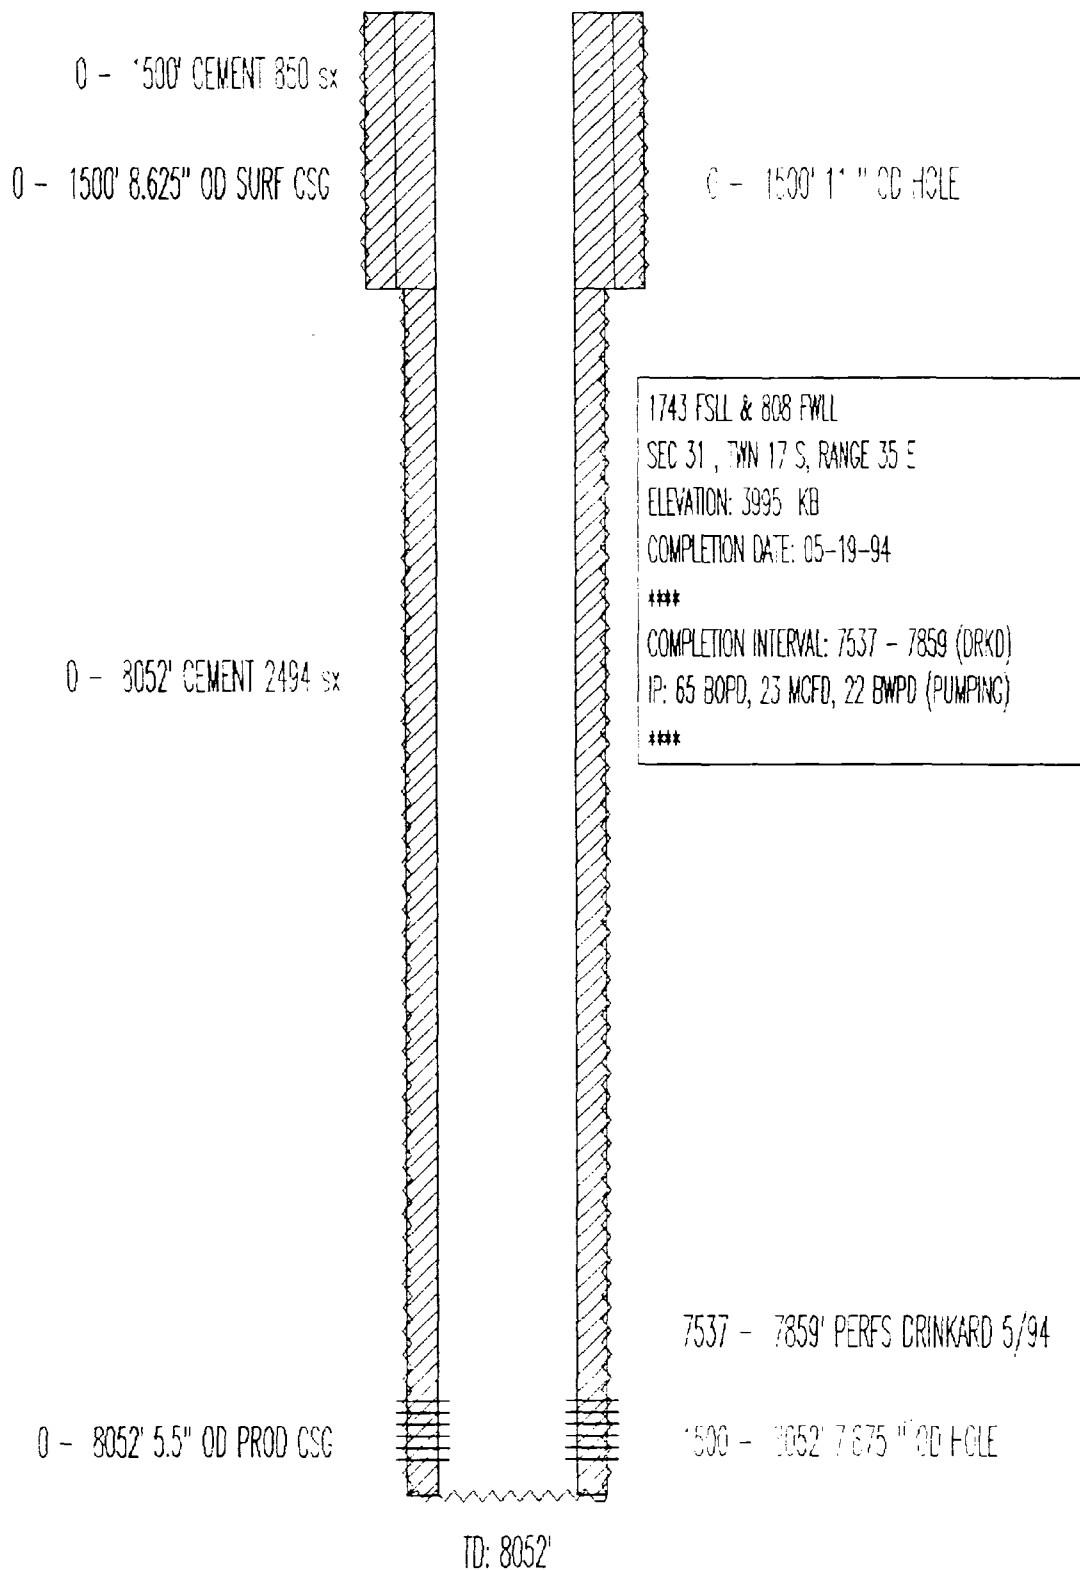

Unichem International

707 North Leech

P.O.Box 1499

Hobbs, New Mexico 88240

Company : Marathon Oil

Date : 8-2-1994

Location: ~~Warn St. - Drinkard~~ (on 8-1-1994)

Sample 1

Specific Gravity:

1.082

Total Dissolved Solids:

114514

pH:

5.60

IONIC STRENGTH:

2.306

[illegible]

CATIONS:

Calcium	(Ca+2)	80.0	1600
Magnesium	(Mg+2)	400	4860
Sodium	(Na+1)	1540	35300
Dissolved Iron	(Fe+2)	0.004	0.100

ANIONS:

Bicarbonate	(HCO ₃ -1)	1.40	85.4
Carbonate	(CO ₃ -2)	0	0
Hydroxide	(OH-1)	0	0
Sulfate	(SO ₄ -2)	96.8	4650
Chloride	(Cl-1)	1920	68000

DISSOLVED GASES

Carbon Dioxide (CO2)	30.0
Hydrogen Sulfide (H2S)	0

[illegible]

SCALING INDEX (positive value indicates scale)

Temperature		Calcium Carbonate	Calcium Sulfate
86[F	30[C	-1.9	-20
110[F	43[C	-1.1	-20
130[F	54[C	-0.78	-20
140[F	60[C	-0.59	-20
160[F	71[C	-0.19	-17

Comments:

cc: Jay Brown

Joe Hay

I

I



Unichem International

707 North Leech

P.O.Box 1499

Hobbs, New Mexico 88240

Company : Texaco Inc.

Date : 8-2-1994

Location: ~~Consolidated~~ (on 8-1-1994)

	Sample 1
Specific Gravity:	1.081
Total Dissolved Solids:	112779
pH:	5.50
IONIC STRENGTH:	2.207

=====

CATIONS:		me/liter	mg/liter
Calcium	(Ca+2)	132	2640
Magnesium	(Mg+2)	264	3210
Sodium	(Na+1)	1570	36100
Dissolved Iron	(Fe+2)	0.007	0.200

ANIONS:			
Bicarbonate	(HCO3-1)	1.40	85.4
Carbonate	(CO3-2)	0	0
Hydroxide	(OH-1)	0	0
Sulfate	(SO4-2)	77.0	3700
Chloride	(Cl-1)	1890	67000

DISSOLVED GASES		
Carbon Dioxide	(CO2)	550
Hydrogen Sulfide	(H2S)	0

=====

SCALING INDEX (positive value indicates scale)

Temperature		Calcium Carbonate	Calcium Sulfate
86[F	30[C	-1.8	-6.6
110[F	43[C	-1.0	-6.6
130[F	54[C	-0.69	-6.6
140[F	60[C	-0.50	-6.6
160[F	71[C	-0.10	-2.9

Comments:

cc: Jay Brown

Joe Hay

I

I



Unichem International

707 North Leech

P.O.Box 1499

Hobbs, New Mexico 88240

Company : Texaco Inc.

Date : 8-2-1994

Location: ~~WGSAN~~ Well 12 (on 8-1-1994)

Specific Gravity:	Sample 1
Total Dissolved Solids:	1.083
pH:	116583
IONIC STRENGTH:	6.70
	2.120

~~~~~

| CATIONS:  |        | me/liter | mg/liter |
|-----------|--------|----------|----------|
| Calcium   | (Ca+2) | 164      | 3280     |
| Magnesium | (Mg+2) | 36.0     | 437      |
| Sodium    | (Na+1) | 1800     | 41300    |

| ANIONS:     |          |      |       |
|-------------|----------|------|-------|
| Bicarbonate | (HCO3-1) | 10.4 | 634   |
| Carbonate   | (CO3-2)  | 0    | 0     |
| Hydroxide   | (OH-1)   | 0    | 0     |
| Sulfate     | (SO4-2)  | 40.1 | 1930  |
| Chloride    | (Cl-1)   | 1950 | 69000 |

DISSOLVED GASES

|                        |      |
|------------------------|------|
| Carbon Dioxide (CO2)   | 70.0 |
| Hydrogen Sulfide (H2S) | 119  |

~~~~~

SCALING INDEX (positive value indicates scale)

Temperature		Calcium Carbonate	Calcium Sulfate
86[F	30[C	0.38	-22
110[F	43[C	1.1	-22
130[F	54[C	1.5	-22
140[F	60[C	1.6	-22
160[F	71[C	2.0	-18

Comments:

cc: Jay Brown

Joe Hay

I



Unichem International

707 North Leech

P.O.Box 1499

Hobbs, New Mexico 88240

Company : Texaco Inc.
Date : 8-3-1994
Location: Compatability (on 7-28-1994)

	Sample 1
Specific Gravity:	1.082
Total Dissolved Solids:	114681
pH:	6.10
IONIC STRENGTH:	2.163

~~~~~

| CATIONS:       |        | me/liter | mg/liter |
|----------------|--------|----------|----------|
| Calcium        | (Ca+2) | 148      | 2960     |
| Magnesium      | (Mg+2) | 150      | 1820     |
| Sodium         | (Na+1) | 1680     | 38700    |
| Dissolved Iron | (Fe+2) | 0.004    | 0.100    |

| ANIONS:     |          |      |       |
|-------------|----------|------|-------|
| Bicarbonate | (HCO3-1) | 5.90 | 360   |
| Carbonate   | (CO3-2)  | 0    | 0     |
| Hydroxide   | (OH-1)   | 0    | 0     |
| Sulfate     | (SO4-2)  | 58.6 | 2810  |
| Chloride    | (Cl-1)   | 1920 | 68000 |

| DISSOLVED GASES  |       |      |
|------------------|-------|------|
| Carbon Dioxide   | (CO2) | 310  |
| Hydrogen Sulfide | (H2S) | 59.5 |
| Oxygen           | (O2)  | 0    |

~~~~~

SCALING INDEX (positive value indicates scale)

Temperature		Calcium Carbonate	Calcium Sulfate
86[F	30[C	-0.50	-13
110[F	43[C	0.23	-13
130[F	54[C	0.57	-13
140[F	60[C	0.76	-13
160[F	71[C	1.2	-9.4

Comments:

Ratio: ~~Consolid~~ Drinkard = 50% and VGSAU = 50%.

cc: Jay Brown

Joe Hay

I



Unichem International

707 North Leech

P.O.Box 1499

Hobbs, New Mexico 88240

Company : Texaco Inc.
Date : 8-3-1994
Location: Computability (on 7-28-1994)

	Sample 1
Specific Gravity:	1.081
Total Dissolved Solids:	113647
pH:	5.55
ONIC STRENGTH:	2.256

=====

CATIONS:		me/liter	mg/liter
Calcium	(Ca+2)	106	2120
Magnesium	(Mg+2)	332	4030
Sodium	(Na+1)	1550	35700
Dissolved Iron	(Fe+2)	0.005	0.150

ANIONS:			
Bicarbonate	(HCO3-1)	1.40	85.4
Carbonate	(CO3-2)	0	0
Hydroxide	(OH-1)	0	0
Sulfate	(SO4-2)	86.9	4180
Chloride	(Cl-1)	1900	67500

DISSOLVED GASES		
Carbon Dioxide	(CO2)	290
Hydrogen Sulfide	(H2S)	0
Oxygen	(O2)	0

=====

SCALING INDEX (positive value indicates scale)

Temperature		Calcium Carbonate	Calcium Sulfate
86[F	30[C	-1.8	-12
110[F	43[C	-1.1	-12
130[F	54[C	-0.72	-12
140[F	60[C	-0.53	-12
160[F	71[C	-0.13	-8.4

Comments:

Ratio: Warm St. Drinkard = 50% and Consol. Drinkard = 50%

cc: Jay Brown

Joe Hay



Unichem International

707 North Leech

P.O.Box 1499

Hobbs, New Mexico 88240

Company : Texaco Inc.
Date : 8-3-1994
Sample 1: Compatability (on 7-28-1994)
Sample 2: (on)

	Sample 1	Sample 2
Specific Gravity:	1.081	1.081
Total Dissolved Solids:	113213	114080
pH:	5.53	5.57
ONIC STRENGTH:	2.231	2.281

=====

CATIONS:		me/liter	mg/liter	me/liter	mg/liter
Calcium	(Ca+2)	119	2380	93.0	1860
Magnesium	(Mg+2)	298	3620	366	4450
Sodium	(Na+1)	1560	35900	1550	35500
Dissolved Iron	(Fe+2)	0.006	0.175	0.004	0.125

ANIONS:					
Bicarbonate	(HCO3-1)	1.40	85.4	1.40	85.4
Carbonate	(CO3-2)	0	0	0	0
Hydroxide	(OH-1)	0	0	0	0
Sulfate	(SO4-2)	82.0	3940	91.9	4410
Chloride	(Cl-1)	1900	67300	1910	67800

DISSOLVED GASES			
Carbon Dioxide	(CO2)	420	160
Hydrogen Sulfide	(H2S)	0	0
Oxygen	(O2)	0	0

=====

SCALING INDEX (positive value indicates scale)

Temperature		Calcium Carbonate	Calcium Sulfate	Calcium Carbonate	Calcium Sulfate
86[F	30[C	-1.8	-8.9	-1.8	-16
110[F	43[C	-1.0	-8.9	-1.1	-16
130[F	54[C	-0.70	-8.9	-0.75	-16
140[F	60[C	-0.51	-8.9	-0.56	-16
160[F	71[C	-0.11	-5.3	-0.16	-12

Comments:
Ratio: Consol. Drinkard = 75% and Warn St. Drinkard = 25%
Consol. Drinkard = 25% and Warn St. Drinkard = 75%
cc: Jay Brown and Joe Hay
I



Unichem International

707 North Leech

P.O.Box 1499

Hobbs, New Mexico 88240

Company : Texaco Inc.
Date : 8-3-1994
Location: Compatability (on 7-28-1994)

	Sample 1
Specific Gravity:	1.082
Total Dissolved Solids:	114681
pH:	6.10
IONIC STRENGTH:	2.163

~~~~~

| CATIONS:       |        | me/liter | mg/liter |
|----------------|--------|----------|----------|
| Calcium        | (Ca+2) | 148      | 2960     |
| Magnesium      | (Mg+2) | 150      | 1820     |
| Sodium         | (Na+1) | 1680     | 38700    |
| Dissolved Iron | (Fe+2) | 0.004    | 0.100    |

| ANIONS:     |          |      |       |
|-------------|----------|------|-------|
| Bicarbonate | (HCO3-1) | 5.90 | 360   |
| Carbonate   | (CO3-2)  | 0    | 0     |
| Hydroxide   | (OH-1)   | 0    | 0     |
| Sulfate     | (SO4-2)  | 58.6 | 2810  |
| Chloride    | (Cl-1)   | 1920 | 68000 |

| DISSOLVED GASES  |       |      |
|------------------|-------|------|
| Carbon Dioxide   | (CO2) | 310  |
| Hydrogen Sulfide | (H2S) | 59.5 |
| Oxygen           | (O2)  | 0    |

~~~~~

SCALING INDEX (positive value indicates scale)

Temperature		Calcium Carbonate	Calcium Sulfate
86[F	30[C	-0.50	-13
110[F	43[C	0.23	-13
130[F	54[C	0.57	-13
140[F	60[C	0.76	-13
160[F	71[C	1.2	-9.4

Comments:

Ratio: Gensolv-Drinkard = 75% and VGSAU = 25%
Consol: Drinkard = 25% and VGSAU = 75%

cc: Jay Brown and Joe Hay

I

Unichem International

707 North Leech

P.O.Box 1499

Hobbs, New Mexico 88240

Company : Texaco Inc.
Date : 8-3-1994
Location: Compatability (on 7-28-1994)

	Sample 1
Specific Gravity:	1.115
Total Dissolved Solids:	160623
pH:	6.20
IONIC STRENGTH:	3.017

=====

CATIONS:		me/liter	mg/liter
Calcium	(Ca+2)	208	4160
Magnesium	(Mg+2)	196	2380
Sodium	(Na+1)	2380	54700
Dissolved Iron	(Fe+2)	0.147	4.10

ANIONS:			
Bicarbonate	(HCO3-1)	1.60	97.6
Carbonate	(CO3-2)	0	0
Hydroxide	(OH-1)	0	0
Sulfate	(SO4-2)	58.6	2810
Chloride	(Cl-1)	2720	96500

DISSOLVED GASES		
Carbon Dioxide	(CO2)	275
Hydrogen Sulfide	(H2S)	0
Oxygen	(O2)	0

=====

SCALING INDEX (positive value indicates scale)

		Calcium	Calcium
Temperature		Carbonate	Sulfate
86[F	30[C	-0.52	-0.55
110[F	43[C	0.21	0.19
130[F	54[C	0.55	0.19
140[F	60[C	0.74	0.19
160[F	71[C	1.1	-0.25

Comments:
Ratio: ~~consolid~~ ~~Drinkard~~ = 50% and Vac: ~~Glorieta West~~ = 50%
cc: Jay Brown
Joe Hay

Unichem International

707 North Leech

P.O.Box 1499

Hobbs, New Mexico 88240

Company : Texaco Inc.
Date : 8-3-1994
Sample 1: Computability (on 7-28-1994)
Sample 2: (on)

	Sample 1	Sample 2
Specific Gravity:	1.098	1.132
Total Dissolved Solids:	136701	184545
pH:	5.85	6.55
IONIC STRENGTH:	2.612	3.422

=====

CATIONS:		me/liter	mg/liter	me/liter	mg/liter
Calcium	(Ca+2)	170	3400	246	4920
Magnesium	(Mg+2)	230	2790	162	1970
Sodium	(Na+1)	1980	45400	2780	63900
Dissolved Iron	(Fe+2)	0.077	2.15	0.217	6.05

ANIONS:		me/liter	mg/liter	me/liter	mg/liter
Bicarbonate	(HCO3-1)	1.50	91.5	1.70	104
Carbonate	(CO3-2)	0	0	0	0
Hydroxide	(OH-1)	0	0	0	0
Sulfate	(SO4-2)	67.8	3260	49.3	2370
Chloride	(Cl-1)	2310	81800	3140	111000

DISSOLVED GASES		me/liter	mg/liter
Carbon Dioxide	(CO2)	413	138
Hydrogen Sulfide	(H2S)	0	0
Oxygen	(O2)	0	0

=====


SCALING INDEX (positive value indicates scale)

Temperature		Calcium Carbonate	Calcium Sulfate	Calcium Carbonate	Calcium Sulfate
86[F]	30[C]	-1.1	-1.3	0.09	-0.30
110[F]	43[C]	-0.41	-1.2	0.82	0.23
130[F]	54[C]	-0.07	-1.2	1.2	0.23
140[F]	60[C]	0.12	-1.2	1.4	0.23
160[F]	71[C]	0.52	-3.1	1.8	-0.22

Comments:
Ratio: Consol: Drinkard = 75% and Vac: Glorieta West = 25%
Consol: Drinkard = 25% and Vac: Glorieta West = 75%

cc: Jay Brown and Joe Hay

ATTACHMENT XI

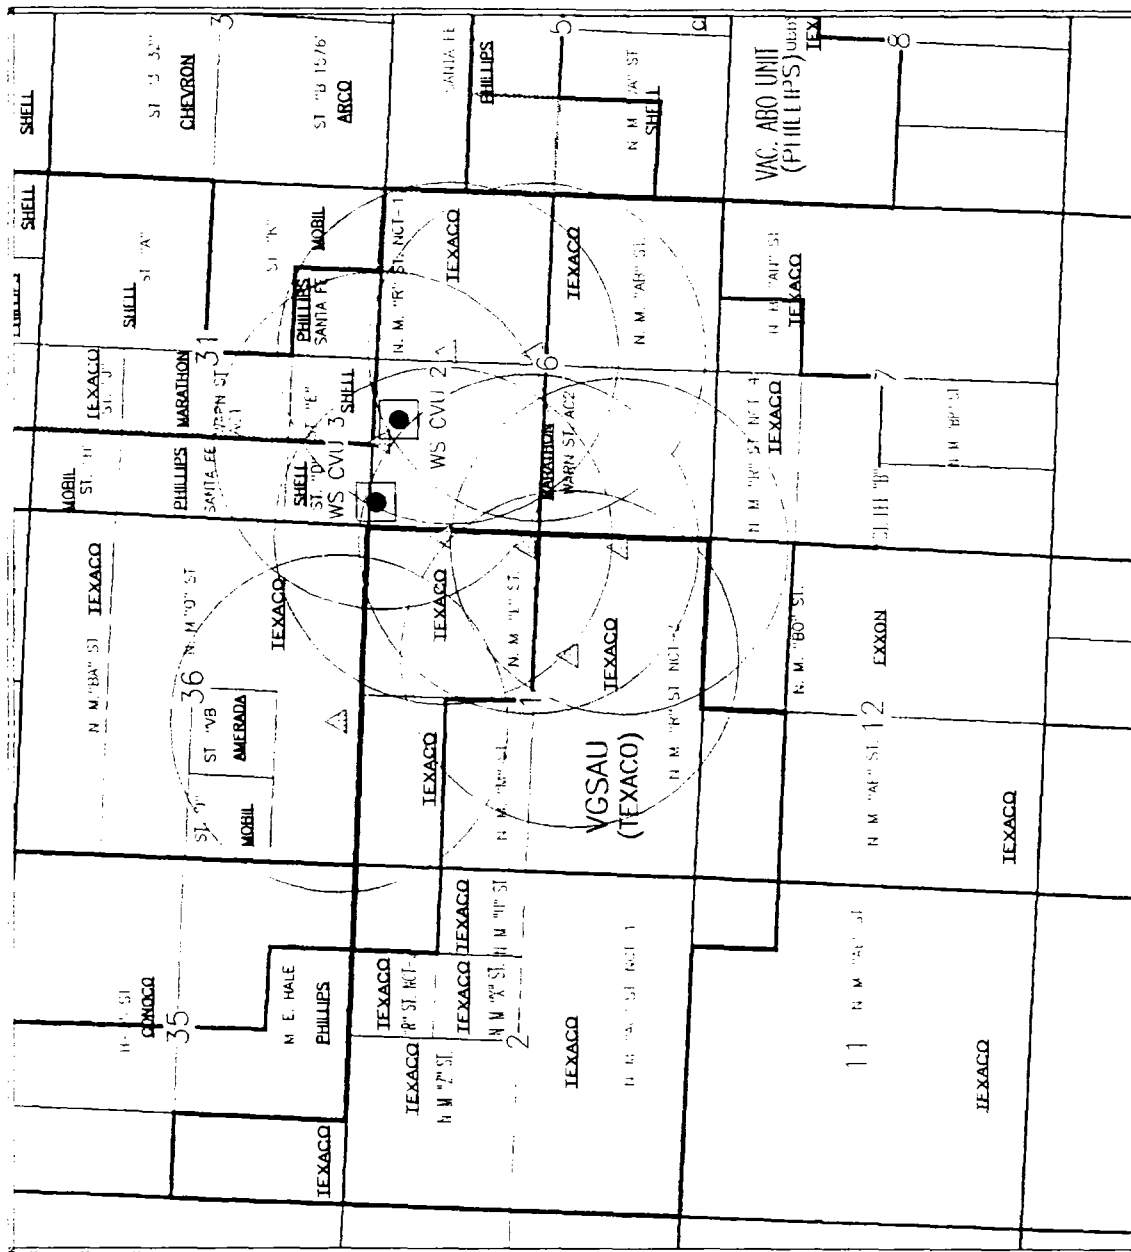

LEASE LINE INJECTION WELLS

Scale 1:36000



Texaco Exploration & Prod. Inc.	
LEASE LINE INJECTION WELLS VACUUM DRINKARD FIELD LEA COUNTY NEW MEXICO	
History Item	10/20/94
Scale	1:36000

**Western Unichem**

Unichem International

707 North Leech

P.O.Box 1499

Hobbs, New Mexico 88240

Company : Texaco Inc.
 Date : 10-31-1994
 Location: CVU - WSW #2 (on 10-26-1994)

	Sample 1
Specific Gravity:	1.000
Total Dissolved Solids:	597
pH:	6.50
IONIC STRENGTH:	0.014

=====

CATIONS:		me/liter	mg/liter
Calcium	(Ca+2)	4.70	94.0
Magnesium	(Mg+2)	3.30	40.1
Sodium	(Na+1)	1.93	44.5
Iron (total)	(Fe+2)	0.007	0.200

ANIONS:			
Bicarbonate	(HCO3-1)	2.60	159
Carbonate	(CO3-2)	0	0
Hydroxide	(OH-1)	0	0
Sulfate	(SO4-2)	0	0
Chloride	(Cl-1)	7.33	260

=====

SCALING INDEX (positive value indicates scale)

Temperature		Calcium Carbonate	Calcium Sulfate
86[F	30[C	-0.84	-18
110[F	43[C	-0.11	-18
130[F	54[C	0.24	-18
140[F	60[C	0.42	-18
160[F	71[C	0.82	-18

Comments:
 cc: Jay Brown
 Joe Hay

I

I



Unichem International

707 North Leech

P.O.Box 1499

Hobbs, New Mexico 88240

Company : Texaco Inc.
 Date : 10-31-1994
 Location: CVU - WSW #3 (on 10-26-1994)

Specific Gravity:	Sample 1
Total Dissolved Solids:	1.001
pH:	1944
IONIC STRENGTH:	6.70
	0.043

=====

CATIONS:		me/liter	mg/liter
Calcium	(Ca+2)	9.00	180
Magnesium	(Mg+2)	6.60	80.2
Sodium	(Na+1)	17.7	406
Iron (total)	(Fe+2)	0.014	0.400

ANIONS:			
Bicarbonate	(HCO3-1)	2.20	134
Carbonate	(CO3-2)	0	0
Hydroxide	(OH-1)	0	0
Sulfate	(SO4-2)	3.31	159
Chloride	(Cl-1)	27.8	984

=====

SCALING INDEX (positive value indicates scale)

Temperature		Calcium Carbonate	Calcium Sulfate
86[F	30[C	-0.55	-14
110[F	43[C	0.18	-14
130[F	54[C	0.52	-14
140[F	60[C	0.71	-14
160[F	71[C	1.1	-14

Comments:

cc: Jay Brown
 Joe Hay

I