

CHUSKA ENERGY COMPANY

315 N. BEHREND • FARMINGTON, NEW MEXICO 87401 • PHONE: (505) 326-5525

April 19, 1989

M. S.
Dismiss
Case No. 9662

New Mexico Oil Conservation Division
P.O. Box 2088
Santa Fe, New Mexico 87501

Attn: Mr. Michael E. Stogner

Ref: Cancelation - Non-Standard Location Hearing

Dear Mike,

In reference to our phone conversation today, please cancel the hearing that is currently scheduled for April 26th for a Non-Standard location for our Chimney Rock prospect. This location has been moved and is now a legal location. The new footage is as follows: 1190' FNL & 1025' FEL. Enclosed are copies of the C-102 and elevation plat.

Regards,

Rick Allen
Drilling Manager

cc: New Mexico Oil Conservation Division
1000 Rio Brazos road
Aztec, New Mexico 87410

Bureau of Land Management
1235 La Plata Hwy.
Farmington, New Mexico 87401

Chuska Energy Company
Denver Division
Attn: Brad C. Morrison

RECEIVED

APR 24 1989
OIL CONSERVATION DIV.
SANTA FE

Submit to Appropriate
District Office
State Lease - 4 copies
Fee Lease - 3 copies

State of New Mexico
Energy, Minerals and Natural Resources Department

Form C-102
Revised 1-1-89

OIL CONSERVATION DIVISION

DISTRICT I
P.O. Box 1980, Hobbs, NM 88240

P.O. Box 2088
Santa Fe, New Mexico 87504-2088

DISTRICT II
P.O. Drawer DD, Artesia, NM 88210


DISTRICT III
1000 Rio Brazos Rd., Aztec, NM 87410

WELL LOCATION AND ACREAGE DEDICATION PLAT

All Distances must be from the outer boundaries of the section

Operator Chuska Energy Company			Lease Chimney Rock 3-21-31N18W		Well No. 1
Unit Letter A	Section 21	Township 31 North	Range 18 West	County San Juan	
Actual Footage Location of Well: 1190 feet from the North line and 1025 feet from the East line					
Ground level Elev. 5055	Producing Formation Paradox	Pool Wildcat	Dedicated Acreage: 160 Acres		

- Outline the acreage dedicated to the subject well by colored pencil or hatchure marks on the plat below.
- If more than one lease is dedicated to the well, outline each and identify the ownership thereof (both as to working interest and royalty).
- If more than one lease of different ownership is dedicated to the well, have the interest of all owners been consolidated by communitization, unitization, force-pooling, etc.?
☐ Yes ☐ No If answer is "yes" type of consolidation _____
If answer is "no" list the owners and tract descriptions which have actually been consolidated. (Use reverse side of this form if necessary.) _____
No allowable will be assigned to the well until all interests have been consolidated (by communitization, unitization, forced-pooling, or otherwise) or until a non-standard unit, eliminating such interest, has been approved by the Division.

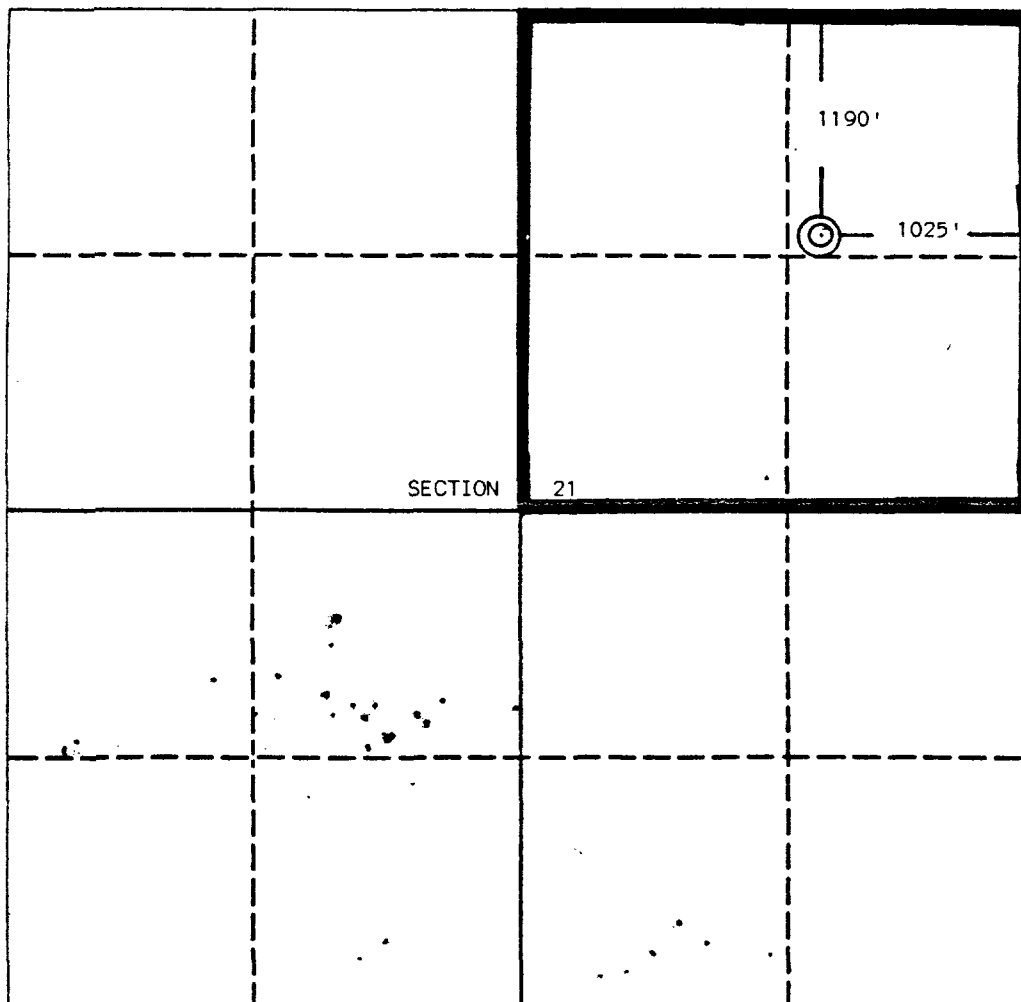

OPERATOR CERTIFICATION

I hereby certify that the information contained herein is true and complete to the best of my knowledge and belief.

Signature

Printed Name

Rick Allen

Position

Drilling Manager

Company

CHUSKA ENERGY COMPANY

Date

April 19, 1989

SURVEYOR CERTIFICATION

I hereby certify that the well location shown on this plat was plotted from field notes of actual surveys made by me or under my supervision, and that the same is true and correct to the best of my knowledge and belief.

Date Surveyed

April 13, 1989


Signature & Seal of
Professional Surveyor

Certificate No. 5979

Edgar Risenhoover

0 330 660 990 1320 1650 1980 2310 2640 2000 1500 1000 500 0

Restake Old 181

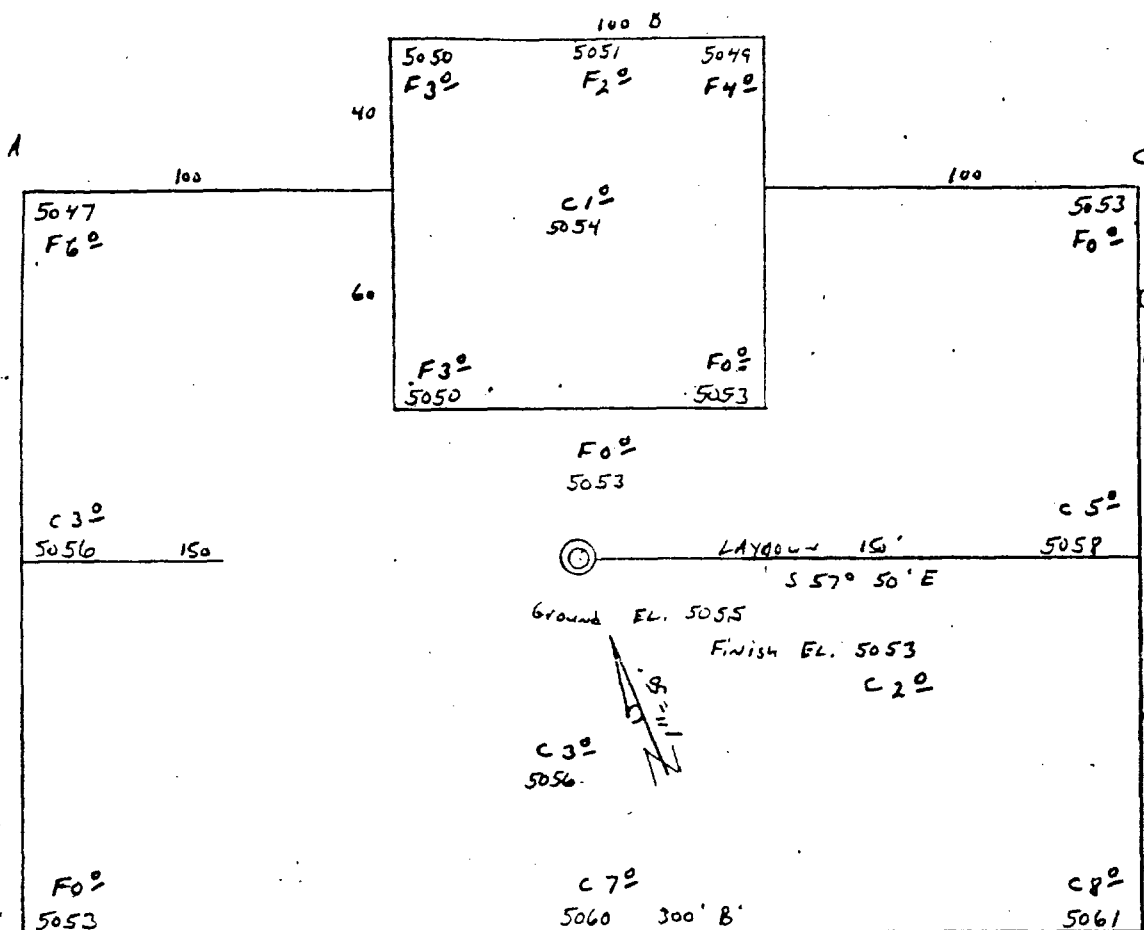

Chuska Energy Company

OPERATOR

3-21-31N18W # Chimney Rock

WELL NAME & NO.

1190' F/NL 1025' F/EL

FOOTAGES

21 31N 18W

SEC. TWP. RGE.

San Juan, NM

COUNTY

April 13, 1989

DATE

5060					
5050					5053
5040					

5060					5053
5050					
5040					

5060					
5050					5053
5040					

Horiz 1" = 50'

Vert 1" = 30'