

UNITED STATES
DEPARTMENT OF THE INTERIOR
BUREAU OF LAND MANAGEMENT

OCD Artesia

FORM APPROVED
OMB No. 1004-0137
Expires: October 31, 2014**SUNDRY NOTICES AND REPORTS ON WELLS**
Do not use this form for proposals to drill or to re-enter an abandoned well. Use Form 3160-3 (APD) for such proposals.5. Lease Serial No.
SHL: NMLC061862 / NMNM120903
6. If Indian, Allottee or Tribe Name**SUBMIT IN TRIPLICATE – Other instructions on page 2.**

7. If Unit of CA/Agreement, Name and/or No.

1. Type of Well

☒ Oil Well ☐ Gas Well ☐ Other8. Well Name and No.
Belgian 15 Fed Com 1H; Shire 22 Fed 1H2. Name of Operator
Devon Energy Production Co LP (6137)9. API Well No.
30-015-43187; 30-015-432223a. Address
PO BOX 250, ARTESIA, NM 882113b. Phone No. (include area code)
575-748-337110. Field and Pool or Exploratory Area
PADUCA; BONE SPRING4. Location of Well (Footage, Sec., T., R., M., or Survey Description)
Belgian 15 Fed Com 1H) O-15-25S-31E; 14 FSL & 1610 FEL; 32.123138, -103.762524 NAD83
Shire 22 Fed 1H) O-15-25S-31E; 14 FSL & 1670 FEL; 32.123137S, -103.762655 NAD 8311. County or Parish, State
EDDY COUNTY, NM

12. CHECK THE APPROPRIATE BOX(ES) TO INDICATE NATURE OF NOTICE, REPORT OR OTHER DATA

TYPE OF SUBMISSION	TYPE OF ACTION			
<input type="checkbox"/> Notice of Intent	<input type="checkbox"/> Acidize	<input type="checkbox"/> Deepen	<input type="checkbox"/> Production (Start/Resume)	<input type="checkbox"/> Water Shut-Off
<input checked="" type="checkbox"/> Subsequent Report	<input type="checkbox"/> Alter Casing	<input type="checkbox"/> Fracture Treat	<input checked="" type="checkbox"/> Reclamation	<input type="checkbox"/> Well Integrity
<input type="checkbox"/> Final Abandonment Notice	<input type="checkbox"/> Casing Repair	<input type="checkbox"/> New Construction	<input type="checkbox"/> Recomplete	<input type="checkbox"/> Other _____
	<input type="checkbox"/> Change Plans	<input type="checkbox"/> Plug and Abandon	<input type="checkbox"/> Temporarily Abandon	<input type="checkbox"/> Downsizing
	<input type="checkbox"/> Convert to Injection	<input type="checkbox"/> Plug Back	<input type="checkbox"/> Water Disposal	

13. Describe Proposed or Completed Operation: Clearly state all pertinent details, including estimated starting date of any proposed work and approximate duration thereof. If the proposal is to deepen directionally or recompleat horizontally, give subsurface locations and measured and true vertical depths of all pertinent markers and zones. Attach the Bond under which the work will be performed or provide the Bond No. on file with BLM/BIA. Required subsequent reports must be filed within 30 days following completion of the involved operations. If the operation results in a multiple completion or recompleat in a new interval, a Form 3160-4 must be filed once testing has been completed. Final Abandonment Notices must be filed only after all requirements, including reclamation, have been completed and the operator has determined that the site is ready for final inspection.)

Devon Energy respectfully requests approval to amend the original APD Proposed Interim Reclamation Diagram to move the Battery Facilities from the Belgian 15 Fed Com 1H / Shire 22 Fed 1H location pad to the Belgian / Shire BS 22 CTB.

This 2-well location has been downsized. Acres reclaimed = 2.3301

NM OIL CONSERVATION
ARTESIA DISTRICT

FEB 06 2017

RECEIVED


(Also, this sundry was not filed electronically because the WIS program was not able to attach files at the time. Ticket turned in to BLM Help Desk)

14. I hereby certify that the foregoing is true and correct. Name (Printed/Typed)

Denise Menoud (575-746-5544)

Title Admin Field Support


Signature

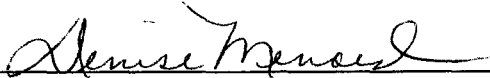

Date 01/06/2017

THIS SPACE FOR FEDERAL OR STATE OFFICE USE

Approved by

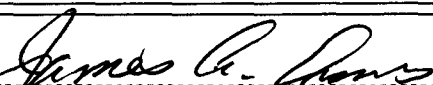

Title

SPET

Date

1-25-17

Conditions of approval, if any, are attached. Approval of this notice does not warrant or certify that the applicant holds legal or equitable title to those rights in the subject lease which would entitle the applicant to conduct operations thereon.

Office

CFD

Title 18 U.S.C. Section 1001 and Title 43 U.S.C. Section 1212, make it a crime for any person knowingly and willfully to make to any department or agency of the United States any false, fictitious or fraudulent statements or representations as to any matter within its jurisdiction.

(Instructions on page 2)



devon

Interim
Site Reclamation

Devon Energy Prod. Co.

Belgian 15 FC 1H
API #30-015-43187
O-15-25S-31E


Shire 22 Fed 1H
30-015-43222
O-15-25S-31E

Eddy County, NM

N



Area
Reclaimed
= 2,3301 Acres
D. Menoud

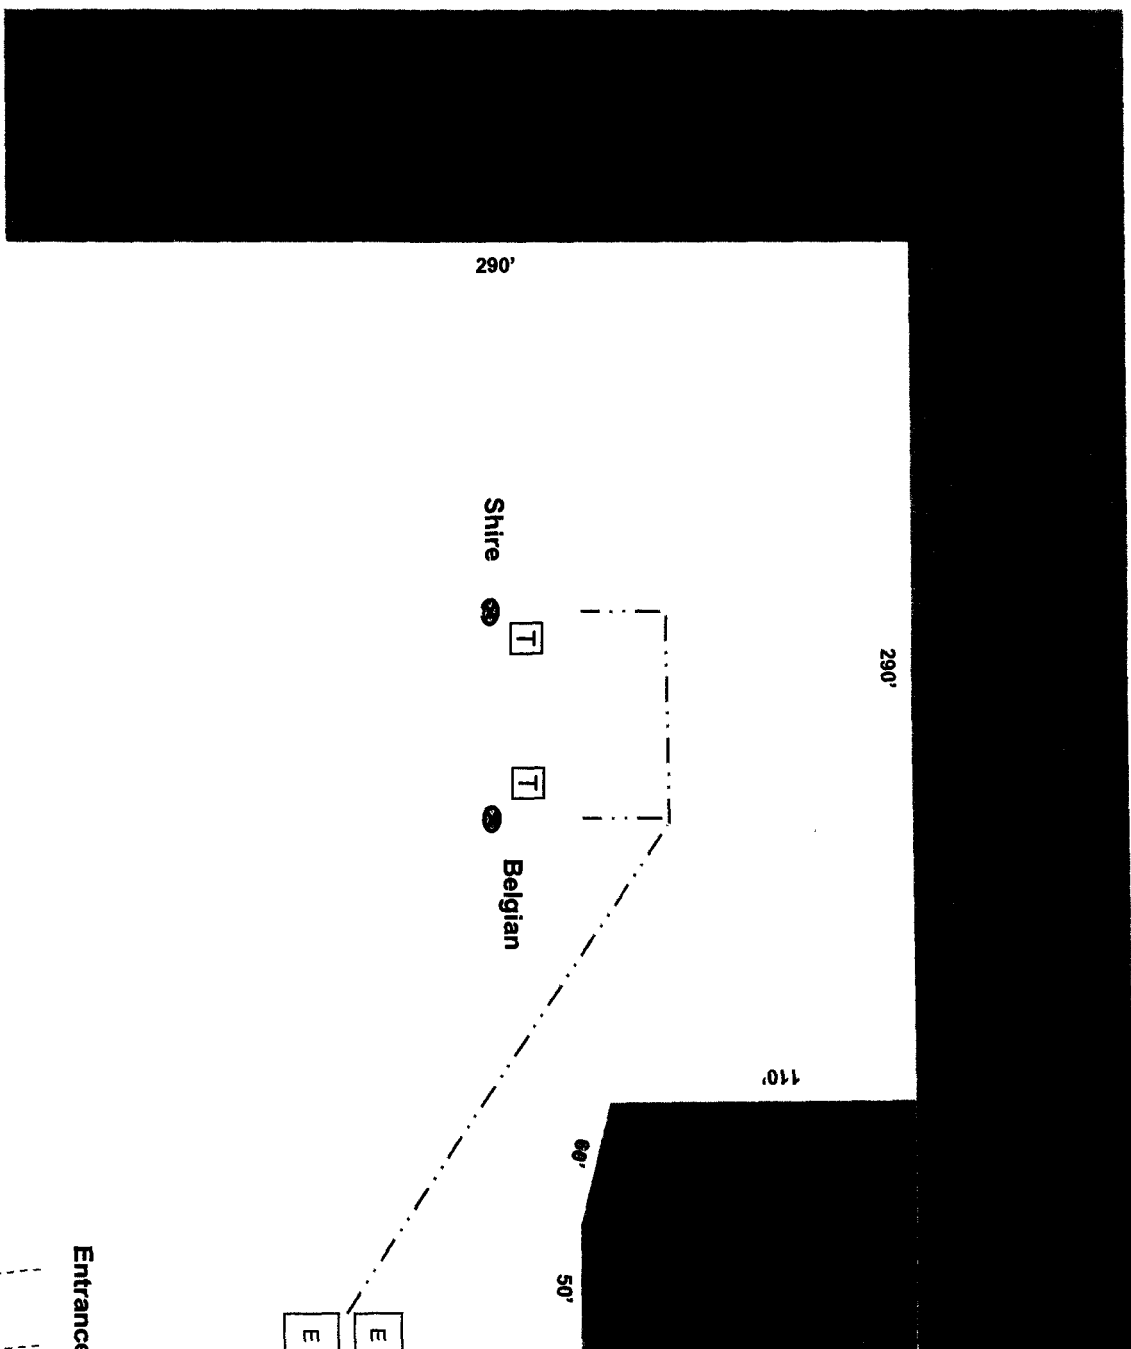



devon


Proposed Interim Site Reclamation


Devon Energy Production Co.
Belgian 15 Fed Com 1H
Sec 15-T25S-R31E
Eddy County, NM



Proposed Reclamation Area


Scale: 1in = 60ft.

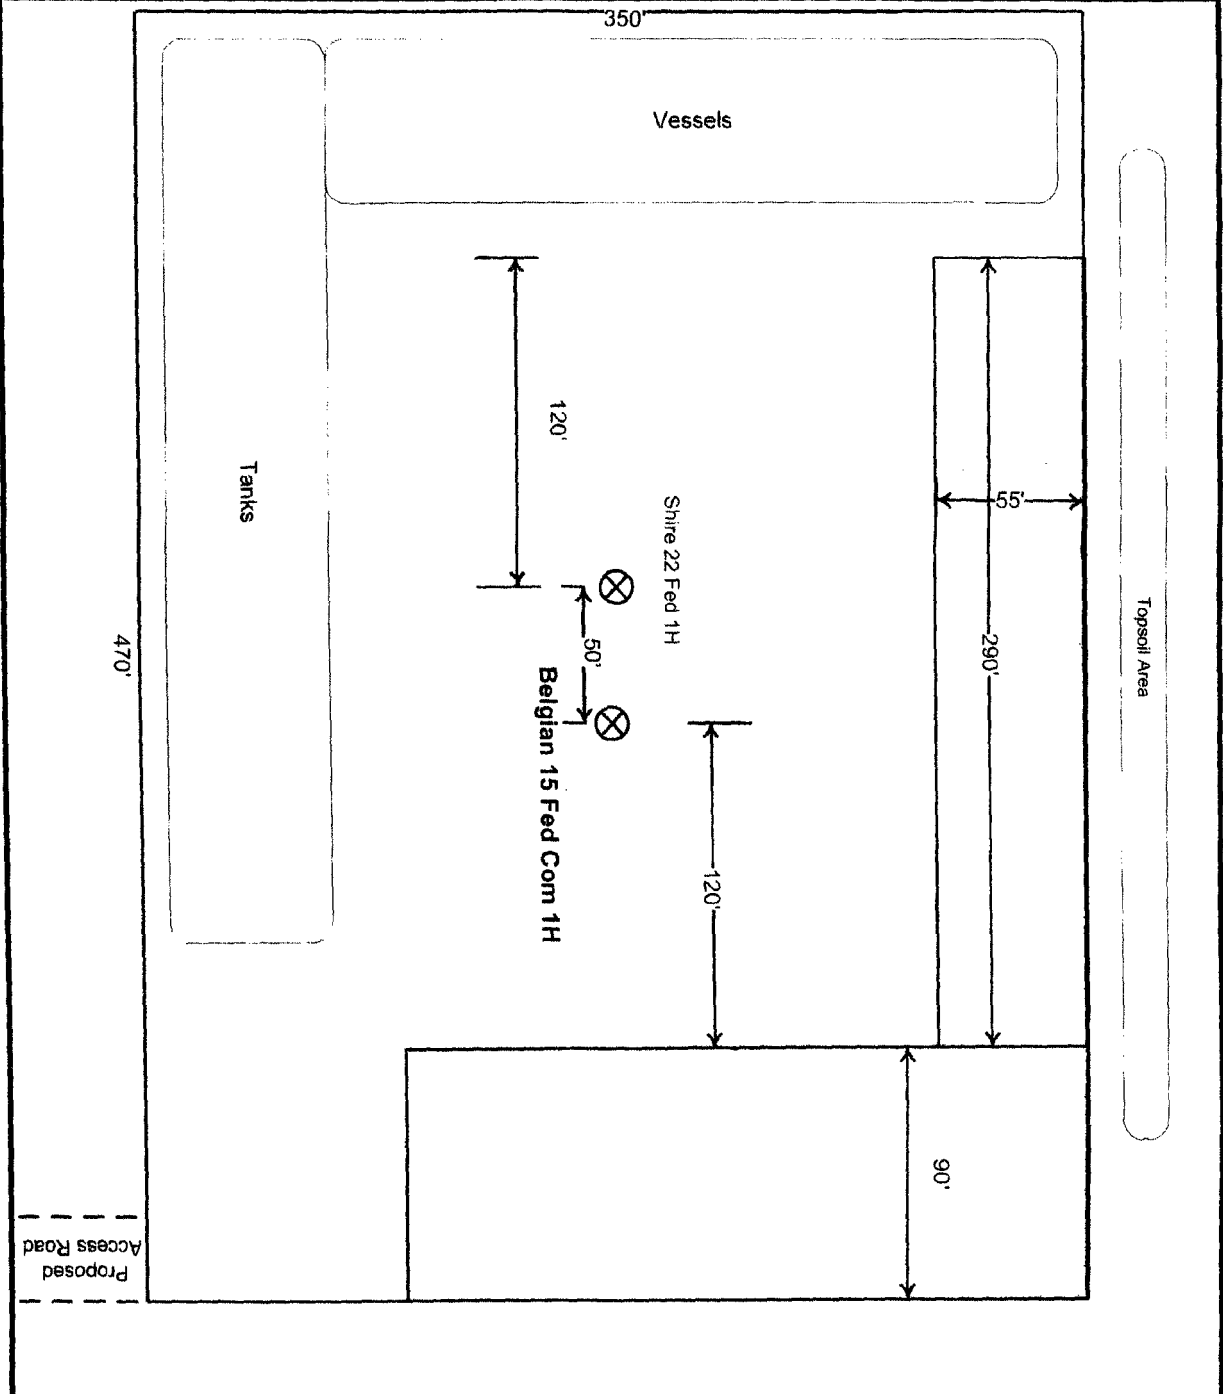

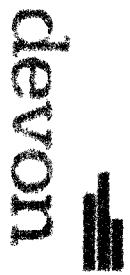


Proposed Interim Site Reclamation

Devon Energy Production Co.
Shire 22 Fed 1H
Sec 15-T25S-R31E
Eddy County, NM

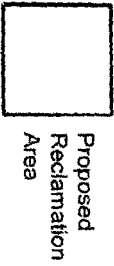

Scale: 1in = 60ft.

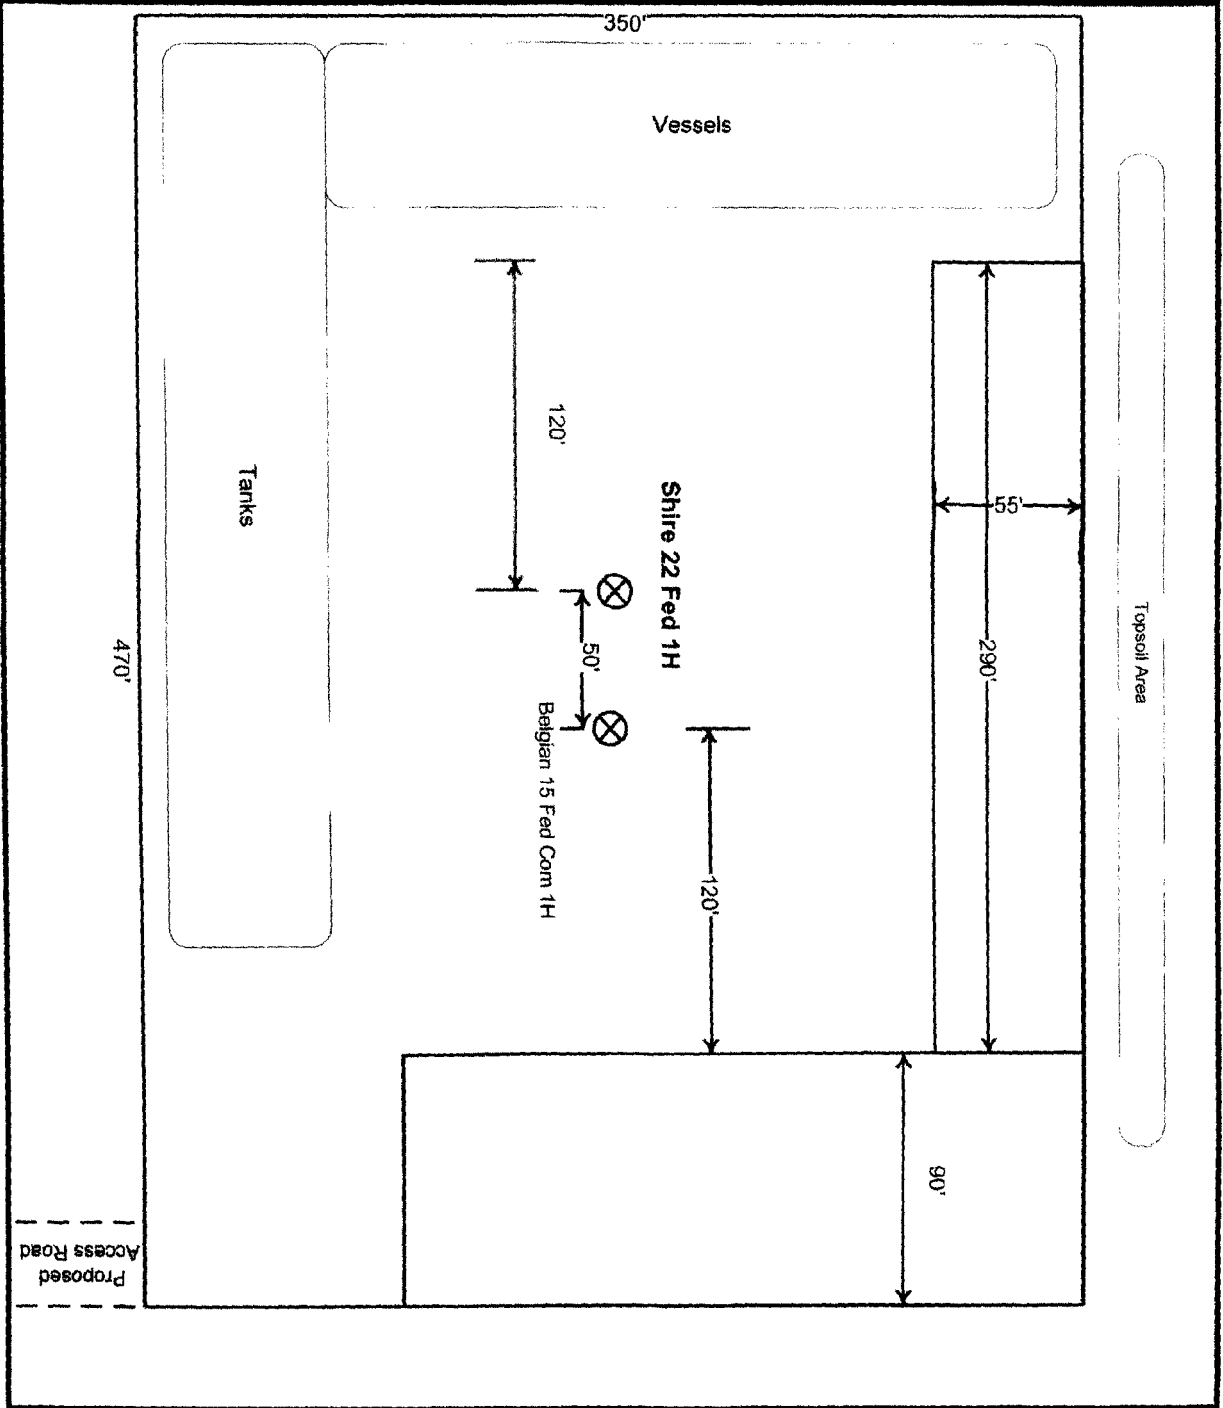

Shirley
1M Pad Connect

SHIRLEY
1M Pad Connect

devon

This map is for illustrative purposes only and is not a legally recorded map nor survey and is not intended to be used as one. Devon makes no warranty, representation, or guarantee of any kind regarding this map.

WGS_1984_Web_Mercator_Auxiliary_Sphere
Prepared by: User
Map is current as of: 05-Jan-2017



Miles

0 0.00 0.01 0.02 1:889

- # DMI Currently Drilling
- # DMI Currently Fracking
- Center Point & Point Features (PA)
- CTR - Center Point
- Multi Well Pad - Center Point
- Single Well Pad - Center Point
- Well Surface Hole
- Well Bottom Hole
- Cathodic - Test Lead
- Plane - Fitting
- Pipeline Valve
- SRV - Cap Bank
- SRV - Fuse Box
- SRV - Meter
- SRV - Pole
- SRV - Backhoe
- SRV - Switch
- SRV - Transformer

- Flowline Head (PA)
- AS BUILT/AFTER BUILT
- CONSTRUCTION
- PROPOSED
- REVISION
- Gas (PA)
- AS BUILT/AFTER BUILT
- CONSTRUCTION
- PROPOSED
- REVISION
- Gas Lift (PA)
- AS BUILT/AFTER BUILT
- CONSTRUCTION
- PROPOSED
- REVISION
- Oil (PA)
- AS BUILT/AFTER BUILT
- CONSTRUCTION
- PROPOSED
- REVISION

- Water (PA)
- AS BUILT/AFTER BUILT
- CONSTRUCTION
- PROPOSED
- REVISION
- Utility (PA)
- AS BUILT/AFTER BUILT
- CONSTRUCTION
- PROPOSED
- REVISION
- Road (PA)
- AS BUILT/AFTER BUILT
- CONSTRUCTION
- PROPOSED
- REVISION
- Flowline Head (PP)
- AS BUILT/AFTER BUILT
- CONSTRUCTION
- PROPOSED
- REVISION

- Gas (PP)
- AS BUILT/AFTER BUILT
- CONSTRUCTION
- PROPOSED
- REVISION
- Gas Lift (PP)
- AS BUILT/AFTER BUILT
- CONSTRUCTION
- PROPOSED
- REVISION
- Oil (PP)
- AS BUILT/AFTER BUILT
- CONSTRUCTION
- PROPOSED
- REVISION
- Water (PP)
- AS BUILT/AFTER BUILT
- CONSTRUCTION
- PROPOSED
- REVISION